

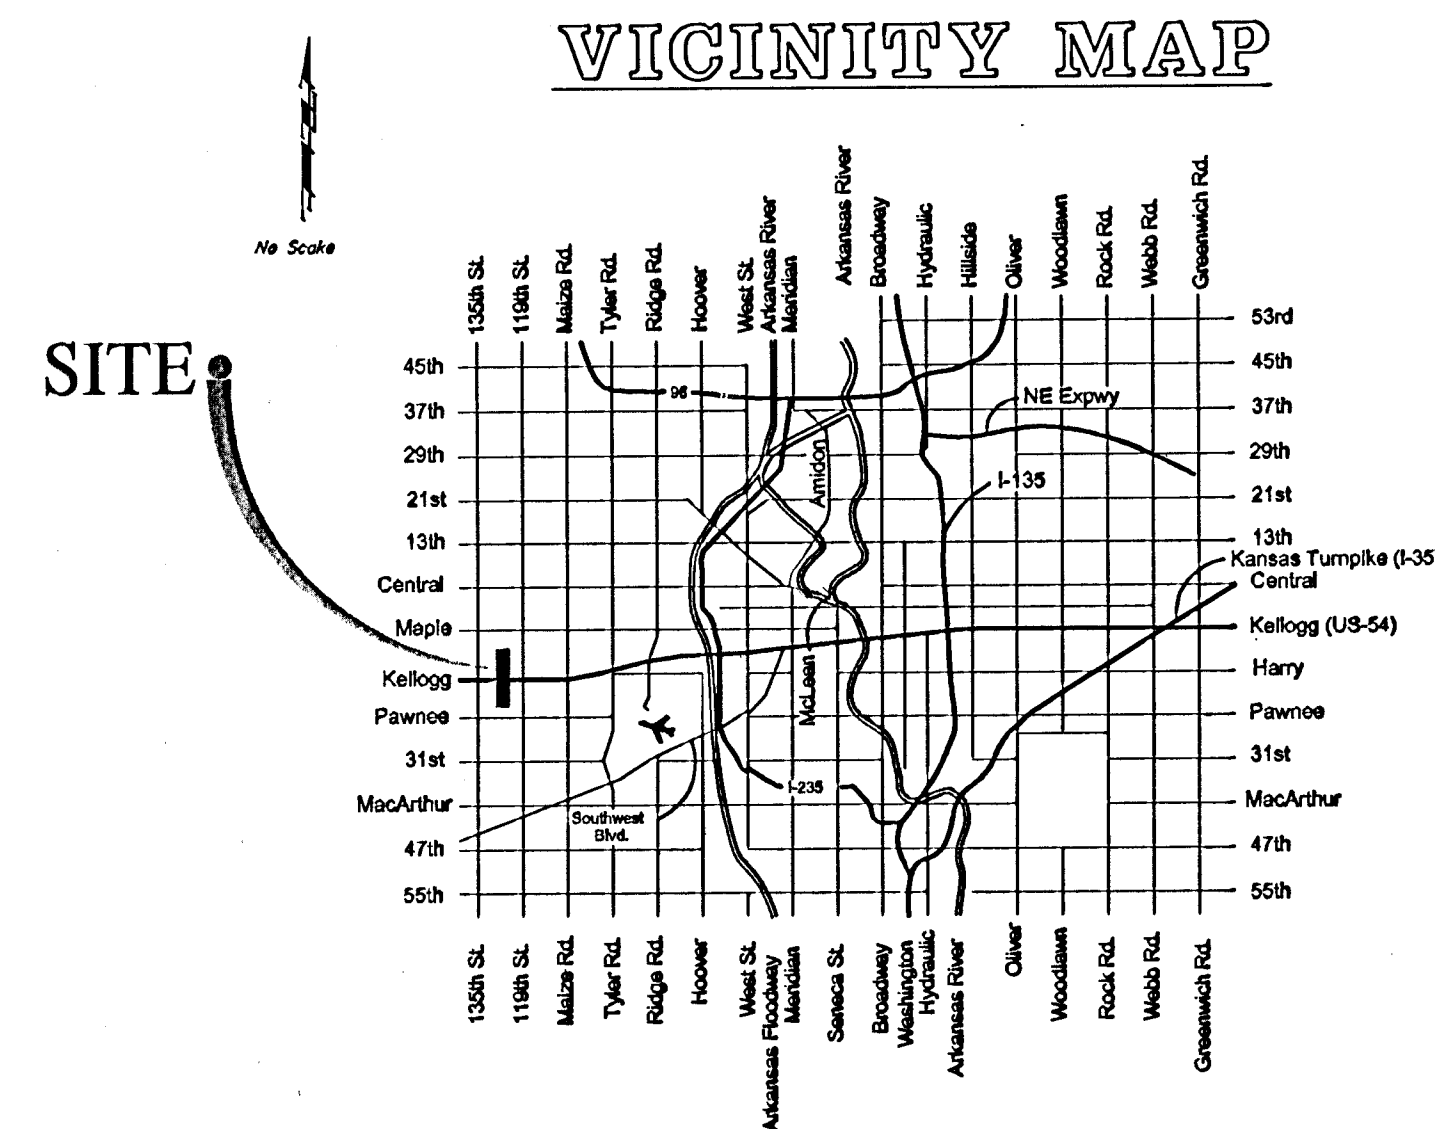


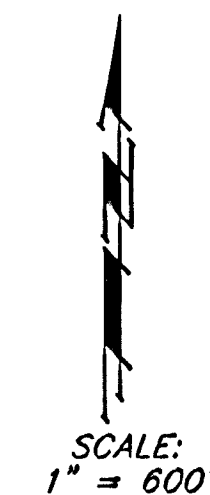

INDEX

Title Sheet	1
General Notepage & Keysheet	2
SS Plan/Profile Sheets	3-11
Type "P" Manhole Details	12
Manhole Ring & Cover Details	13
Erosion Controls Details	14-16

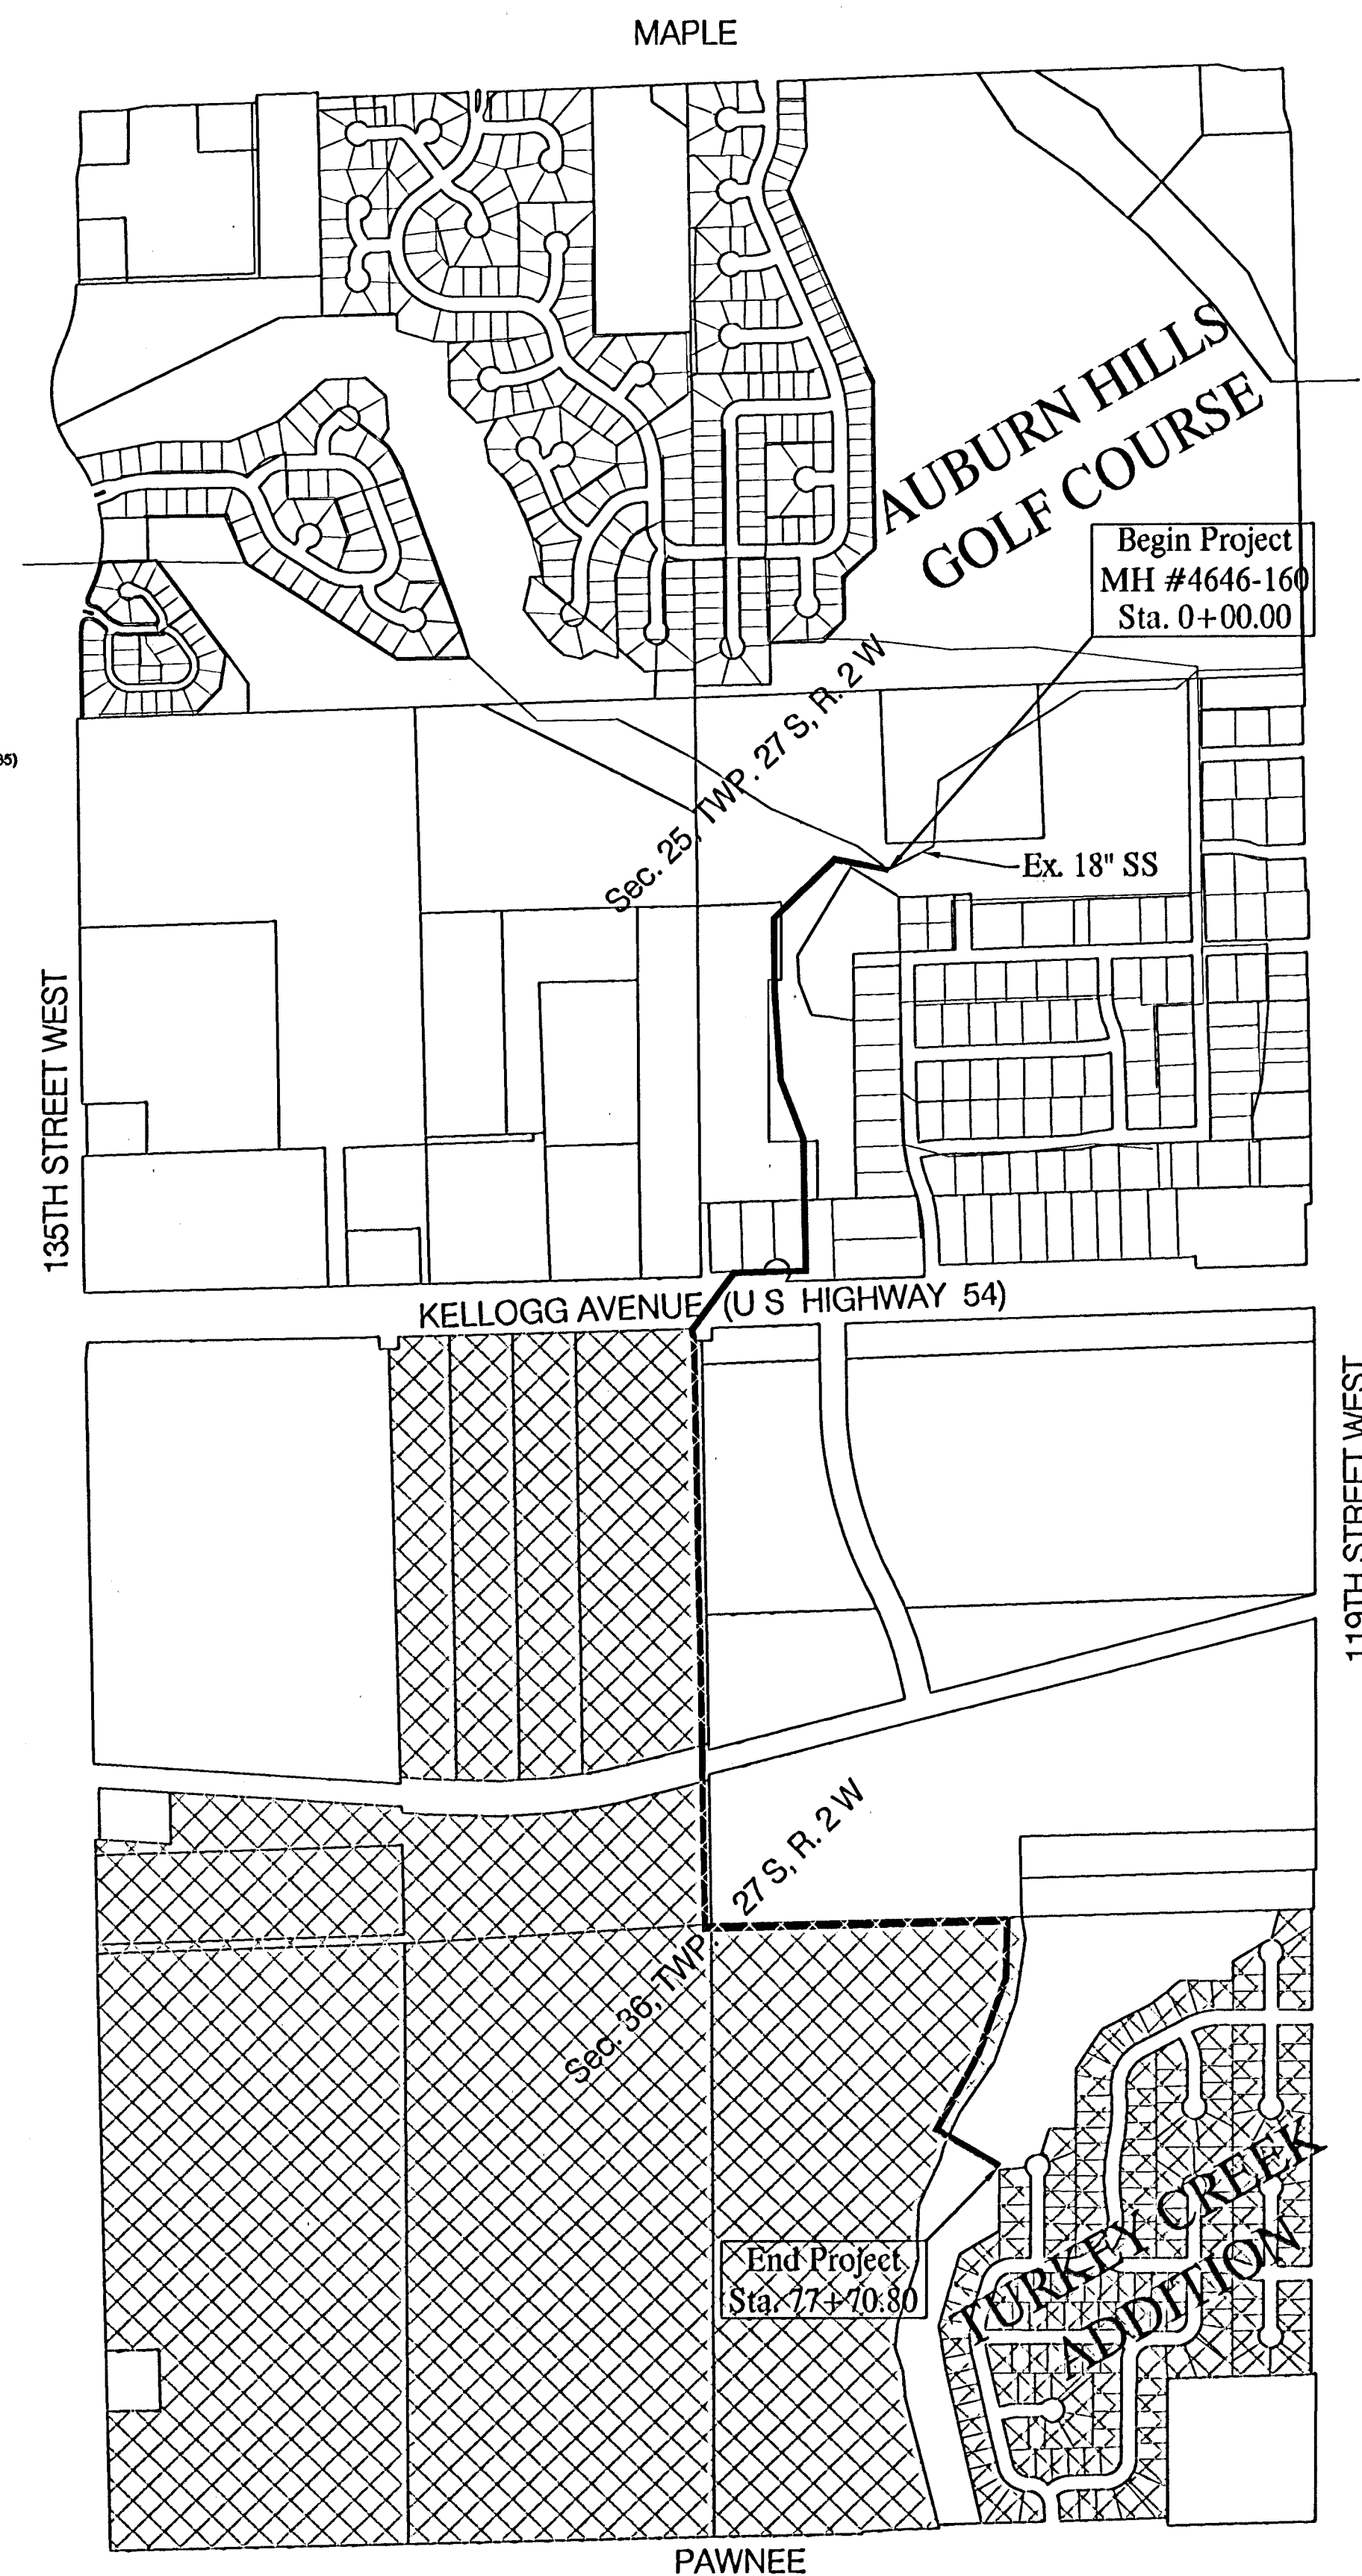

SANITARY SEWER COLLECTION SYSTEM IMPROVEMENTS MAIN 6, COWSKIN INTERCEPTOR SEWER

to serve

TURKEY CREEK ADDITION

Project No.

468-83817

OCA No.


744081

CITY OF WICHITA, KANSAS


James L. Armour, City Engineer

August 2005

Mies Construction, Inc. - Contractor
Hartman, City - Inspector
Released 2/22/06
Per Plan
Stubs
.pdf by JDL 4/26/06

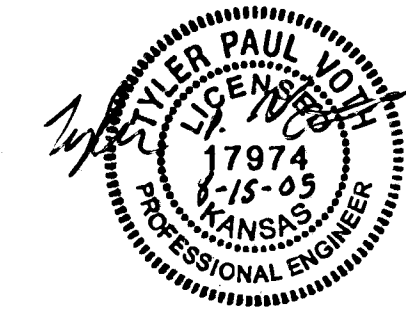

Benefit District

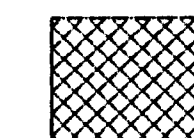

Drawing File: R:\eng\Main 6, COWSKIN.dwg

Aug 2005

Baughman Company, P.A.
315 Ellis St. Wichita, KS 67211 P 316-262-7171 F 316-262-0149
Baughman ENGINEERING | SURVEYING | PLANNING | LANDSCAPE ARCHITECTURE