



Benchmarks:
BM #1: "X" on the West End of the Steel Casing Pipe at the Railroad Crossing South of 37th Street North Sta. 25+90, 41' Rt. Elev. = 149.18 (1336.58 MSL)
BM #2: Steel T-Post Driven 4' Deep Sta. 18+00, 25' Rt. Elev. = 150.33 (1337.73 MSL)
BM #3: "U" in the Concrete Footing of the SBC Pedestal in the South West Corner of 37th Street North and Tyler Road Sta. 8+56, 95' Rt. Elev. = 154.77 (1342.17 MSL)
BM #4: Railroad Spike in the East Face of the 2nd Power Pole North of 37th Street and West of Tyler Road Sta. 94+24, 48' Lt. Elev. = 155.45 (1342.85 MSL)

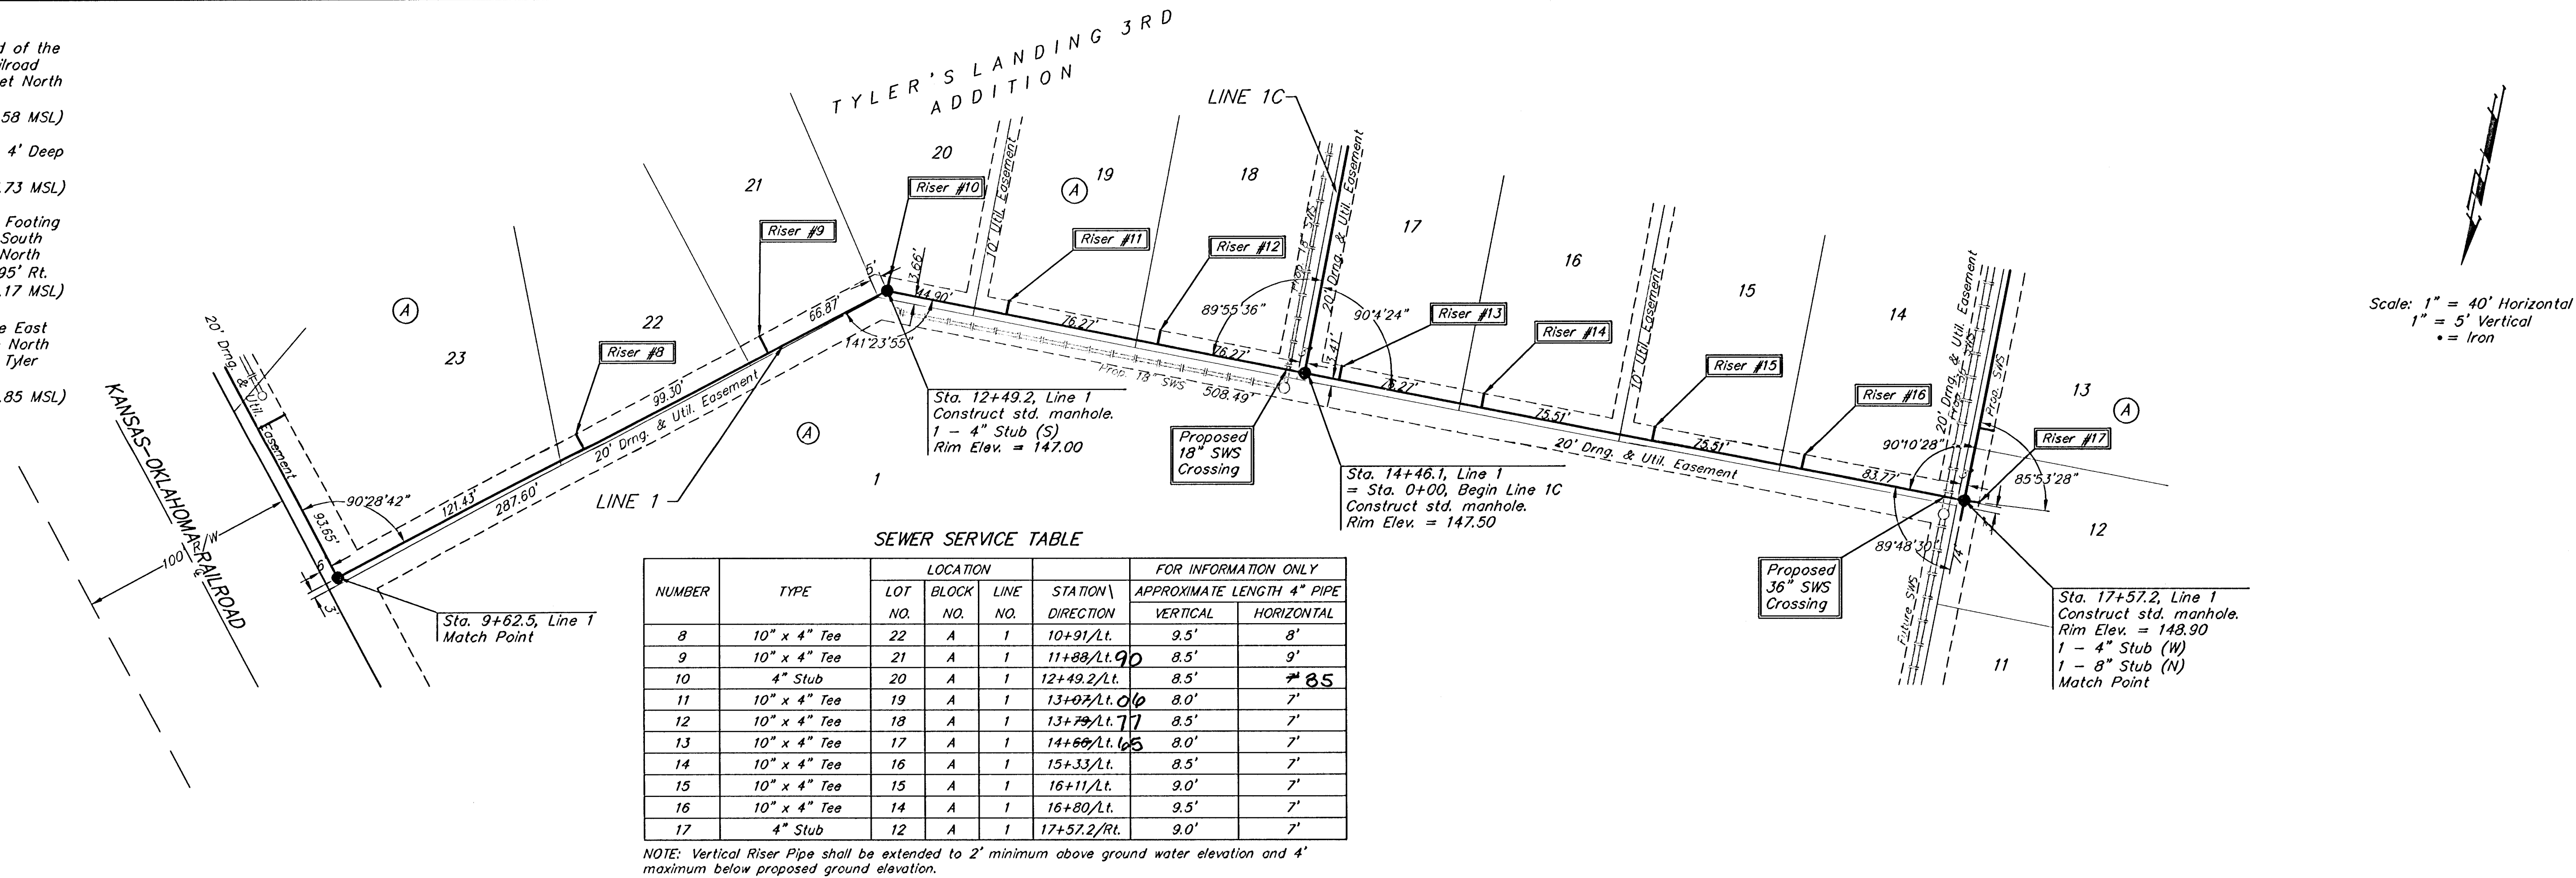

SEWER SERVICE TABLE							
NUMBER	TYPE	LOCATION			FOR INFORMATION ONLY		
		LOT NO.	BLOCK NO.	LINE NO.	STATION \ DIRECTION	APPROXIMATE LENGTH 4" PIPE VERTICAL HORIZONTAL	
8	10" x 4" Tee	22	A	1	10+91/Lt.	9.5'	8'
9	10" x 4" Tee	21	A	1	11+88/Lt.	8.5'	9'
10	4" Stub	20	A	1	12+49.2/Lt.	8.5'	8.5'
11	10" x 4" Tee	19	A	1	13+07/Lt.	8.0'	7'
12	10" x 4" Tee	18	A	1	13+79/Lt.	8.5'	7'
13	10" x 4" Tee	17	A	1	14+60/Lt.	8.0'	7'
14	10" x 4" Tee	16	A	1	15+33/Lt.	8.5'	7'
15	10" x 4" Tee	15	A	1	16+11/Lt.	9.0'	7'
16	10" x 4" Tee	14	A	1	16+80/Lt.	9.5'	7'
17	4" Stub	12	A	1	17+57.2/Rt.	9.0'	7'

NOTE: Vertical Riser Pipe shall be extended to 2' minimum above ground water elevation and 4' maximum below proposed ground elevation.

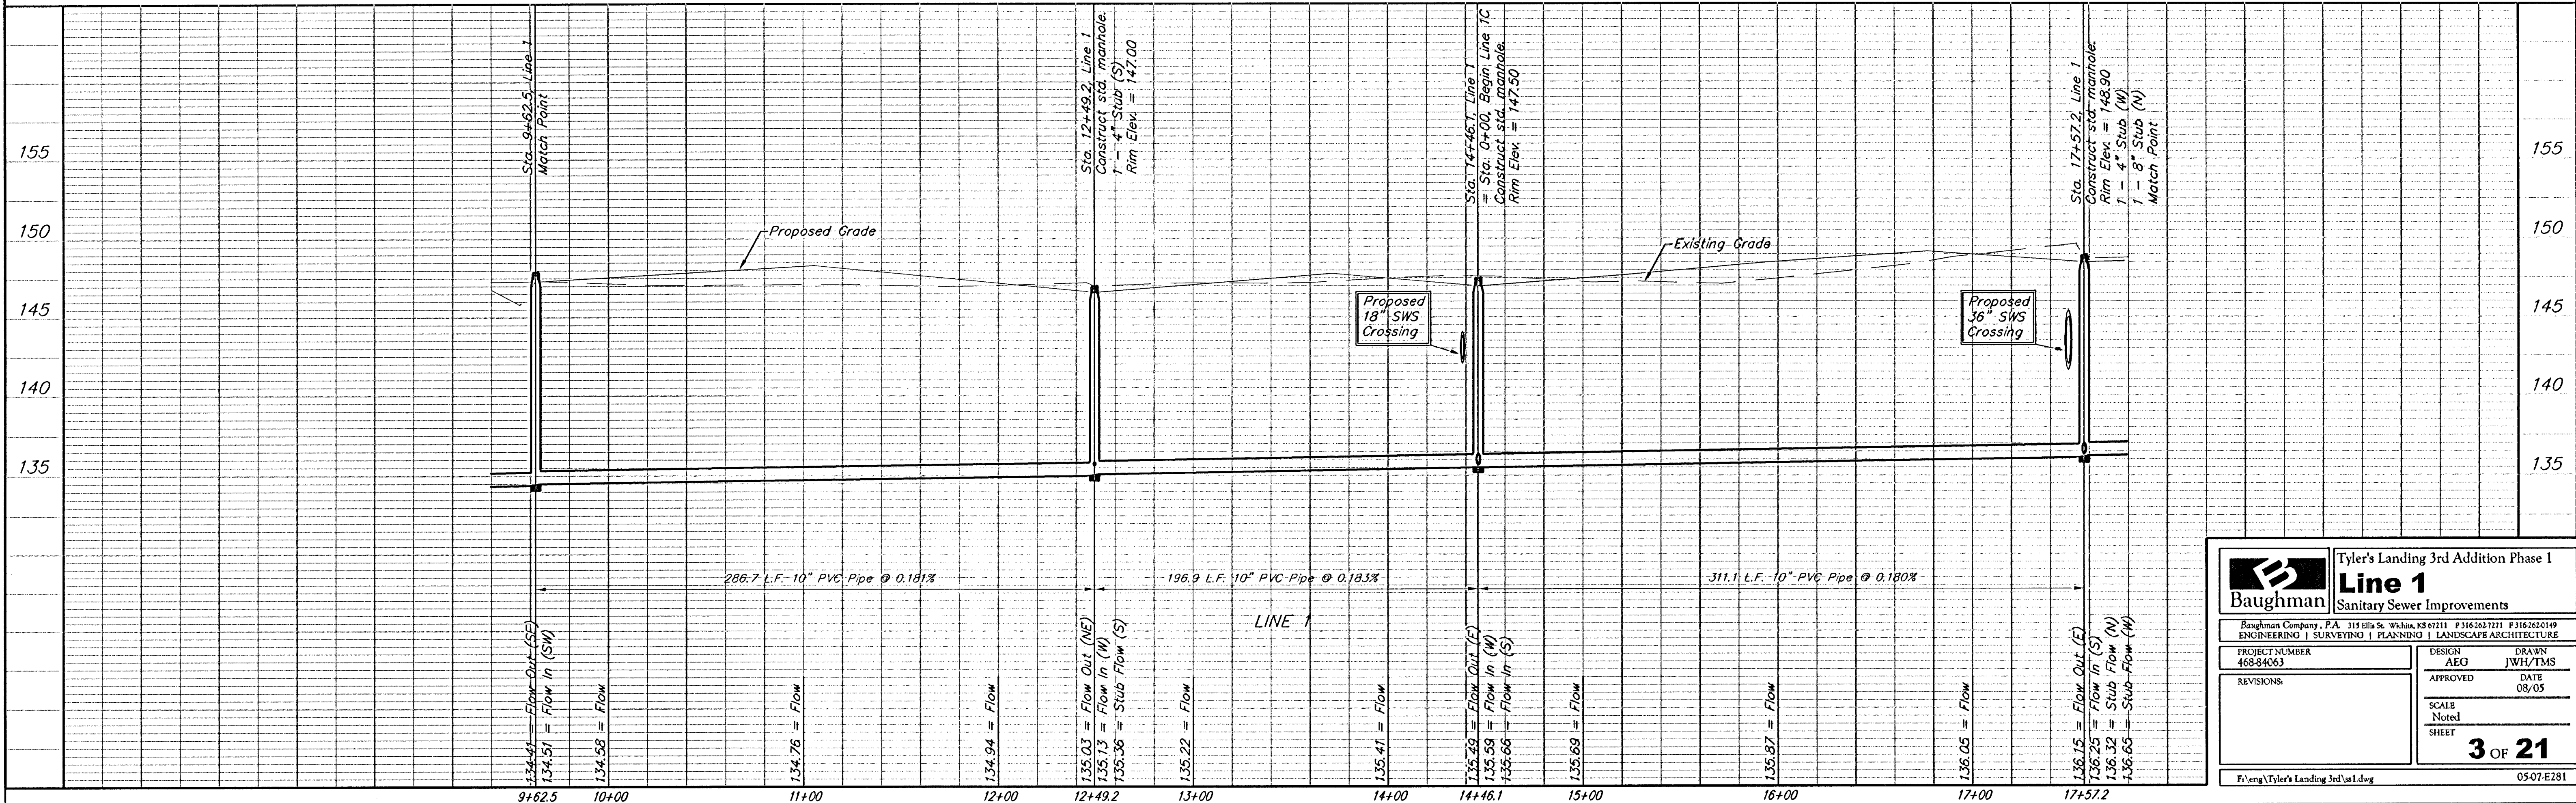

Tyler's Landing 3rd Addition Phase 1
Line 1
Sanitary Sewer Improvements

PROJECT NUMBER
468-0403

DESIGN
AEG

APPROVED
DATE
08/05

REVISIONS

SCALE
NOTED
SHEET
3 OF 21

F:\eng\Tyler's Landing 3rd\va1.dwg

0507E291