
Benchmarks:

BM #1: "X" on the West End of the Steel Casing Pipe at the Railroad Crossing South of 37th Street North Sta. 25+90, 41' Rt. Elev. = 149.18 (1336.58 MSL)

BM #2: Steel T-Post Driven 4' Deep Sta. 18+00, 25' Rt. Elev. = 150.33 (1337.73 MSL)

BM #3: "□" in the Concrete Footing of the SBC Pedestal in the South West Corner of 37th Street North and Tyler Road Sta. 8+56, 95' Rt. Elev. = 154.77 (1342.17 MSL)

BM #4: Railroad Spike in the East Face of the 2nd Power Pole North of 37th Street and West of Tyler Road Sta. 94+24, 48' Lt. Elev. = 155.45 (1342.85 MSL)

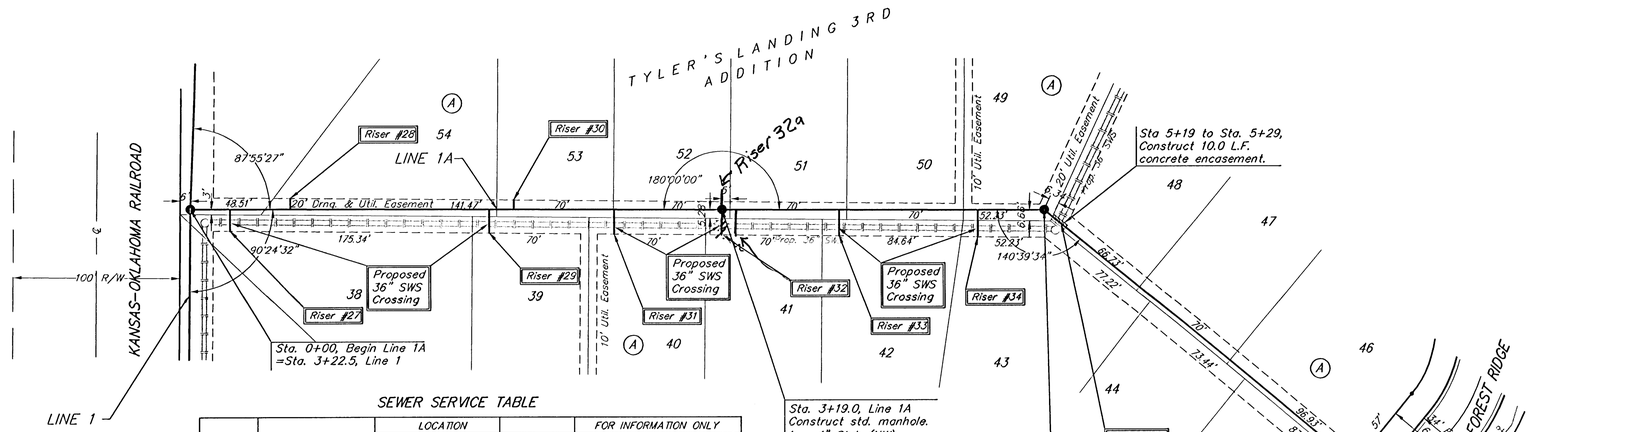

Scale: 1" = 40' Horizontal
1" = 5' Vertical
• = Iron


SEWER SERVICE TABLE

NUMBER	TYPE	LOCATION LOT NO.	BLOCK NO.	LINE NO.	STATION \ DIRECTION	FOR INFORMATION ONLY APPROXIMATE LENGTH 4" PIPE VERTICAL	HORIZONTAL
28	8" x 4" Tee	38	A	1A	0+24/Rt.	8.0'	13'
28	8" x 4" Tee	54	A	1A	0+61/Lt.	8.0'	7'
29	8" x 4" Tee	39	A	1A	1+80/Rt.	8.5'	13'
30	8" x 4" Tee	53	A	1A	1+94/Lt.	9.0'	7'
31	8" x 4" Tee	40	A	1A	2+55/Rt.	7.5'	13'
32	4" Stub	41	A	1A	3+~~19.0~~/Rt. 24	6.5'	~~14'~~ 15
33	8" x 4" Tee	42	A	1A	3+89/Rt.	5.5'	15'
34	8" x 4" Tee	43	A	1A	4+73/Rt.	4.5'	16'

NOTE: Vertical Riser Pipe shall be extended to 2' minimum above ground water elevation and 4' maximum below proposed ground elevation.

Riser added.

32a	8"x4" Tee	52	A	1A	3+19/Lt.		5'

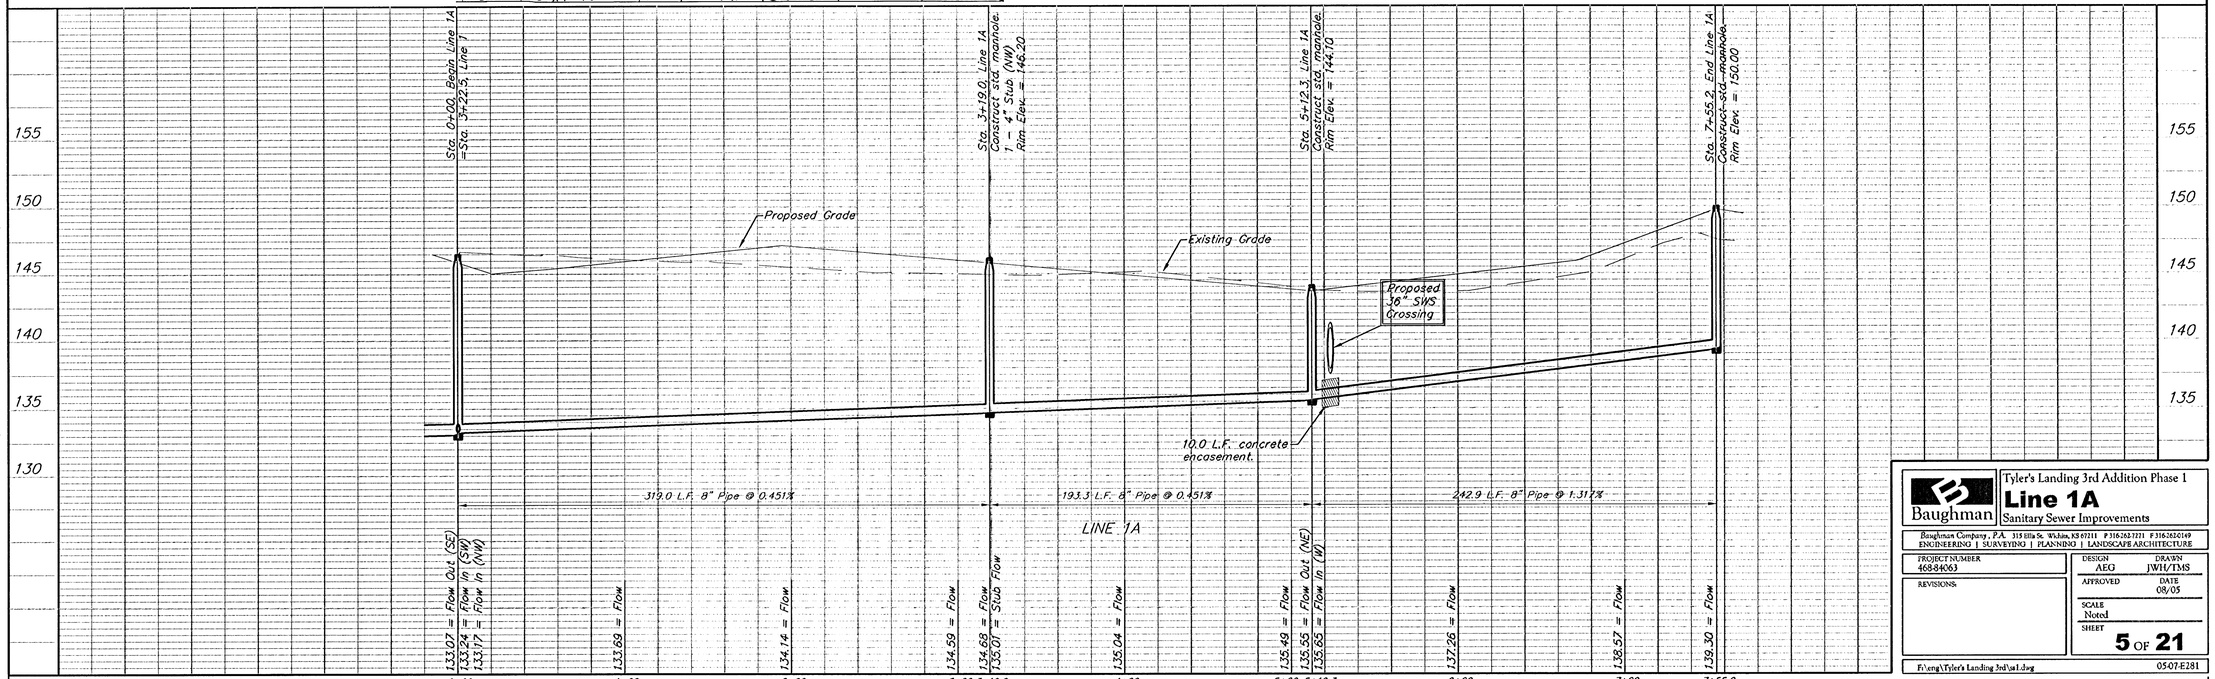

Baughman Company, P.A. 315 Ella St. Wichita, KS 67211 P 3162627271 F 3162620249
ENGINEERING | SURVEYING | PLANNING | LANDSCAPE ARCHITECTURE

Tyler's Landing 3rd Addition Phase 1
Line 1A
Sanitary Sewer Improvements

PROJECT NUMBER 468-84063
DESIGN AEG
DRAWN JWH/TMS
REVISIONS
APPROVED
DATE 08/05
SCALE Noted
SHEET **5 OF 21**

F:\eng\Tyler's Landing 3rd\ua1.dwg 05-07-E281