


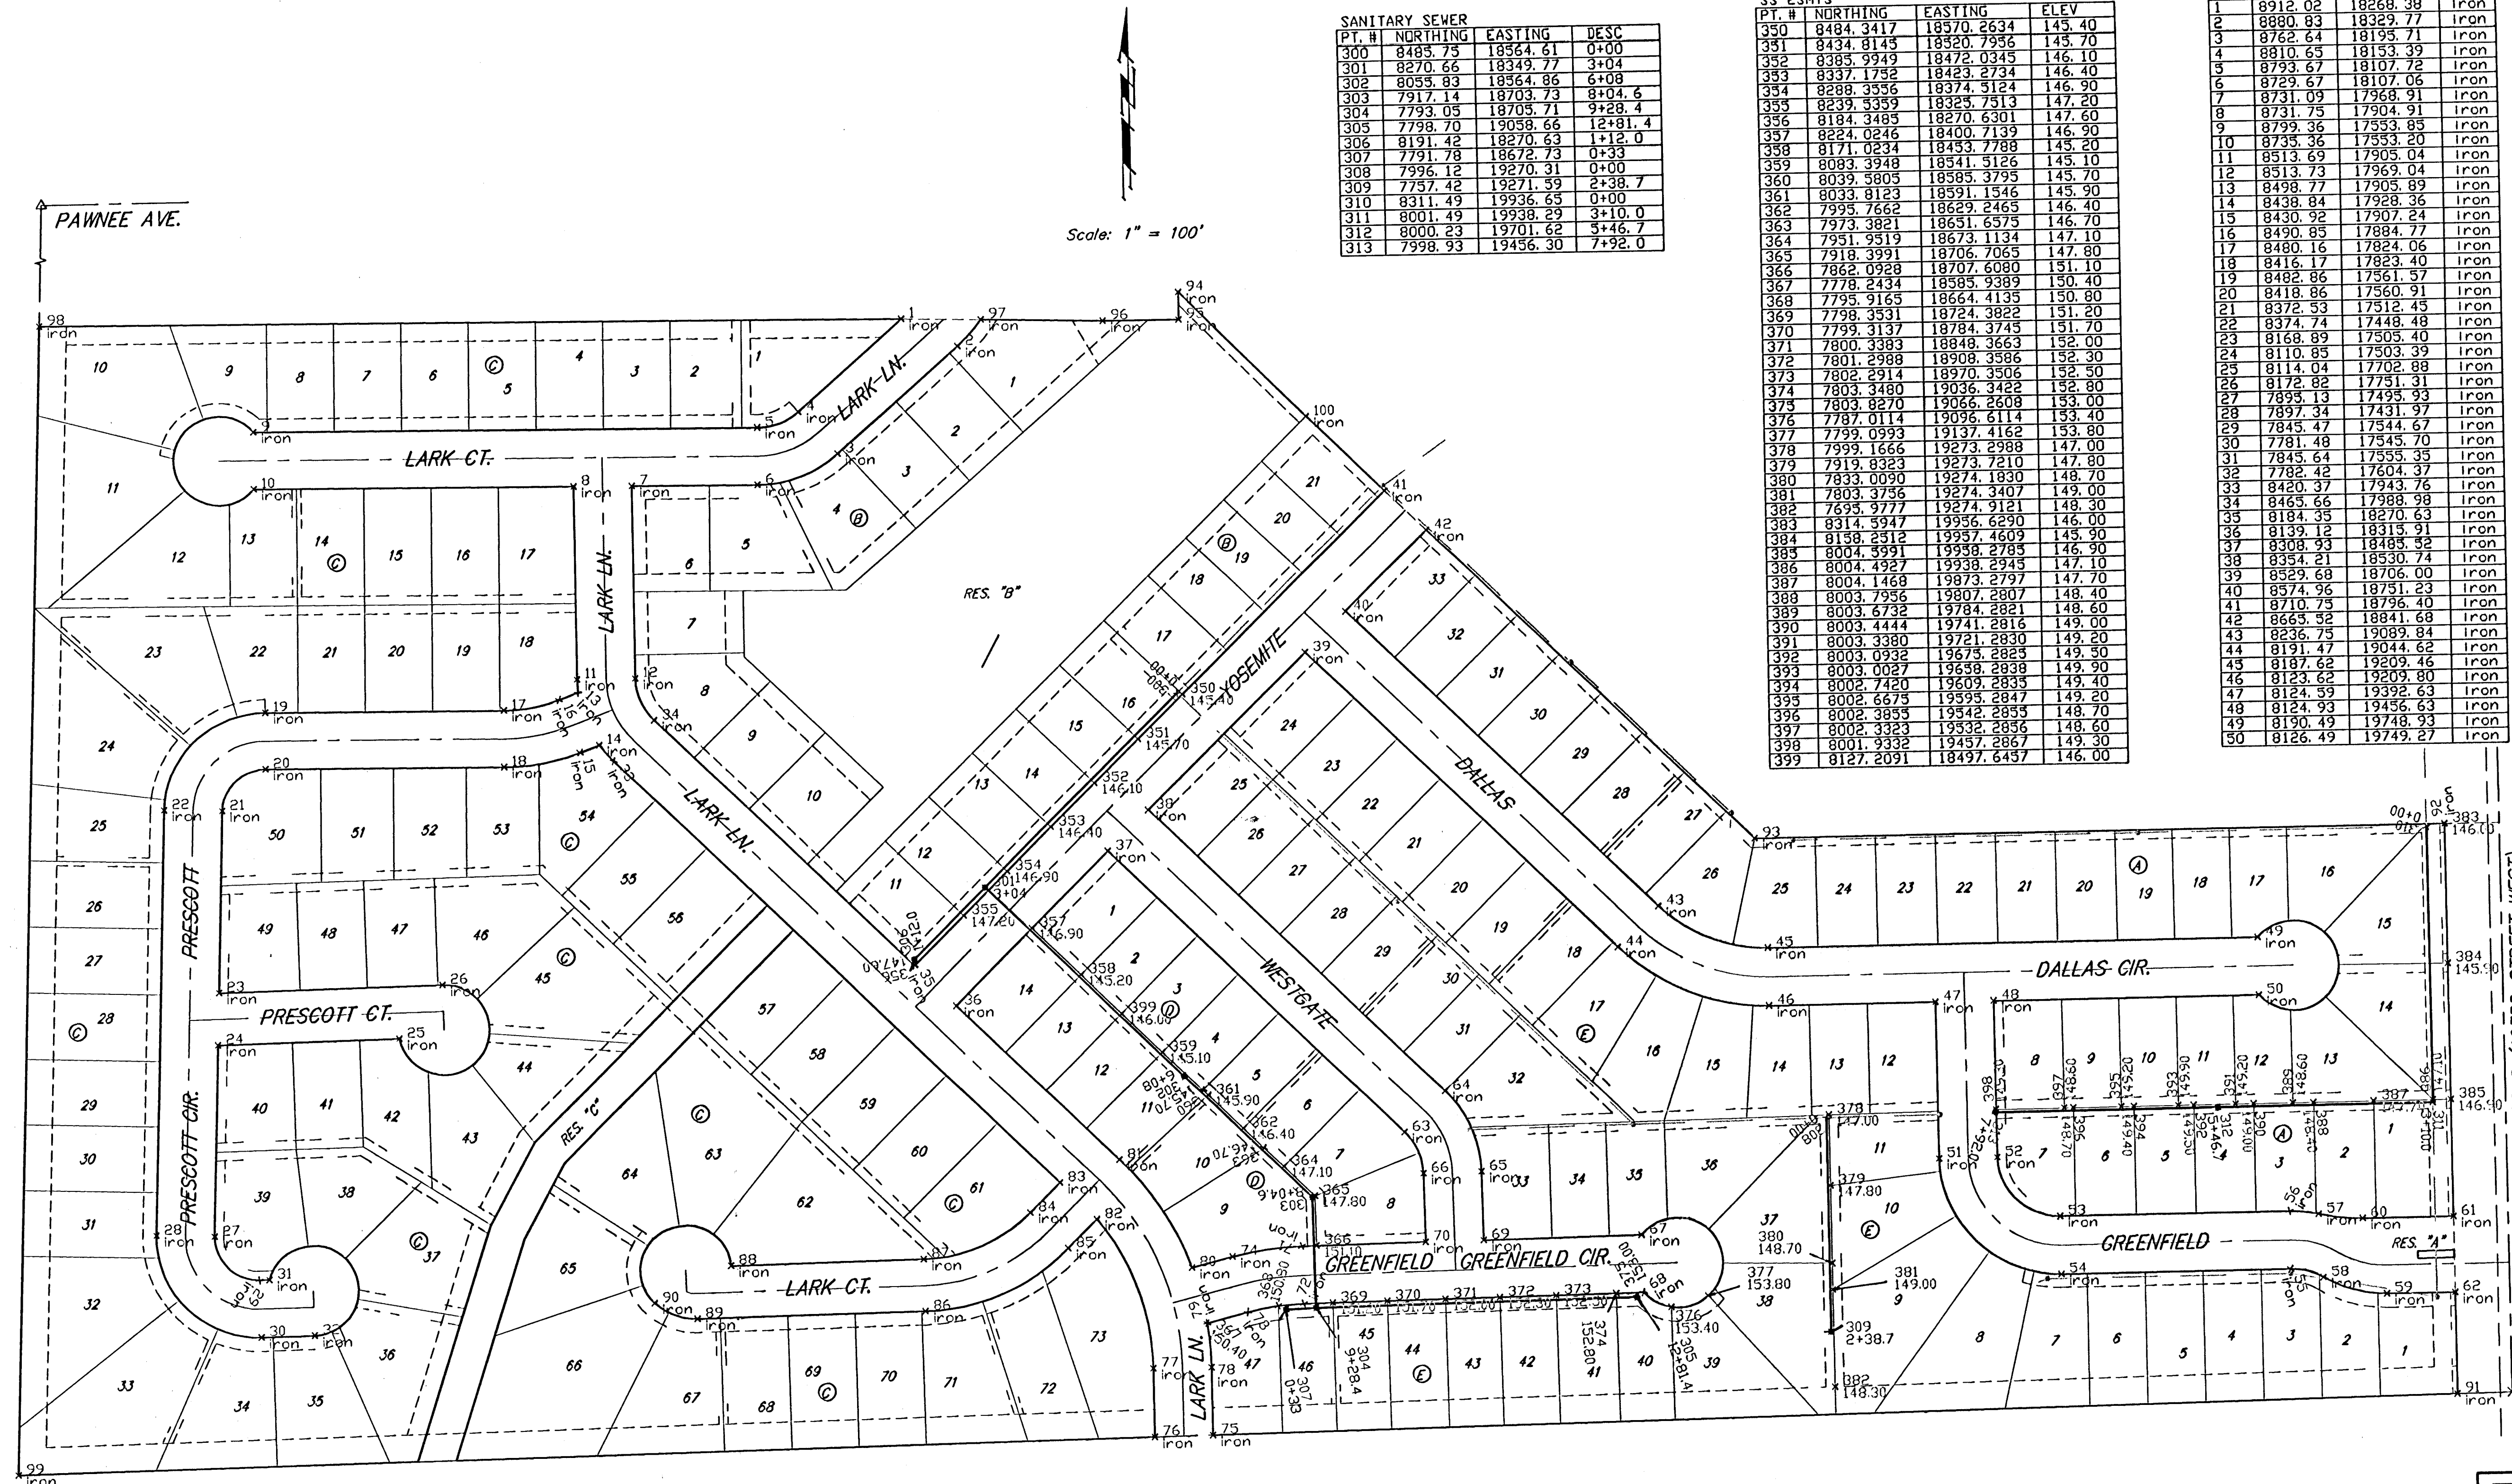

SANITARY SEWER			
PT. #	NORTHING	EASTING	DESC
300	8485.75	18564.61	0+0.0
301	8270.66	18349.77	3+0.4
302	8055.83	18564.86	6+0.8
303	7917.14	18703.73	8+04.6
304	7793.05	18705.71	9+28.4
305	7798.70	19058.66	12+81.4
306	8131.42	18270.63	1+12.0
307	7791.78	18672.73	0+33.0
308	7996.12	19270.31	0+00.0
309	7757.42	19271.59	2+38.7
310	8311.49	19936.65	0+00.0
311	8001.49	19938.29	3+10.0
312	8000.23	19701.62	5+46.7
313	7998.93	19436.30	7+32.0

SS ESMTS			
PT. #	NORTHING	EASTING	ELEV
350	8484.3417	18570.2634	145.40
351	8434.8145	18520.7956	145.70
352	8385.9949	18472.0345	146.10
353	8337.1752	18423.2734	146.40
354	8288.3356	18374.5124	146.90
355	8239.5359	18325.7513	147.20
356	8184.3485	18270.6301	147.60
357	8224.0246	18400.7139	146.90
358	8171.0234	18453.7788	145.20
359	8083.3948	18541.5126	145.10
360	8039.5805	18595.3795	145.70
361	8033.8123	18591.1546	145.90
362	7995.7662	18629.2465	146.40
363	7973.3821	18651.6575	146.70
364	7951.9519	18673.1134	147.10
365	7918.3991	18706.7065	147.80
366	7862.0928	18707.6080	151.10
367	7778.2434	18595.9382	150.40
368	7795.9165	18664.4135	150.80
369	7798.3591	18724.3822	151.20
370	7799.3137	18784.3745	151.70
371	7800.3383	18848.3663	152.00
372	7801.2988	18908.3586	152.30
373	7802.2914	18970.3506	152.50
374	7803.3480	19036.3432	152.80
375	7803.3270	19066.2608	153.00
376	7787.0114	19096.6114	153.40
377	7799.0993	19137.4162	153.80
378	7999.1666	19273.2988	147.00
379	7919.8323	19273.7210	147.80
380	7833.0090	19274.1930	148.70
381	7803.3756	19274.3407	149.00
382	7695.9777	19274.9121	148.30
383	8314.5947	19956.6290	146.00
384	8158.2512	19957.4609	145.90
385	8004.3991	19958.2785	146.90
386	8004.4927	19938.2945	147.10
387	8004.1468	19973.2797	147.70
388	8003.7956	19807.2807	148.40
389	8003.6732	19784.2821	148.60
390	8003.4444	19741.2816	149.00
391	8003.3380	19721.2830	149.20
392	8003.0932	19675.2823	149.50
393	8003.0027	19588.2838	149.90
394	8002.7420	19509.2835	149.40
395	8002.6675	19595.2847	149.20
396	8002.3855	19542.2853	148.70
397	8002.3323	19532.2856	148.60
398	8001.9332	19457.2867	149.30
399	8127.2091	18497.6437	146.00

IRONS			
PT. #	NORTHING	EASTING	DESC
1	8912.02	18268.38	Iron
2	8880.83	18329.77	Iron
3	8762.64	18195.71	Iron
4	8810.65	18153.39	Iron
5	8793.67	18107.72	Iron
6	8729.67	18107.06	Iron
7	8731.09	17968.91	Iron
8	8731.75	17904.91	Iron
9	8799.36	17553.85	Iron
10	8735.36	17553.20	Iron
11	8513.69	17905.04	Iron
12	8513.73	17969.04	Iron
13	8498.77	17905.89	Iron
14	8438.84	17928.36	Iron
15	8430.92	17907.24	Iron
16	8490.85	17884.77	Iron
17	8480.16	17824.06	Iron
18	8416.17	17823.40	Iron
19	8482.86	17561.57	Iron
20	8418.86	17560.91	Iron
21	8372.53	17512.45	Iron
22	8374.74	17448.48	Iron
23	8168.89	17505.40	Iron
24	8110.85	17503.39	Iron
25	8114.04	17702.88	Iron
26	8172.82	17751.31	Iron
27	7895.13	17495.93	Iron
28	7897.34	17431.97	Iron
29	7845.47	17544.67	Iron
30	7781.48	17545.77	Iron
31	7845.64	17553.35	Iron
32	7782.42	17604.37	Iron
33	8420.37	17943.76	Iron
34	8465.66	17988.98	Iron
35	8184.35	18270.63	Iron
36	8139.12	18315.81	Iron
37	8308.93	18465.92	Iron
38	8354.21	18530.74	Iron
39	8529.68	18706.00	Iron
40	8574.96	18751.23	Iron
41	8710.75	18796.40	Iron
42	8665.52	18841.68	Iron
43	8836.75	19099.84	Iron
44	8191.47	19044.62	Iron
45	8187.62	19209.46	Iron
46	8123.62	19209.80	Iron
47	8124.59	19392.63	Iron
48	8124.93	19456.63	Iron
49	8130.49	19748.93	Iron
50	8126.49	19749.27	Iron

50	8126.49	19749.27	Iron
51	7947.76	19393.57	Iron
52	7948.10	19457.57	Iron
53	7880.46	19525.93	Iron
54	7816.46	19526.27	Iron
55	7817.81	19779.05	Iron
56	7881.81	19778.71	Iron
57	7878.04	19810.75	Iron
58	7807.63	19814.89	Iron
59	7788.45	19884.43	Iron
60	7872.32	19859.30	Iron
61	7872.85	19958.98	Iron
62	7788.85	19959.43	Iron
63	7988.41	18806.42	Iron
64	8033.69	18851.64	Iron
65	7942.41	18890.35	Iron
66	7941.39	18826.35	Iron
67	7867.82	19065.24	Iron
68	7803.83	19066.26	Iron
69	7865.04	18891.58	Iron
70	7864.01	18827.59	Iron
71	7861.83	18691.45	Iron
72	7797.84	18692.48	Iron
73	7789.64	18630.83	Iron
74	7851.67	18615.08	Iron
75	7655.01	18590.16	Iron
76	7653.99	18526.17	Iron
77	7729.38	18523.77	Iron
78	7729.72	18589.76	Iron
79	7718.24	18585.94	Iron
80	7840.28	18570.19	Iron
81	7962.86	18492.39	Iron
82	7895.97	18466.57	Iron
83	7938.07	18426.64	Iron
84	7904.96	18393.58	Iron
85	7863.98	18434.61	Iron
86	7796.84	18276.26	Iron
87	7854.83	18275.33	Iron
88	7851.43	18063.18	Iron
89	7792.82	18025.51	Iron
90	7811.28	17978.66	Iron
91	7676.94	19960.02	Iron
92	8314.59	19956.64	Iron
93	8310.55	19197.08	Iron
94	8936.11	18573.53	Iron
95	8906.11	18573.54	Iron
96	8906.06	18490.11	Iron
97	8909.86	18355.93	Iron
98	8921.77	17320.31	Iron
99	7633.84	17275.96	Iron
100	8795.55	18711.50	Iron

SOUTHERN RIDGE 3RD ADDITION - PH II
STAKING COORDINATE SHEET
SANITARY SEWER IMPROVEMENTS

ENGINEERING | SURVEYING | PLANNING | LANDSCAPE ARCHITECTURE

PROJECT NUMBER
468-83966

DESIGN
AEO

DRAWN
TMS

APPROVED
AEO

DATE
11/05

SCALE
Noted

SHEET
15 OF 16

SouthernRidge3rd/Phase2/SSCoords0508-E312