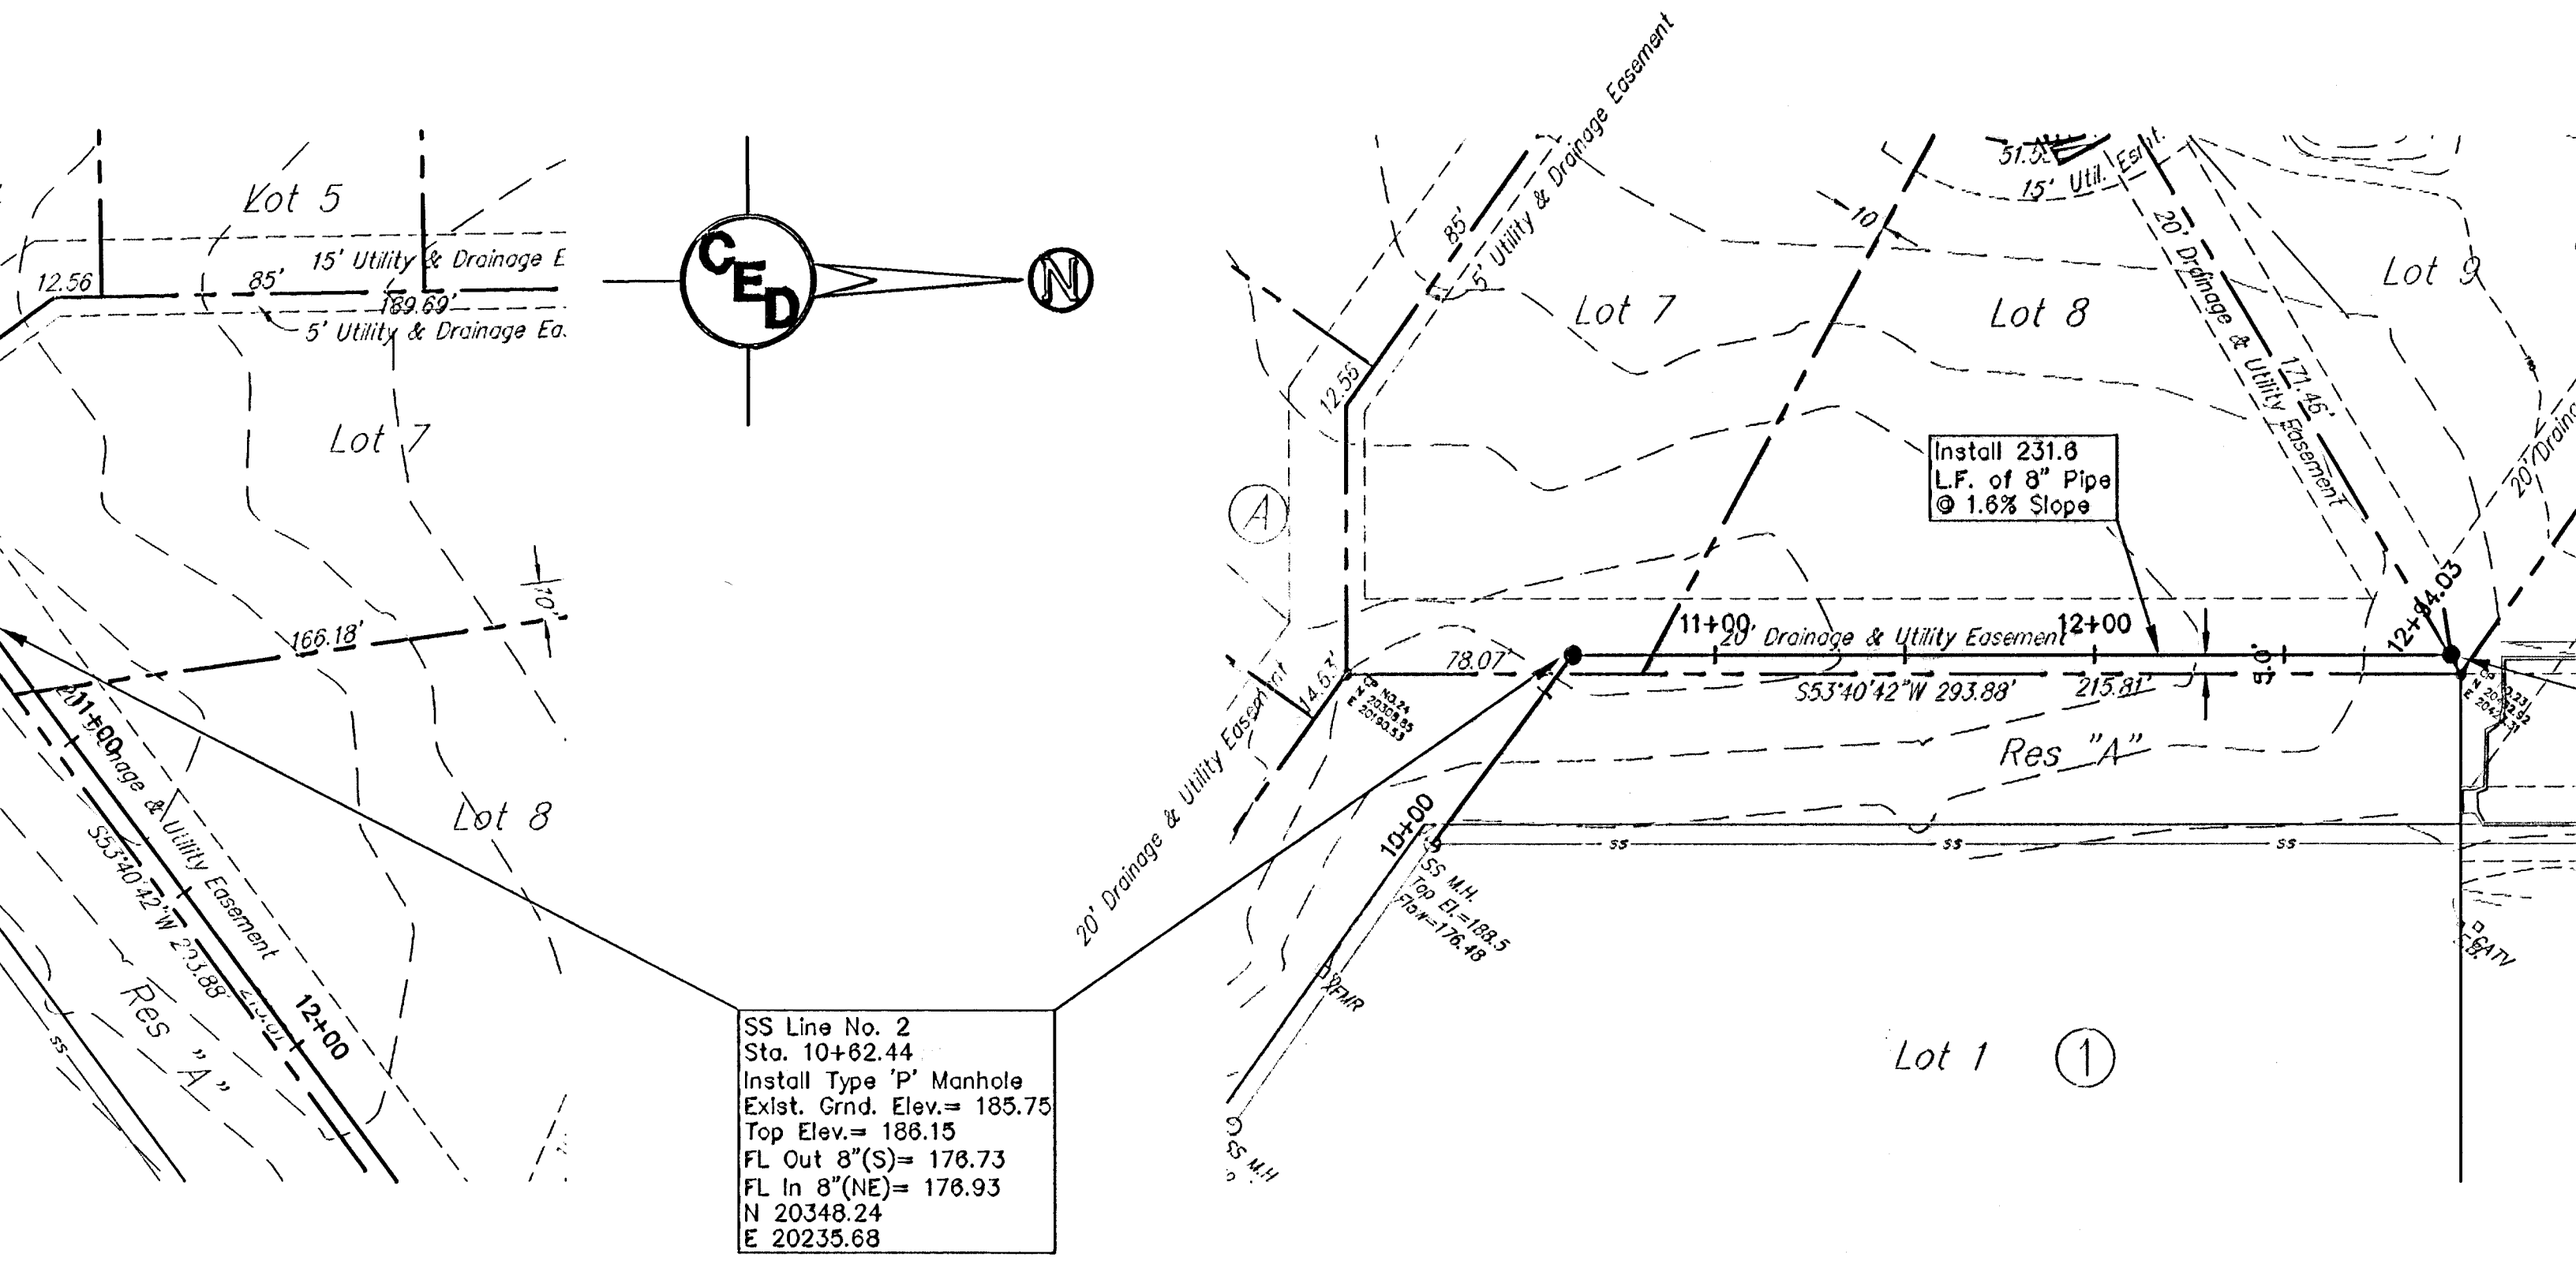
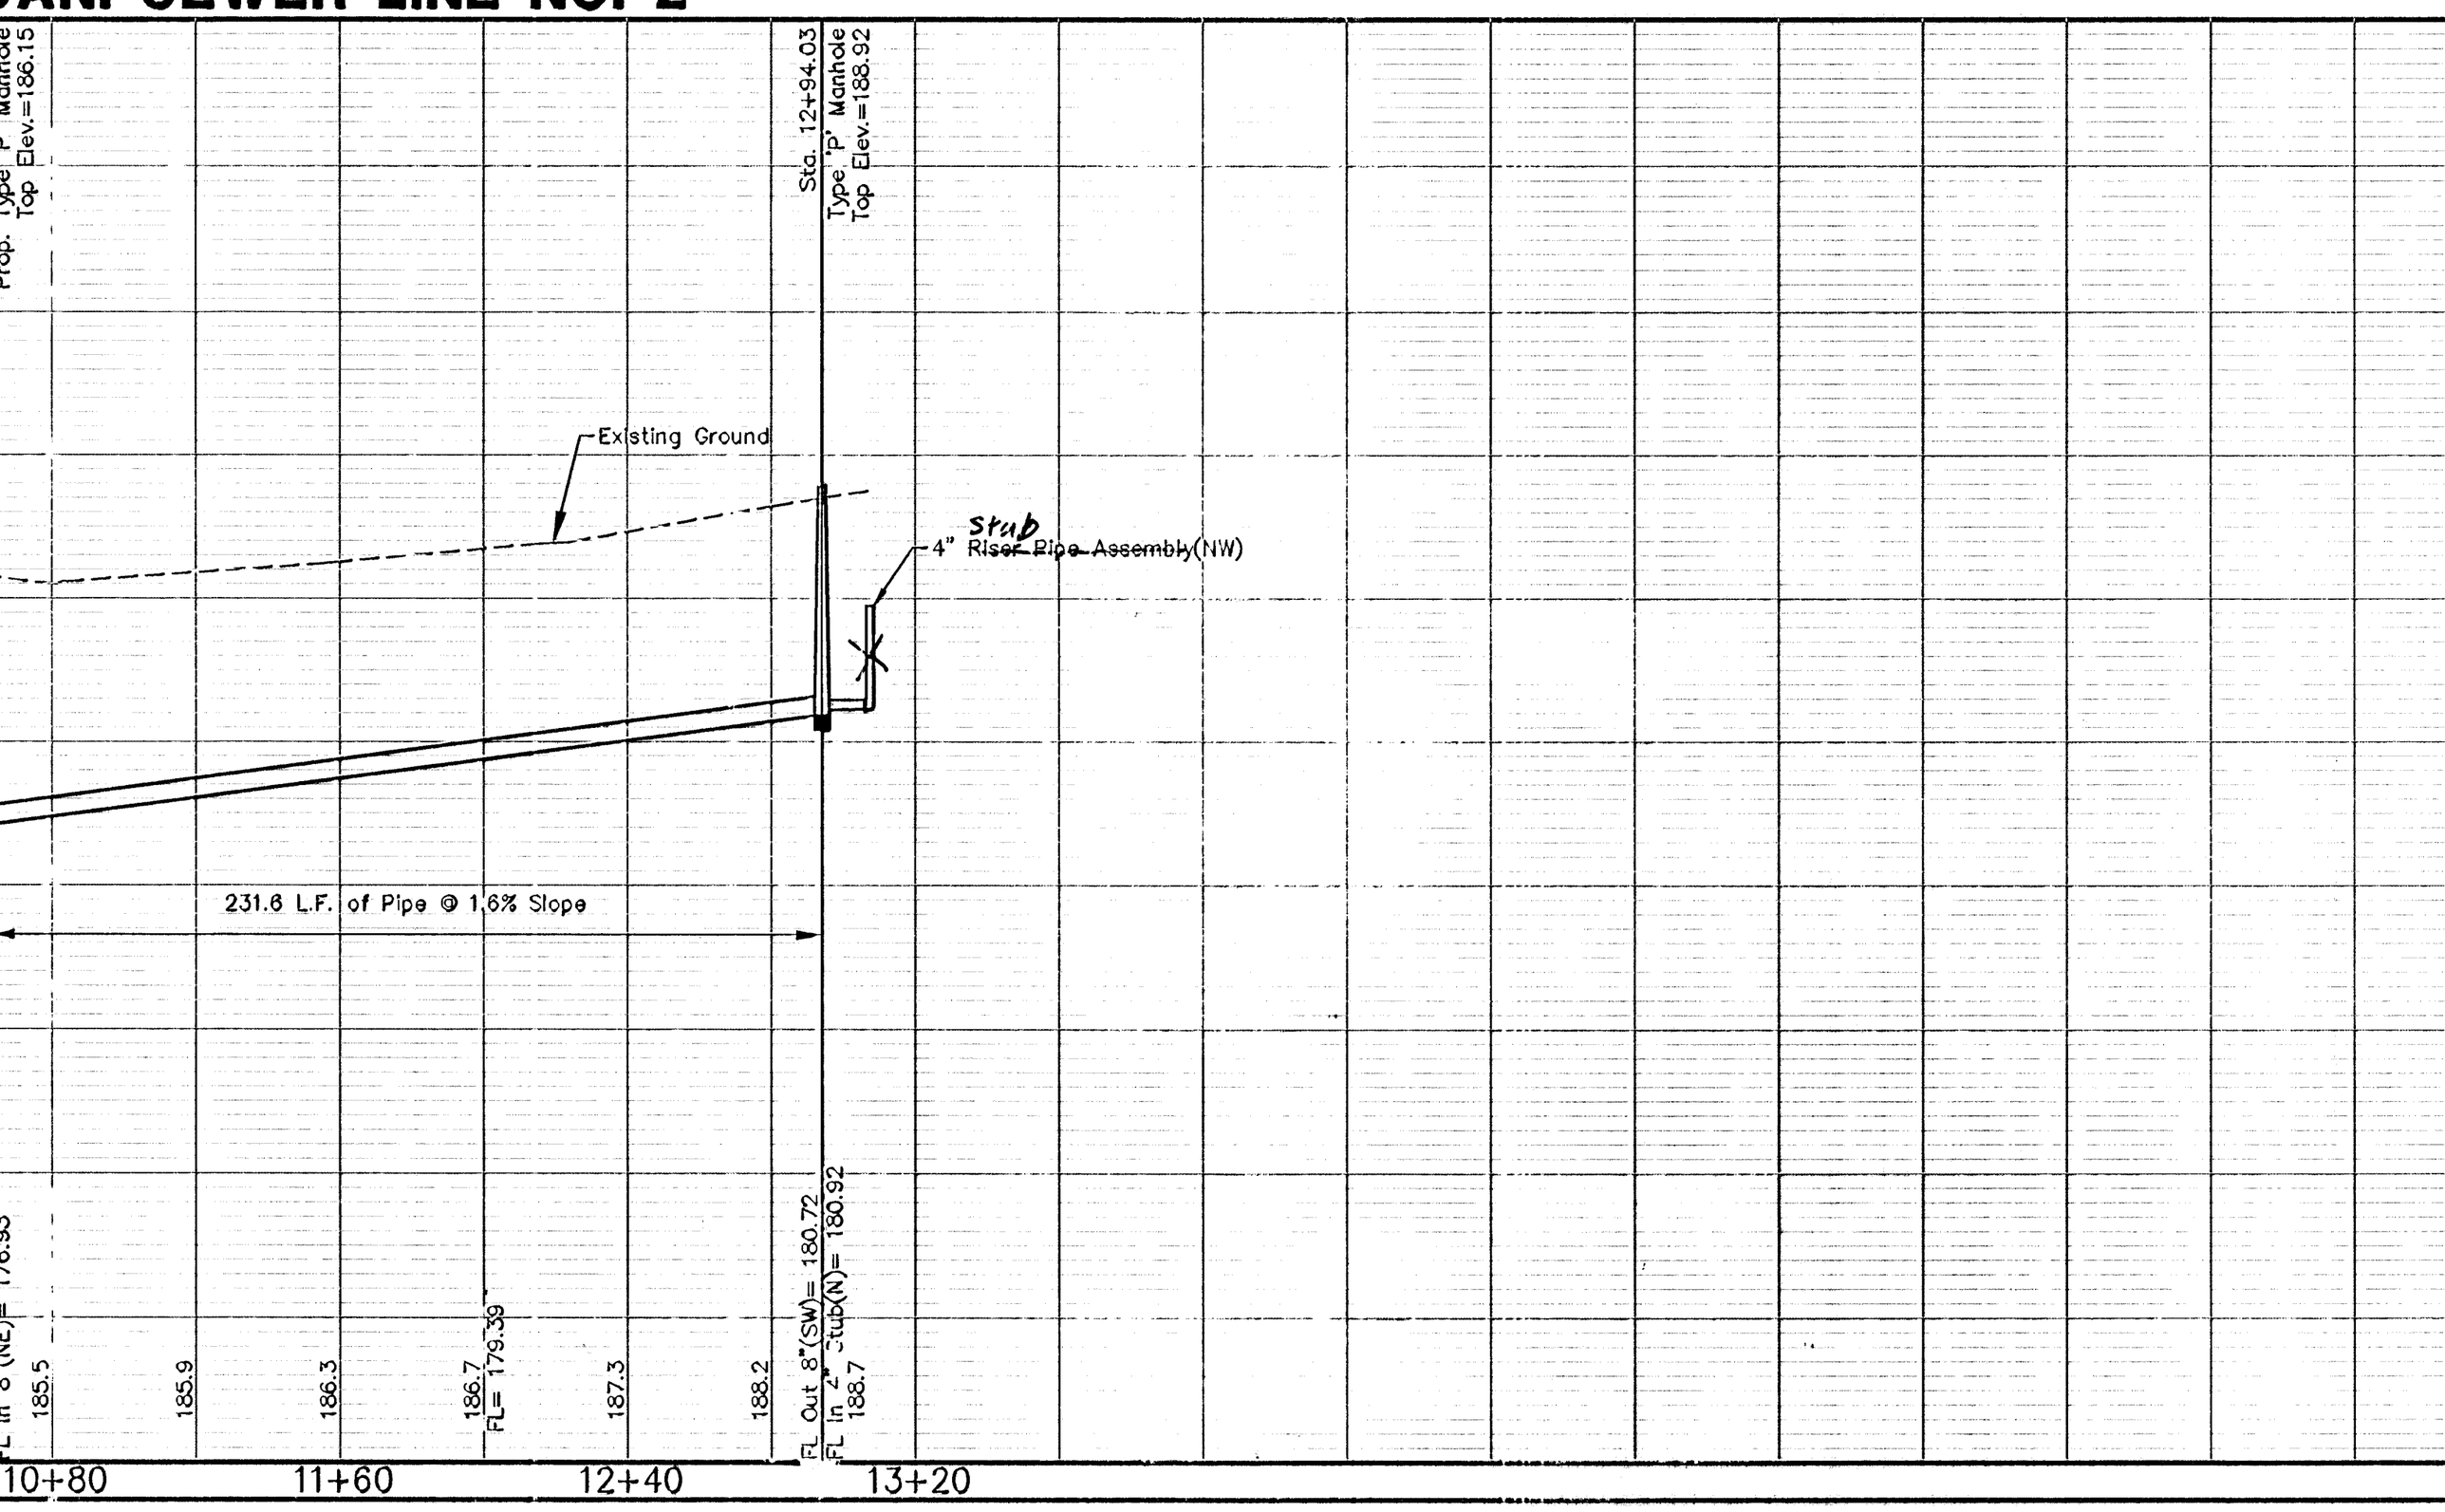
SAN. SEWER LINE NO. 2