

FOR INFORMATION ONLY (To be determined by measure.)		
	VERTICAL DEPTH	HORIZONTAL
	19.75'	15'
	19'	15'
3	18'	15'
	8.6'	4'
	6.18'	13'
	9.56'	7'
	9.56'	32'

STM D 2665)
and water





VERTICAL RISER DETAILS

ADOPTED AS STANDARD DESIGN

BY

CITY OF WICHITA, KANSAS

OCTOBER 1992

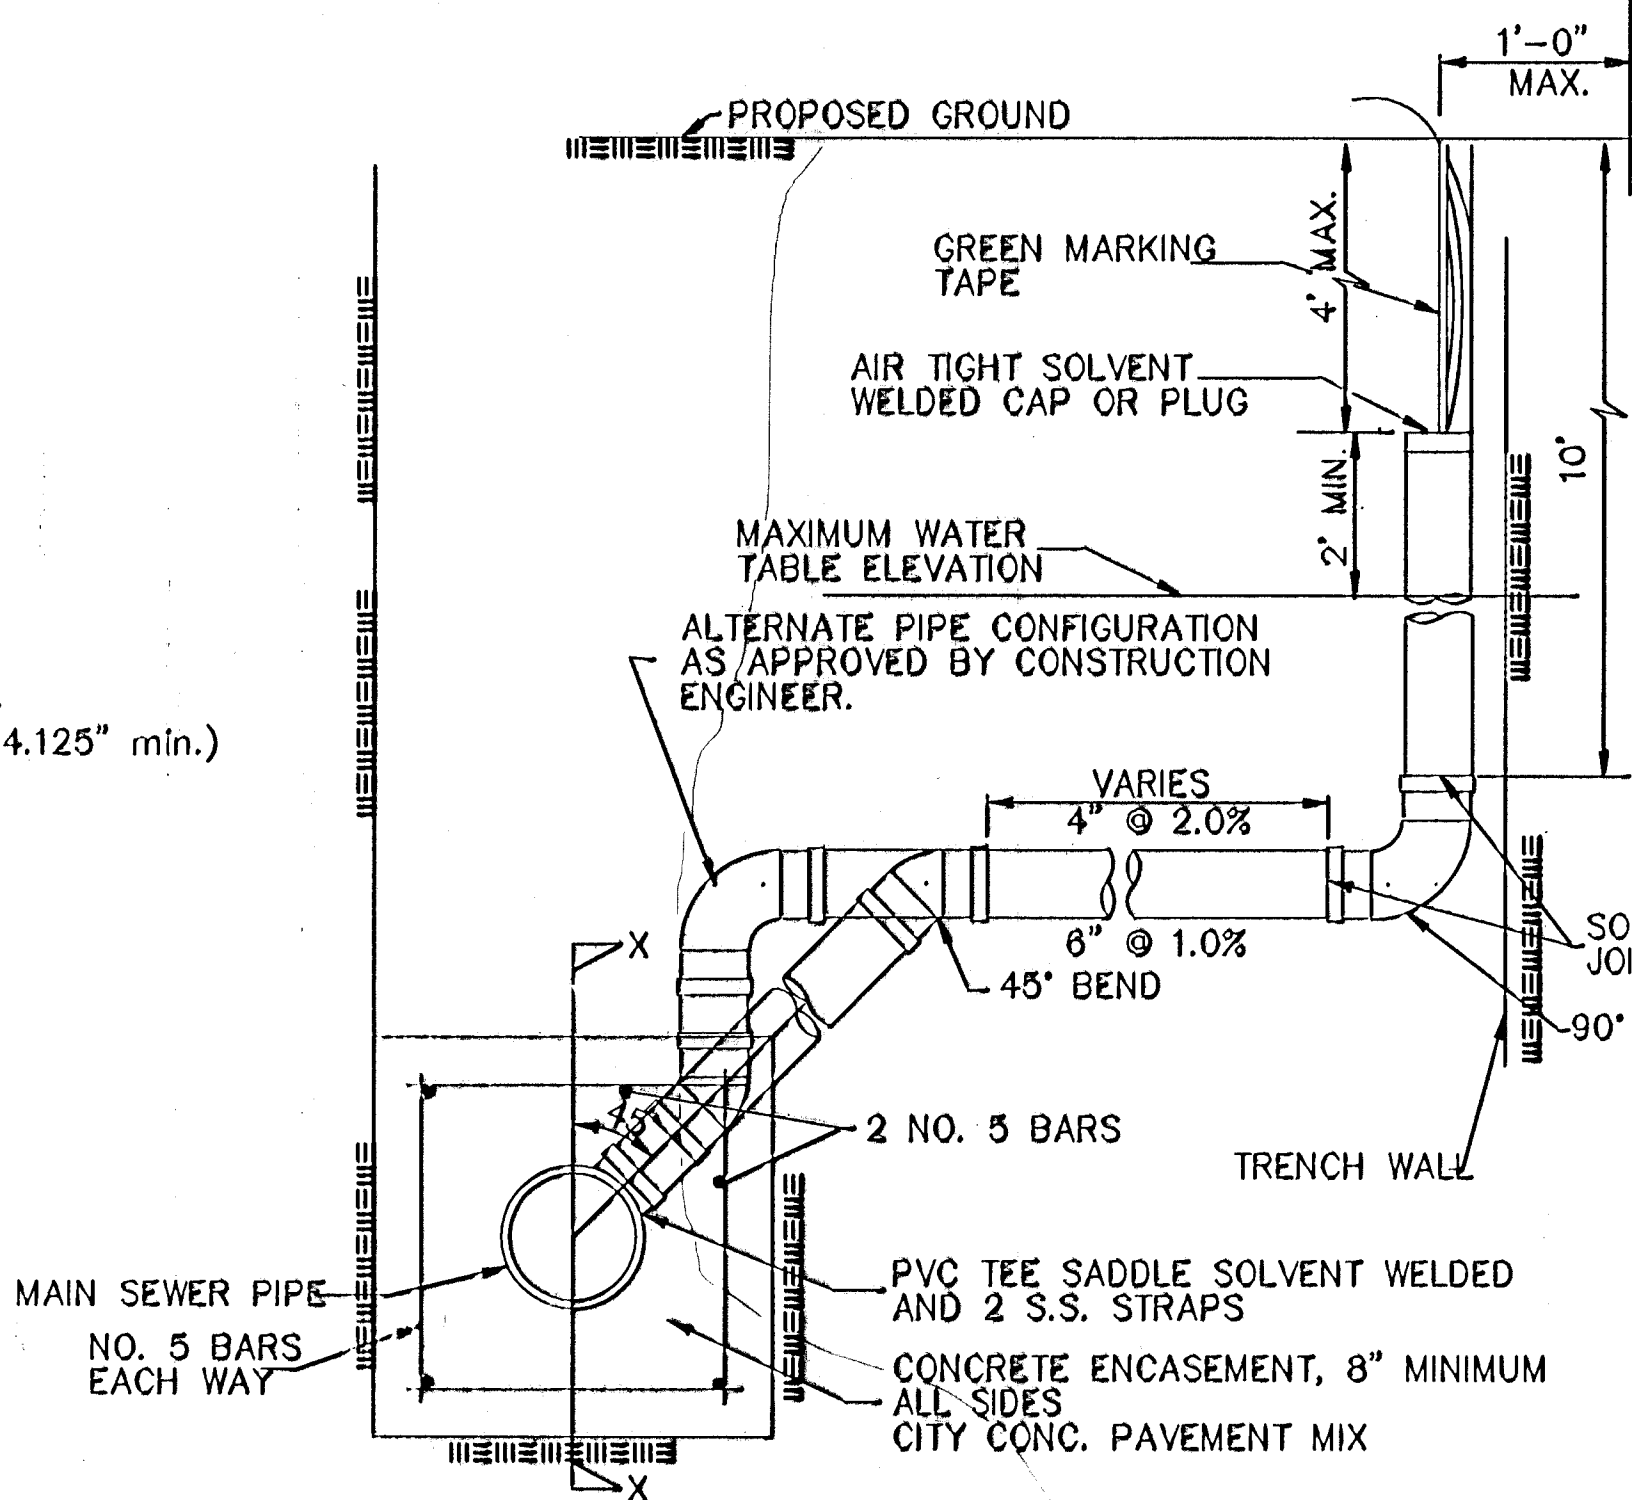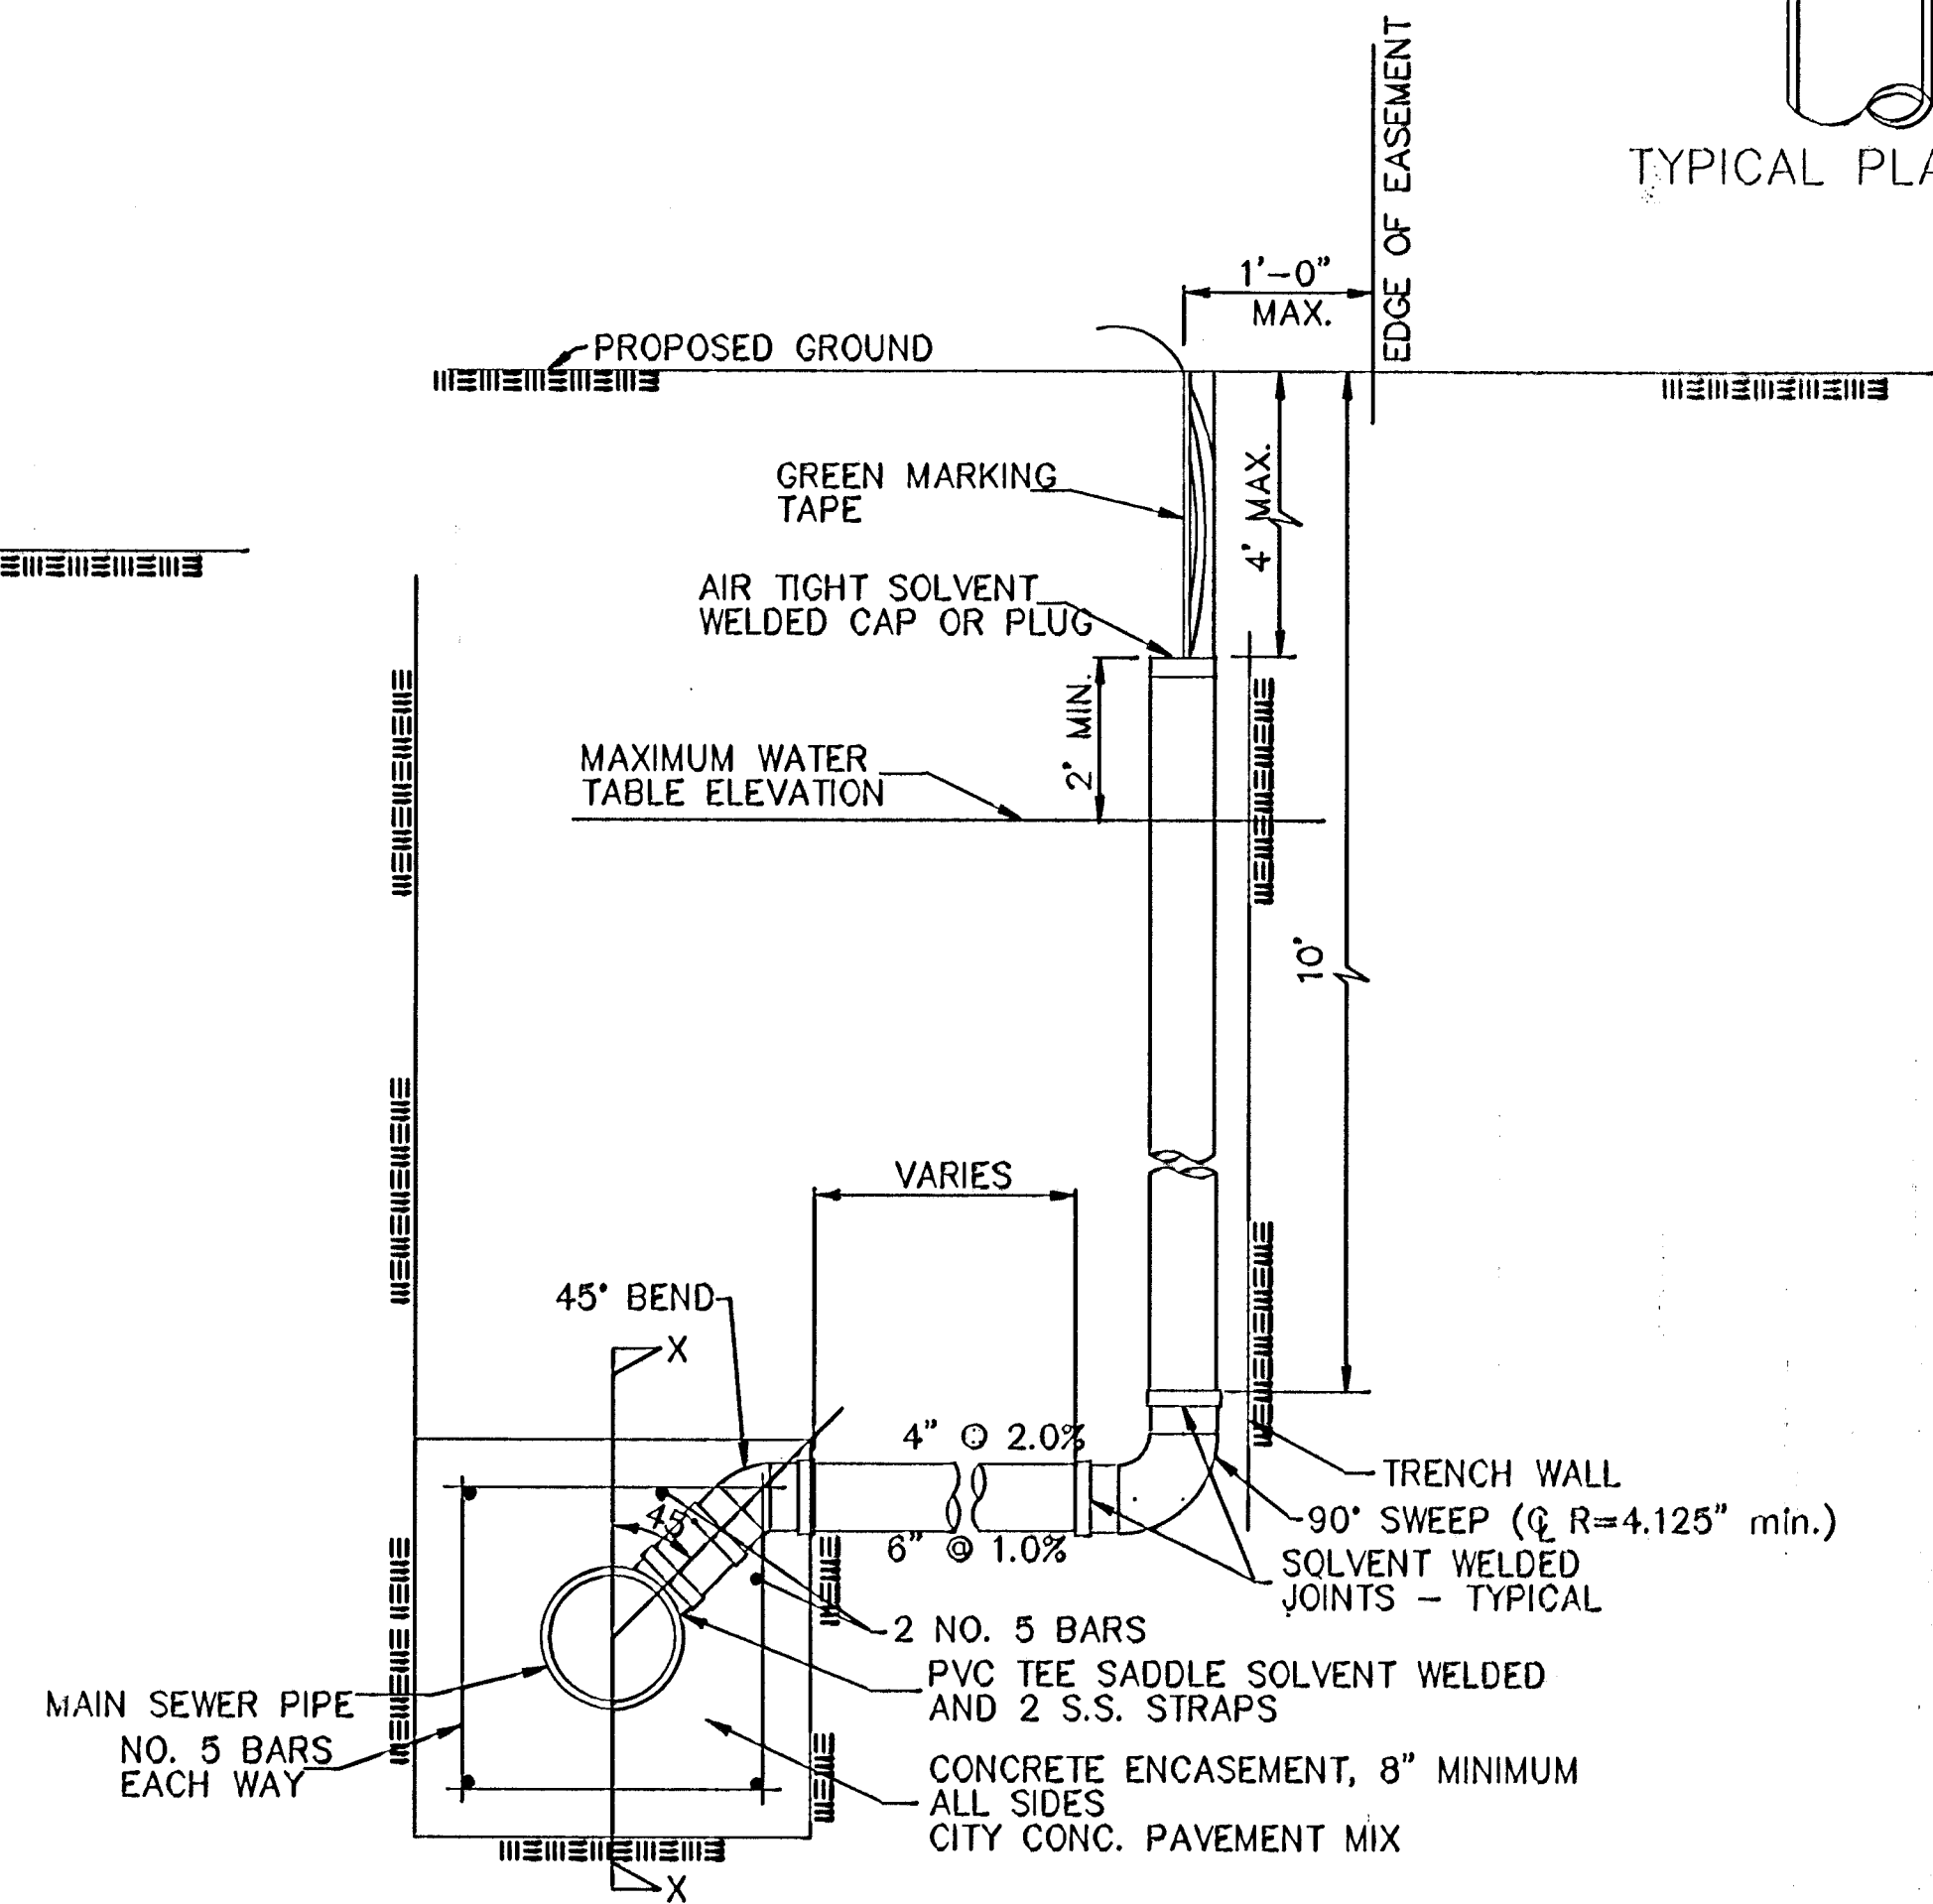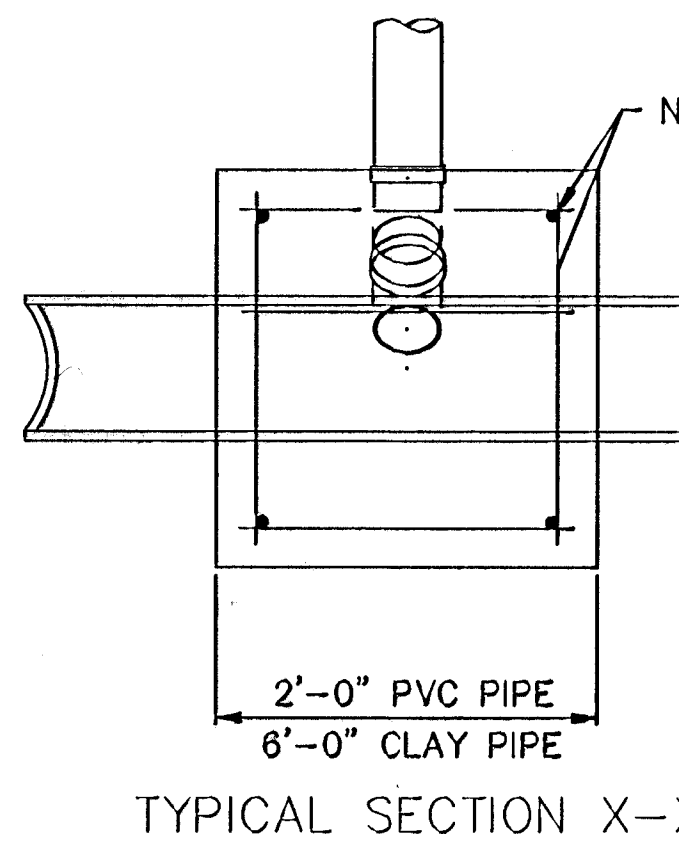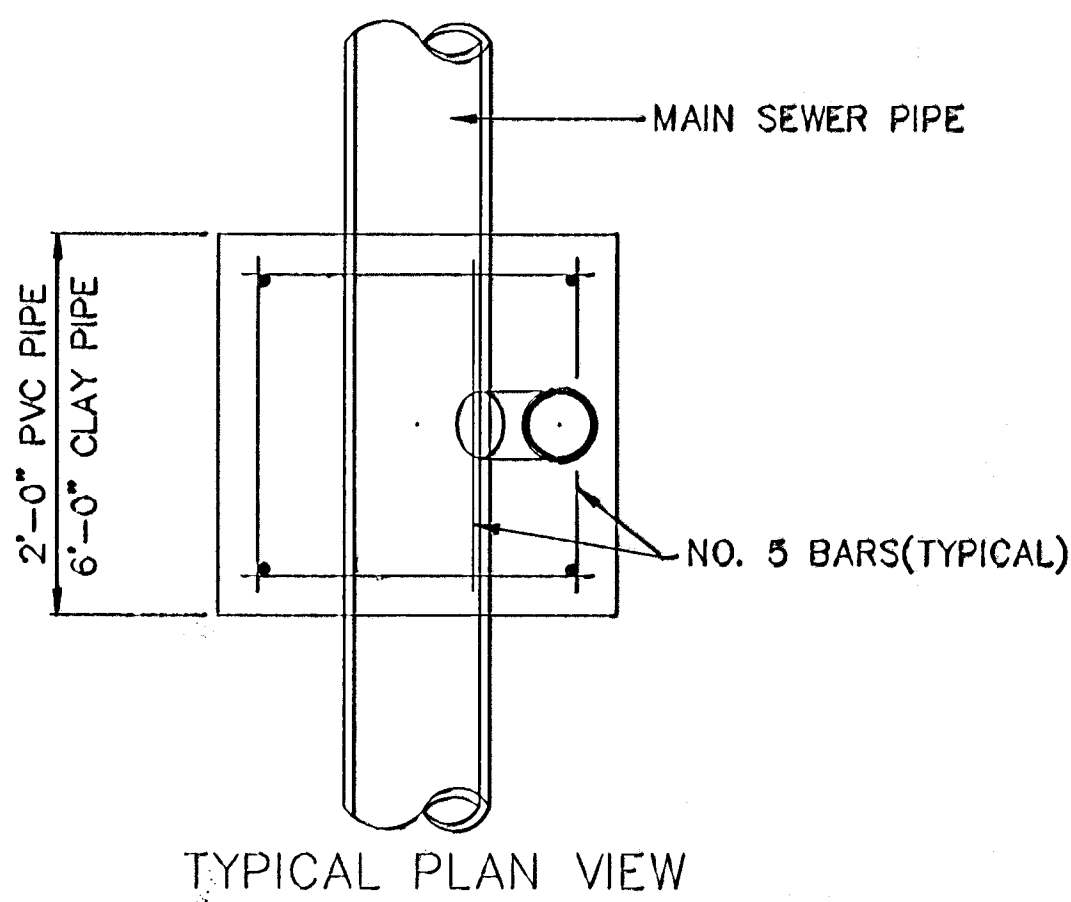

WELDED
MINIMUM

RISER PIPE REQUIREMENTS AT MANHOLE STUBS SHALL BE SIMILAR TO THOSE SHOWN ABOVE.