


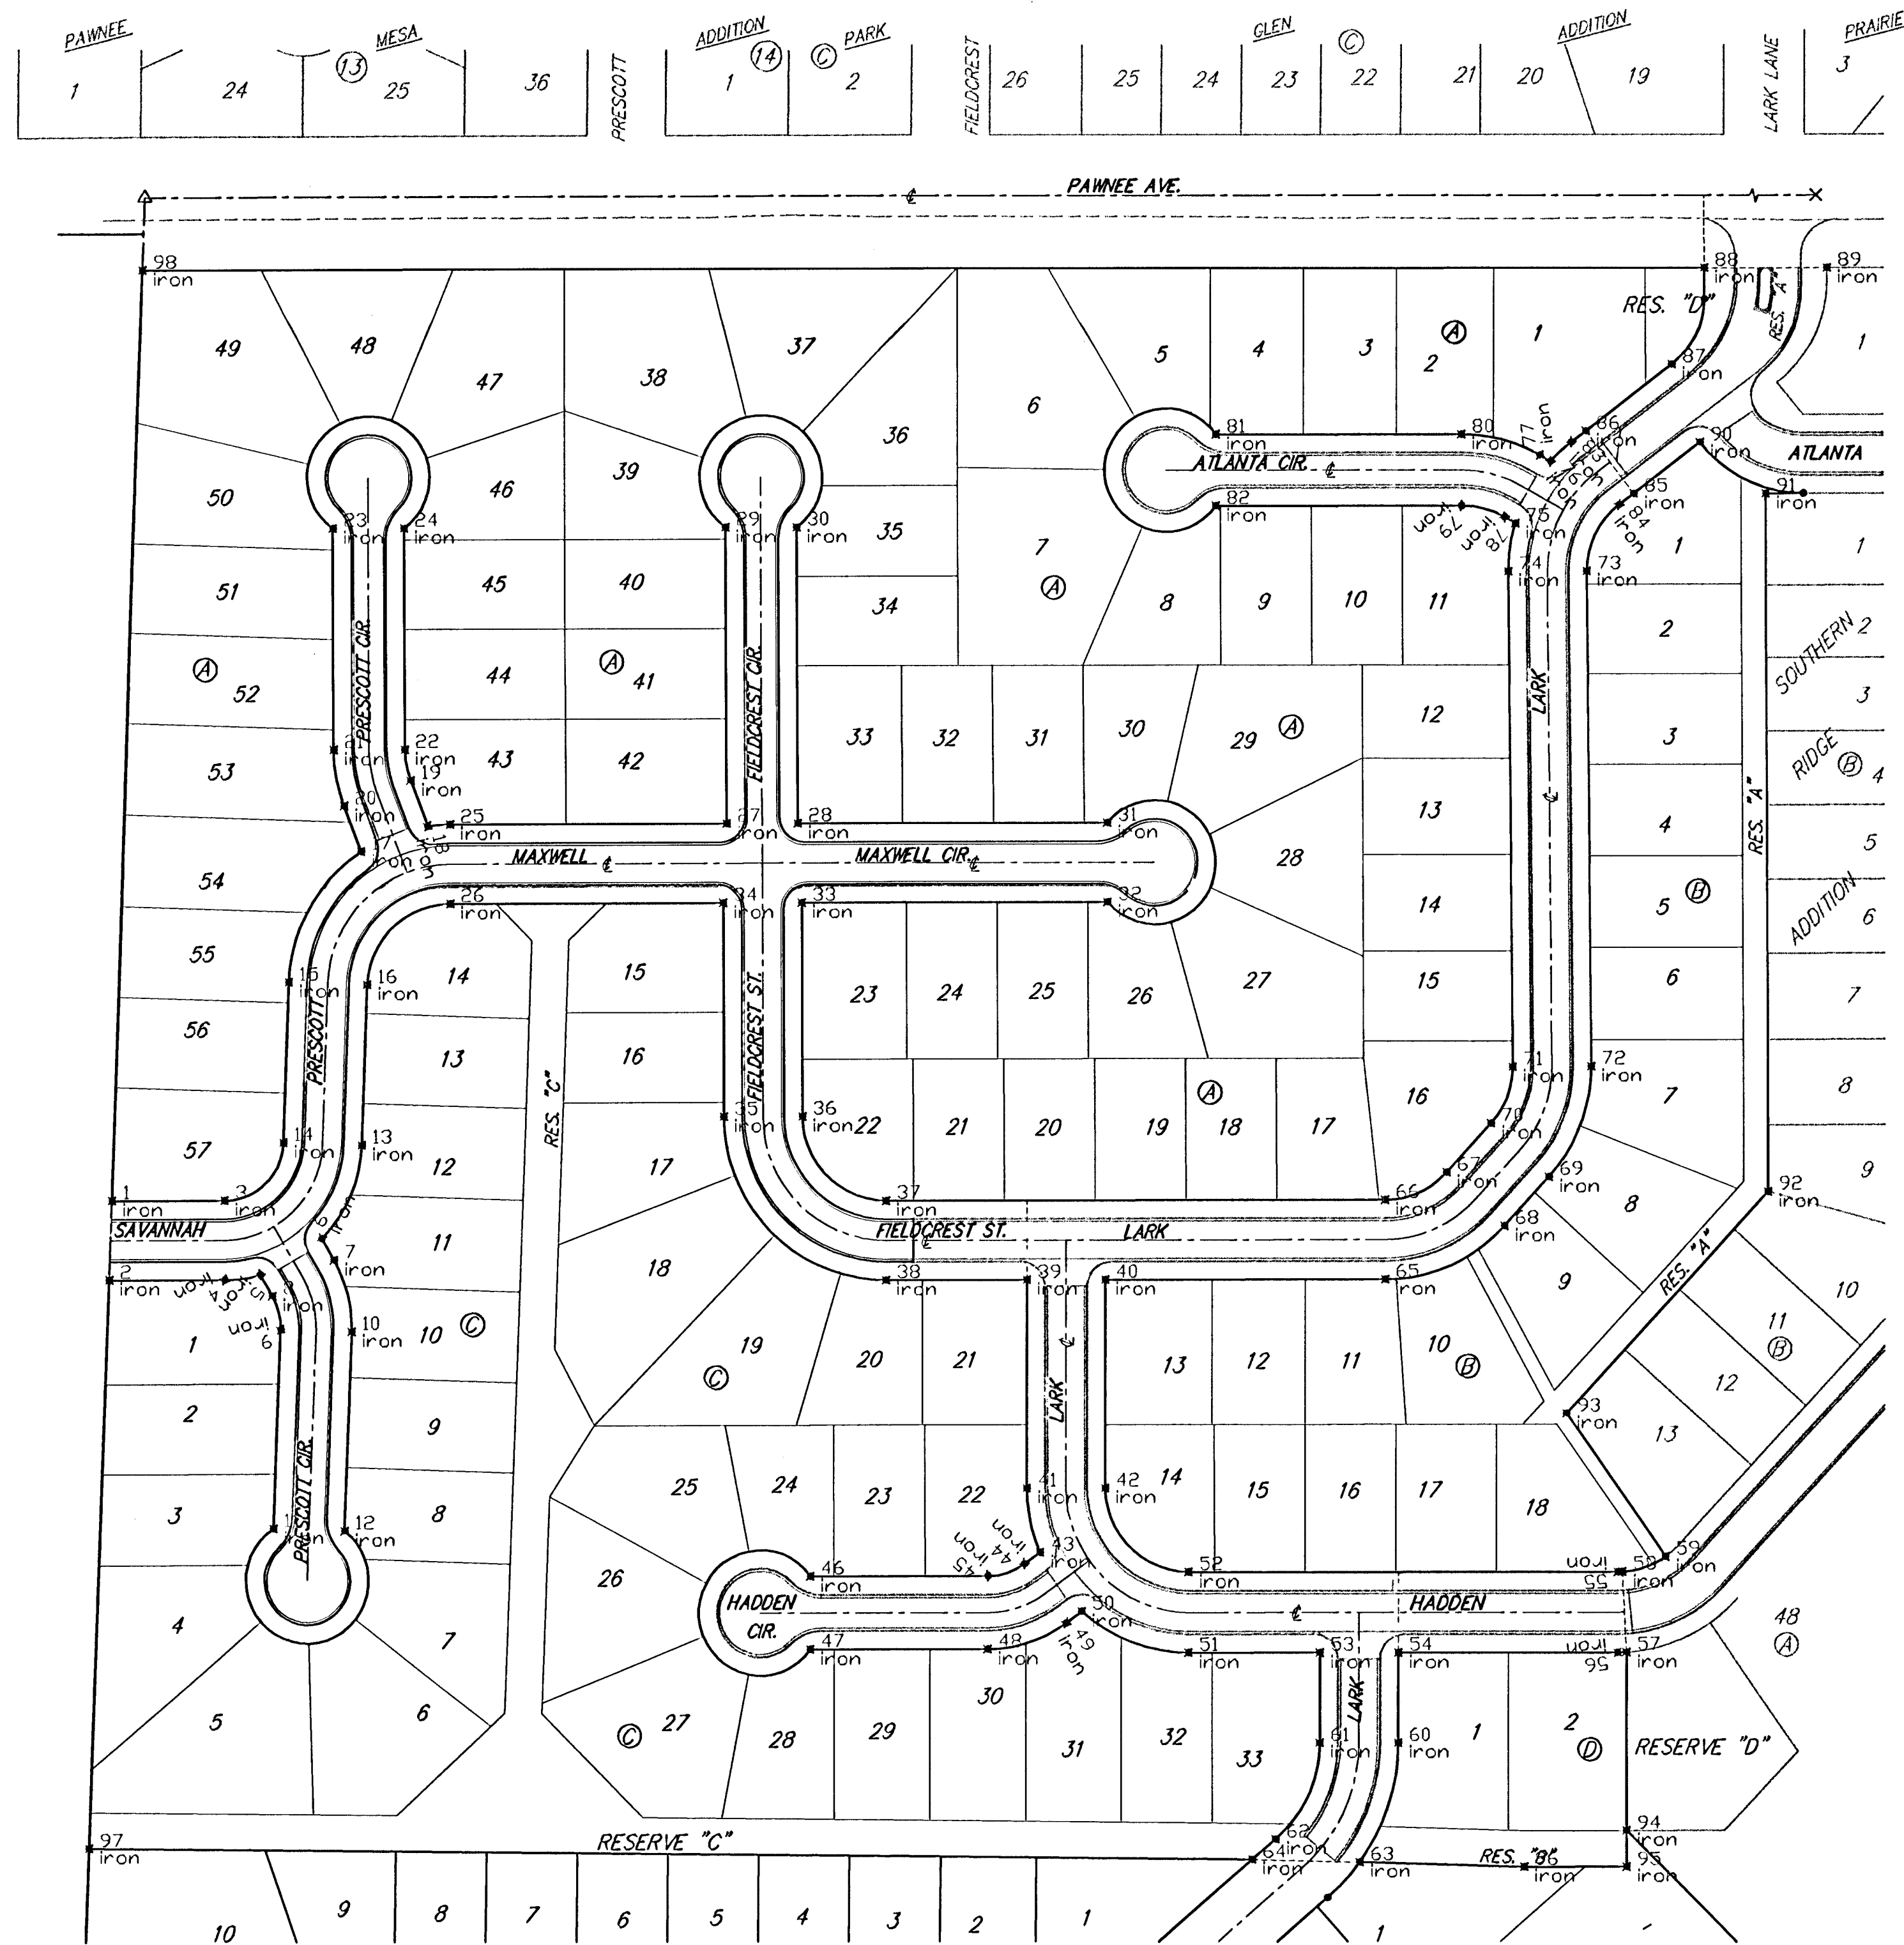

Scale: 1" = 100'

| POINT | NORTHING | EASTING  | DESC |
|-------|----------|----------|------|
| 1     | 9449.29  | 17338.56 | iron |
| 2     | 9385.29  | 17336.35 | iron |
| 3     | 9449.35  | 17430.30 | iron |
| 4     | 9385.35  | 17430.34 | iron |
| 5     | 9389.16  | 17459.26 | iron |
| 6     | 9418.17  | 17509.49 | iron |
| 7     | 9400.92  | 17519.45 | iron |
| 8     | 9371.91  | 17469.22 | iron |
| 9     | 9344.63  | 17476.02 | iron |
| 10    | 9342.64  | 17533.99 | iron |
| 11    | 9181.66  | 17470.39 | iron |
| 12    | 9179.66  | 17528.35 | iron |
| 13    | 9493.48  | 17542.51 | iron |
| 14    | 9495.69  | 17478.25 | iron |
| 15    | 9627.02  | 17482.79 | iron |
| 16    | 9624.81  | 17546.75 | iron |
| 17    | 9732.78  | 17542.23 | iron |
| 18    | 9753.20  | 17596.52 | iron |
| 19    | 9789.97  | 17582.69 | iron |
| 20    | 9769.55  | 17528.40 | iron |
| 21    | 9814.89  | 17520.14 | iron |
| 22    | 9814.92  | 17578.14 | iron |
| 23    | 9996.67  | 17520.03 | iron |
| 24    | 9996.71  | 17578.03 | iron |
| 25    | 9754.46  | 17614.63 | iron |
| 26    | 9690.46  | 17614.67 | iron |
| 27    | 9754.59  | 17840.18 | iron |
| 28    | 9754.63  | 17898.18 | iron |
| 29    | 9996.86  | 17840.03 | iron |
| 30    | 9996.90  | 17898.03 | iron |
| 31    | 9754.78  | 18150.19 | iron |
| 32    | 9690.78  | 18150.22 | iron |
| 33    | 9690.63  | 17901.22 | iron |
| 34    | 9690.59  | 17837.22 | iron |
| 35    | 9515.59  | 17837.32 | iron |
| 36    | 9515.63  | 17901.32 | iron |
| 37    | 9447.67  | 17969.36 | iron |
| 38    | 9383.67  | 17969.40 | iron |
| 39    | 9383.74  | 18084.10 | iron |
| 40    | 9383.78  | 18148.10 | iron |
| 41    | 9213.74  | 18084.20 | iron |
| 42    | 9213.78  | 18148.20 | iron |
| 43    | 9161.59  | 18094.97 | iron |
| 44    | 9152.46  | 18082.42 | iron |
| 45    | 9142.72  | 18052.47 | iron |
| 46    | 9142.63  | 17907.99 | iron |
| 47    | 9084.63  | 17908.02 | iron |
| 48    | 9084.72  | 18052.50 | iron |
| 49    | 9105.54  | 18116.51 | iron |
| 50    | 9114.66  | 18129.07 | iron |
| 51    | 9081.82  | 18216.28 | iron |
| 52    | 9145.82  | 18216.24 | iron |
| 53    | 9081.88  | 18323.44 | iron |
| 54    | 9081.92  | 18387.44 | iron |
| 55    | 9146.03  | 18566.36 | iron |
| 56    | 9082.03  | 18566.40 | iron |
| 57    | 9082.22  | 18573.44 | iron |
| 58    | 9146.13  | 18569.99 | iron |
| 59    | 9158.12  | 18605.02 | iron |
| 60    | 9008.73  | 18397.48 | iron |
| 61    | 9008.69  | 18323.48 | iron |
| 62    | 8928.83  | 18287.45 | iron |
| 63    | 8909.86  | 18355.93 | iron |
| 64    | 8912.02  | 18268.38 | iron |
| 65    | 9383.92  | 18376.26 | iron |
| 66    | 9447.92  | 18376.22 | iron |
| 67    | 9470.05  | 18426.38 | iron |
| 68    | 9426.88  | 18473.63 | iron |
| 69    | 9466.38  | 18509.72 | iron |
| 70    | 9309.55  | 18462.47 | iron |
| 71    | 9555.78  | 18480.27 | iron |
| 72    | 9556.12  | 18544.57 | iron |
| 73    | 9960.71  | 18542.12 | iron |
| 74    | 9960.37  | 18478.12 | iron |
| 75    | 9999.69  | 18483.89 | iron |
| 76    | 0050.07  | 18512.63 | iron |
| 77    | 0055.00  | 18503.99 | iron |
| 78    | 0004.62  | 18475.25 | iron |
| 79    | 0013.95  | 18440.02 | iron |
| 80    | 0071.95  | 18439.99 | iron |
| 81    | 0071.83  | 18239.72 | iron |
| 82    | 0013.83  | 18239.75 | iron |
| 83    | 0065.73  | 18529.68 | iron |
| 84    | 0014.99  | 18568.68 | iron |
| 85    | 0024.04  | 18580.46 | iron |
| 86    | 0074.79  | 18541.46 | iron |
| 87    | 0128.51  | 18611.37 | iron |
| 88    | 0208.07  | 18637.80 | iron |
| 89    | 0208.13  | 18737.80 | iron |
| 90    | 0065.51  | 18634.43 | iron |
| 91    | 0024.10  | 18688.09 | iron |
| 92    | 9454.43  | 18688.43 | iron |
| 93    | 9274.77  | 18524.29 | iron |
| 94    | 8936.11  | 18573.53 | iron |
| 95    | 8906.11  | 18573.54 | iron |
| 96    | 8906.06  | 18490.11 | iron |
| 97    | 8921.77  | 17320.31 | iron |
| 98    | 0207.31  | 17364.77 | iron |



SOUTHERN RIDGE 2ND ADD. - PH. II

**COORDINATE  
INFORMATION**

ENGINEERING | SURVEYING | PLANNING | LANDSCAPE ARCHITECTURE

PROJECT NUMBER  
472-84098

DESIGN  
AEG  
DRAWN  
TMS

REVISIONS:

APPROVED  
DATE  
10/05

SCALE  
Noted  
SHEET

**19 OF 29**