


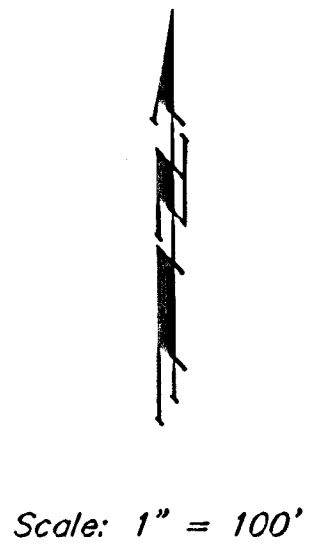

IRONS			
PT. #	NORTHING	EASTING	DESC
1	21407.04	11137.48	Iron
2	21396.06	11201.28	Iron
3	21533.60	11286.73	Iron
4	21992.73	11468.21	Iron
5	21991.14	11404.23	Iron
6	22113.25	11401.20	Iron
7	22114.84	11465.18	Iron
8	22184.52	11532.67	Iron
9	22248.52	11532.22	Iron
10	22249.98	11736.34	Iron
11	22186.00	11739.80	Iron
12	22250.44	11800.34	Iron
13	22186.42	11797.90	Iron
14	22186.44	11800.80	Iron
15	22145.68	11903.86	Iron
16	22192.05	11947.97	Iron
17	22026.71	12204.68	Iron
18	22090.71	12204.22	Iron
19	22091.91	12372.49	Iron
20	22027.91	12372.95	Iron
21	22028.33	12430.95	Iron
22	22092.33	12430.49	Iron
23	22102.91	12511.41	Iron
24	22018.91	12512.01	Iron
25	22019.34	12572.01	Iron
26	22103.34	12571.41	Iron
27	21554.87	11219.52	Iron
28	21601.94	11262.93	Iron
29	21614.73	11249.94	Iron
30	21369.13	11205.04	Iron
31	21587.84	11167.98	Iron
32	21651.05	11178.02	Iron
33	21696.57	10891.22	Iron
34	21633.36	10881.19	Iron
35	21777.92	10770.65	Iron
36	21771.04	10834.28	Iron
37	21964.05	10778.89	Iron
38	21962.76	10638.05	Iron
39	22026.76	10637.47	Iron
40	22028.03	10776.26	Iron
41	22133.45	10765.80	Iron
42	22142.06	10829.22	Iron
43	21858.30	11391.86	Iron
44	21921.54	11401.69	Iron
45	21952.74	11201.01	Iron
46	21889.50	11191.18	Iron
47	22016.65	11079.50	Iron
48	22018.24	11143.48	Iron
49	22491.31	11131.73	Iron
50	22481.76	11067.95	Iron
51	22480.20	11040.85	Iron
52	22475.52	10952.30	Iron
53	22539.50	10850.71	Iron
54	22544.18	11039.26	Iron
55	22549.74	11093.31	Iron
56	22560.32	11391.28	Iron
57	22496.70	11384.28	Iron
58	22502.91	11656.51	Iron
59	22566.14	11646.62	Iron
60	22436.22	11735.01	Iron
61	22436.67	11799.01	Iron
62	21986.74	11741.23	Iron
63	21987.15	11799.22	Iron
64	22134.47	12027.53	Iron
65	22109.21	12086.34	Iron
66	22136.10	12097.88	Iron
67	22161.35	12039.07	Iron
68	22208.76	12048.65	Iron
69	22209.21	12112.64	Iron
70	22630.36	12045.63	Iron
71	22630.82	12109.63	Iron
72	22707.66	12109.08	Iron
73	22707.20	12045.08	Iron
74	22504.98	12369.54	Iron
75	22505.39	12427.53	Iron
76	21508.34	12376.66	Iron
77	21508.75	12434.66	Iron
78	21394.62	12345.34	Iron
79	21454.17	12341.29	Iron
80	21153.51	12578.20	Iron
81	21190.40	12397.10	Iron
82	21249.09	12114.01	Iron
83	21451.01	10881.81	Iron
84	21489.17	10642.38	Iron
85	22672.10	10631.57	Iron
86	22720.16	12567.00	Iron

SANITARY SEWER			
PT. #	NORTHING	EASTING	DESC
100	22350.83	10943.70	0+00
101	22349.64	10896.30	0+91.2
102	22361.70	11303.34	3+59.8
103	22572.72	11668.38	7+25.0
104	21955.78	11272.07	0+00
105	22355.65	11262.14	4+00
106	22504.29	11258.45	5+48.7
107	22362.81	11550.53	2+88.5
108	22367.46	11737.50	4+75.5
109	21782.01	11601.69	0+00
110	22187.00	11598.79	4+05
111	21772.70	11842.92	2+41.4
112	21820.95	11920.42	3+32.7
113	22135.32	11918.17	6+47.1
114	22339.89	11916.71	8+51.7
115	22621.57	11914.69	11+33.4

SANITARY SEWER ESMTS			
PT. #	NORTHING	EASTING	ELEV
150	22539.4954	10850.7069	193.30
151	22541.8053	10943.7209	192.60
152	22543.9155	11028.6947	193.50
153	22554.7829	11123.4541	194.30
154	22564.7356	11118.2362	195.30
155	22566.2008	11303.2260	196.30
156	22560.0851	11393.4056	197.30
157	22554.6139	11483.5693	198.40
158	22557.5451	11573.5242	199.50
159	22567.6828	11663.5166	200.10
160	21941.1685	11275.4341	191.00
161	22037.0930	11273.0519	188.00
162	22058.8190	11272.5124	189.20
163	22143.7928	11270.4021	190.70
164	22223.7682	11268.4160	192.50
165	22282.3231	11266.9619	193.80
166	22313.7404	11266.1817	193.00
167	22358.7266	11265.0645	193.60
168	22403.7127	11263.9473	194.50
169	22502.3475	11261.4979	195.80
170	22360.9609	11355.0368	191.80
171	22362.7609	11427.5177	190.30
172	22363.1953	11445.0090	190.20
173	22435.4296	11534.9813	192.00
174	22367.6640	11624.9536	193.80
175	22368.0500	11640.4966	194.10
176	22370.4088	11735.4822	196.50
177	21826.6824	11604.3668	188.20
178	21897.9735	11603.8570	189.70
179	21765.0274	11604.8077	187.20
180	22005.0213	11603.0915	187.50
181	22090.0191	11602.4837	191.00
182	22185.0167	11601.8044	195.50
183	21775.3211	11729.7494	185.00
184	21776.7362	11843.7301	185.00
185	21826.3234	11923.3775	185.00
186	21985.0554	11922.2425	185.00
187	22070.0533	11921.6347	189.30
188	22130.0517	11921.2056	192.30
189	22214.0655	11920.6049	192.90
190	22276.5962	11920.1577	190.30
191	22344.9129	11919.6692	188.50
192	22361.5940	11919.5499	188.10
193	22429.9107	11919.0614	189.50
194	22446.9918	11918.9421	189.90
195	22531.5896	11918.3343	191.60
196	22580.2700	11917.9862	192.50
197	22616.5875	11917.7265	193.30
198	22684.0180	11917.2443	194.70



Krug North 2nd Add. - Ph. III

COORDINATE SHEET

SANITARY SEWER IMPROVEMENTS

Baughman Company, P.A. 315 Ellis St. Wichita, KS 67211 P 316.262.7271 F 316.262.4149

ENGINEERING | SURVEYING | PLANNING | LANDSCAPE ARCHITECTURE

PROJECT NUMBER

DESIGN

TMS

DRAWN

REVISIONS

APPROVED

DATE

10/05

SCALE

Noted

SHEET

12 OF 18

KrugNorth2ndPhasellVSScoeds