
BRENTWOOD SOUTH

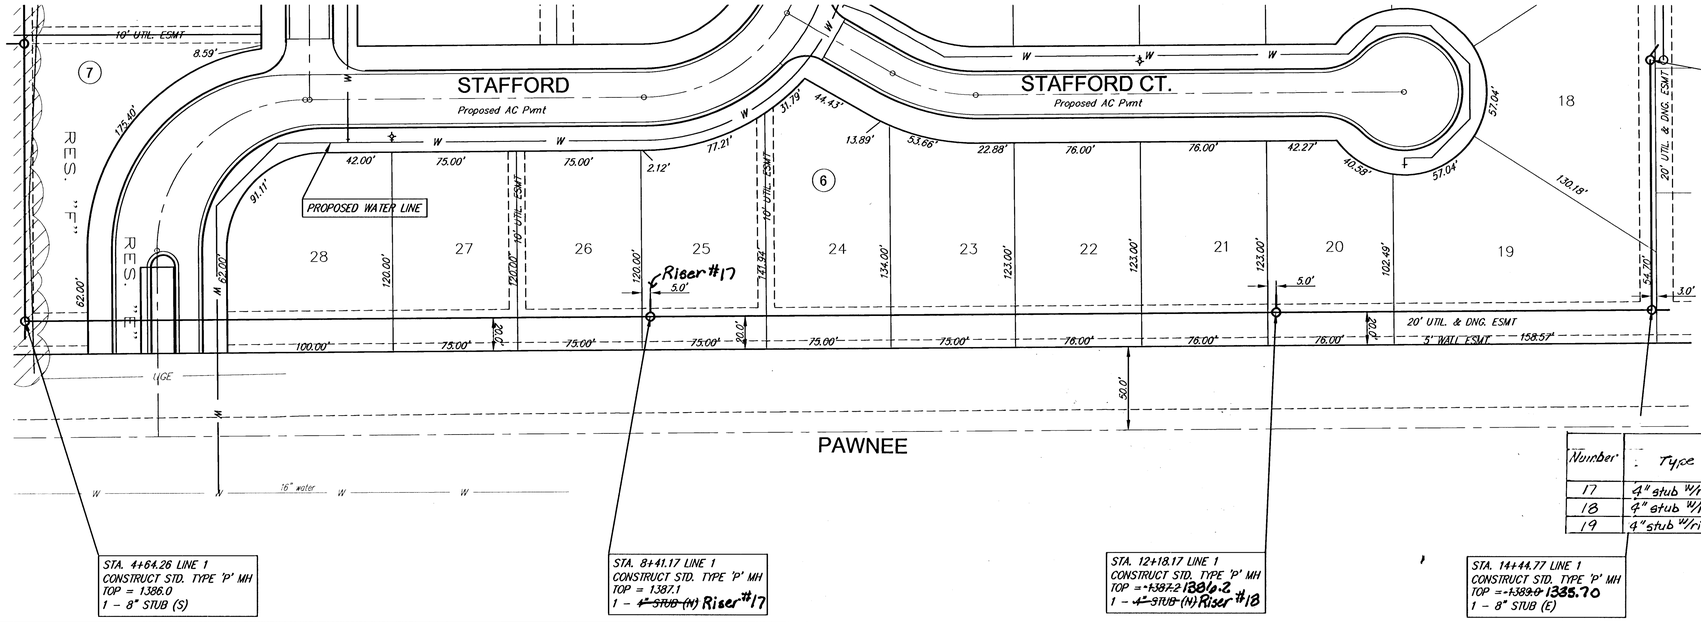

STA. 15+94.96 LINE 1
CONSTRUCT STD. TYPE 'P' MH
TOP =-1388.4 1384.7
1 – 4" STUB (NE) Riser #19

SCALE 1" = 40'
IRON = ●


STA. 4+64.26 LINE 1
CONSTRUCT STD. TYPE 'P' MH
TOP = 1386.0
1 – 8" STUB (S)

STA. 8+41.17 LINE 1
CONSTRUCT STD. TYPE 'P' MH
TOP = 1387.1
1 – ~~4" STUB (N)~~ Riser #17

STA. 12+18.17 LINE 1
CONSTRUCT STD. TYPE 'P' MH
TOP =-1387.2 1386.2
1 – 4" STUB (N) Riser #18

STA. 14+44.77 LINE 1
CONSTRUCT STD. TYPE 'P' MH
TOP =-1389.0 1385.70
1 – 8" STUB (E)

Number	Type	Location			
		Lot No.	Block No.	Line No	Station/ Direction
17	4" stub w/riser	25	6	1	8.5' Due north of MH
18	4" stub w/riser	20	6	1	7.5' Due north of MH
19	4" stub w/riser	3	6	1	12.5' E & 20.5' N. of MH (1 no vertical pipe)

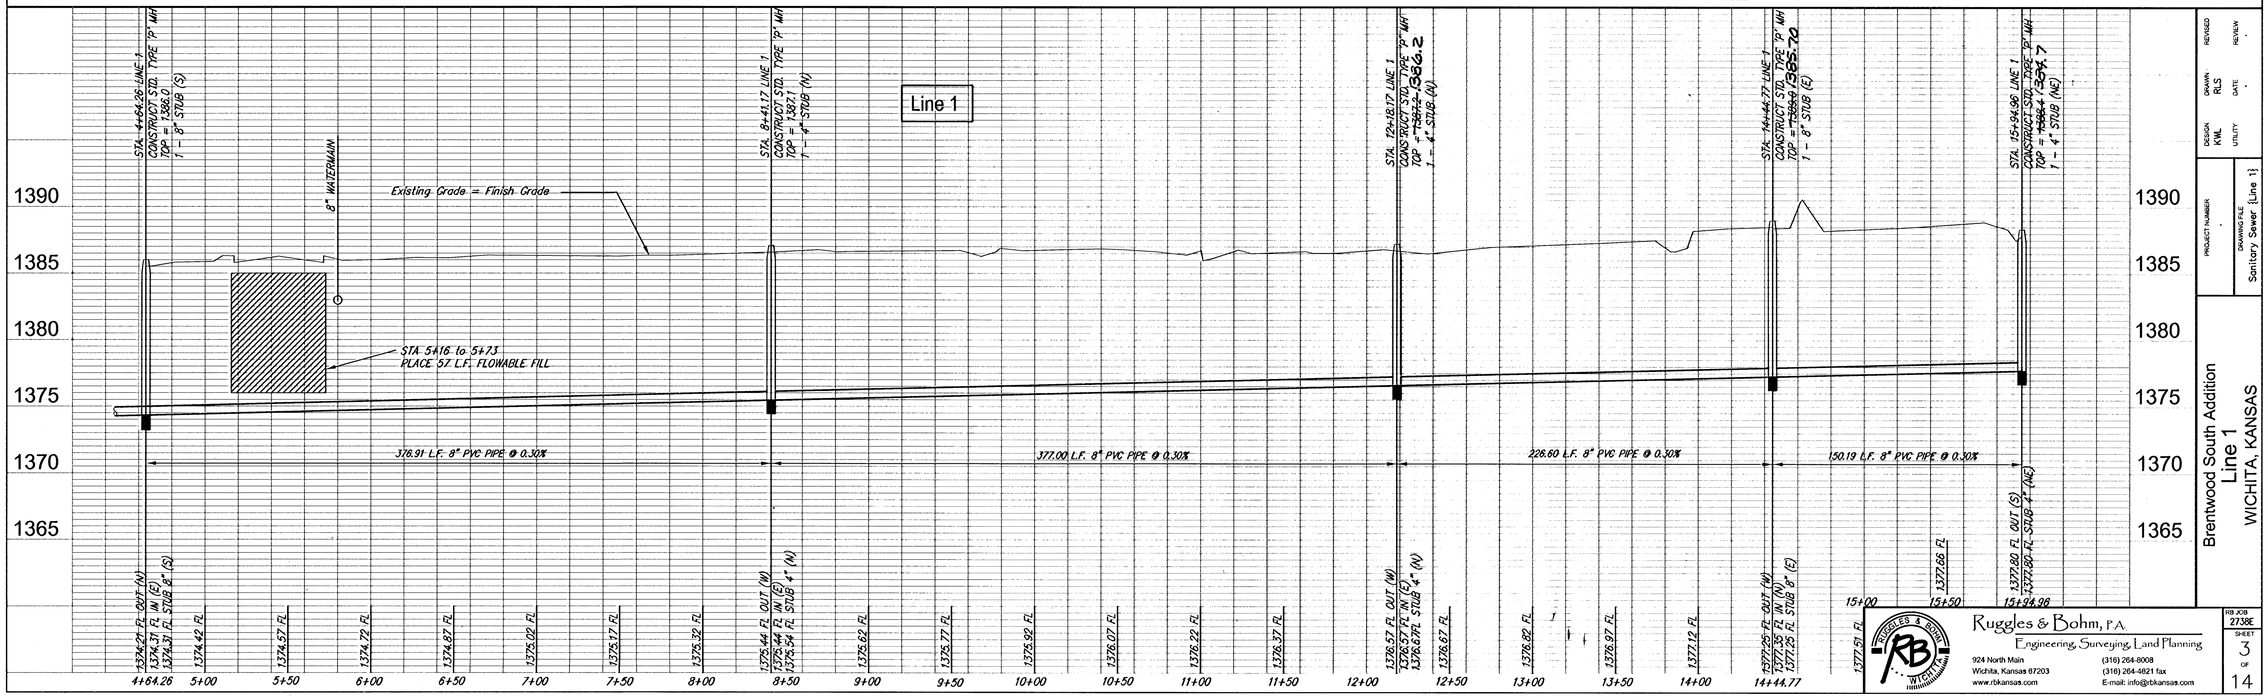

DESIGN KWL | DRAWN RLS | REVISED | REVIEW
UTILITY | DATE

PROJECT NUMBER

DRAWING FILE: Sanitary Sewer [Line 1]

Brentwood South Addition
Line 1
WICHITA, KANSAS

Ruggles & Bohm, P.A.
Engineering, Surveying, Land Planning
924 North Main
Wichita, Kansas 67203
www.rbkansas.com
(316) 264-8008
(316) 264-8621 fax
E-mail: info@rbkansas.com

RB JOB 2738E