
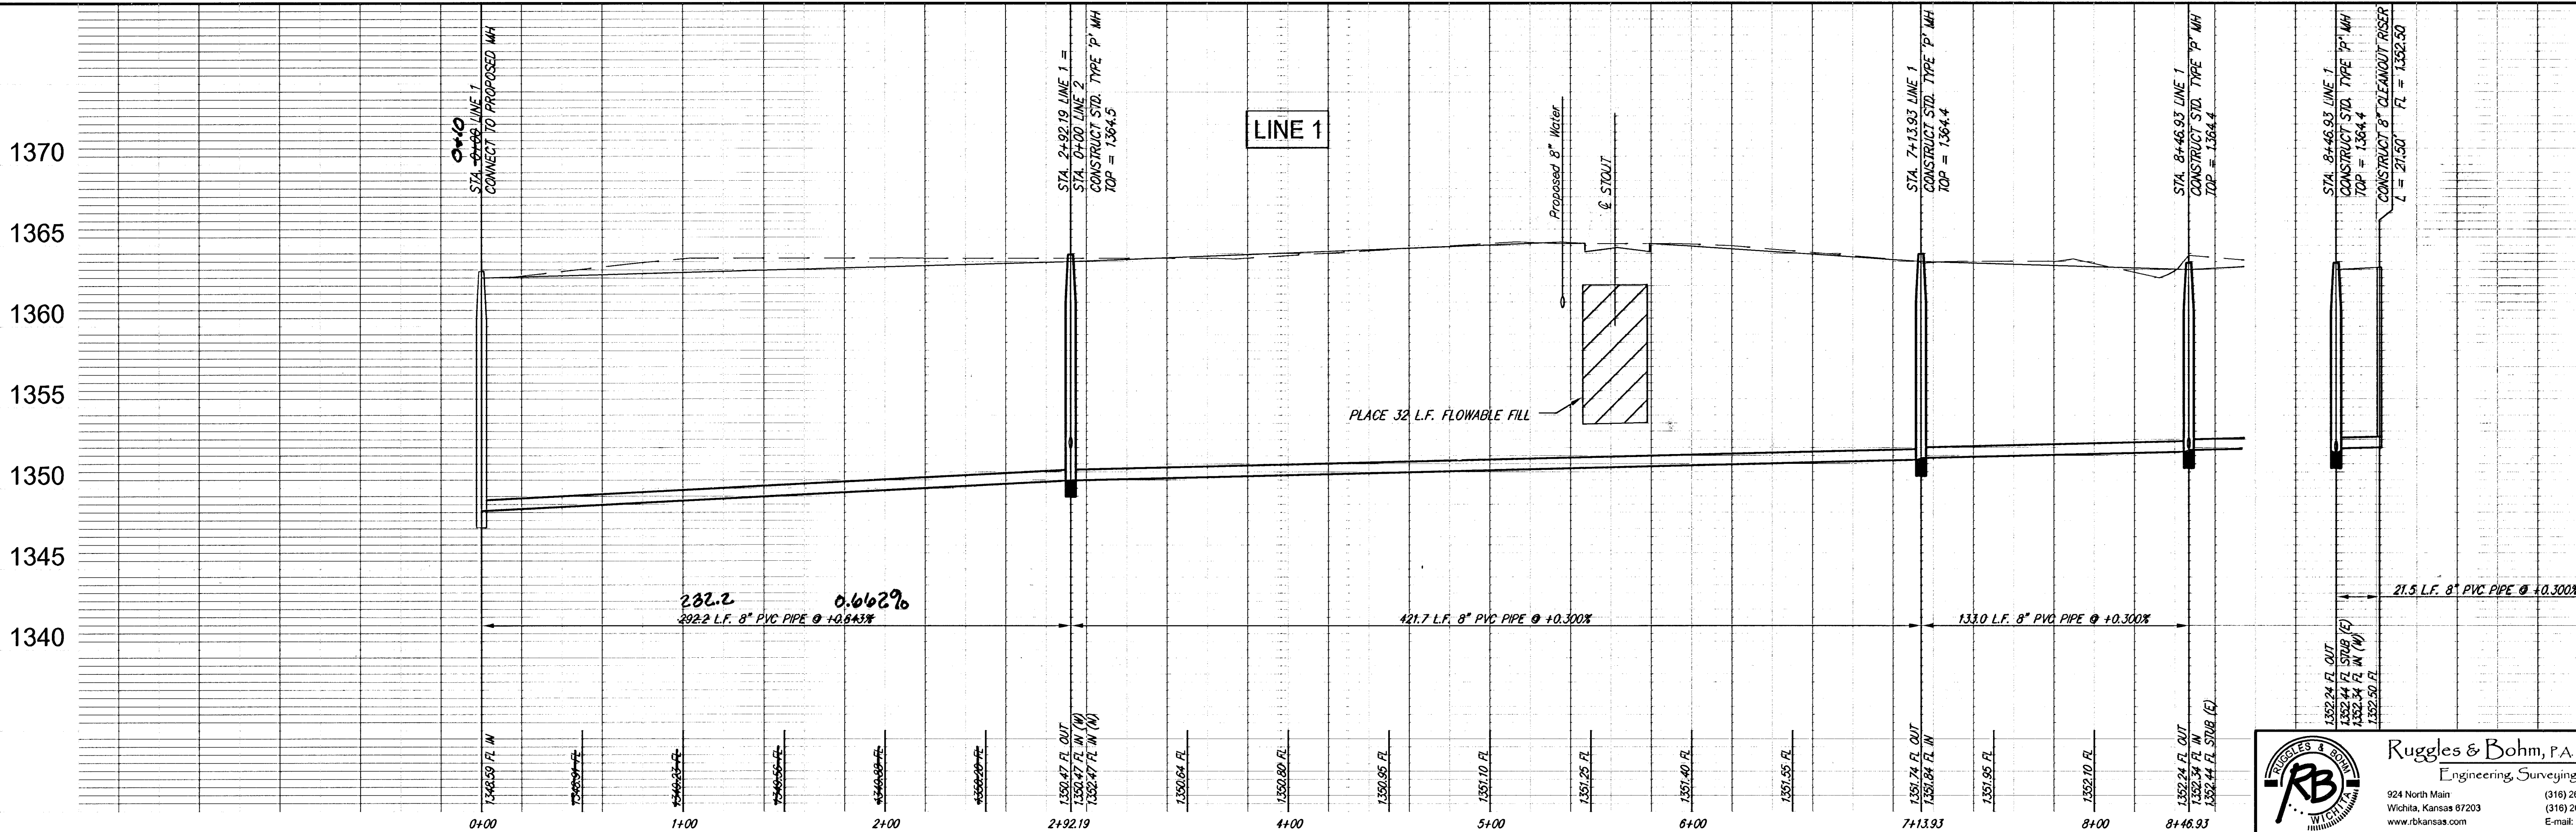
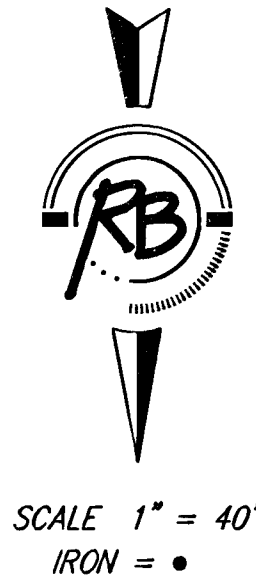



SEWER SERVICE TABLE						
NUMBER	TYPE	SERVING			FOR INFORMATION ONLY	
		LOT NO.	BLOCK NO.	LINE NO.	STATION\ DIRECTION	APPROXIMATE LENGTH 4" PIPE VERTICAL HORIZONTAL
1	8"x4" Saddle	5	2	1	0+50; N 48.90 14'	15' 14.7
2	8"x4" Saddle	5	2	1	1+50; N 50.2 14'	15'
3	8"x4" Saddle	4	2	1	2+32; N 30.9 14'	15' 15.2
4	8"x4" Saddle	3	2	1	3+20; N 18.29 14'	15' 14.8
5	8"x4" Saddle	2	2	1	3+95; N 92.89 14'	15' 14.6
6	8"x4" Saddle	1	2	1	4+70; N 70.49 13'	15' 14.4
7	8"x4" Saddle	3	1	1	8+46.39; N 46.93 9'	15' 13.2
8	4" MH Stub	4	1	1	8+46.39; N 46.93 9'	15' NA

NOTE: Vertical Riser Pipe shall be extended to 2' minimum above ground water elevation and 4' maximum below proposed ground elevation.

THIS LINE TO BE CONSTRUCTED WITH PROJECT CONTRACTOR TO COORDINATE CONSTRUCTION WITH THIS PROJECT. FIELD VERIFY FLOWS AND NOTIFY ENGINEER IF CHANGES ARE NECESSARY.

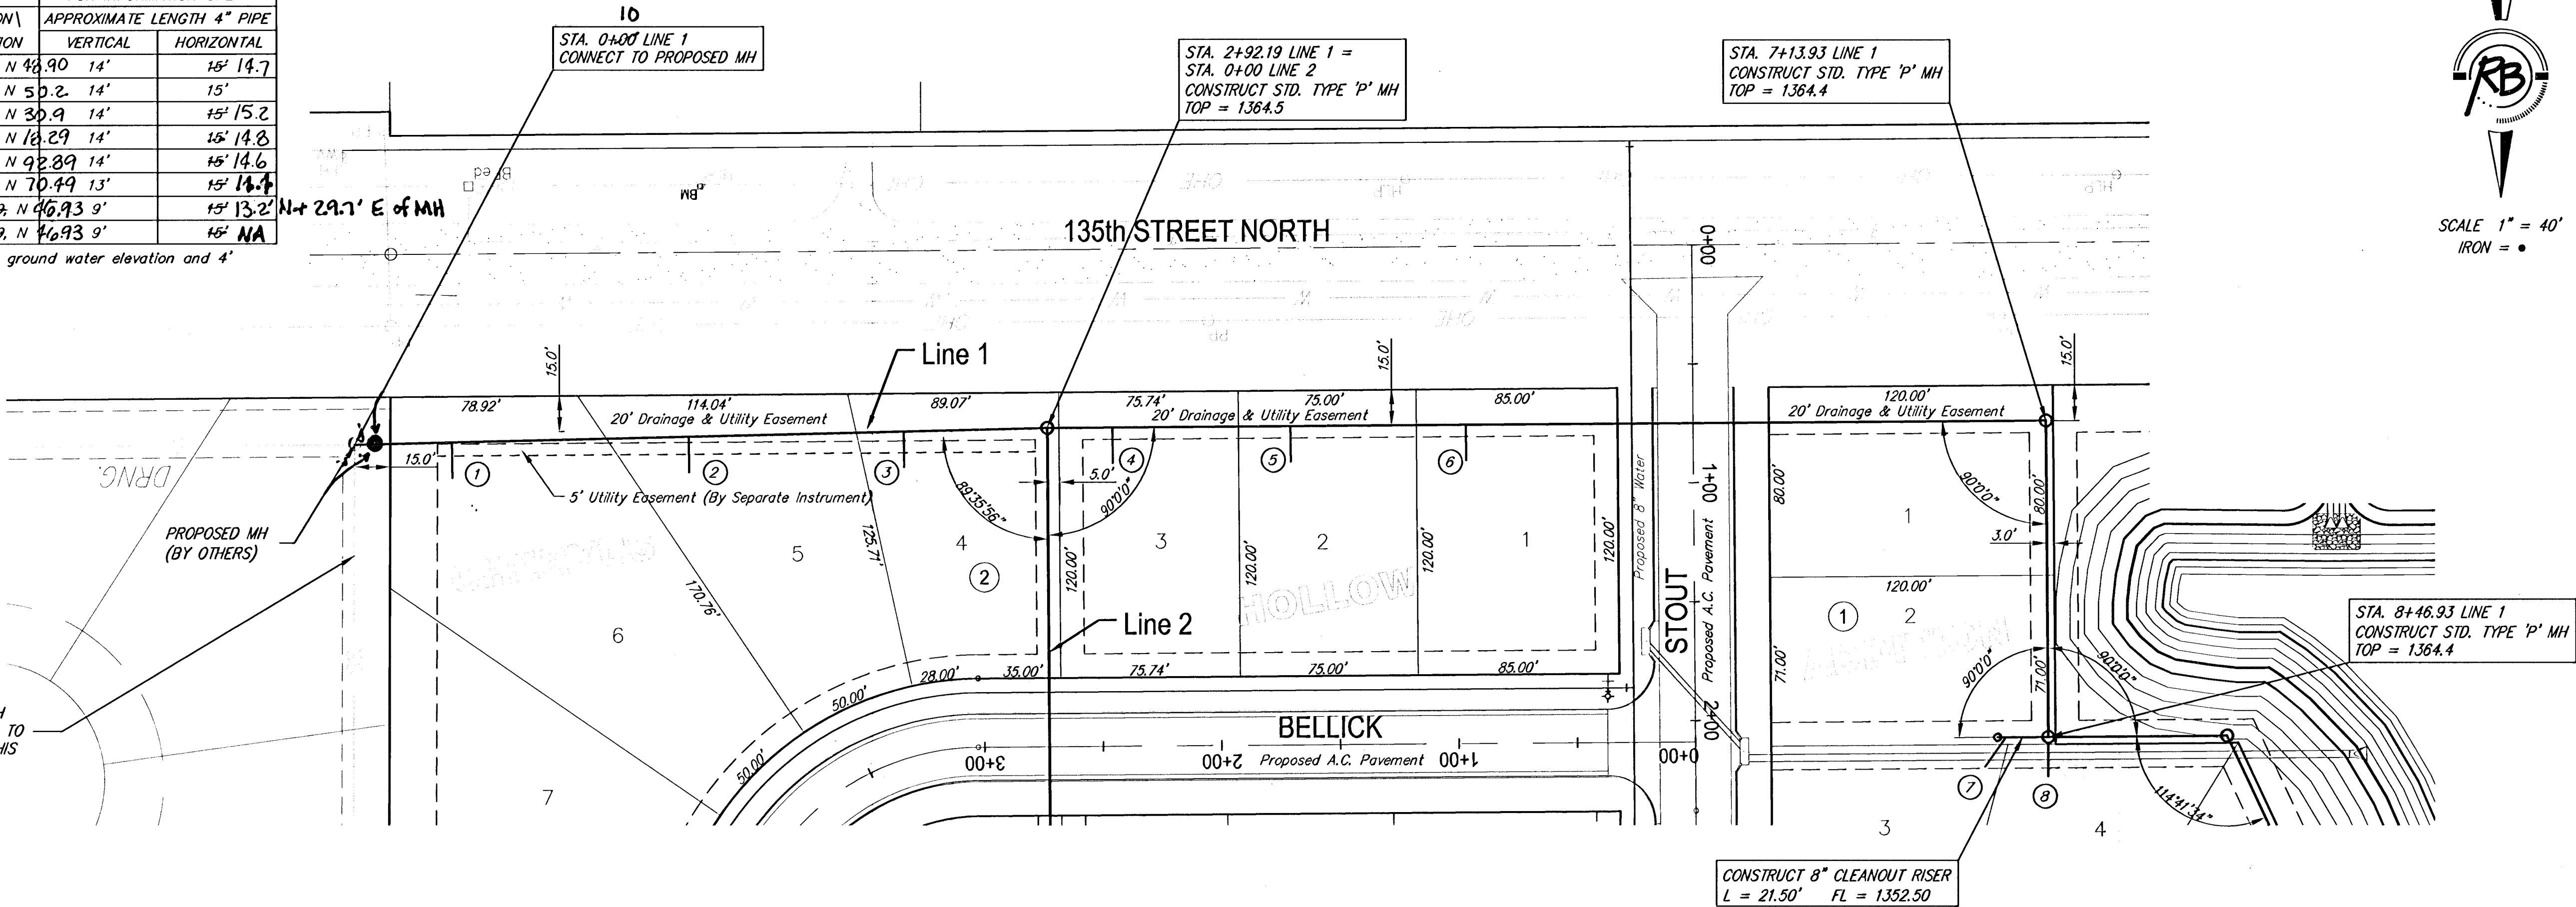

DESIGN	RA	DATE	May 3, 2005
PROJECT NUMBER	468-83937	DRAWING FILE	Sanitary Sewer {Line 1}
DESIGNER	KML	UTILITY	
REVIEW			
Cheryl's Hollow Addition Line 1 WICHITA, KANSAS			
PROJECT NUMBER	468-83937	DRAWING FILE	Sanitary Sewer {Line 1}
DESIGNER	KML	UTILITY	
REVIEW			
Cheryl's Hollow Addition Line 1 WICHITA, KANSAS			

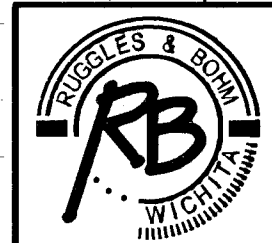

Ruggles & Bohm, P.A.
Engineering, Surveying, Land Planning
924 North Main
Wichita, Kansas 67203
www.rbkansas.com
(316) 264-8008
(316) 264-4821 fax
E-mail: info@rbkansas.com

2
OF
11