

SEWER SERVICE TABLE


NUMBER	TYPE	SERVING			STATION \ DIRECTION	FOR INFORMATION ONLY	
		LOT NO.	BLOCK NO.	LINE NO.		APPROXIMATE LENGTH 4" PIPE VERTICAL	HORIZONTAL
14	8"x4" Saddle	9	1	1A	1+~~14~~ S 13.30	9'	~~15~~ 15.4
15	8"x4" Saddle	8	1	1A	2+~~14~~ S 10.10	9'	~~15~~ 15.8
16	8"x4" Saddle	7	1	1A	2+~~74~~ S 7~~4~~.70	9'	~~15~~ 15.5

NOTE: Vertical Riser Pipe shall be extended to 2' minimum above ground water elevation and 4' maximum below proposed ground elevation.

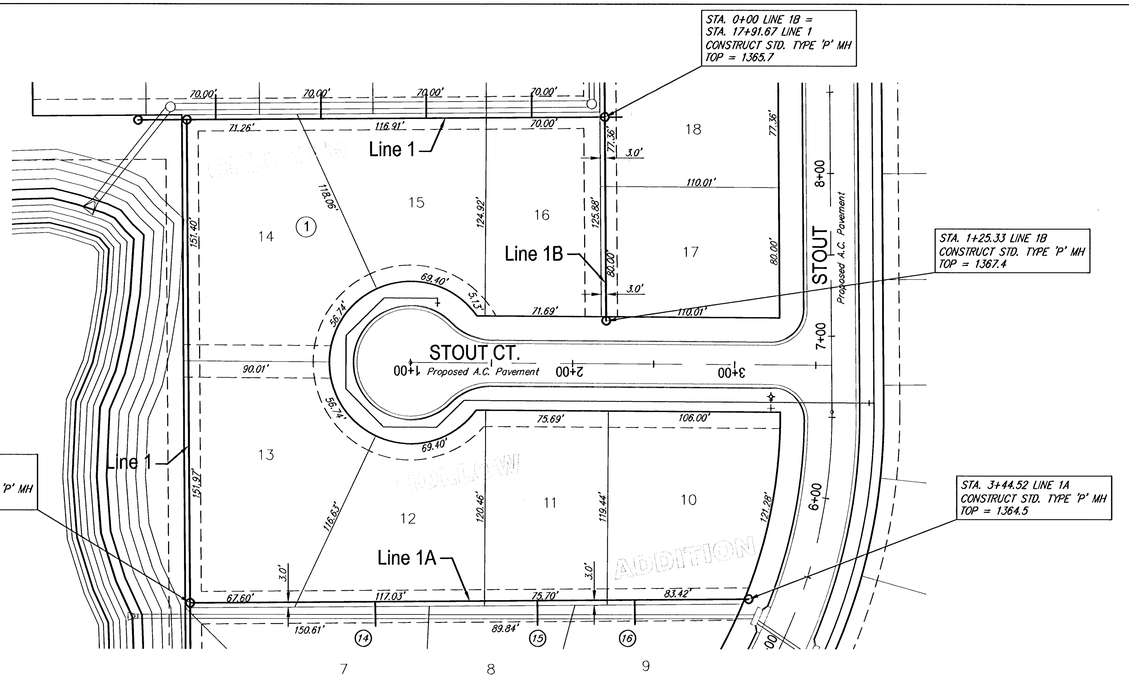

SCALE 1" = 40'
IRON = •

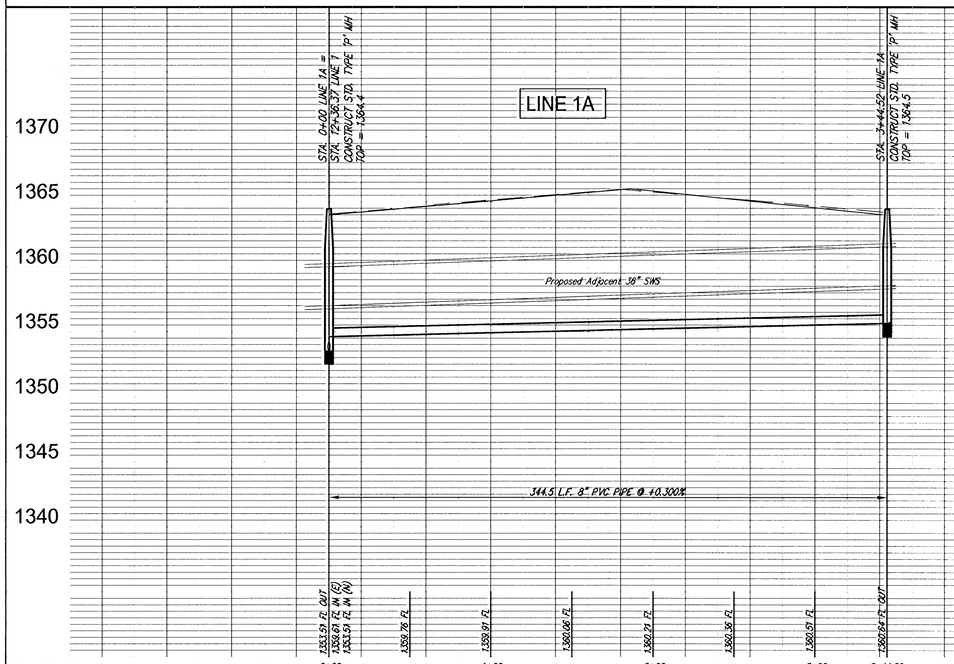

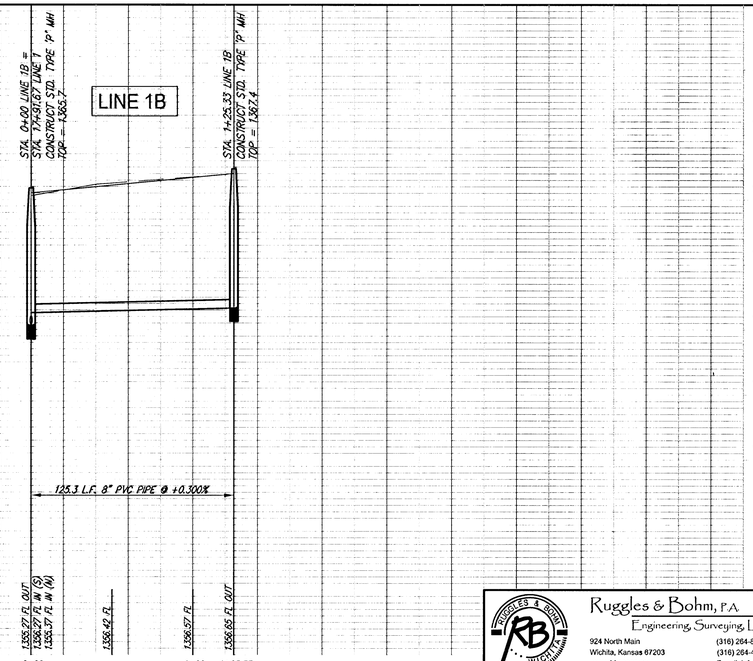

DESIGN KWL
DRAWN RA
CHECKED
REVIEWED
UTILITY
DATE May 3, 2005

PROJECT NUMBER 468-83937
DRAWING FILE Sanitary Sewer (Line 1)

Cheryl's Hollow Addition
Line 1A & 1B
WICHITA, KANSAS

Ruggles & Bohm, P.A.
Engineering, Surveying, Land Planning
924 North Main
Wichita, Kansas 67203
www.rbkansas.com
(316) 264-8008
(316) 264-4621 fax
E-mail: info@rbkansas.com

RB JOB 2666E
SHEET 4 OF 11