


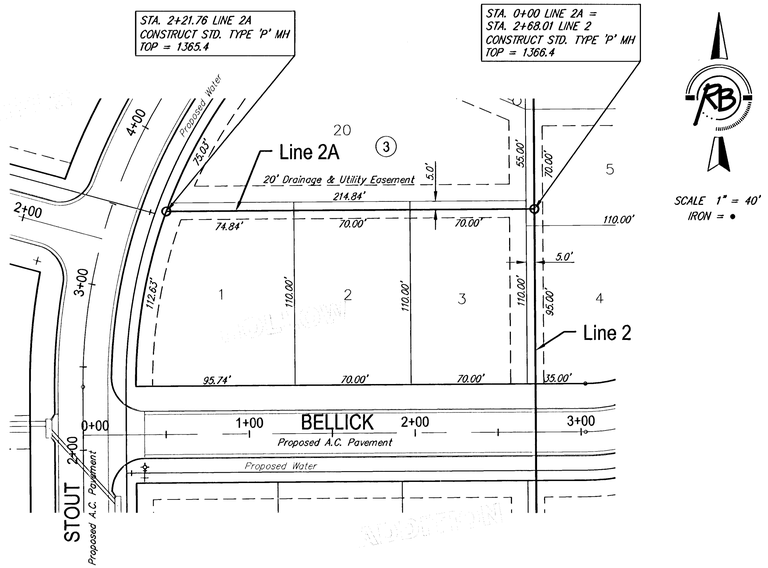


SCALE 1" = 40'
IRON = ●

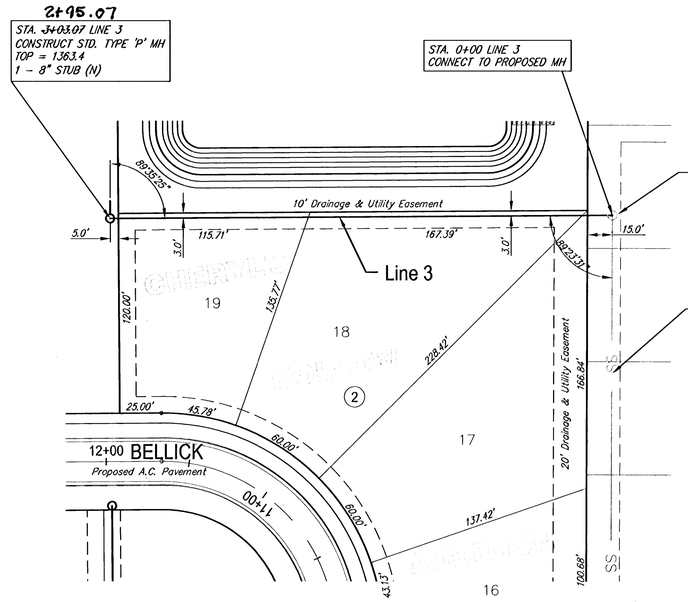

SCALE 1" = 40'
IRON = ●

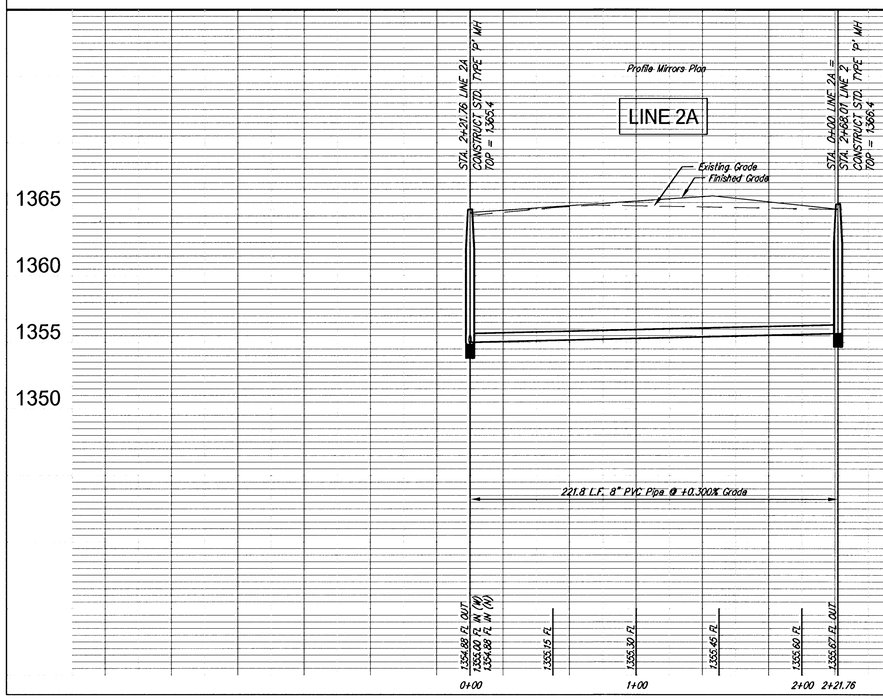

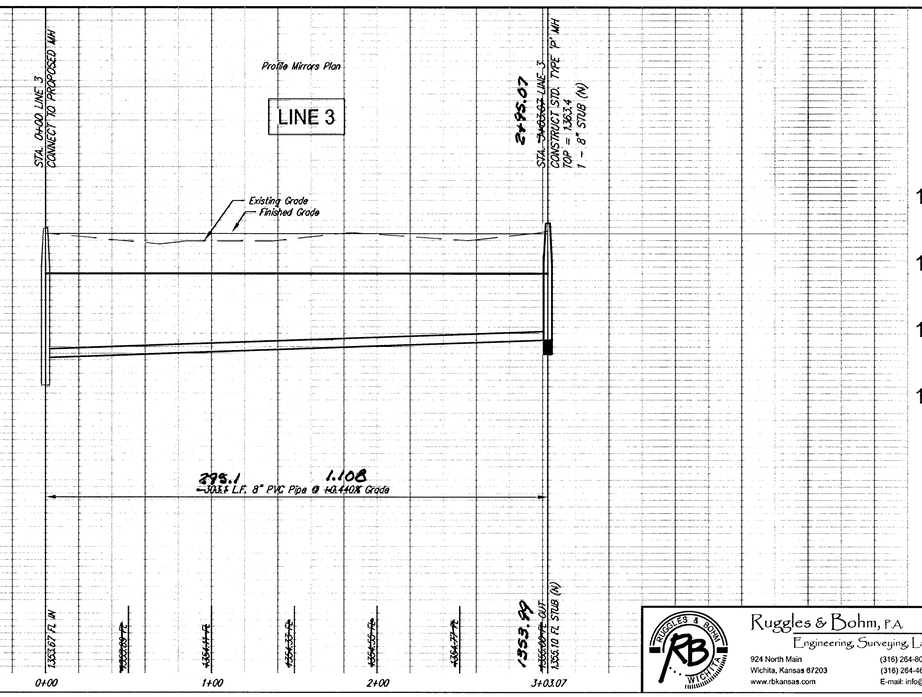

Cheryl's Hollow Addition
Line 2A and 3
WICHITA, KANSAS

PROJECT NUMBER 468-83937
DRAWING FILE Sanitory Sewer (Line 1)
DESIGN KML
DRAWN RA
CHECK
UTILITY
DATE May 3, 2005
REVISED
REVIEW

Ruggles & Bohm, P.A.
Engineering, Surveying, Land Planning
924 North Main
www.rbkansas.com
(316) 264-8008
(316) 264-4821 fax
E-mail: info@rbkansas.com

RB JOB 2666E
SHEET 6 OF 11