
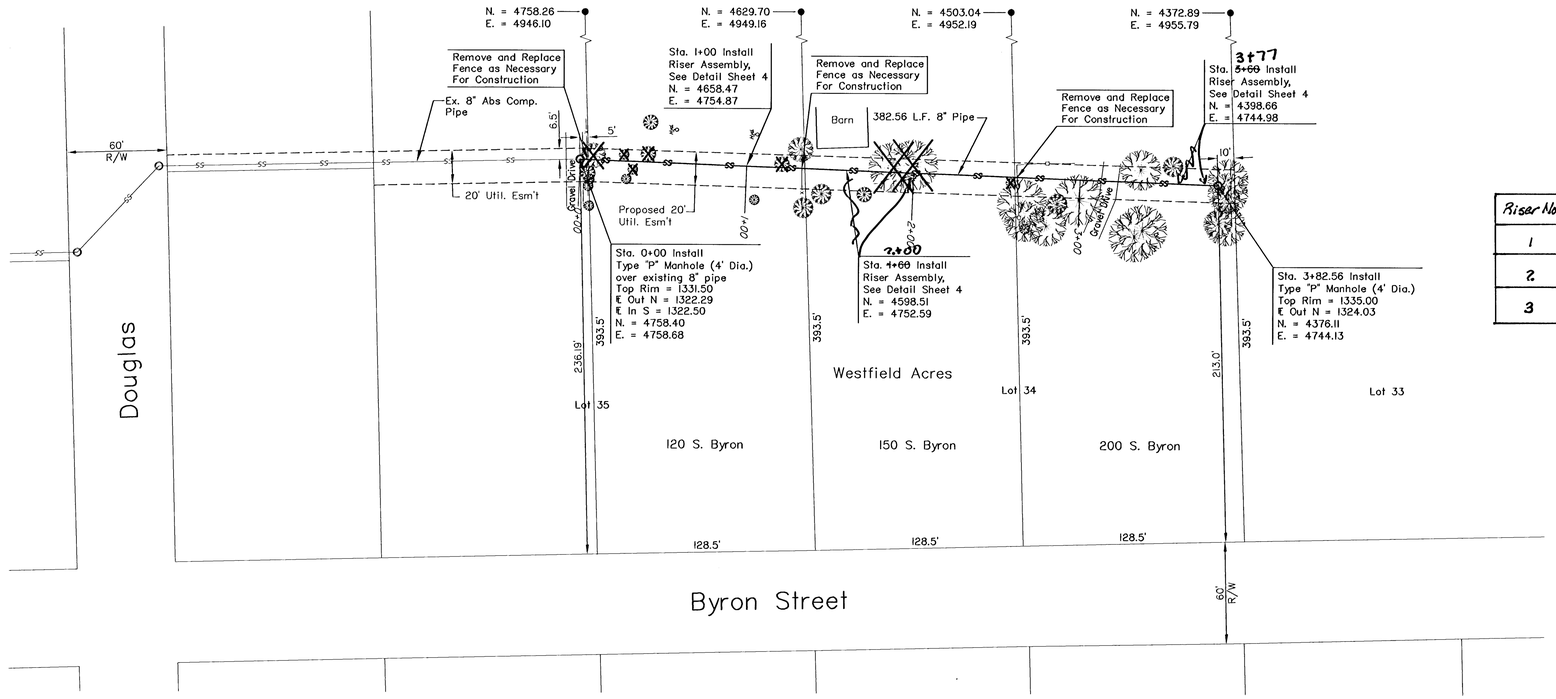



| Riser No. | Line No. | Sta. | Distance Main-Riser | Distance from Upstream MH | Distance from Downstream MH |
|---|---|---|---|---|---|
| 1 | 1 | 1+00 | 10' Rt. | 282.56 | 100' |
| 2 | 1 | 2+00 | 10' Rt. | 182.56 | 200' |
| 3 | 1 | 3+77 | 10' Rt. | 5' | 377.56' |

Horz. Scale 1" = 40'
Vert. Scale 1" = 5'

0 40 80

5 0

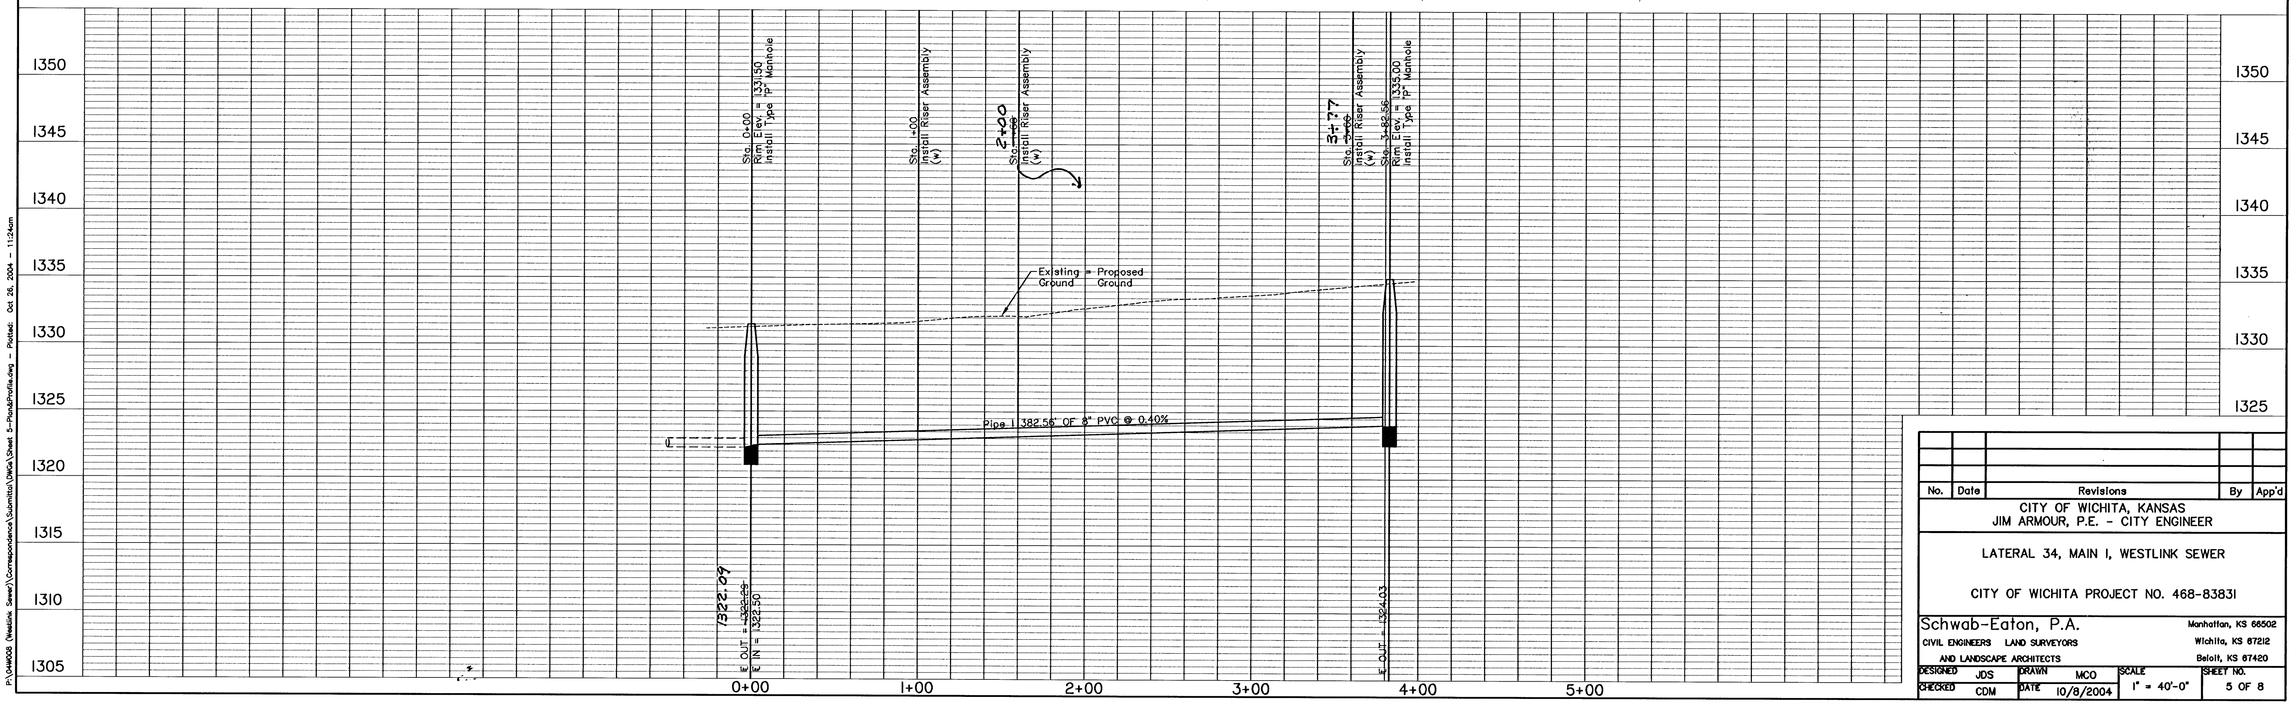


| No. | Date | Revisions | By | App'd |
|---|---|---|---|---|
| | | | | |

CITY OF WICHITA, KANSAS
JIM ARMOUR, P.E. - CITY ENGINEER

LATERAL 34, MAIN 1, WESTLINK SEWER

CITY OF WICHITA PROJECT NO. 468-83831

Schwab-Eaton, P.A.
CIVIL ENGINEERS LAND SURVEYORS AND LANDSCAPE ARCHITECTS
Manhattan, KS 66502
Wichita, KS 67212
Beloit, KS 67420

| DESIGNED | DRAWN | SCALE | SHEET NO. |
|---|---|---|---|
| JDS | MCO | 1" = 40'-0" | 5 OF 8 |
| CHECKED CDM | DATE 10/8/2004 | | |

P:\CWA008 (Westlink Sewer)\Correspondence\Submittal\DWGs\Sheet 5-PlanProfile.dwg - Plotted: Oct 26, 2004 - 11:24am