


**NORTH RIDGE VILLAGE ADDITION
SANITARY SEWER**

NORTH RIDGE PLAZA ADDITION

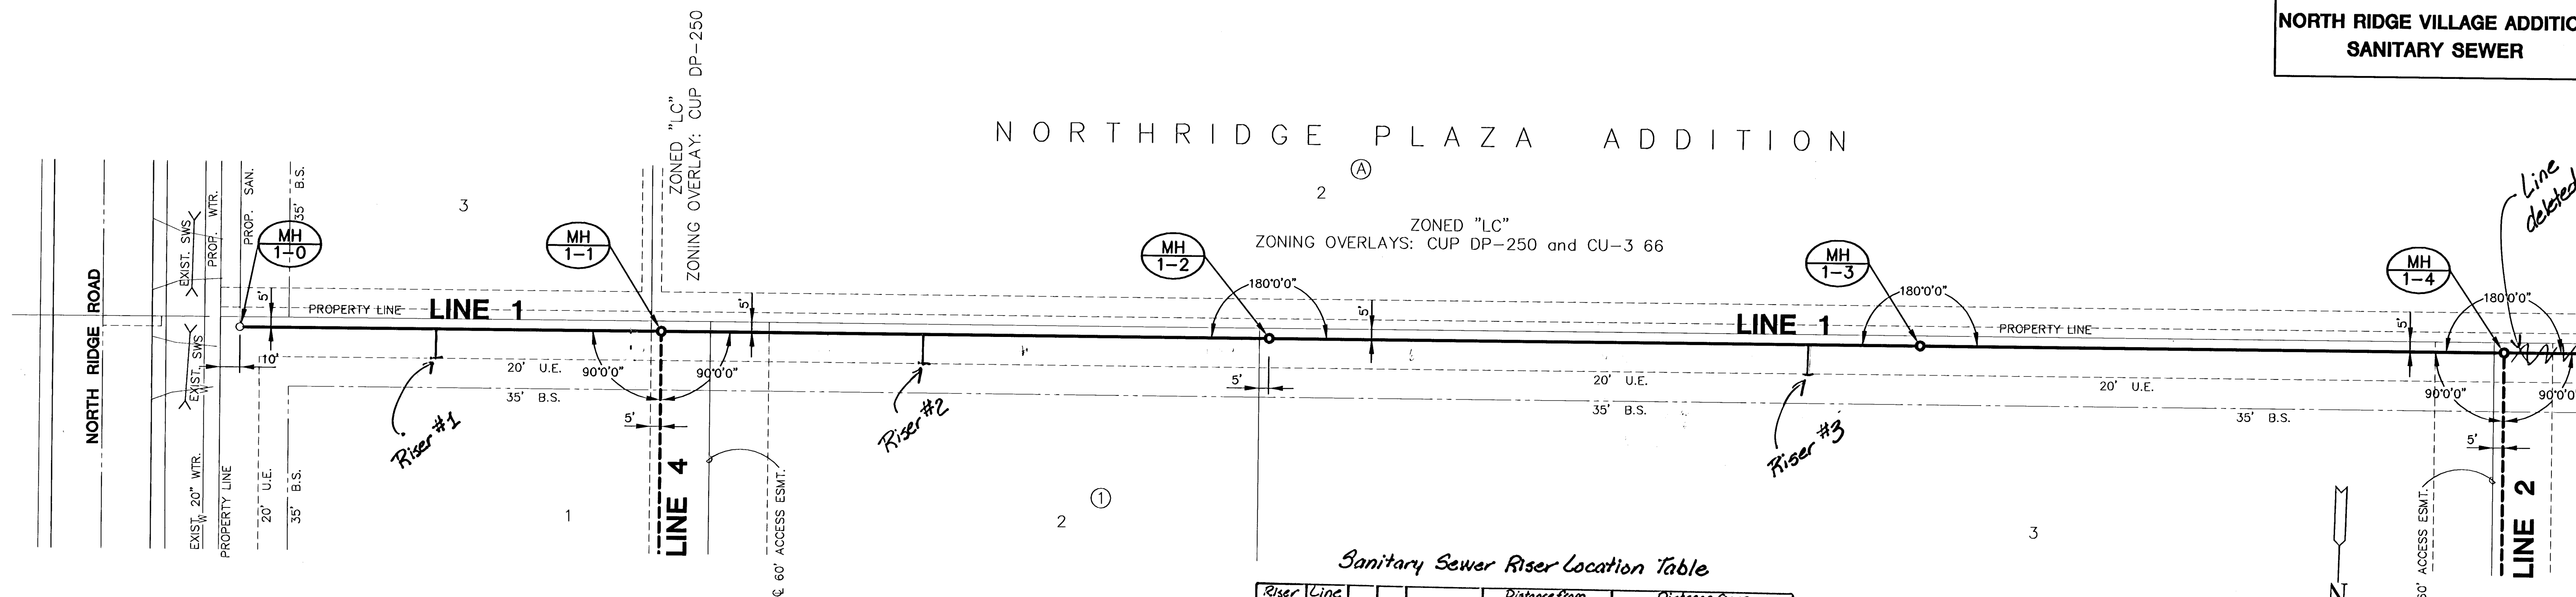


Sanitary Sewer Riser Location Table

Riser No.	Line No.	Lot	Blk	Station	Distance from Main to Riser (L/R)	Distance from Upstream MH	Distance from Downstream MH
1	1	1	1	11+00 Rt	14' Rt.	118.0	100.0
2	1	2	1	13+18 Rt	14' Rt.	177.0	133.1
3	1	3	1	18+02 Rt	14' Rt.	55.0	277.5

PLAN LINE 1

SCALE: 1"=40'

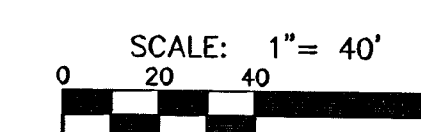

PROFILE LINE 1

SCALE: HORIZ. 1"=40'
SCALE: VERT. 1"=5'

