




NORTH RIDGE VILLAGE
ADDITION

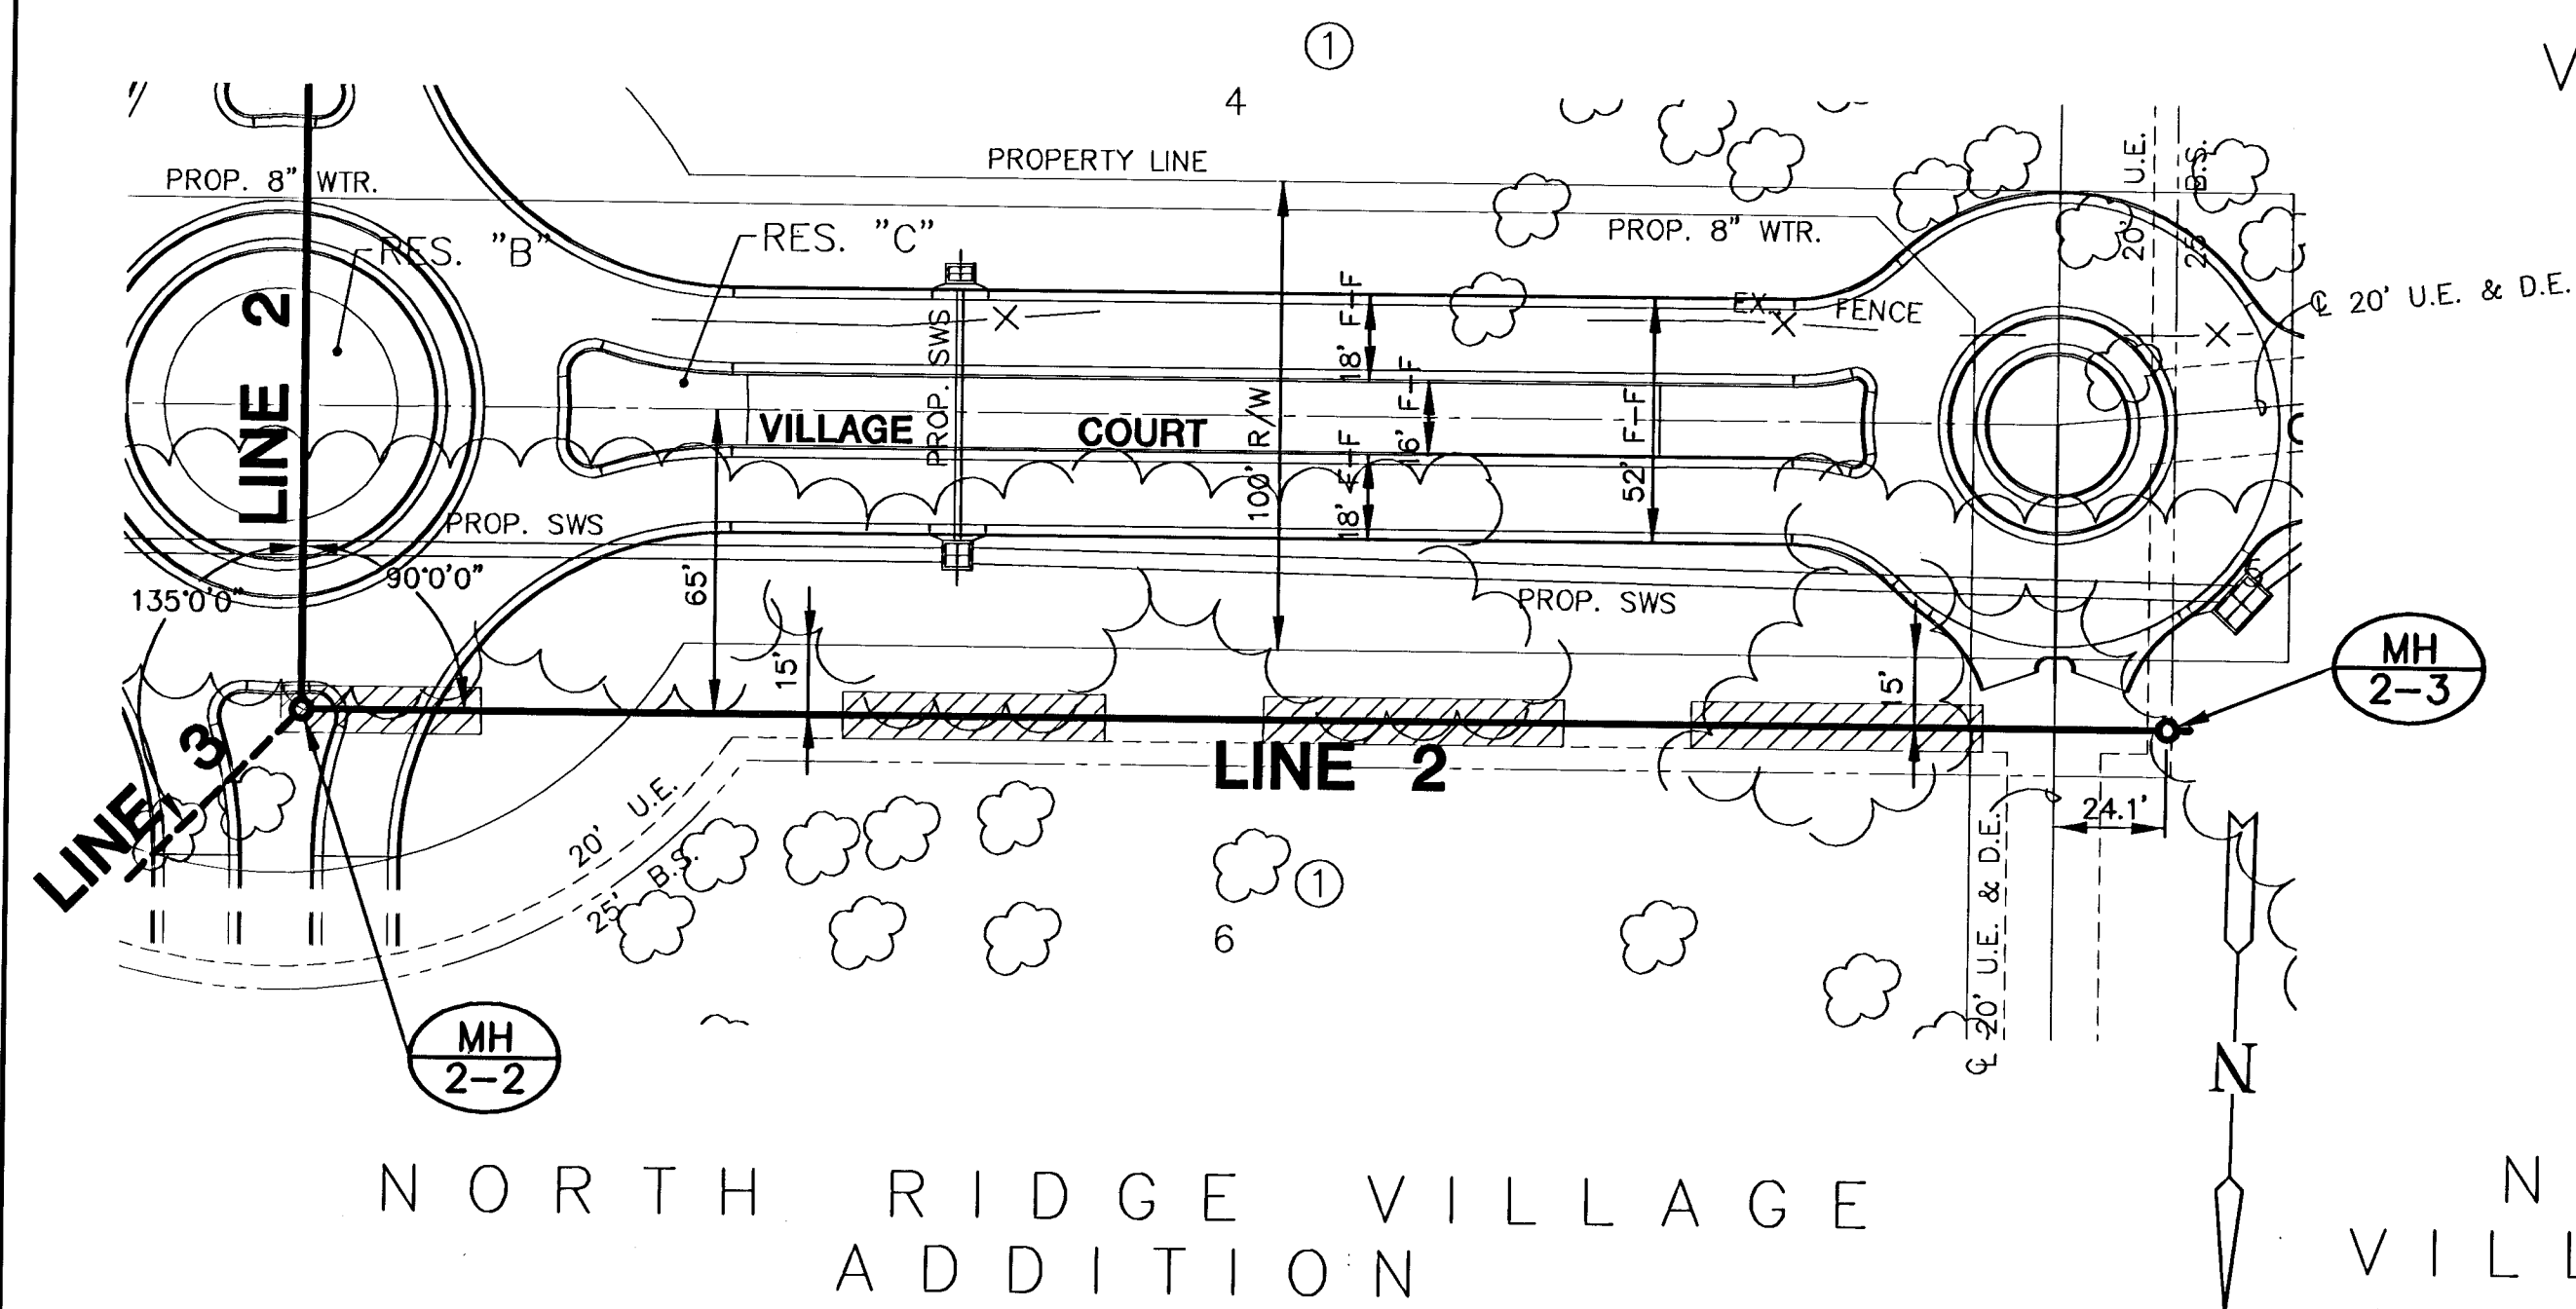


NORTH RIDGE VILLAGE
ADDITION

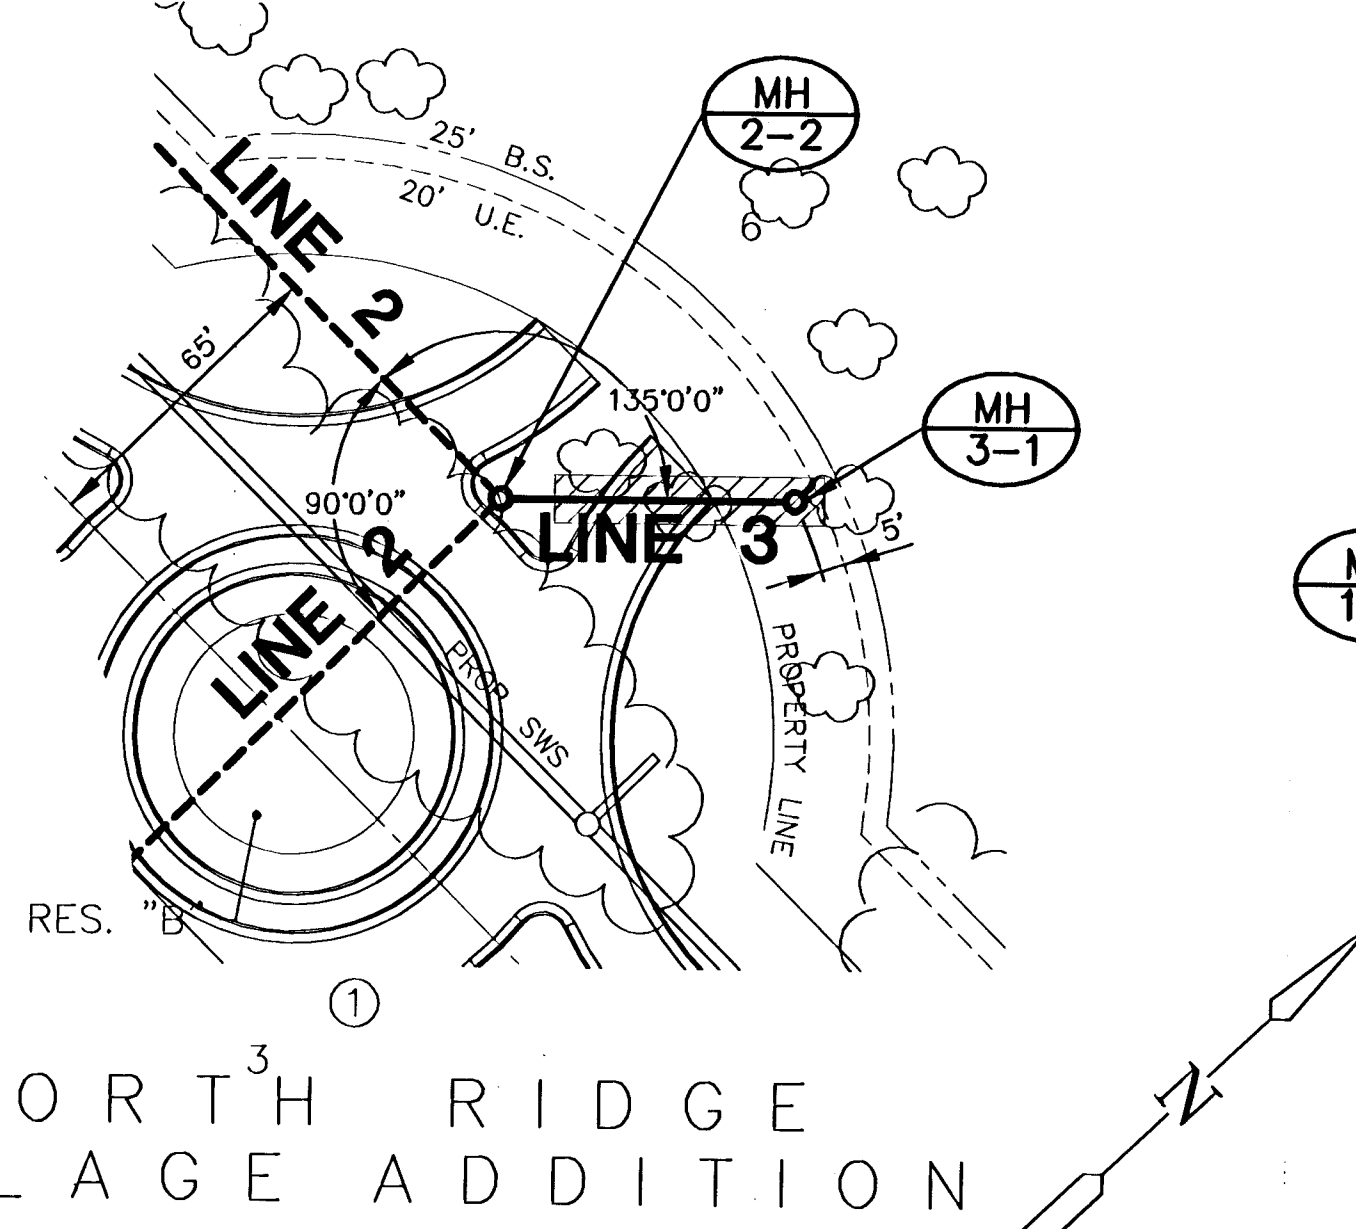


NORTH RIDGE VILLAGE
ADDITION

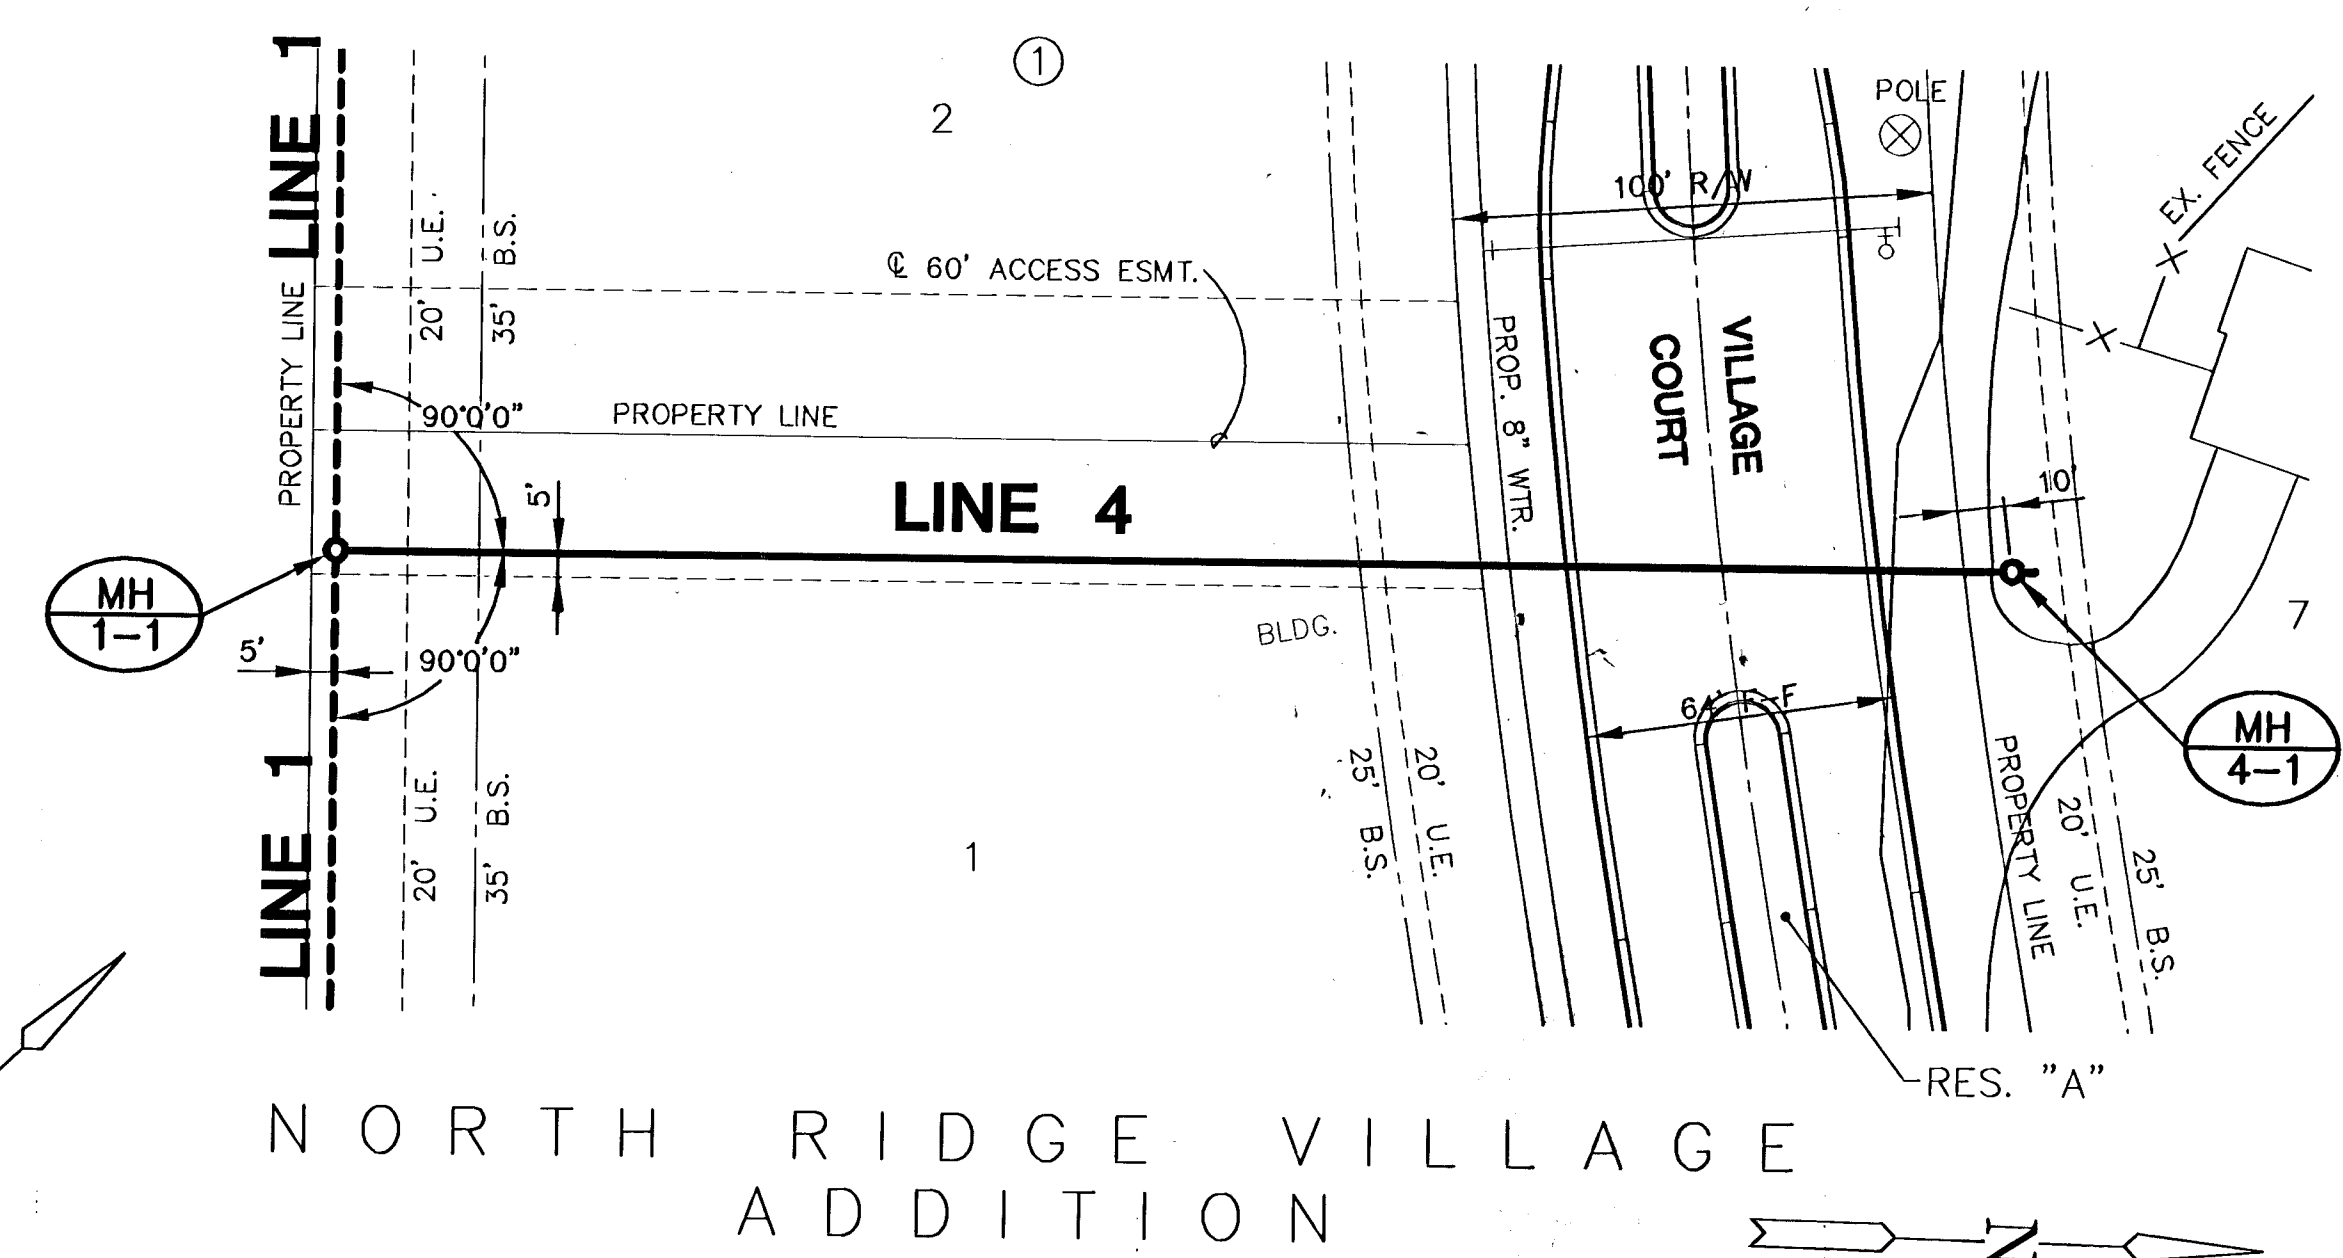

PROFILE LINE 2

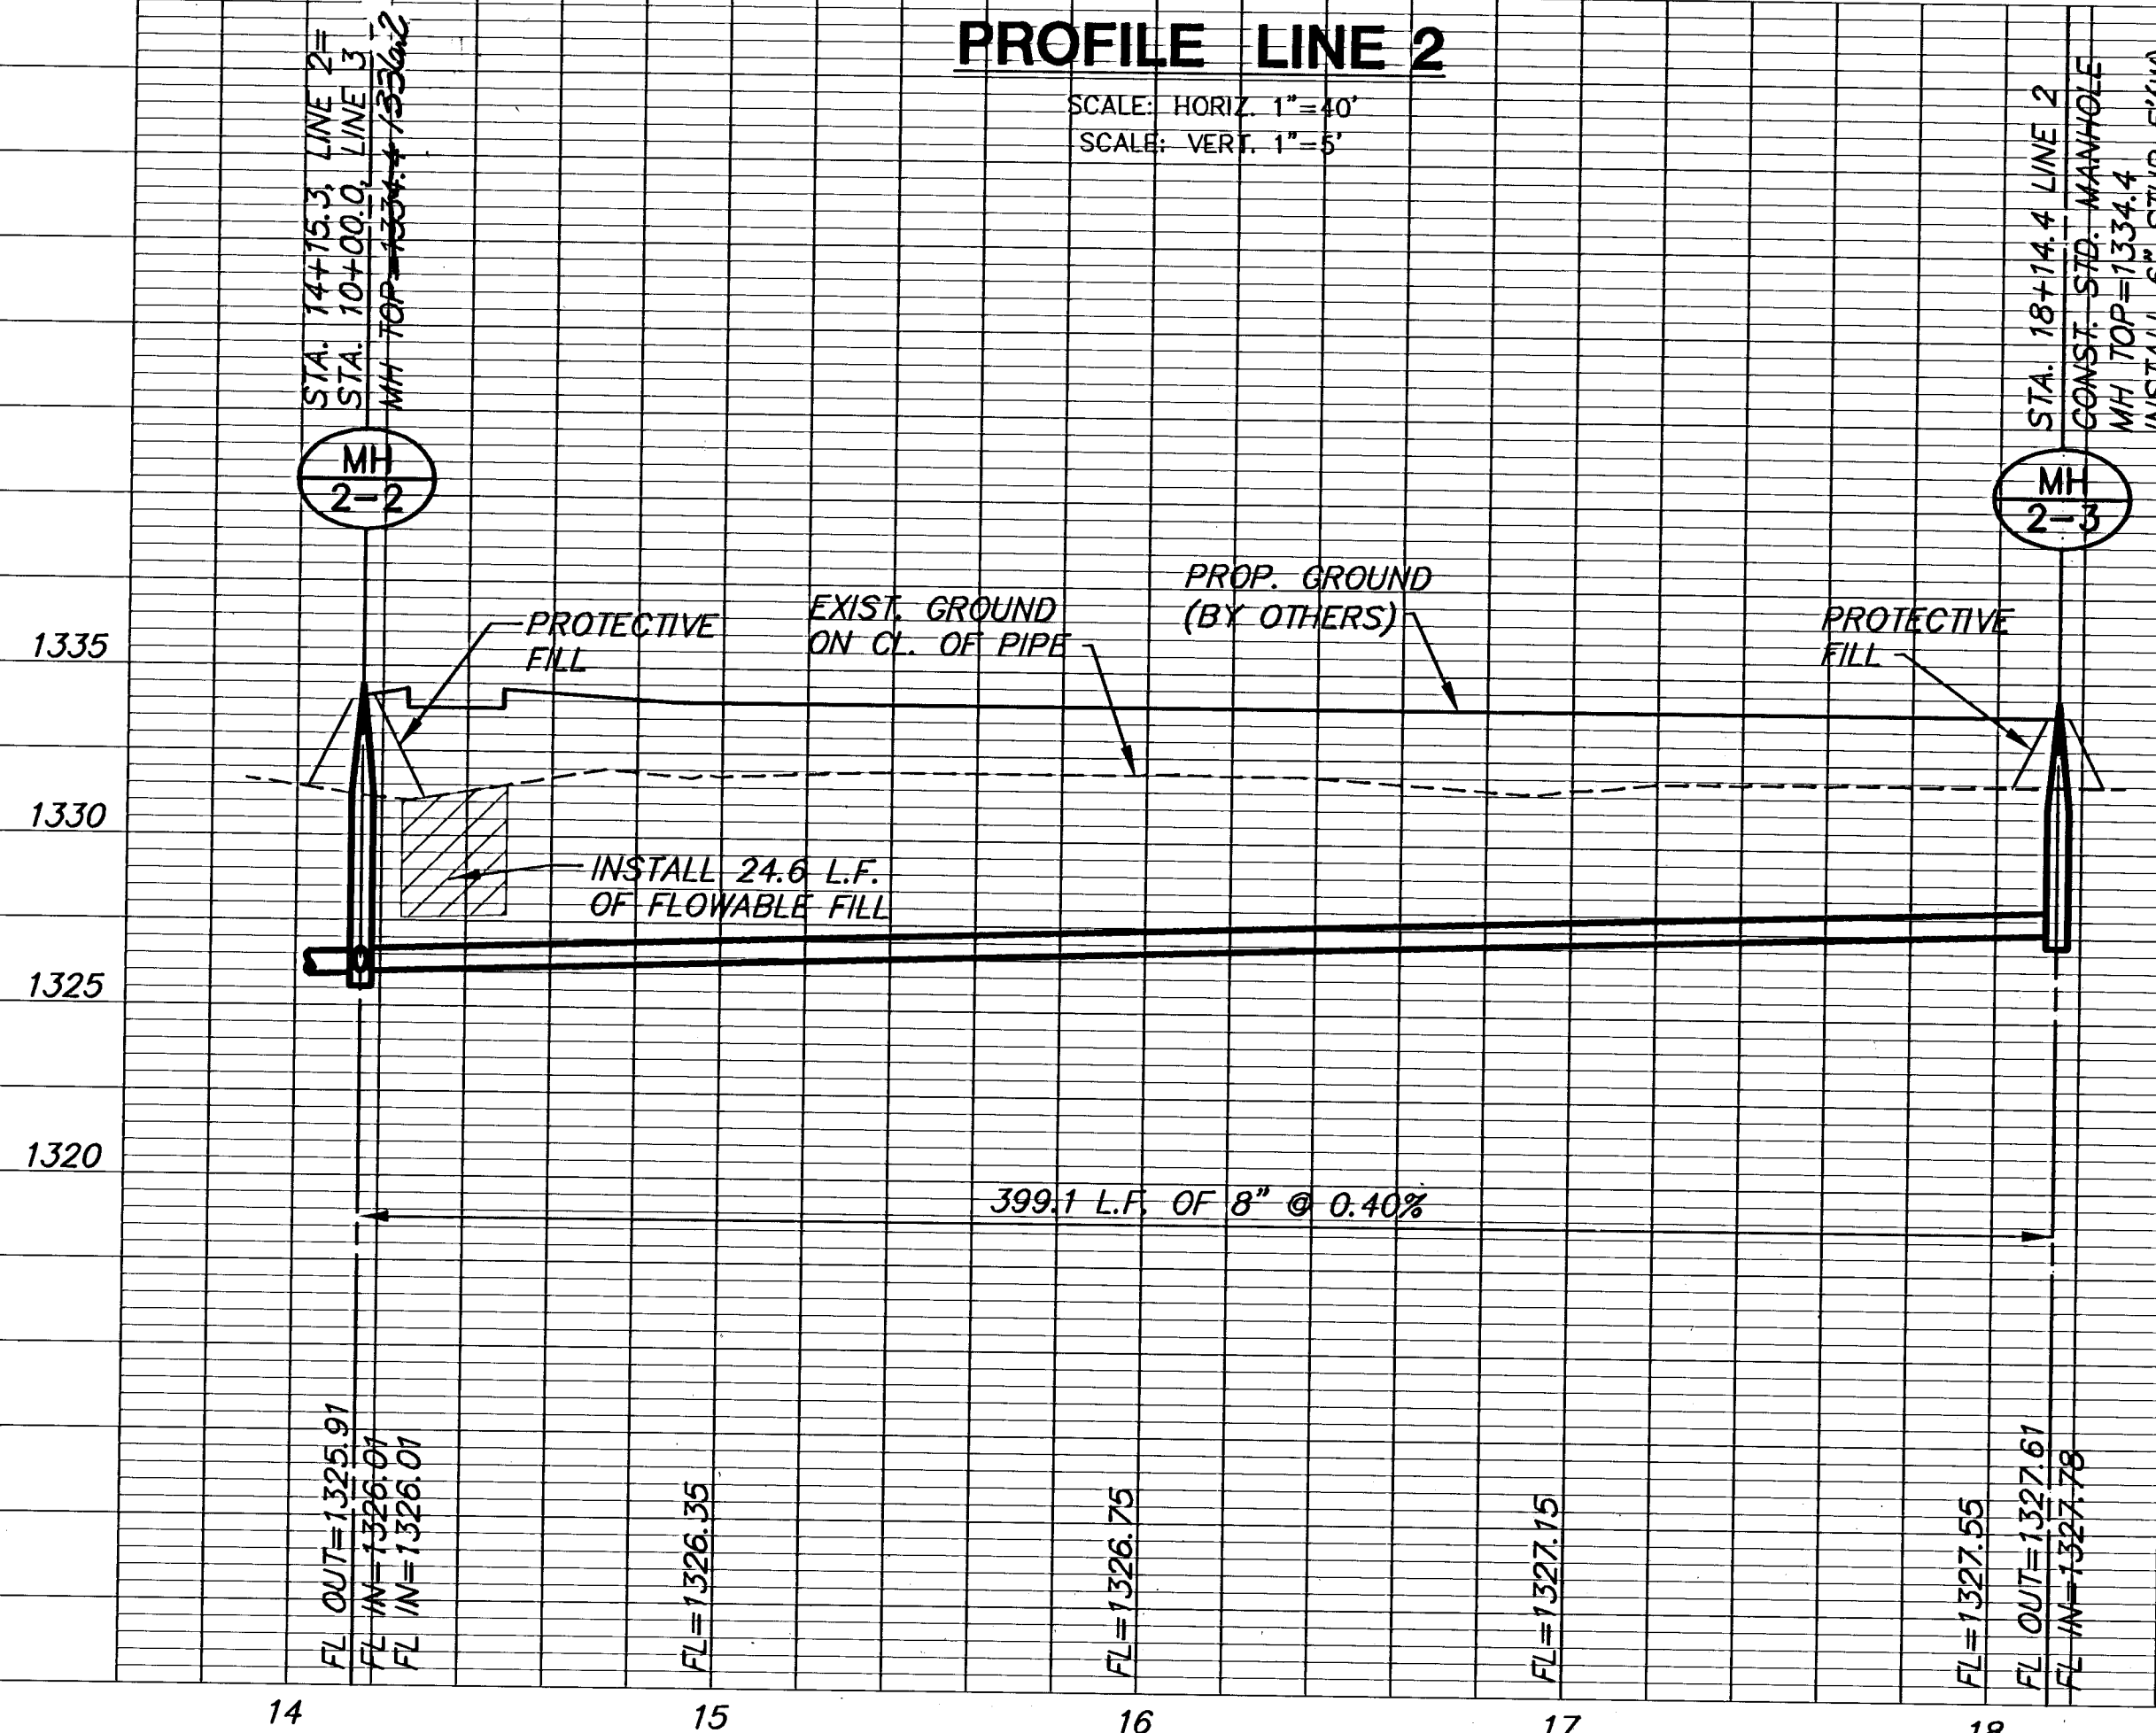

PROFILE LINE 3

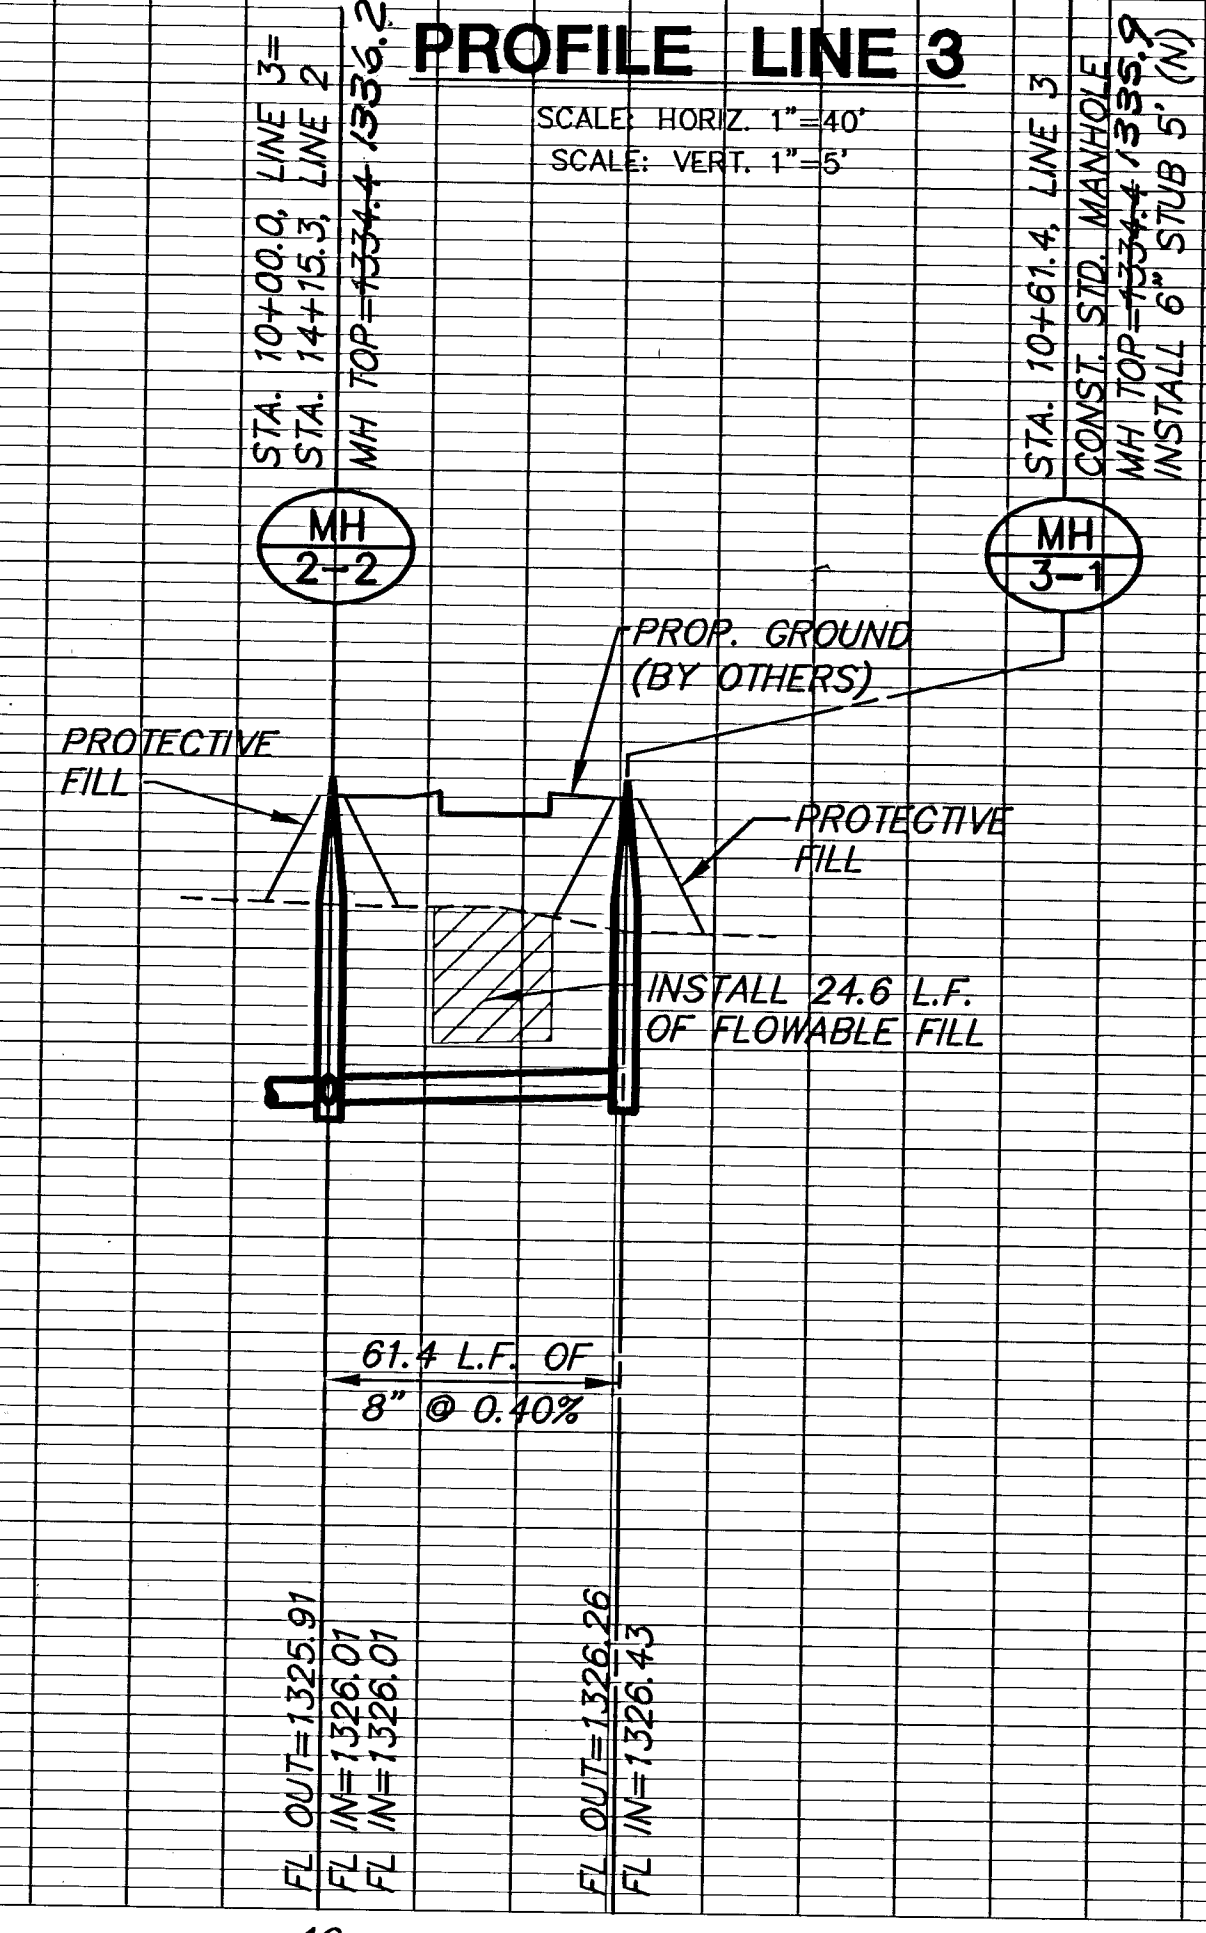

PROFILE LINE 4

