


PLAN	CHECKED	DATE

PROFILE	CHECKED	DATE

DSMR: MDK OPER. CSJ SCALE: 1"=40.00
Q:\2004\04688\001\04688-001-C-SSPP0200 1 06-14-2005 10:59:35 am

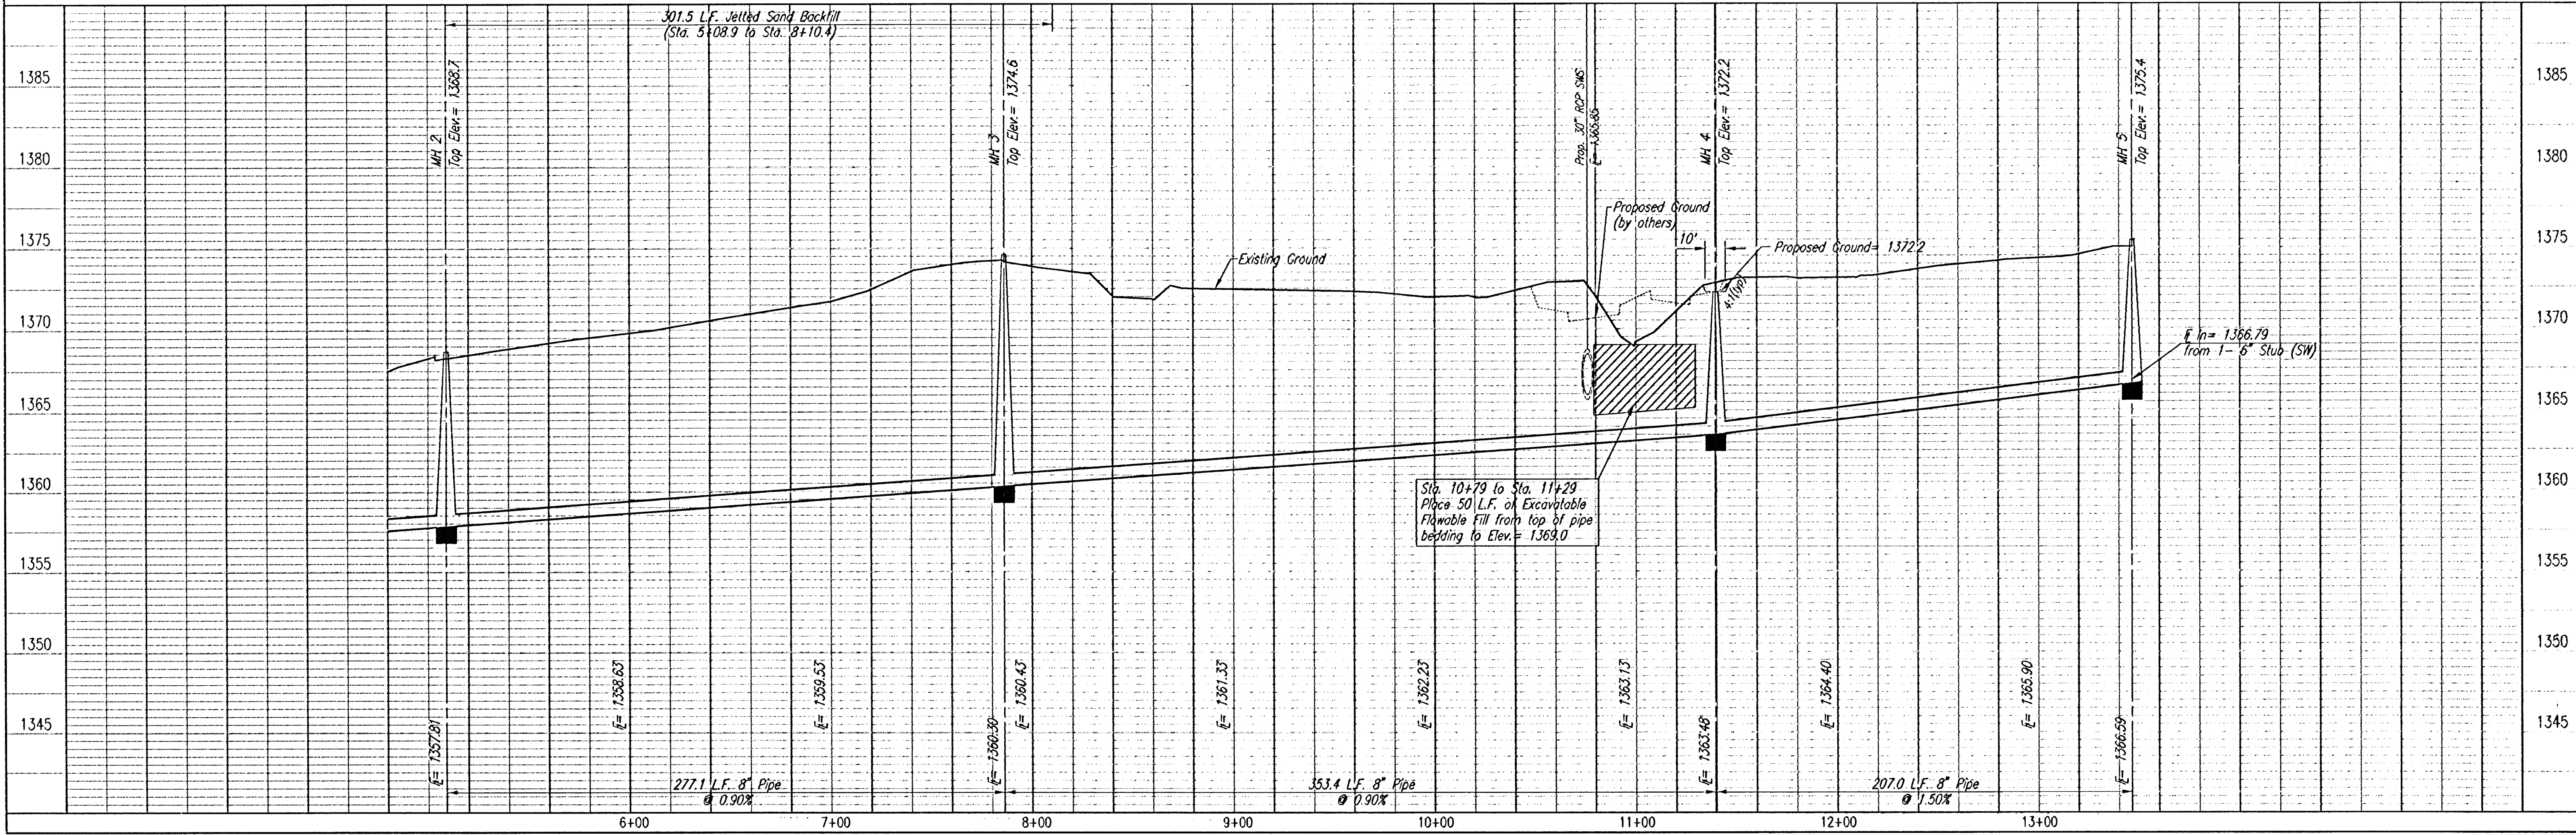

Professional Engineering Consultants, P.A.
303 S. TOPICKA • WICHITA, KANSAS 67202
316-262-2691 • FAX 316-262-3003

SANITARY SEWER LINE NO. 1
JAMES L. ARMOUR, P.E. - ACTING CITY ENGINEER
CITY OF WICHITA PROJECT NO. 468-8394

Designed By: MDK
Drawn By: TLB
Job No.: 35-04688-001
Date: January 2005

Sheet 6 of 18
CHANGE ORDER #1

CAUTION !!
Approximate location of existing City of Wichita water meter, (10801 E. 21st. St. North). Existing 1" water service line to remain active. Location of water service line unknown. This water service line will also be crossed in the vicinity of MH 11 on Sanitary Sewer Line No. 3. Any damage to the water service line shall be repaired by the contractor.

N-387,188.6777, E-2,372,752.5994
Sta. 5+08.7
MH 2

N-387,183.9259, E-2,372,475.4956
Sta. 7+85.8
Const. MH 3
Standard MH

CAUTION !!!
Proposed 30" RCP Storm Sewer (by others)

N-387,177.8662, E-2,372,122.1159
Sta. 11+39.2
Const. MH 4
Standard MH

N-387,174.3171, E-2,371,915.1463
Sta. 13+46.2
Const. MH 5
Standard MH

Install 1-6" Stub and Plug.

Abandoned water service (10715 E. 21st. Street North) Water meter to be removed by City of Wichita Water Department.

Remove 19 L.F. Asphalt drive. Do not replace.

Install 353.4 L.F. 8" Pipe.

Remove Fence as required. Do not replace.

Install 207.0 L.F. 8" Pipe.

SEE SHEET NO. 3 & 4 FOR PLAT COORDINATES



SCALE: 0 40 80
PLAN: LAT. & LONG.
PROFILE: HORIZ. SAME AS ABOVE
VERT. 0 5

No.	Revision	By	Date
1	CHANGE ORDER #1 - SANITARY SEWER ALIGNMENT CHANGE	MDK	06/14/05