



PLAN	CHECKED	DATE

PROFILE	CHECKED	DATE


DSNR MDK OPER: CSL SCALE: 1"=40.00
Q:\2004\04688\001\04688-001-C-SSPP0400 1 06-14-2005 10:05:41 am

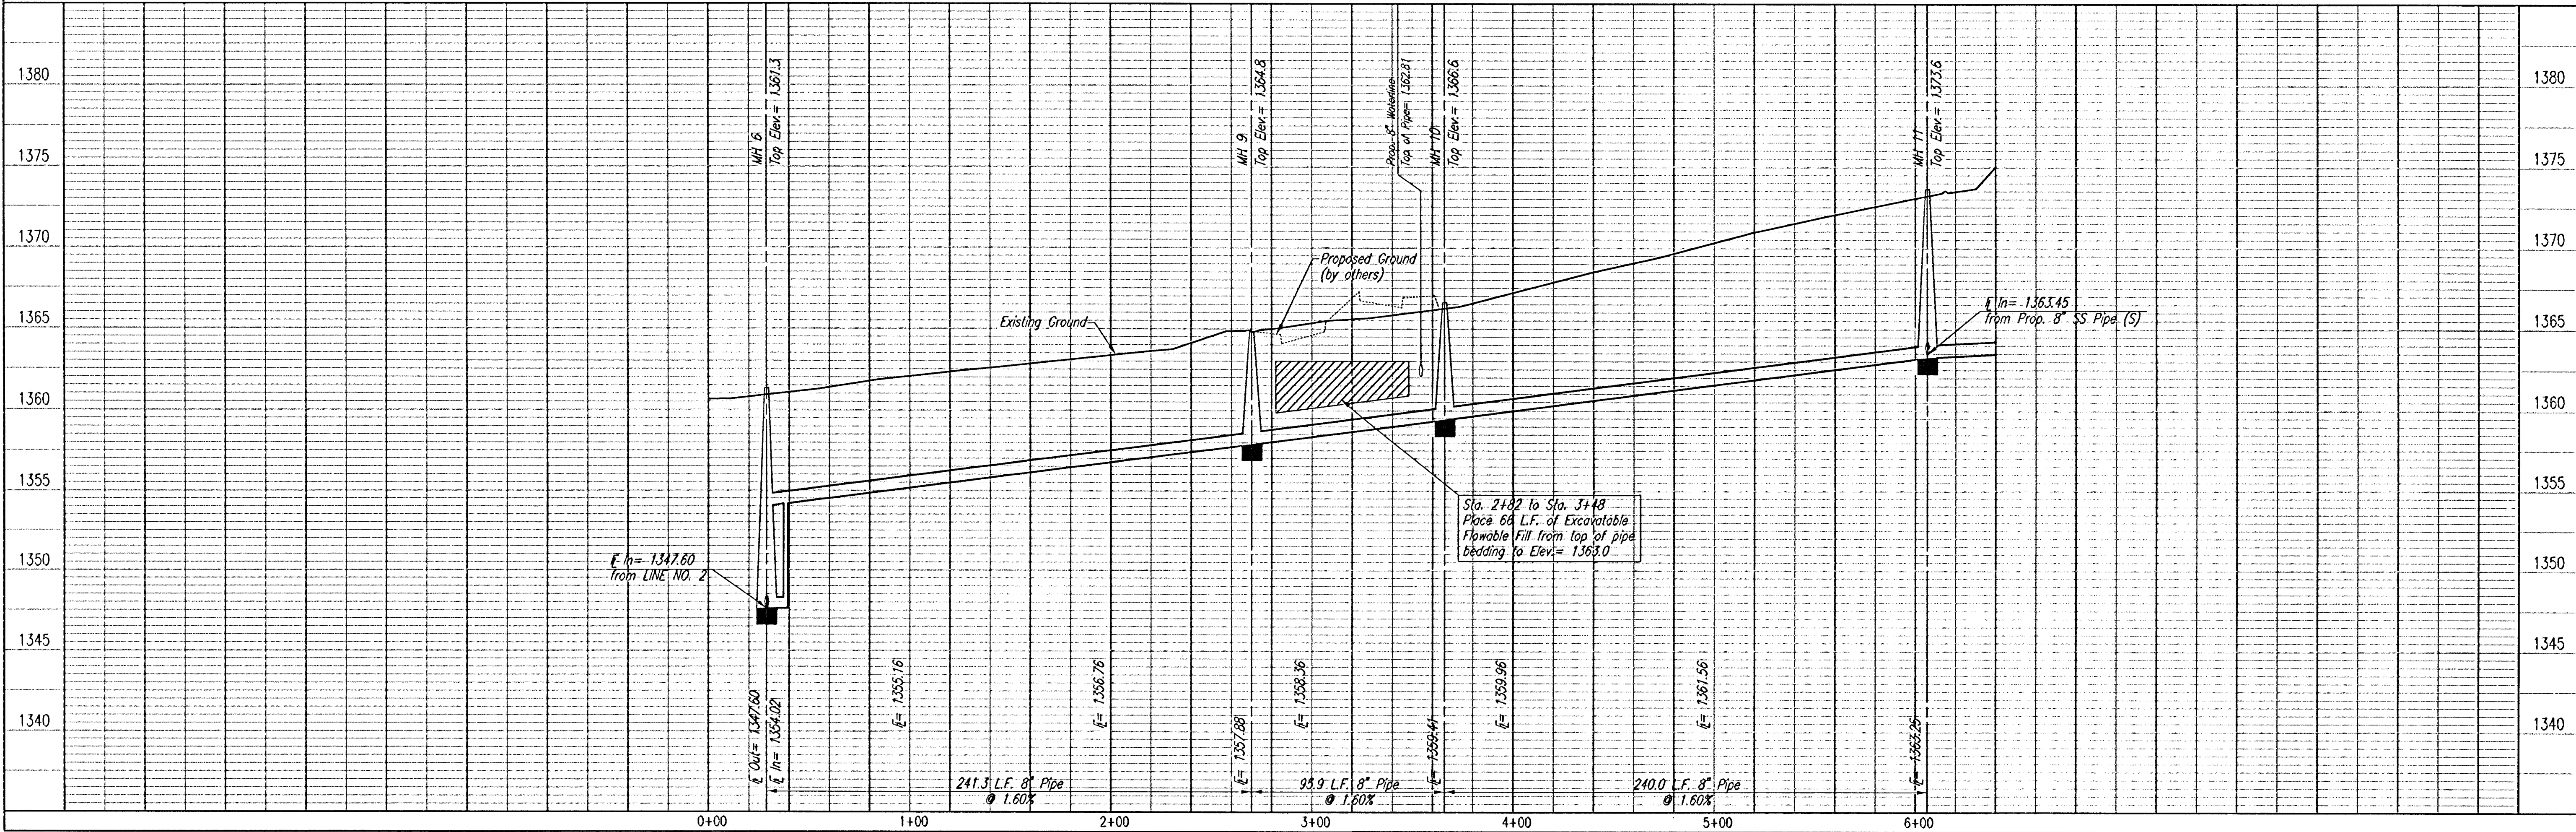

SANITARY SEWER LINE NO. 3

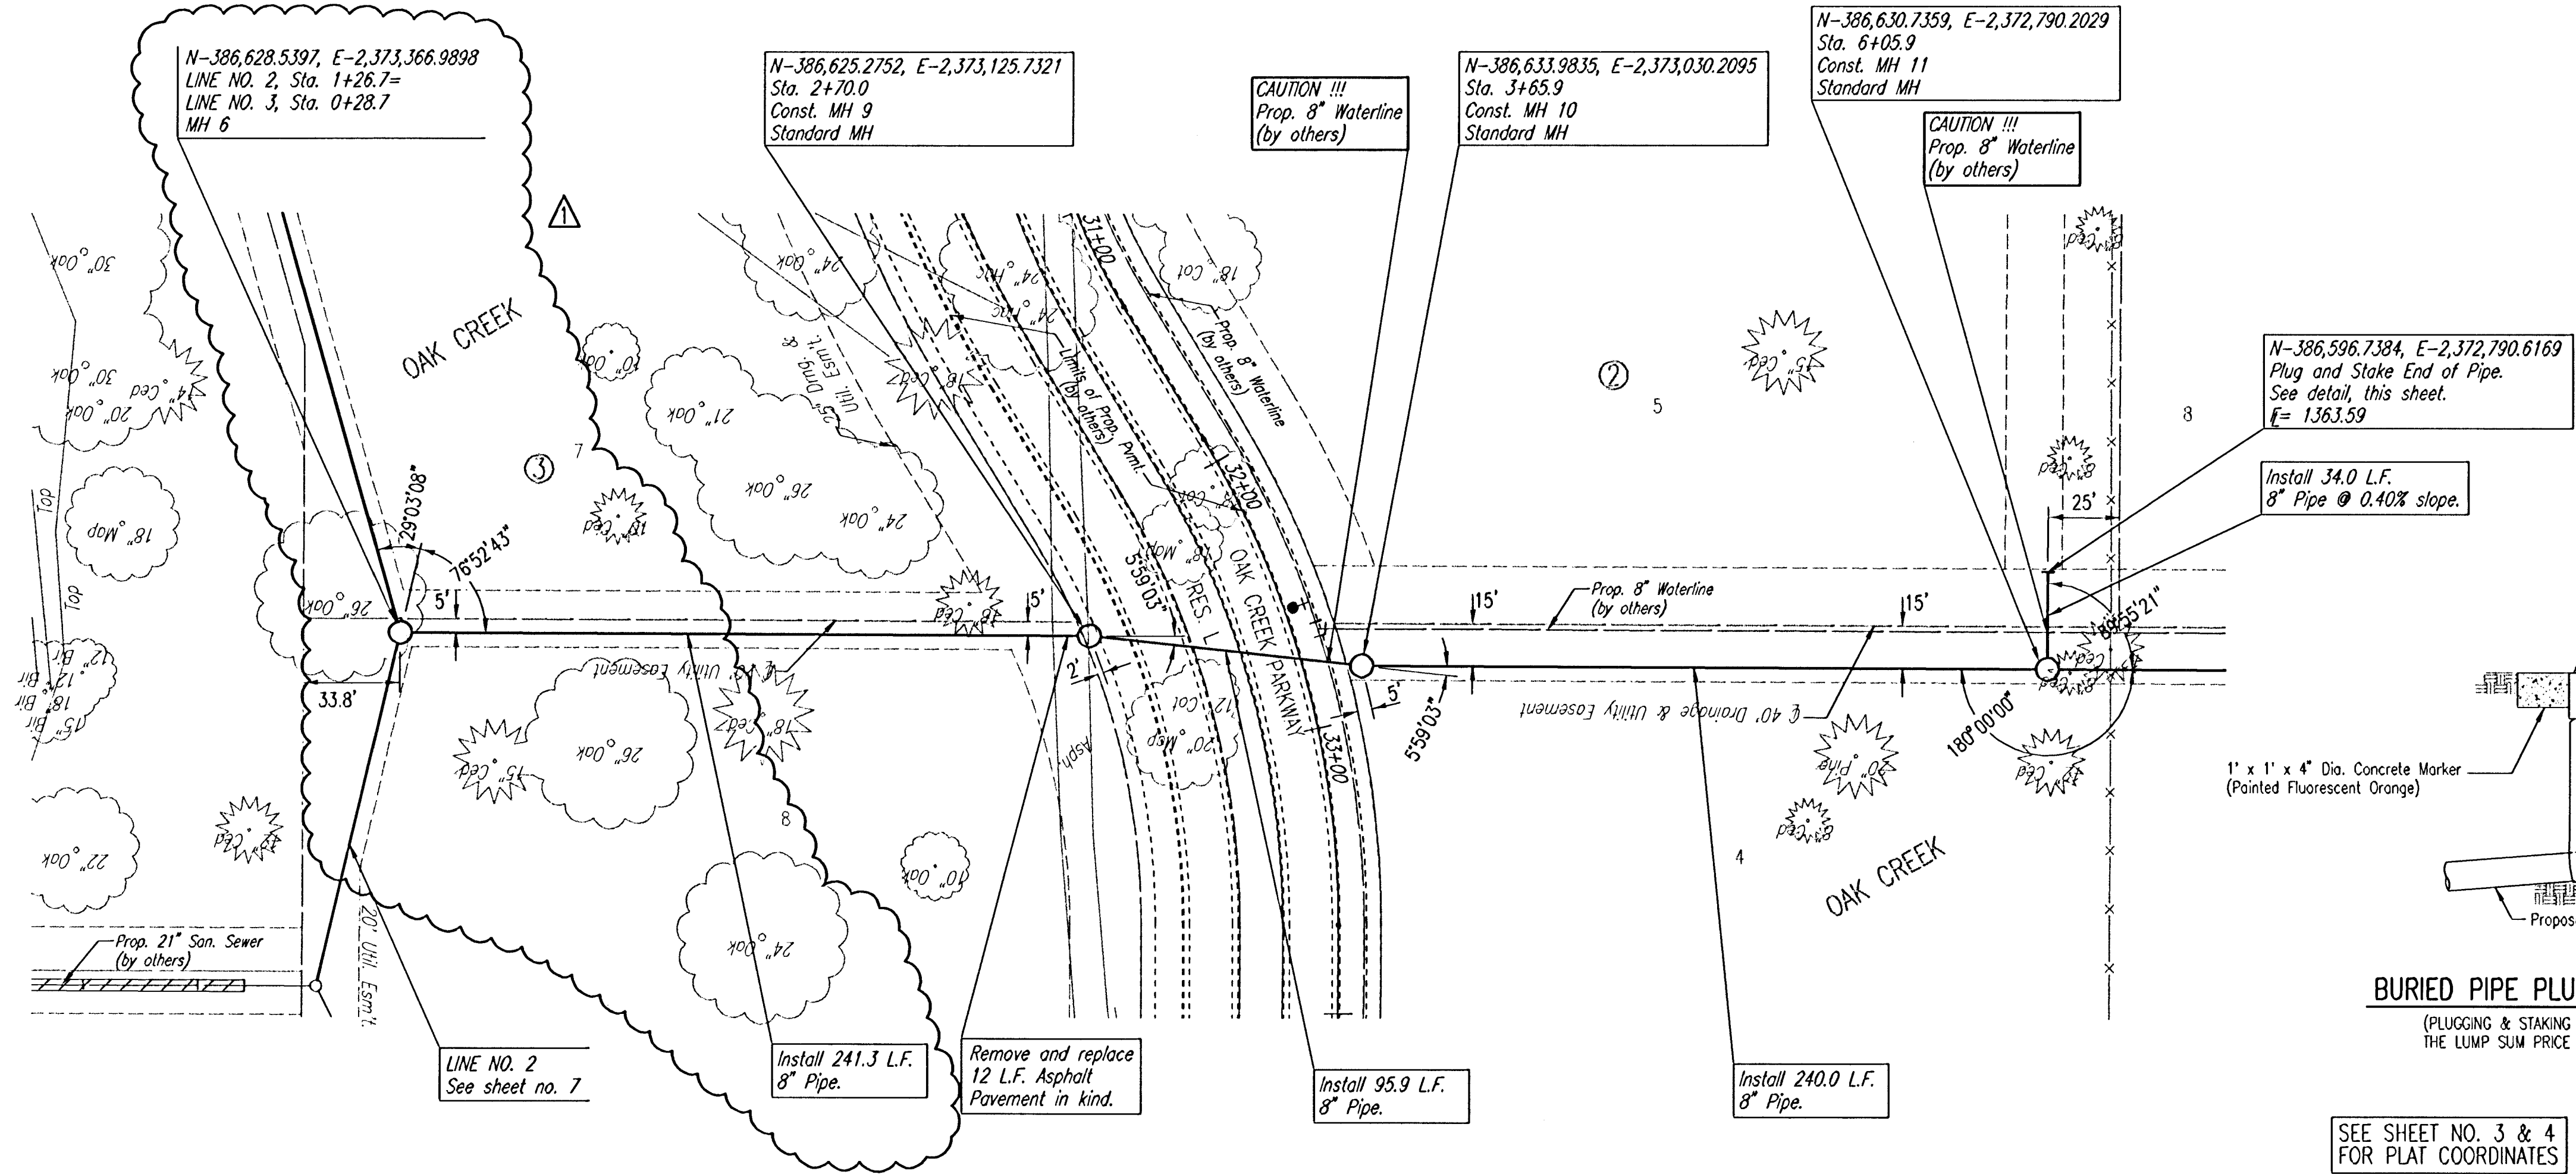

SCALE:
PLAN: LAT. & LONG. 0 40 80
PROFILE: HORZ. SAME AS ABOVE
VERT. 0 5

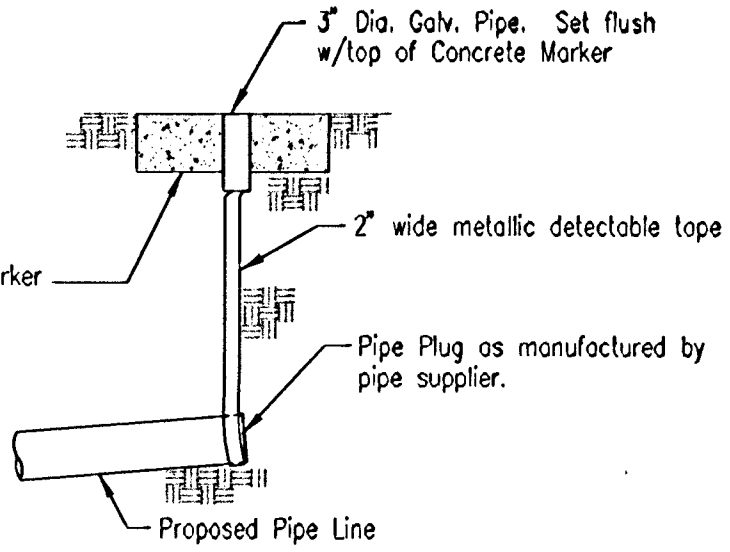

BURIED PIPE PLUG & MARKER DETAIL
(PLUGGING & STAKING SHALL BE SUBSIDIARY TO THE LUMP SUM PRICE BID FOR PIPE IN PLACE)

SEE SHEET NO. 3 & 4
FOR PLAT COORDINATES



LATERAL 1, MAIN 16
OF THE FOUR MILE CREEK SEWER
SANITARY SEWER LINE NO. 3
JAMES L. ARMOUR, P.E. - ACTING CITY ENGINEER
CITY OF WICHITA PROJECT NO. 468-83984

Professional Engineering Consultants, P.A.
303 S. TOPEKA • WICHITA, KANSAS 67202
316-262-2891 • FAX 316-262-3003
Designed By: MDK
Drawn By: TLB
Job No: 35-04688-001
Date: January 2005