



PLAN	CHECKED	DATE

PROFILE	CHECKED	DATE


DSNR: MDK OPER: JLM SCALE: 1"=40.00
 Q:\2004\04688\001\04688-001-C-SSPP07 04-06-2005 11:21:33 am

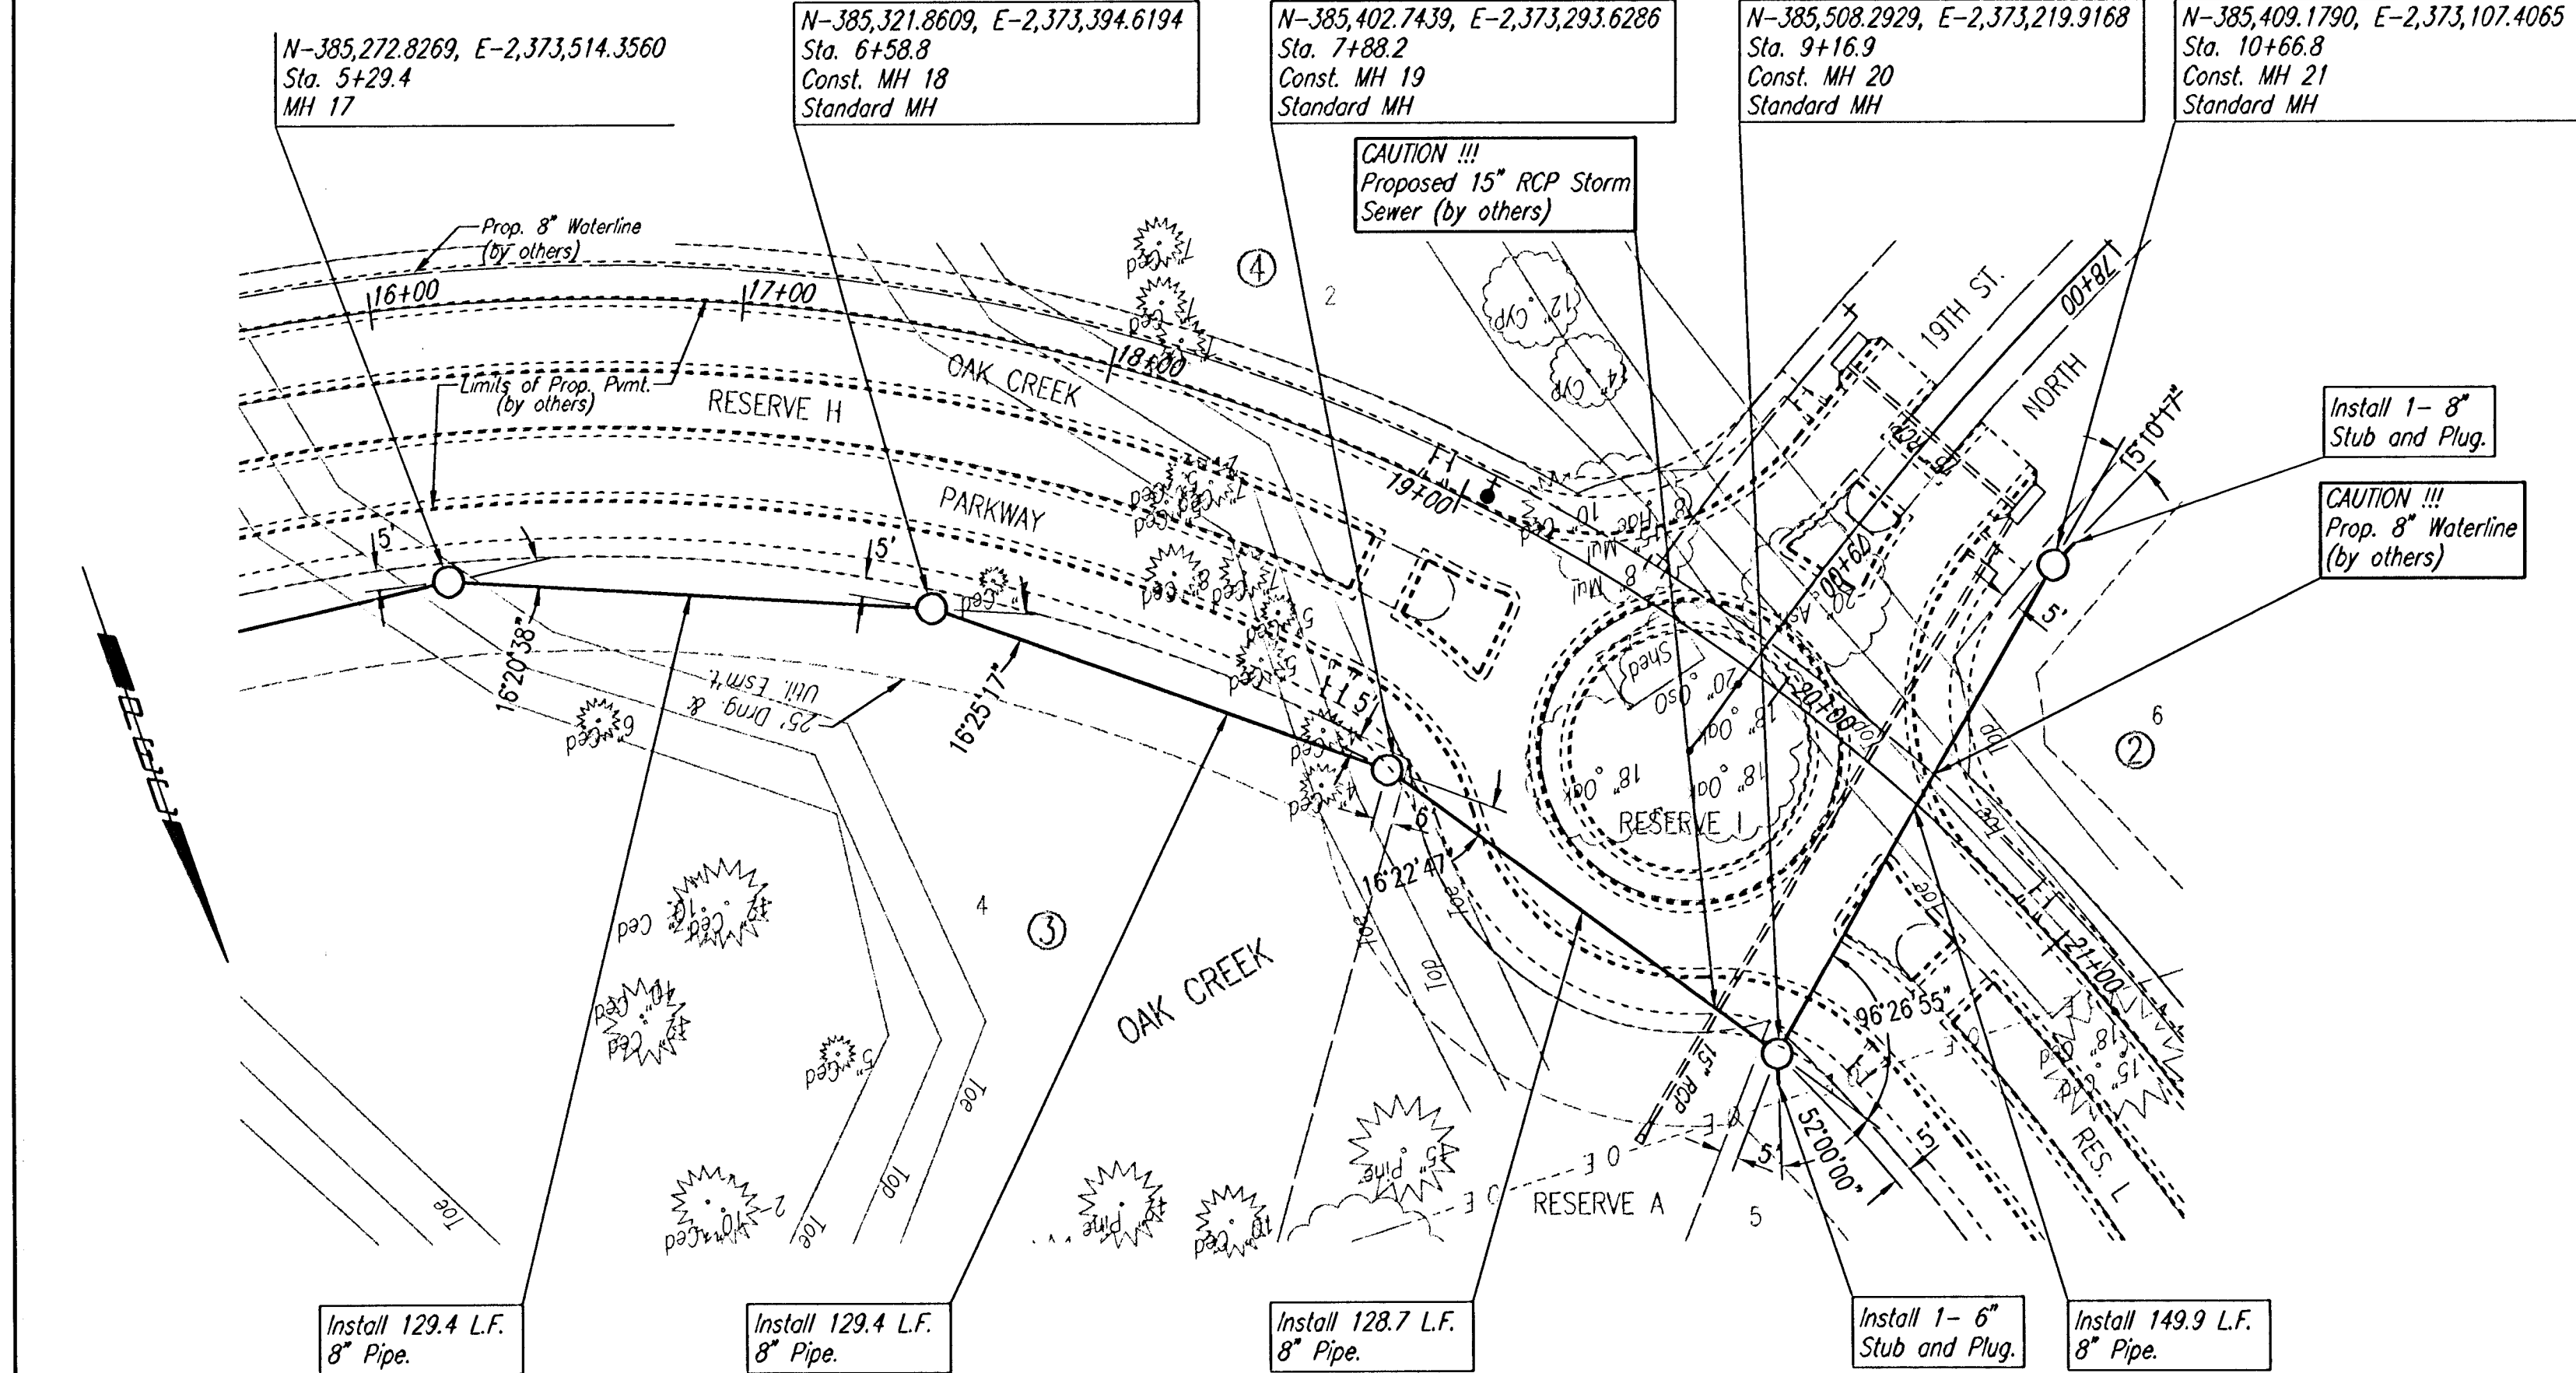


SANITARY SEWER LINE NO. 4

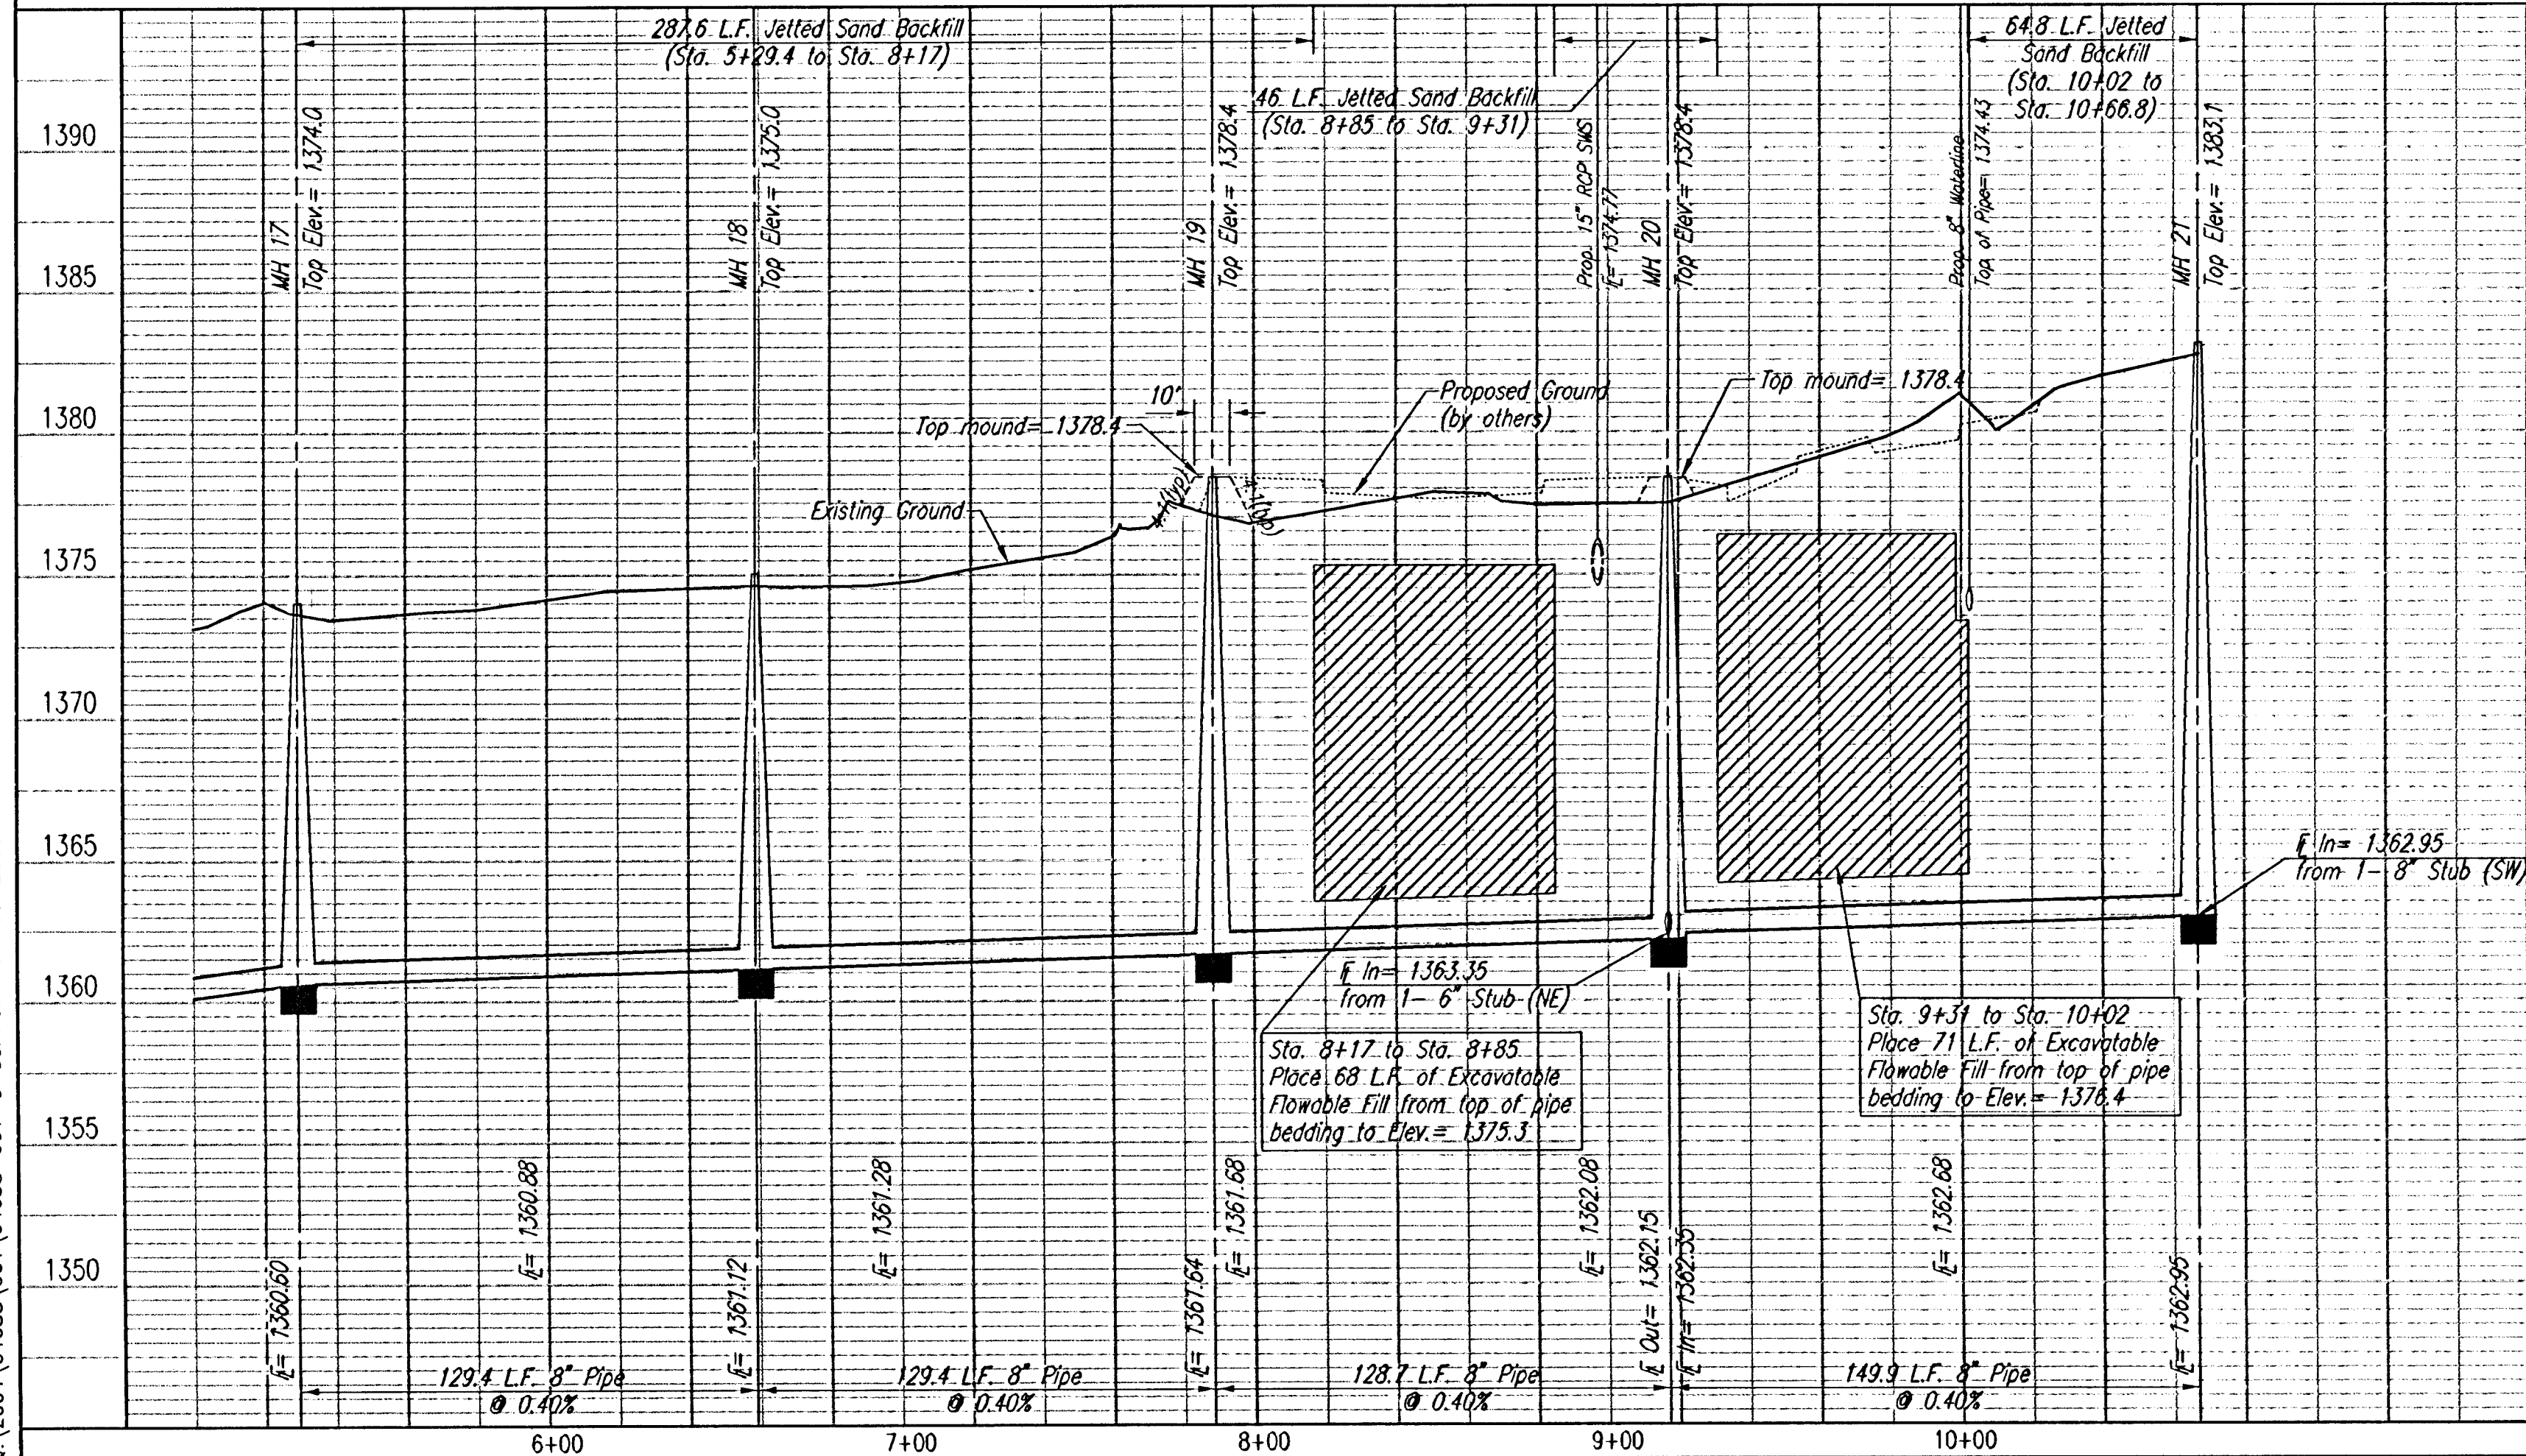

SANITARY SEWER LINE NO. 5

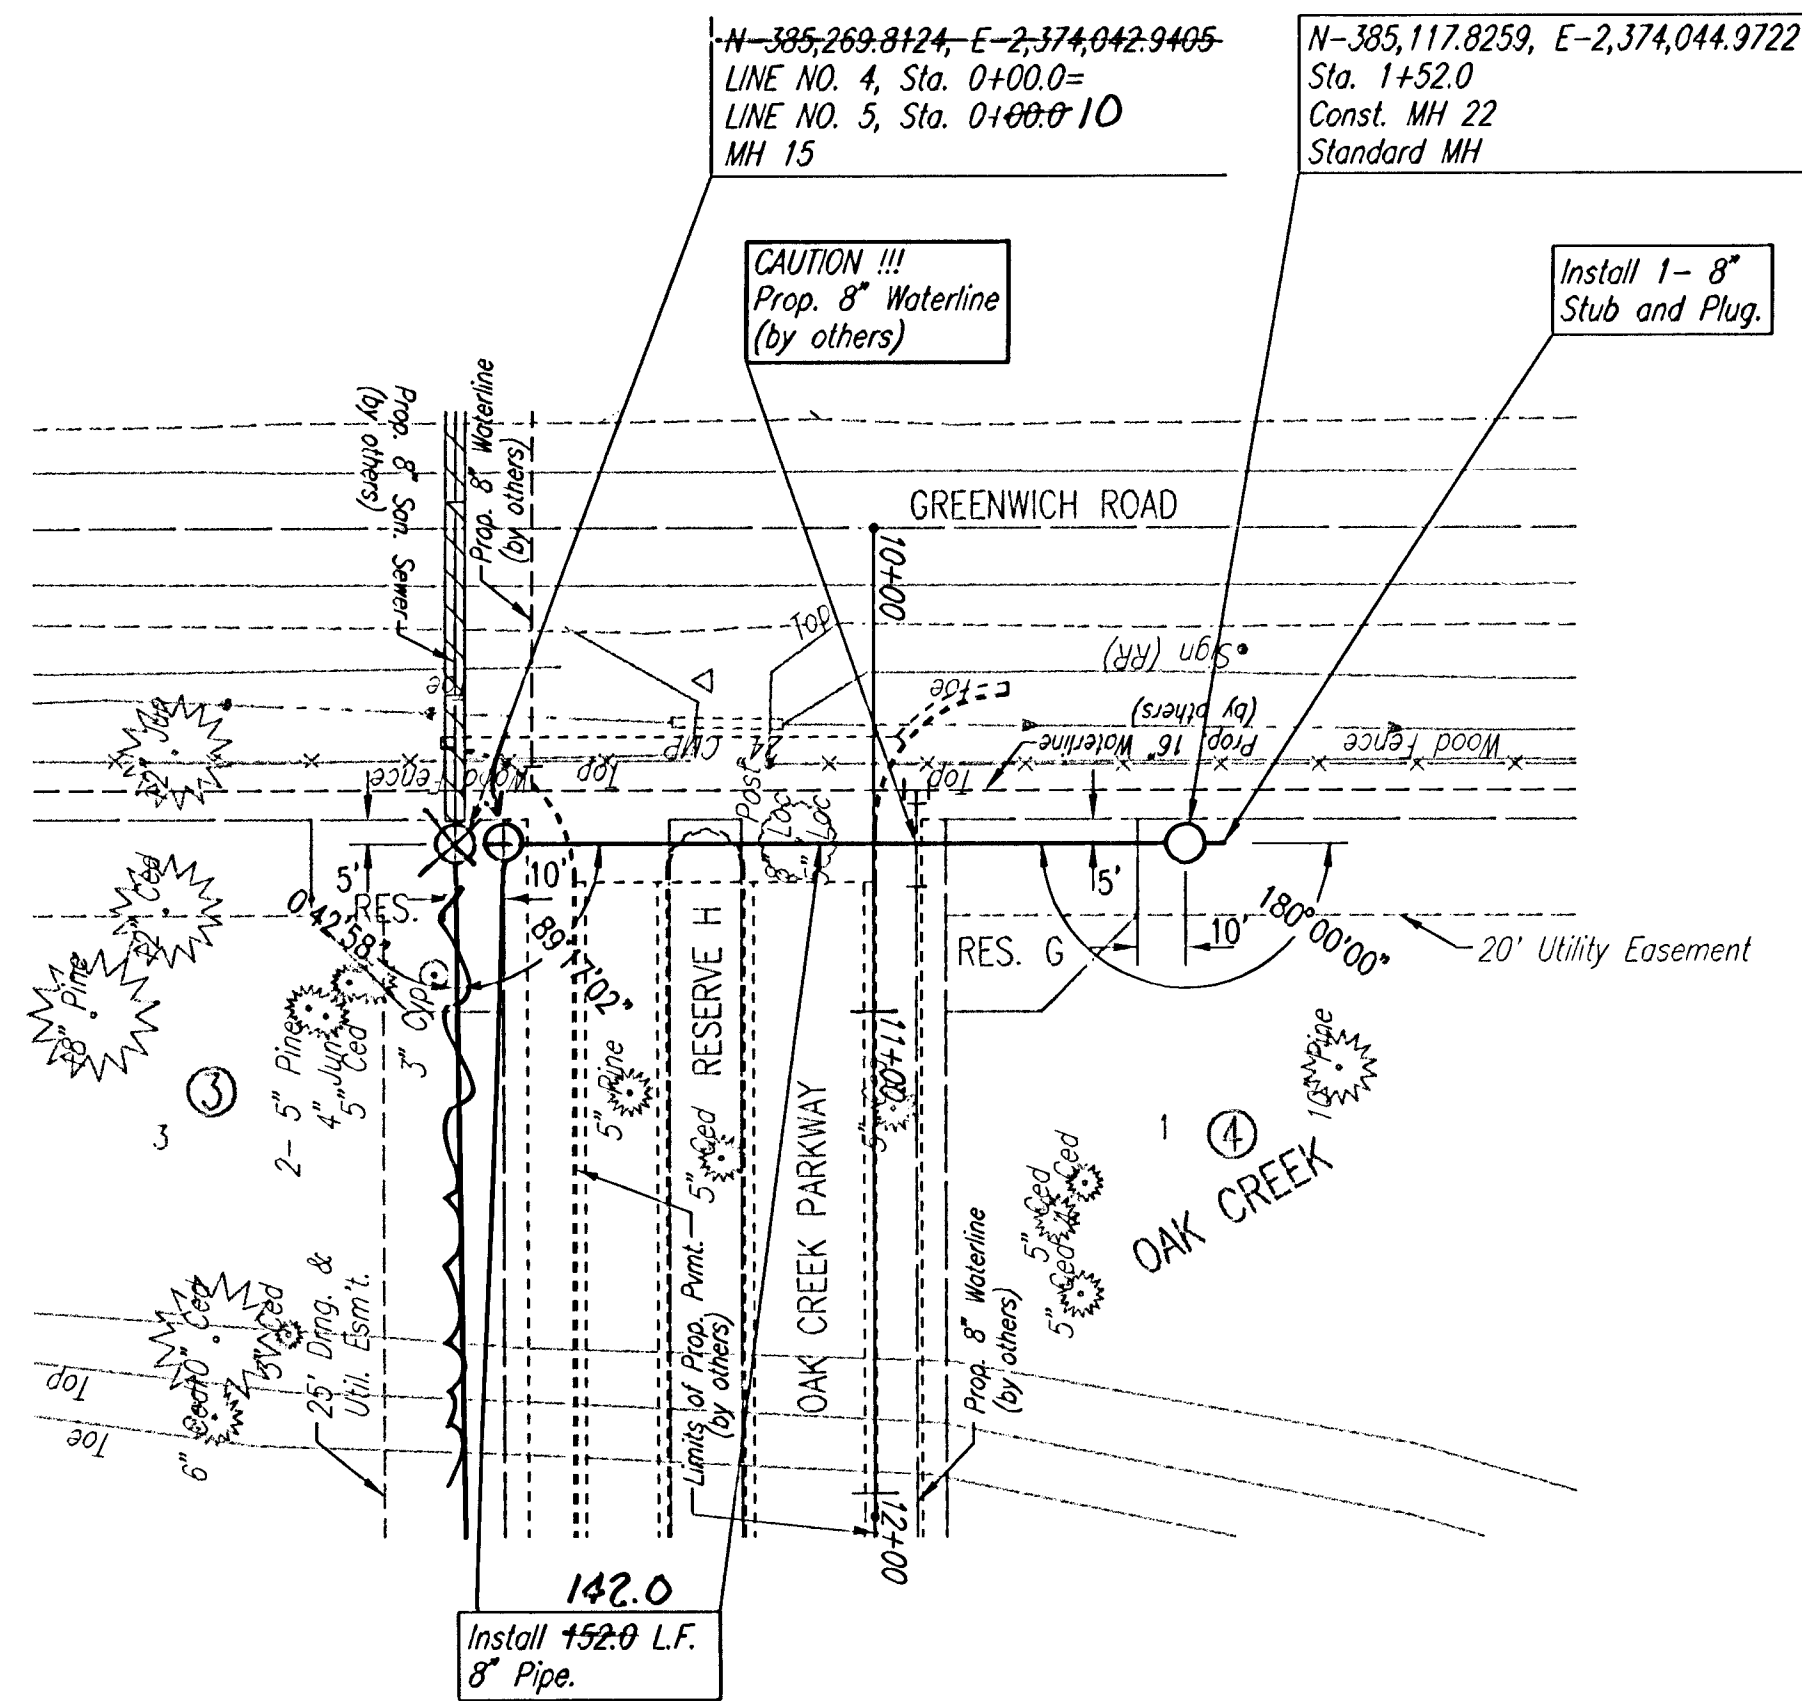

SEE SHEET NO. 3 & 4
 FOR PLAT COORDINATES

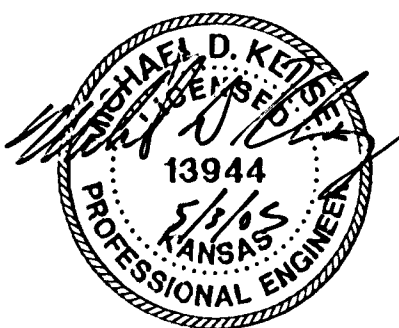

LATERAL 1, MAIN 16
 OF THE FOUR MILE CREEK SEWER
SANITARY SEWER LINE NO. 4 & 5
 JAMES L. ARMOUR, P.E. - ACTING CITY ENGINEER
 CITY OF WICHITA PROJECT NO. 468-83984

Professional Engineering Consultants, P.A.
 303 S. TOPEKA - WICHITA, KANSAS 67202
 316-262-2691 • FAX 316-262-3003

Designed By: MDK
 Drawn By: TLB
 Job No.: 35-04688-001
 Date: January 2005