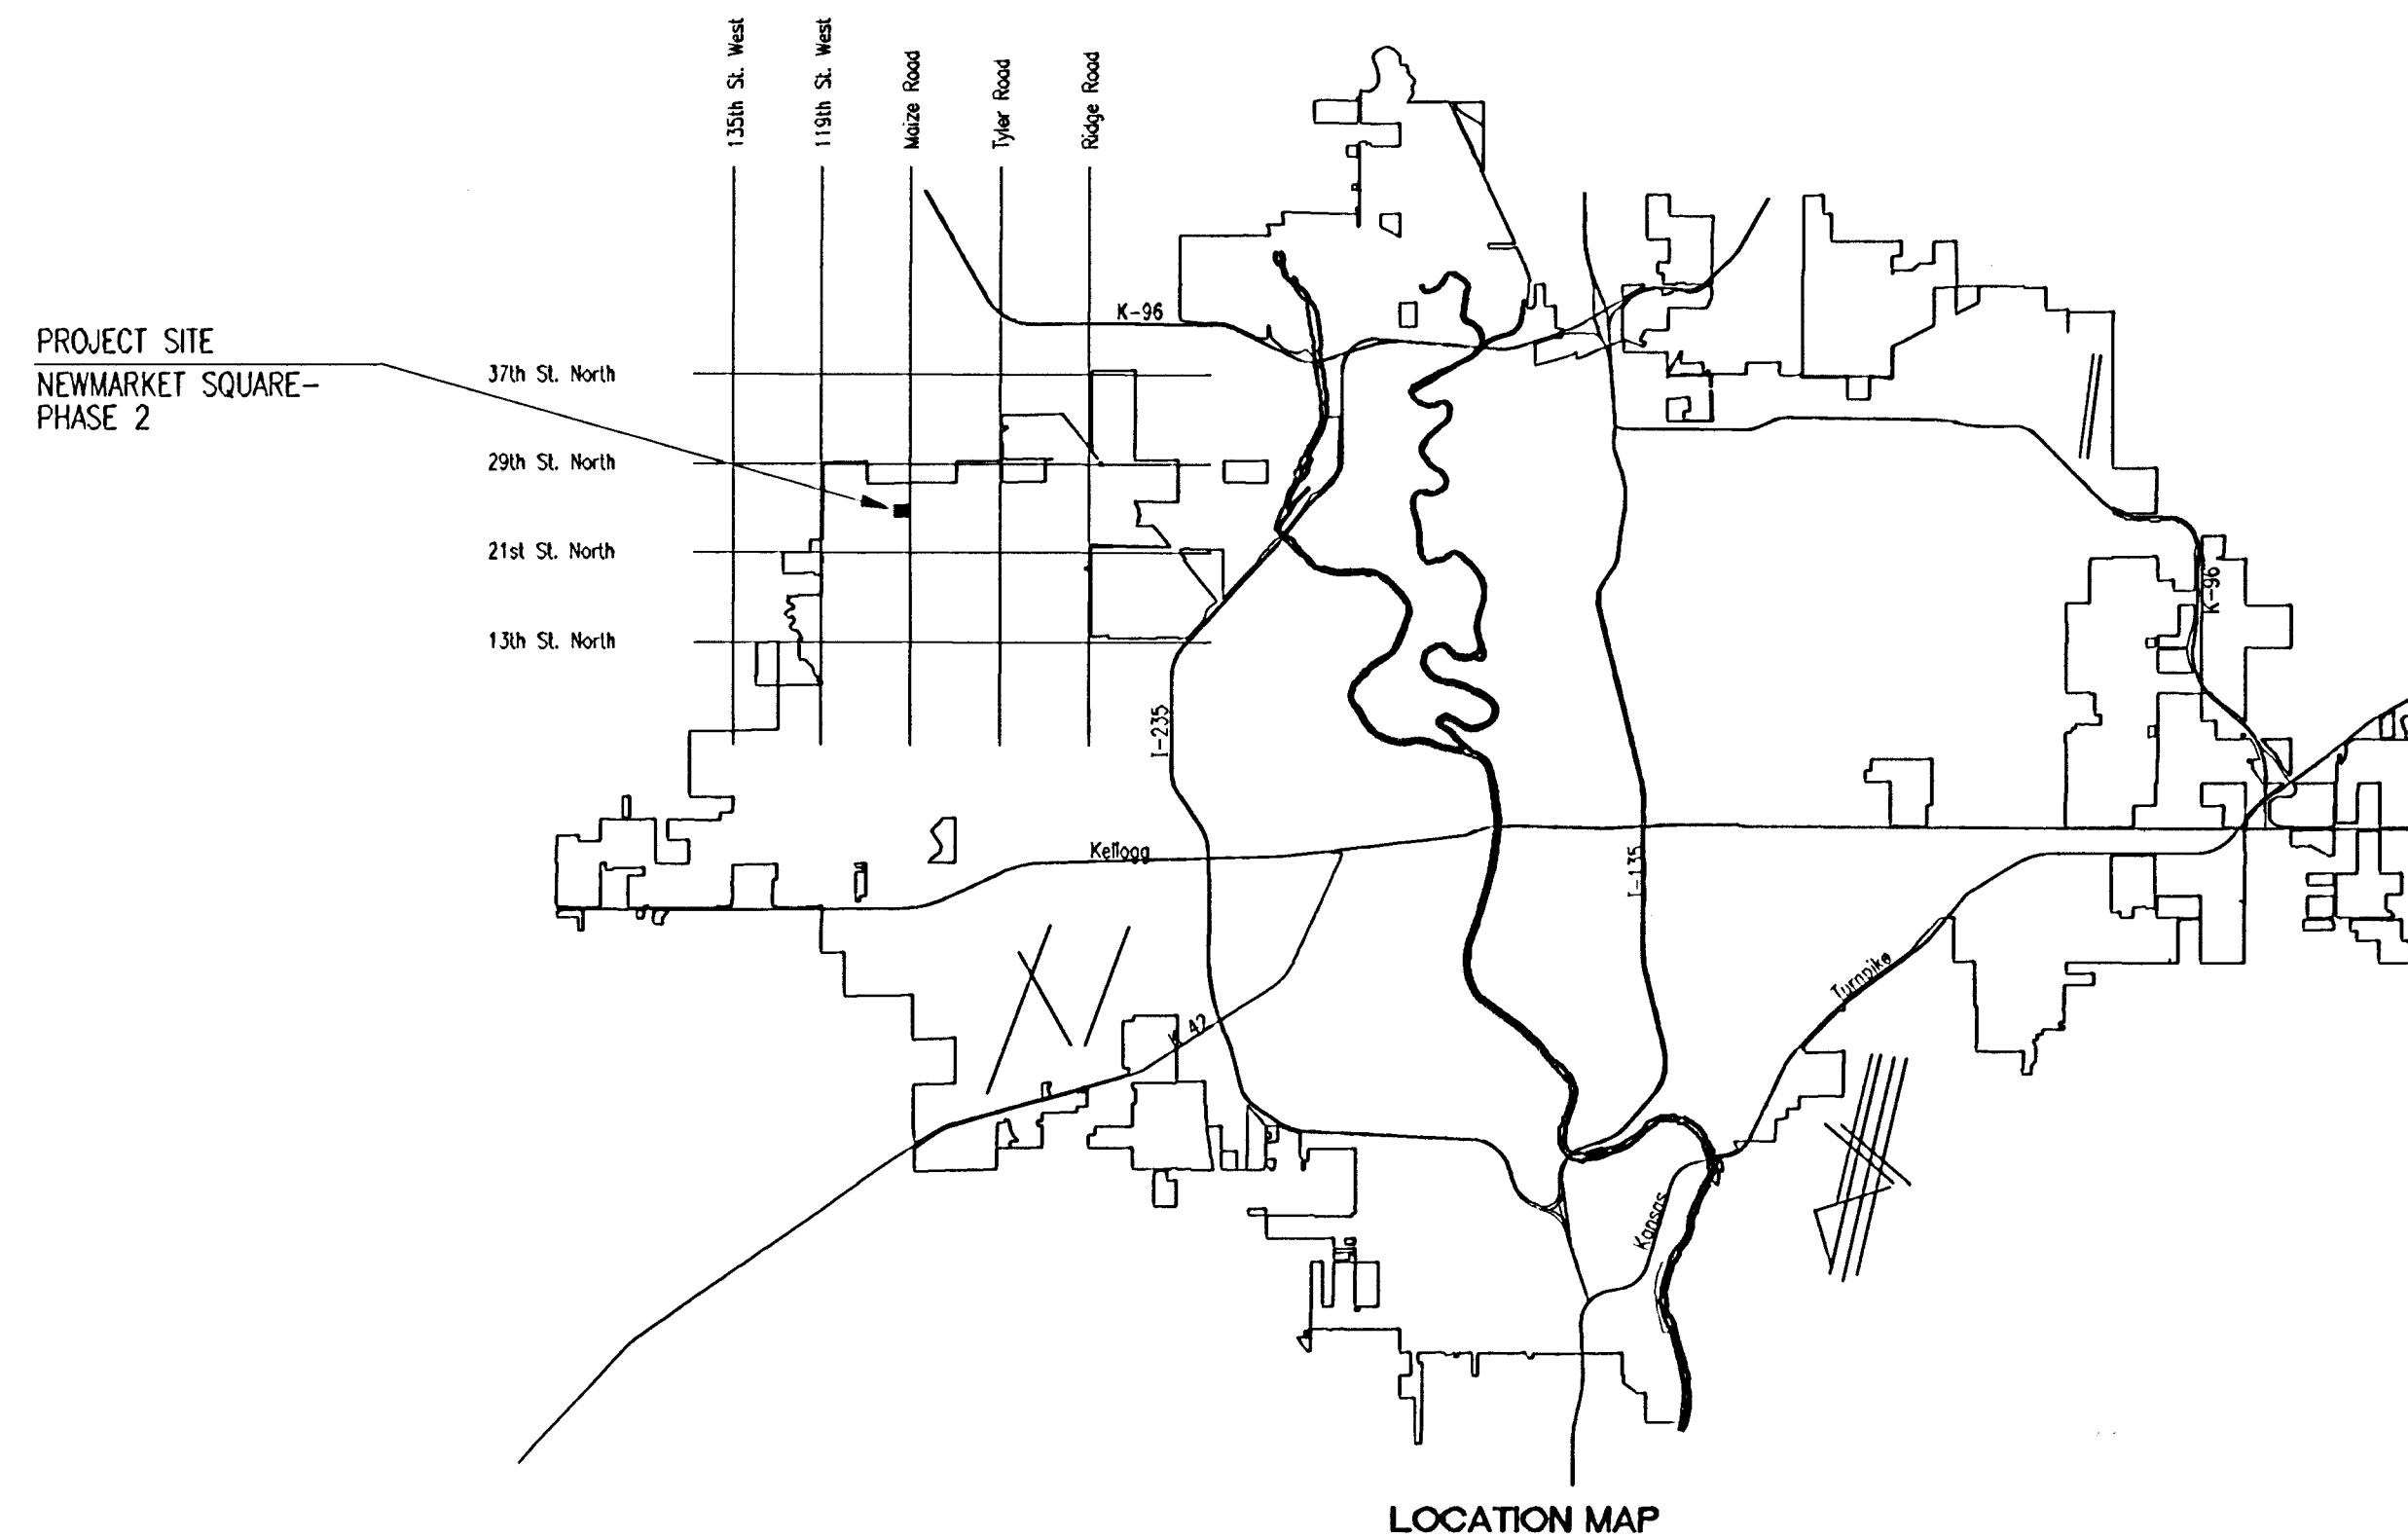


LATERAL 1, MAIN 6 OF THE NORTHWEST INTERCEPTOR SEWER IN THE CITY OF WICHITA

OCA NO. 744110

CITY OF WICHITA PROJECT NO. 468-83969

JAMES L. ARMOUR, P.E. - ACTING CITY ENGINEER

*Nowak Construction Co, Inc. Contractor**Shearer, City Inspector**Released 7/8/05**Per Revised Plans**Stubs**.pdf by JDL 8/29/05*

LOCATION MAP

INDEX OF SHEETS

SHEET NO. 1	TITLE SHEET
SHEET NO. 2	KEY MAP AND GENERAL NOTES
SHEET NO. 3-5	PLAT
SHEET NO. 6-10	PLAN/PROFILE
SHEET NO. 11	TYPE "P" MANHOLE DETAILS
SHEET NO. 12	CLEANOUT RISER ASSEMBLY DETAIL
SHEET NO. 13	FRAME & COVER DETAILS
SHEET NO. 14	RISER DETAILS
SHEET NO. 15-18	SOIL EROSION BMP DETAILS

CONSTRUCTION SCHEDULE/SEQUENCE

THE CONTRACTOR FOR EACH OF THE FOLLOWING NEWMARKET SQUARE - PHASE 2 PROJECTS SHALL COORDINATE THEIR EFFORTS WITH OTHER CONTRACTORS PERFORMING WORK IN THIS AREA SUCH THAT ANY NECESSARY SIMULTANEOUS CONSTRUCTION CAN PROCEED CONCURRENTLY WITHOUT CAUSING UNDUE DELAYS SO THAT CONSTRUCTION CAN BE COMPLETED WITHIN THE TIME FRAMES AS NOTED.

SANITARY SEWER (468-83969)

THE CONTRACTOR SHALL SEQUENCE HIS WORK TO COMPLETE ALL WORK, INCLUDING TESTING AND ACCEPTANCE, BY JUNE 1, 2005.

WATER DISTRIBUTION SYSTEM (448-90058)

THE CONTRACTOR SHALL COMPLETE NEWMARKET SQUARE - PHASE 2 WATERLINE CONSTRUCTION BY JULY 1, 2005. THE CONTRACTOR SHALL COORDINATE INSTALLATION OF WATERLINES WITH THE STORM WATER DRAIN AND PAVING CONTRACTOR SO THAT STORM SEWERS CROSSING BELOW PROPOSED WATERLINES WILL BE INSTALLED PRIOR TO WATERLINE CONSTRUCTION.

MARCH 2005

PLANS PREPARED BY
PROFESSIONAL ENGINEERING CONSULTANTS, P.A.
ENGINEERS
WICHITA, KANSAS

