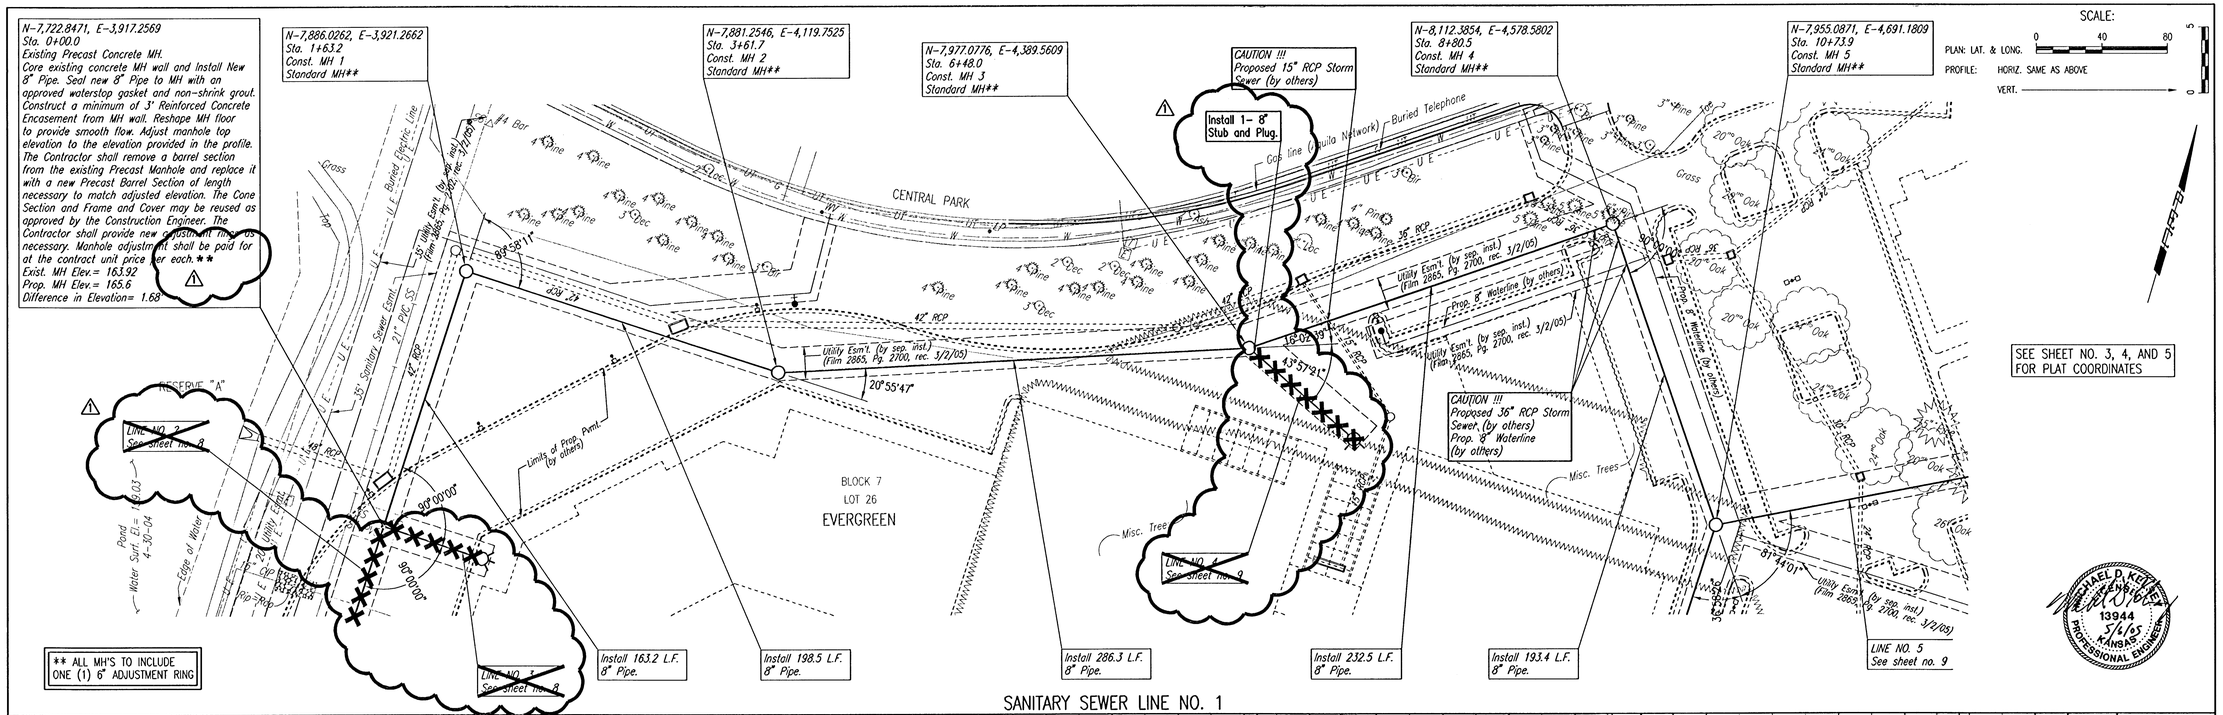

SANITARY SEWER LINE NO. 1

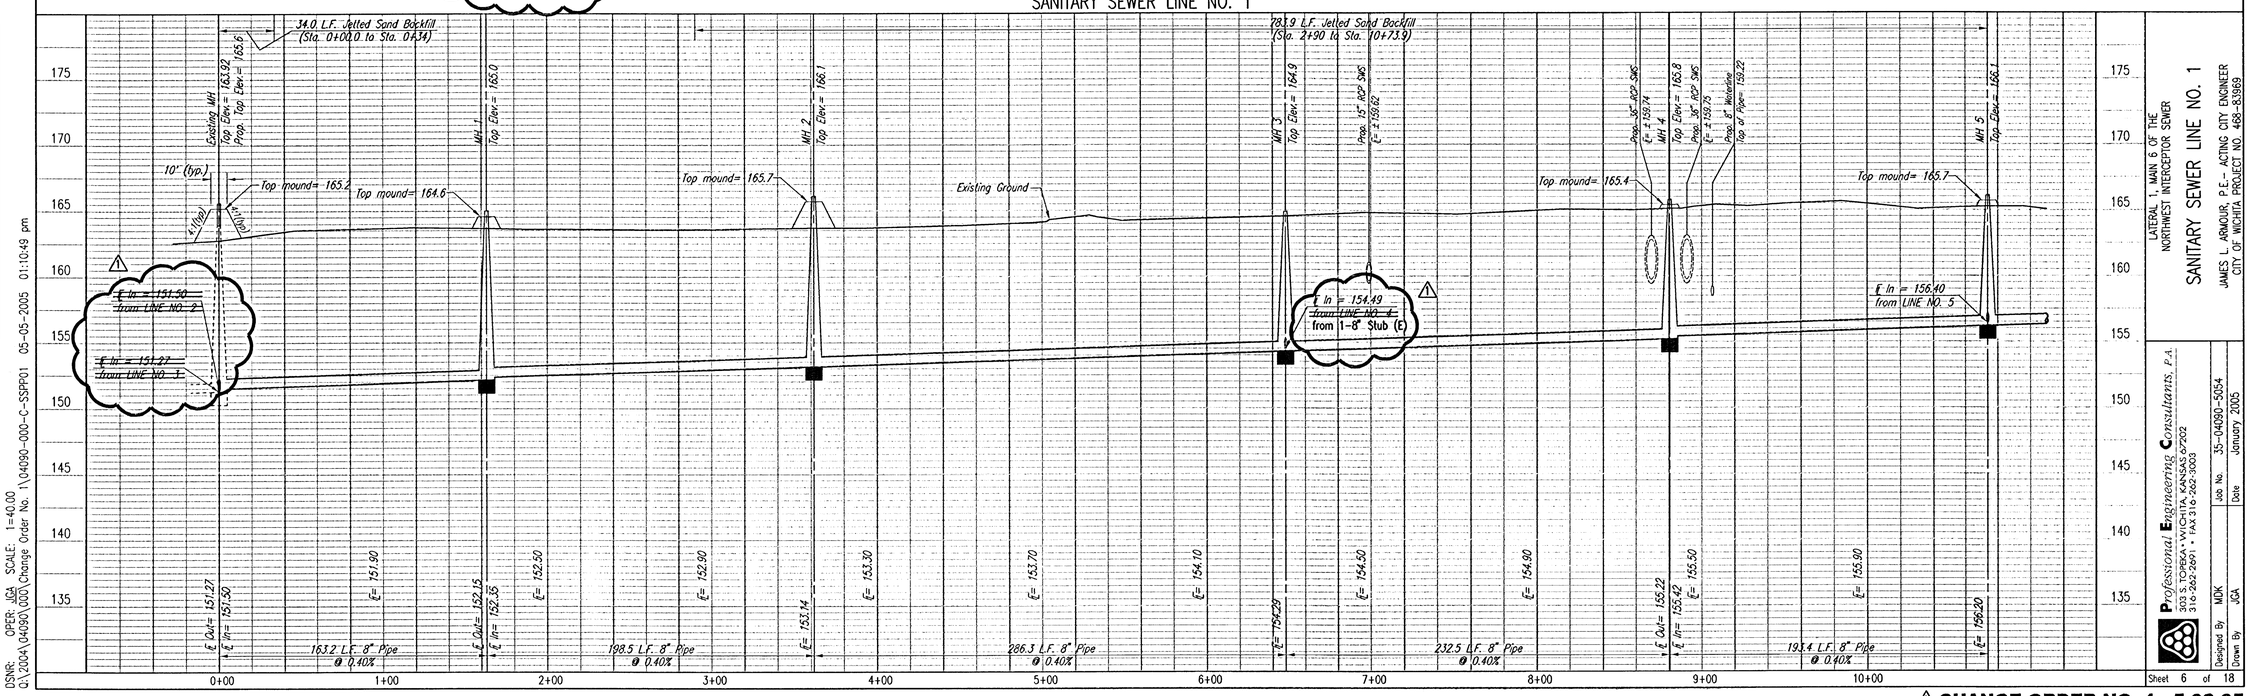

LATERAL 1, MAIN 6 OF THE NORTHWEST INTERCEPTOR SEWER

SANITARY SEWER LINE NO. 1

JAMES L. ARMOUR, P.E. – ACTING CITY ENGINEER
CITY OF WICHITA PROJECT NO. 468-83969

Professional Engineering Consultants, P.A.
303 S. TOPEKA • WICHITA, KANSAS 67202
316-262-2691 • FAX 316-262-3003

Designed By	WDK	Job No.	35-04090-5054
Drawn By	JGA	Date	January 2005

Sheet 6 of 18

PLAN		BY	DATE
	CHECKED		
	CHECKED		

PROFILE		BY	DATE
	CHECKED		
	CHECKED		

DSN/R: OPER: JGA SCALE: 1=40.00
Q:\2004\04090\000\Change Order No. 1\04090-000-C-SSPP01 05-05-2005 01:10:49 pm

⚠ CHANGE ORDER NO. 1 5-02-05