
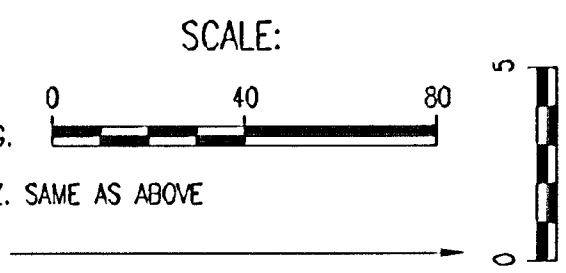




PLAN	CHECKED	DATE

PROFILE	CHECKED	DATE

DSNR: OPER. JGA SCALE: 1"=40.00
 Q:\2004\04090\000\Change Order No. 1\04090-000-C-SSPP02 05-05-2005 01:11:21 pm

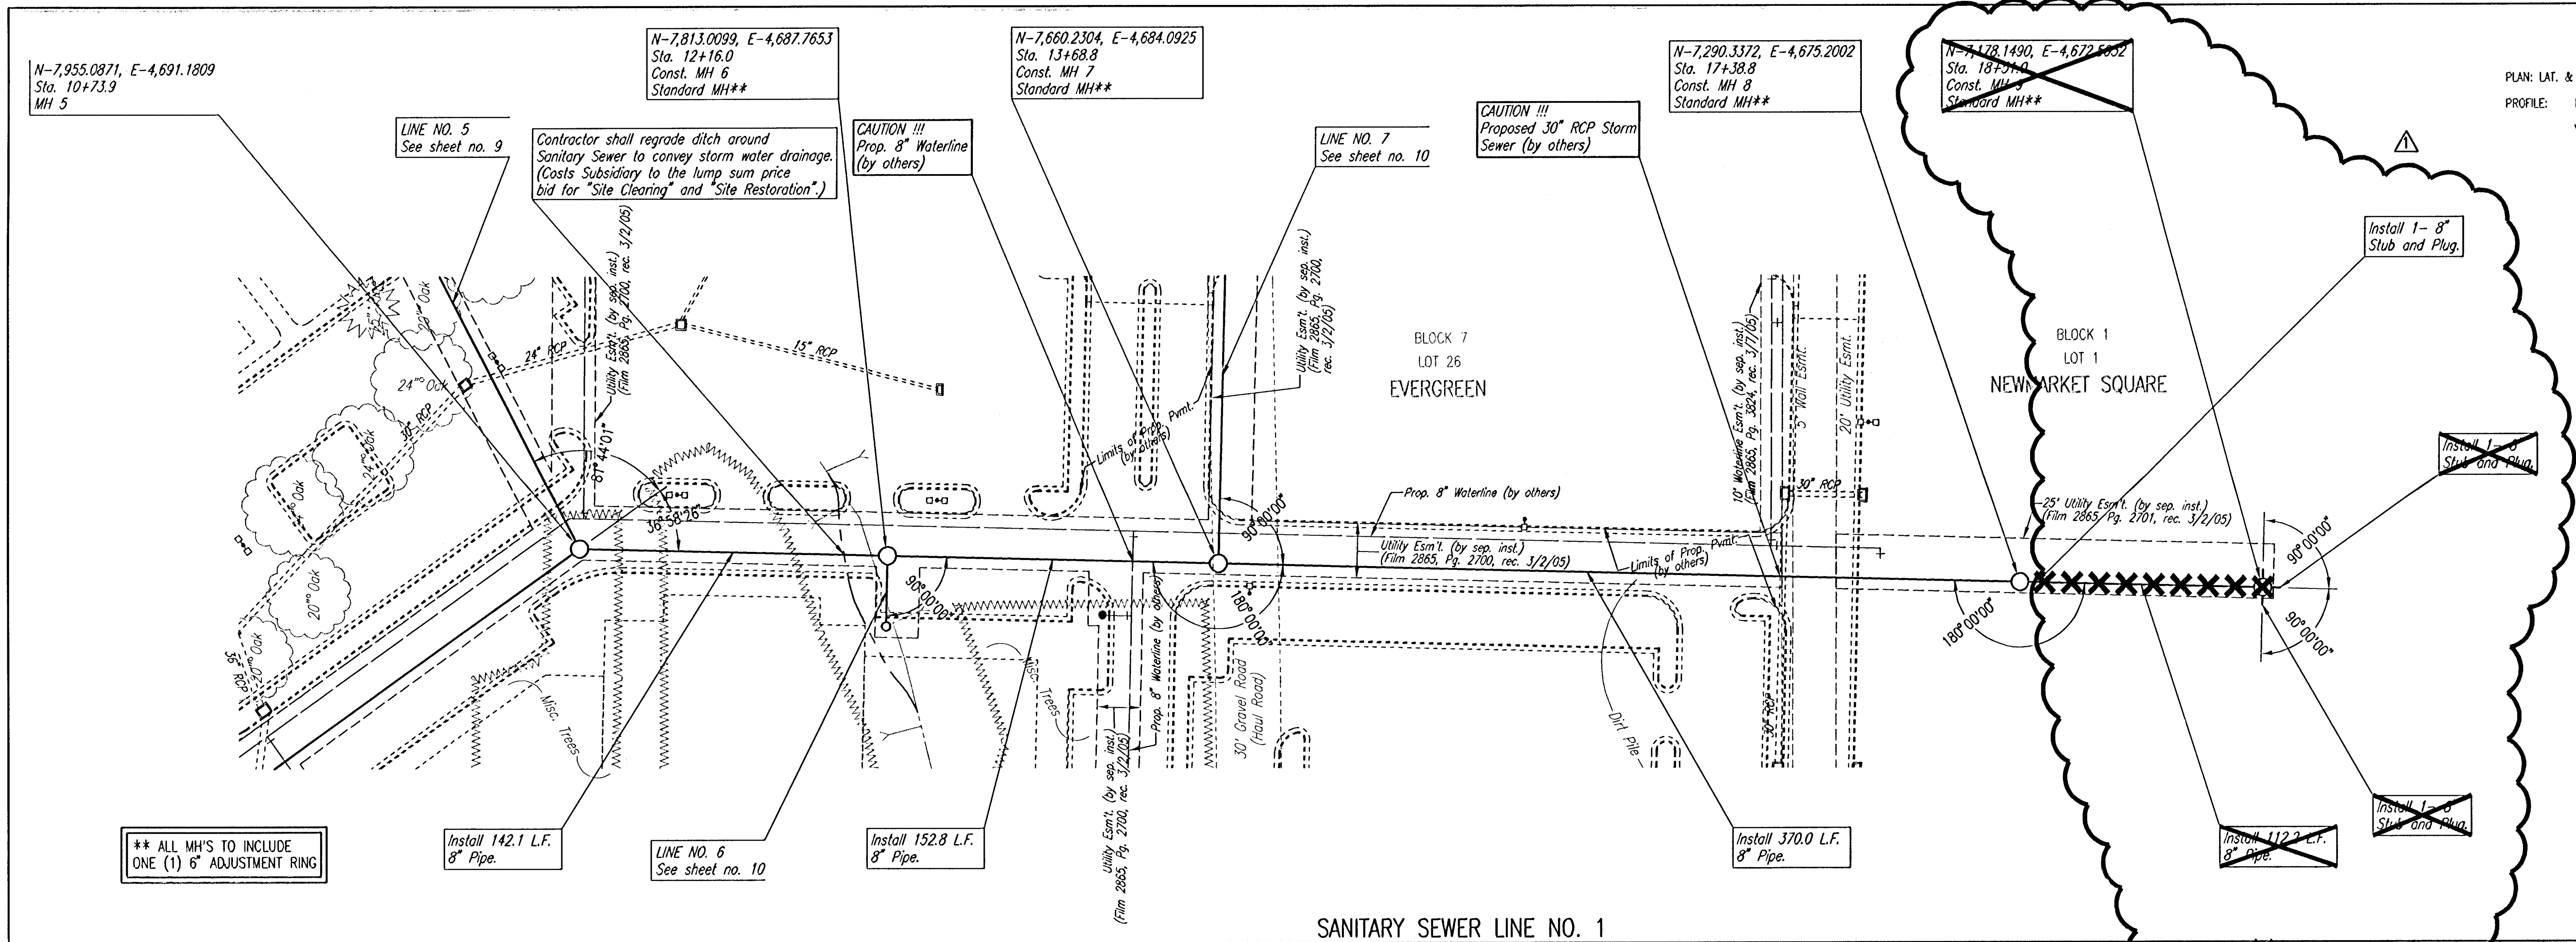

SEE SHEET NO. 3, 4, AND 5 FOR PLAT COORDINATES

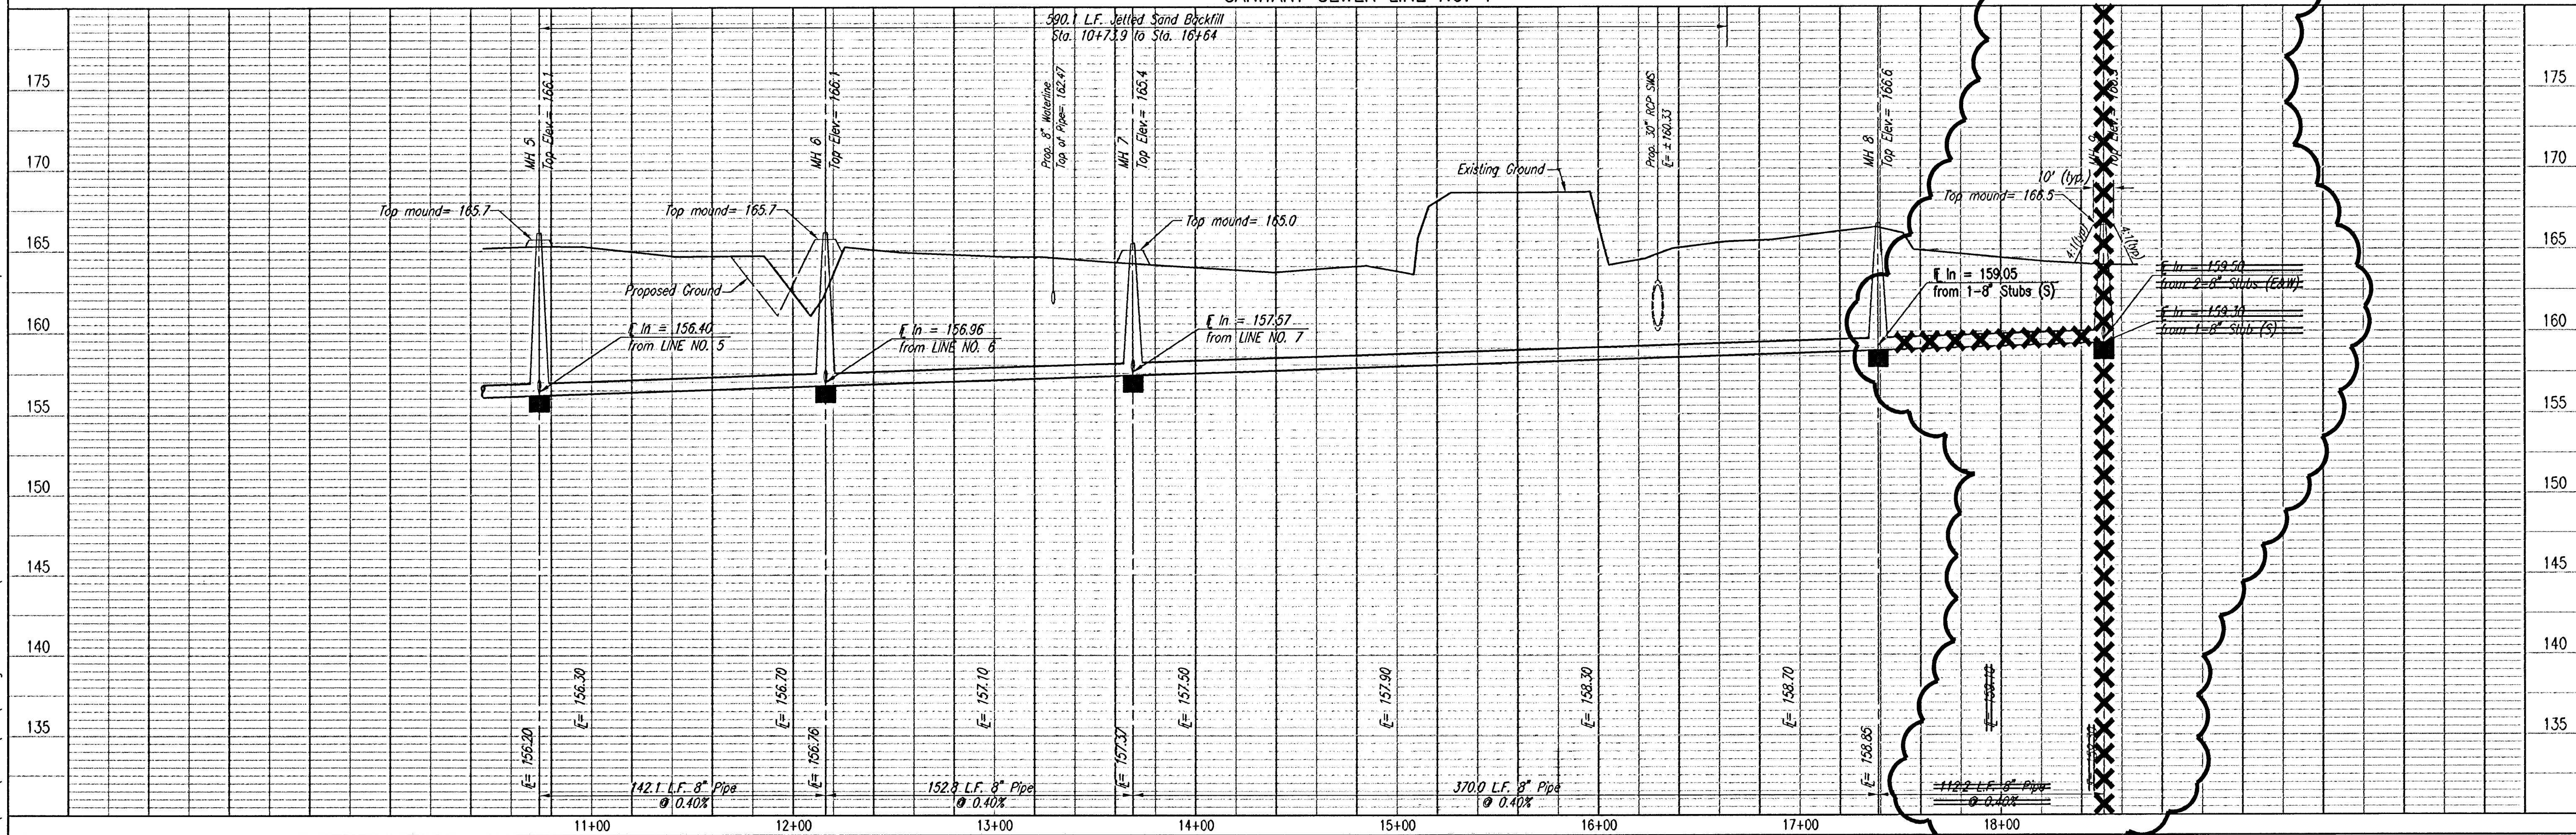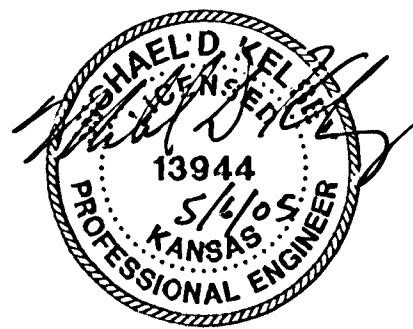

Professional Engineering Consultants, P.A.
 303 S. TOPICKA • WICHITA, KANSAS 67202
 316-262-2691 • FAX 316-262-3003

LATERAL 1, MAIN 6 OF THE NORTHWEST INTERCEPTOR SEWER

SANITARY SEWER LINE NO. 1

JAMES L. ARMOUR, P.E. - ACTING CITY ENGINEER
 CITY OF WICHITA PROJECT NO. 488-83669

Job No. 35-04090-5054
 Date January 2005

Designed By MDK
 Drawn By JGA