
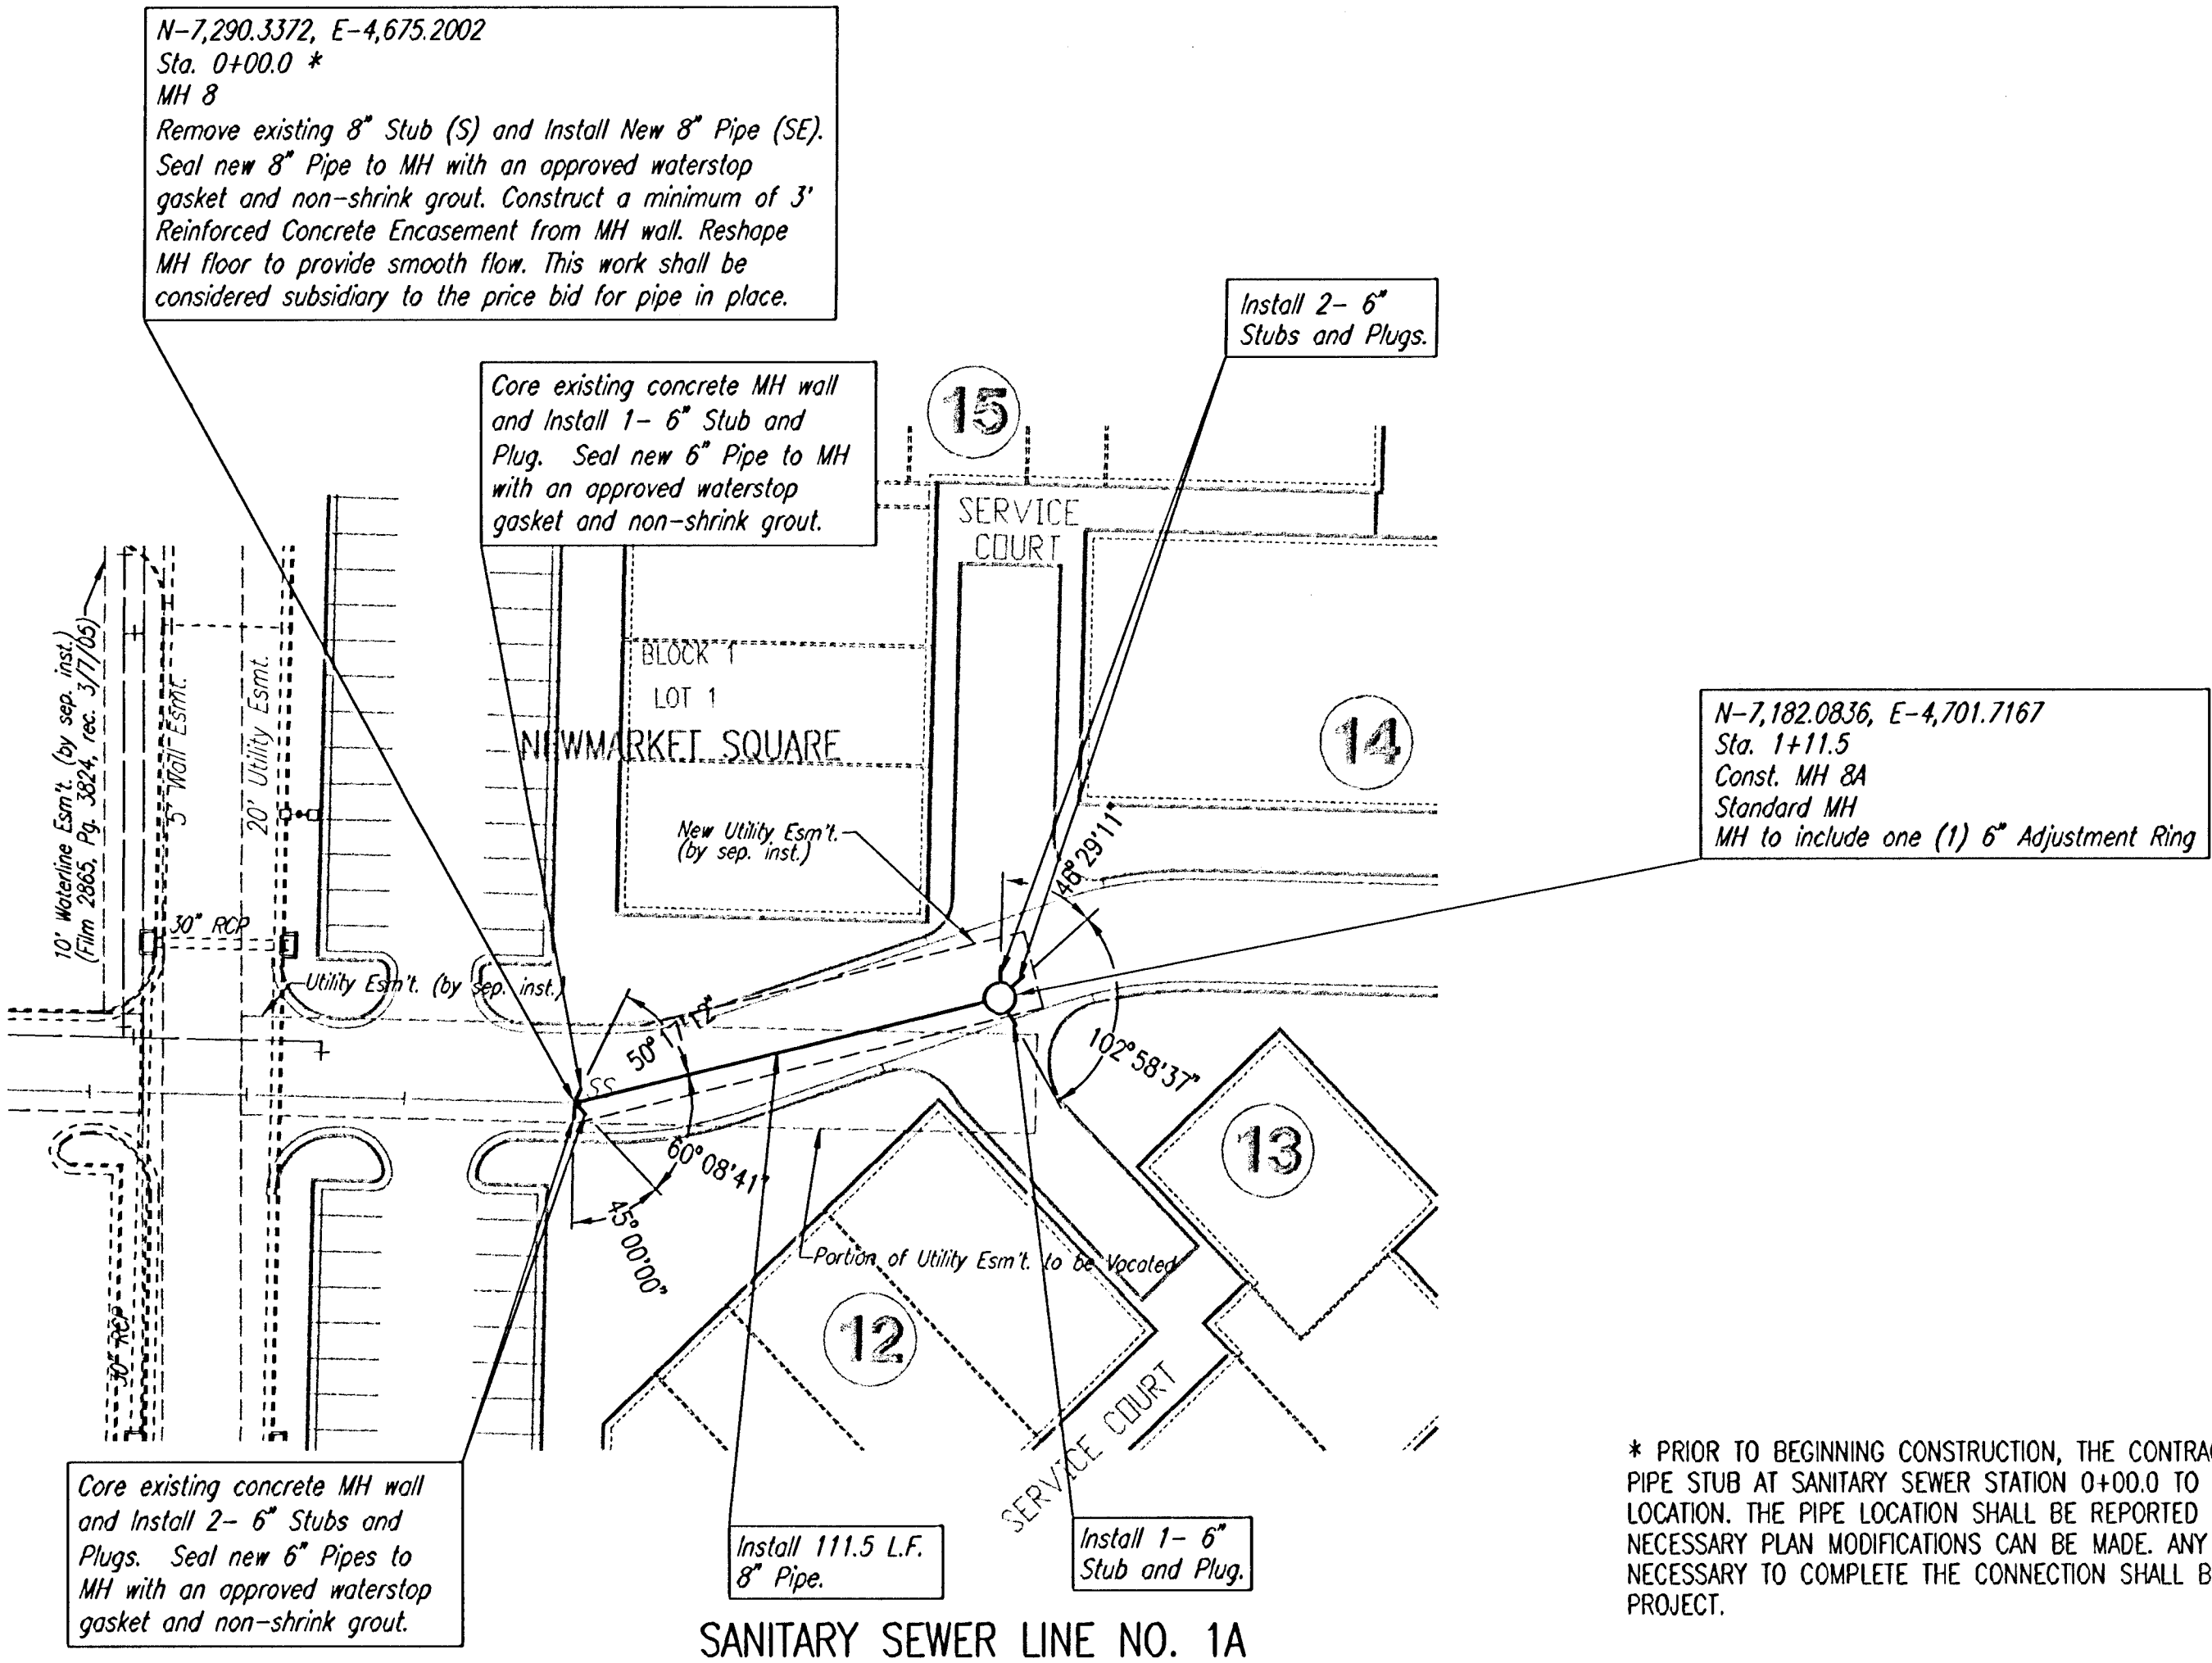



PLAN	CHECKED	DATE

PROFILE	CHECKED	DATE

DSNR MDK OPER: CSL SCALE: 1"=40.00
C:\2004\04090\000\Change Order No. 2\04090-000-C-SSPP02 06-15-2005 04:45:46 pm

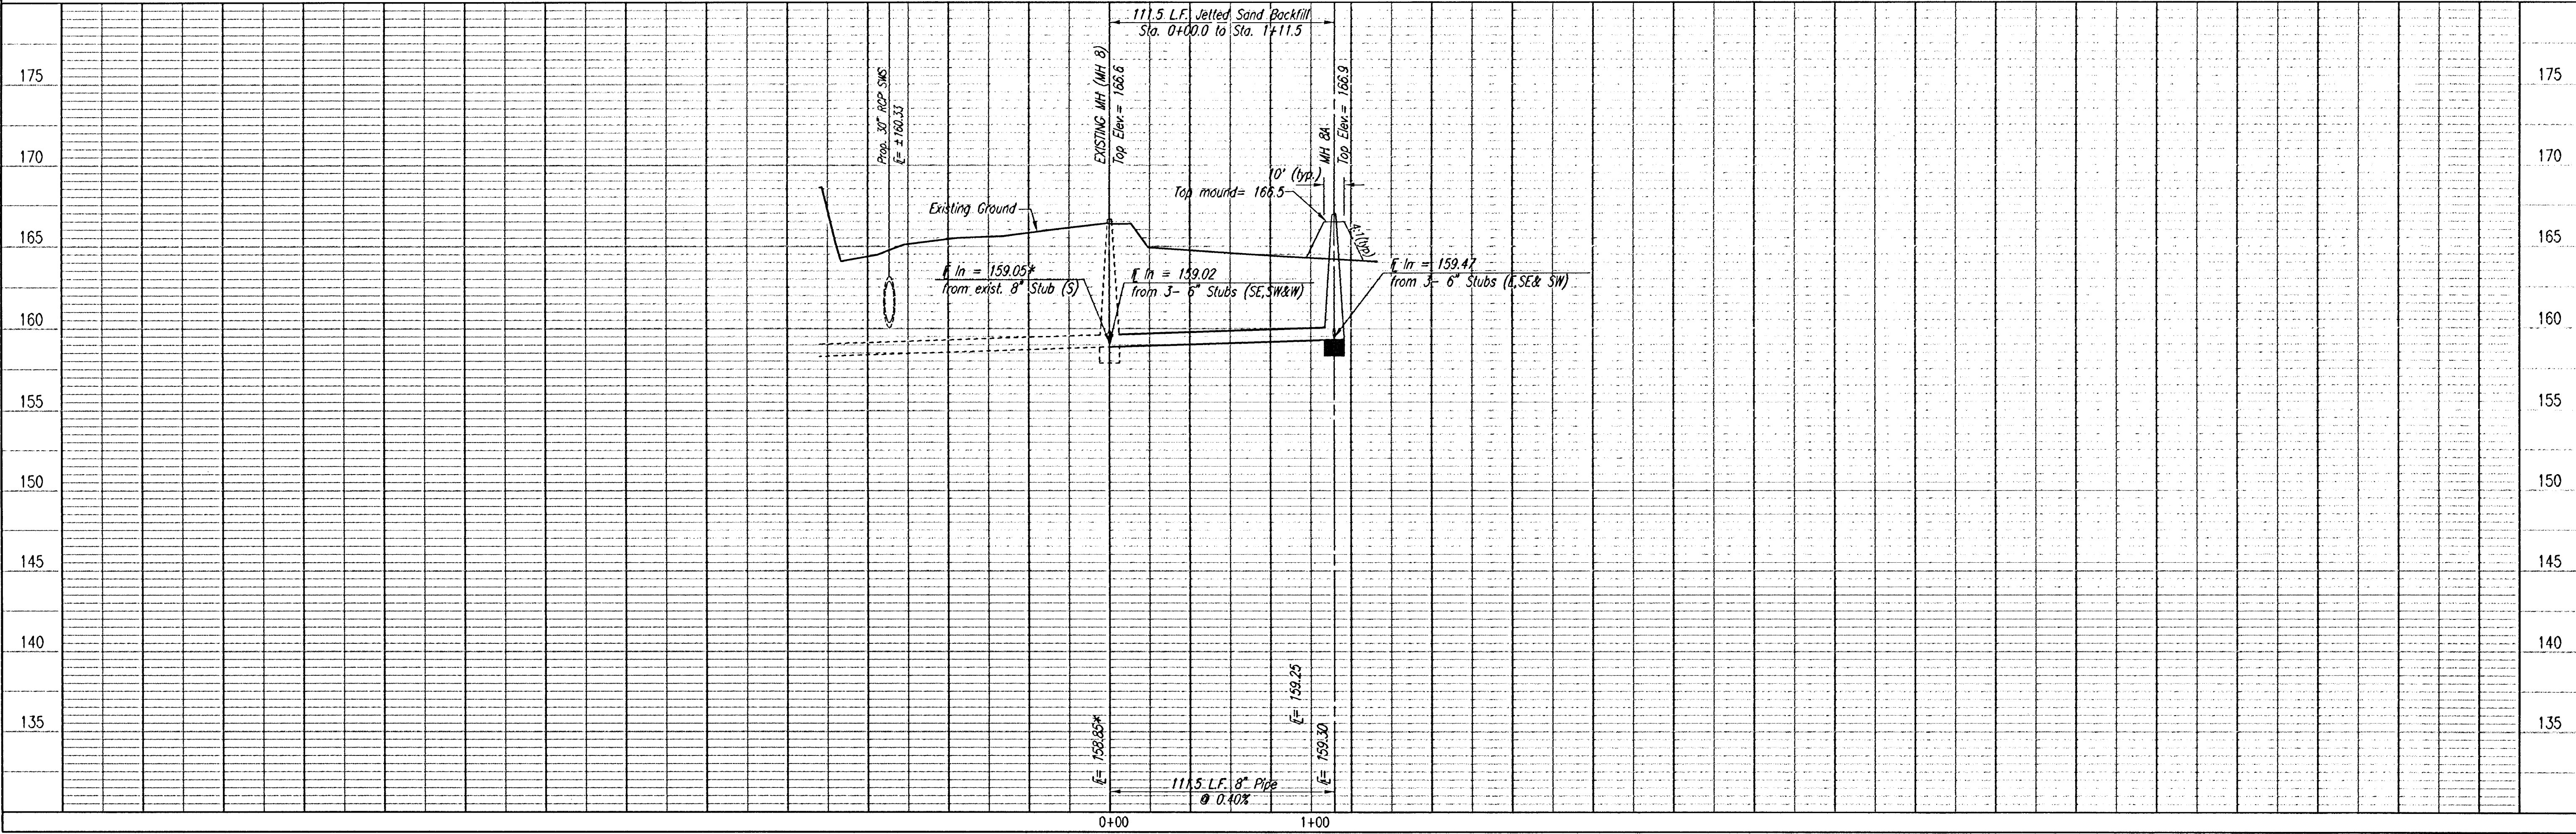

SCALE:
PLAN: LAT. & LONG. 0 40 80
PROFILE: HORIZ. SAME AS ABOVE
VERT. 0 5

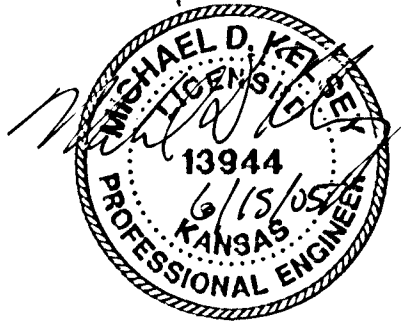

LATERAL 1, MAIN 6 OF THE
NORTHWEST INTERCEPTOR SEWER
SANITARY SEWER LINE NO. 1A
JAMES L. ARMOUR, P.E. - CITY ENGINEER
CITY OF WICHITA PROJECT NO. 468-83569

Professional Engineering Consultants, P.A.
303 S. TOPEKA • WICHITA, KANSAS 67202
316-262-2691 • FAX 316-262-3003
Designed By MDK
Drawn By JGA
Job No. 35-04090-5054
Date January 2005

No.	By	Date
1		

CHANGE ORDER #2- AND LINE NO. 1A
Reason