


PLAN	CHECKED	DATE




PROFILE	CHECKED	DATE

DSNR: OPER JCA SCALE: 1"=40.00
 C:\2004\04090-000\Change Order No. 1\04090-000-C-SSPP03 05-05-2005 01:11:57 pm

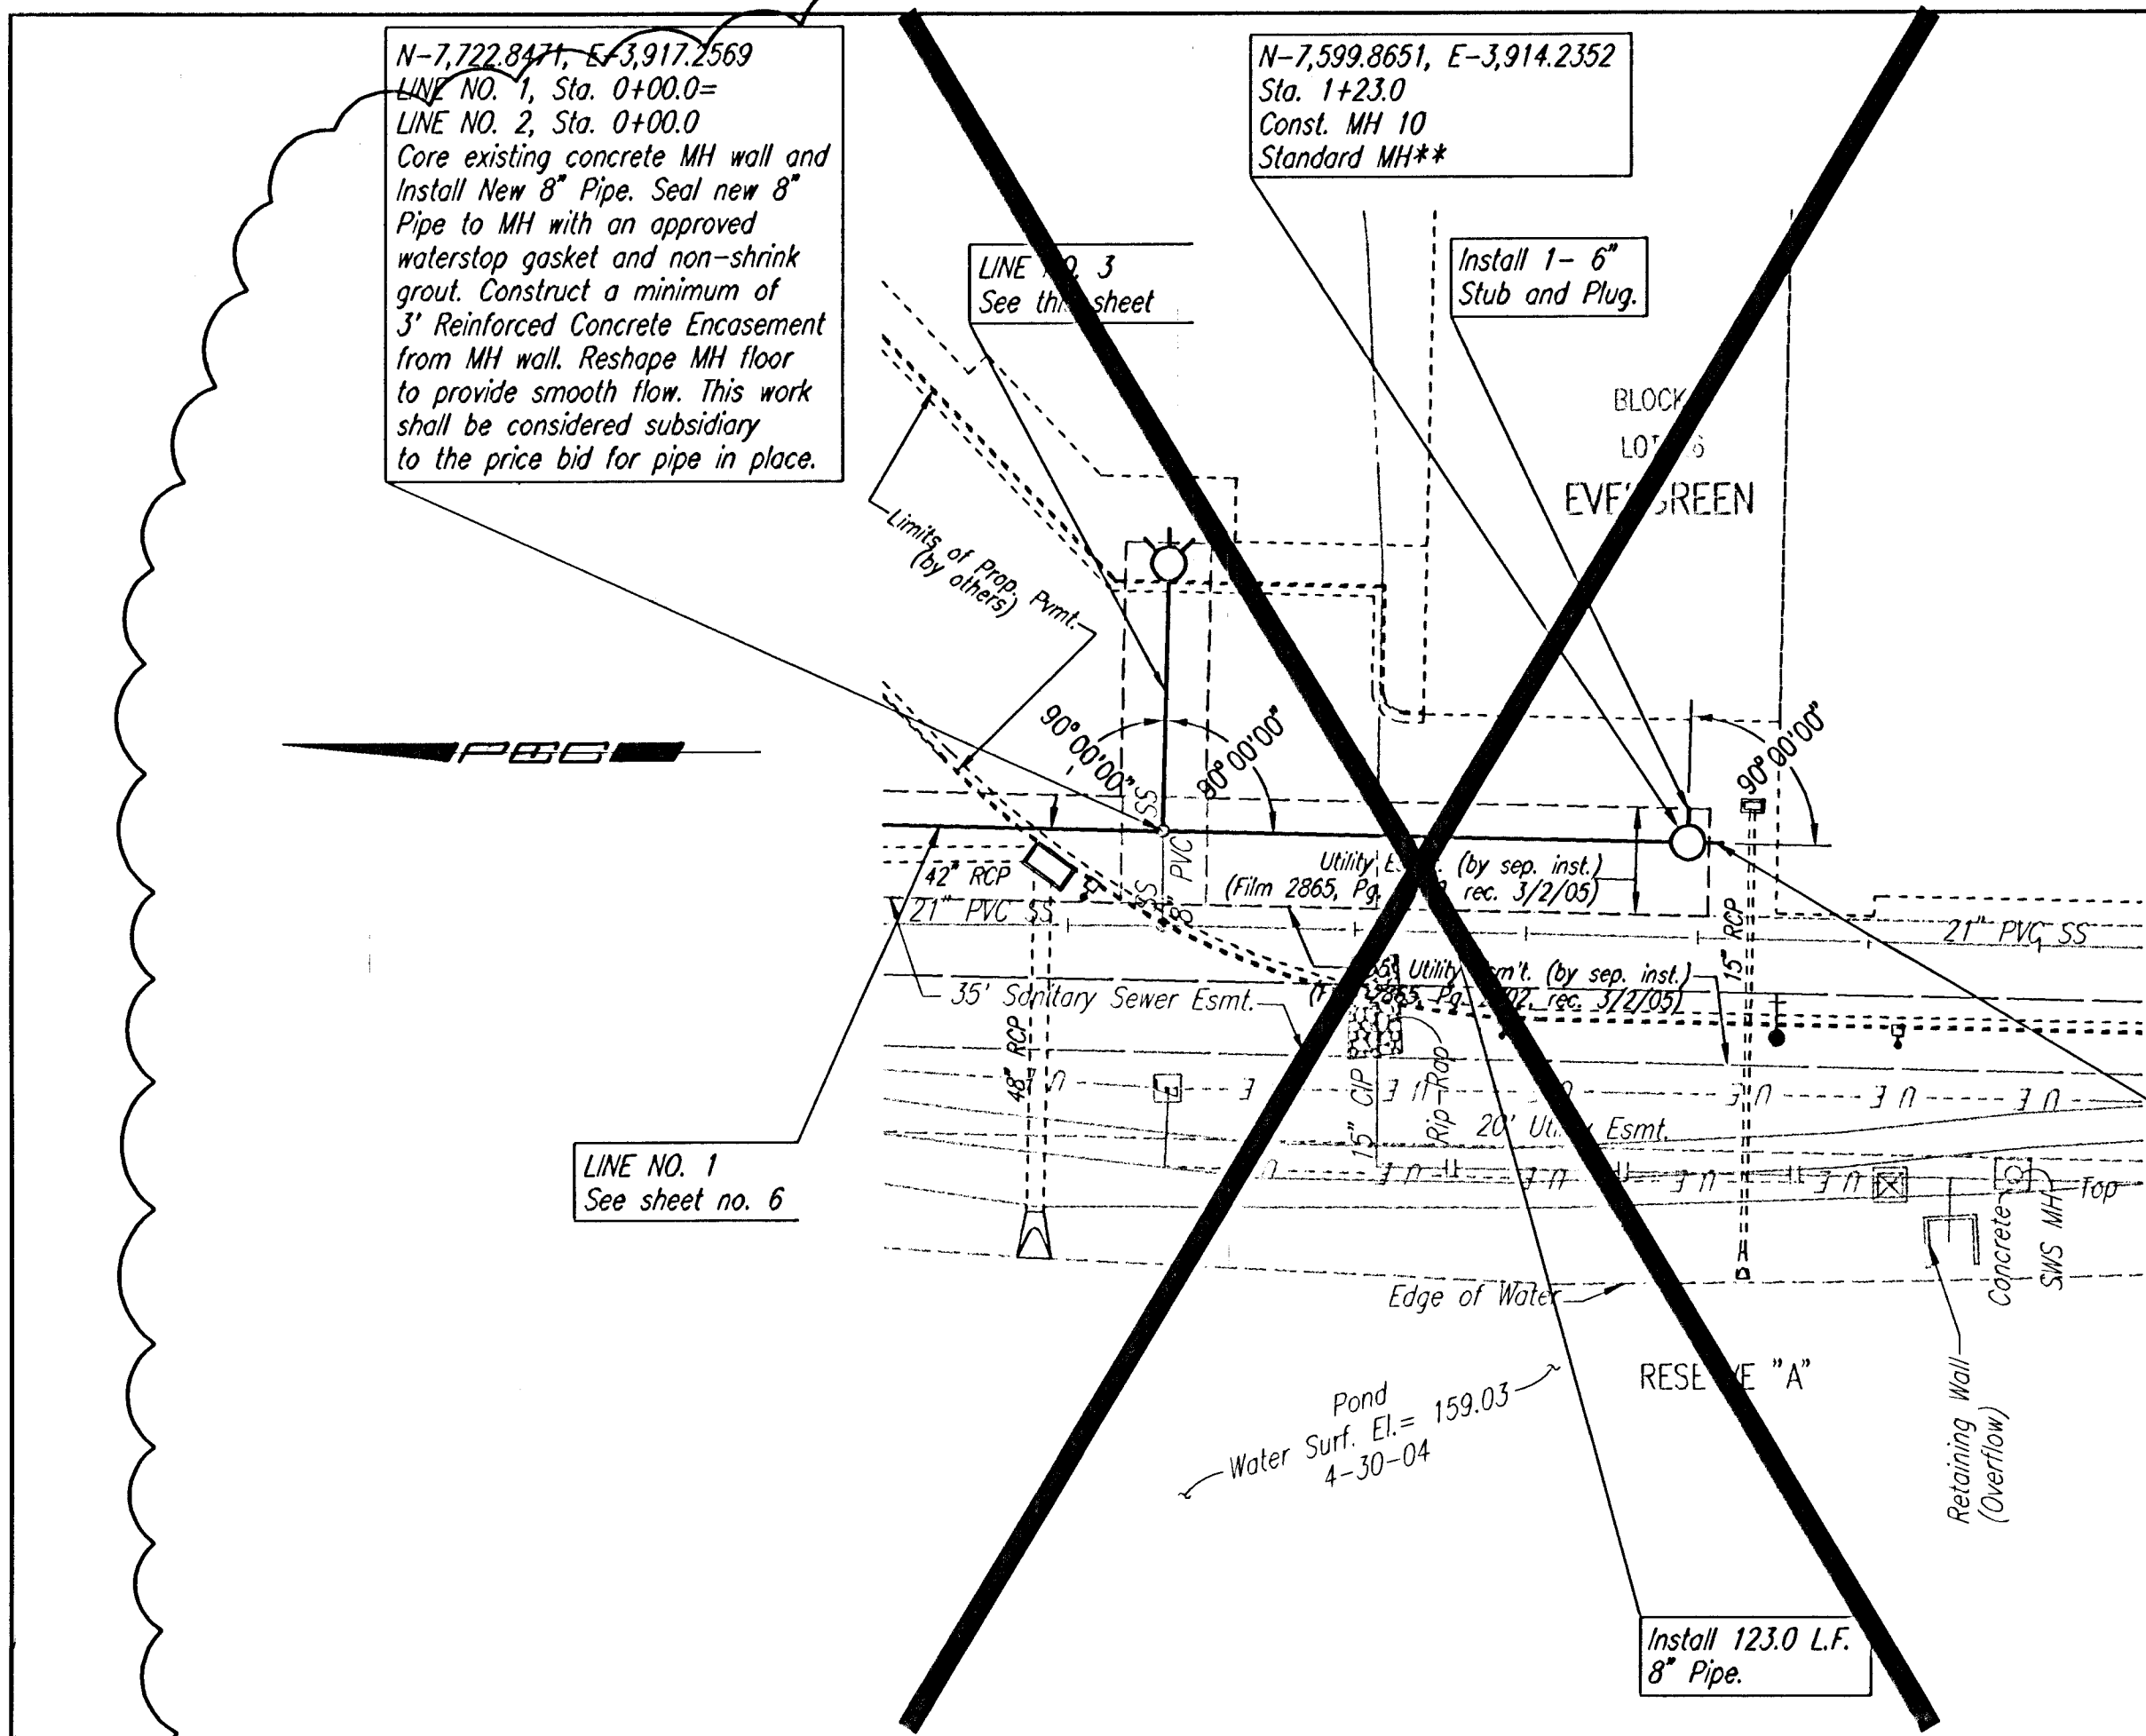


SEE SHEET NO. 3, 4, AND 5
FOR PLAT COORDINATES

** ALL MH'S TO INCLUDE
ONE (1) 6" ADJUSTMENT RING

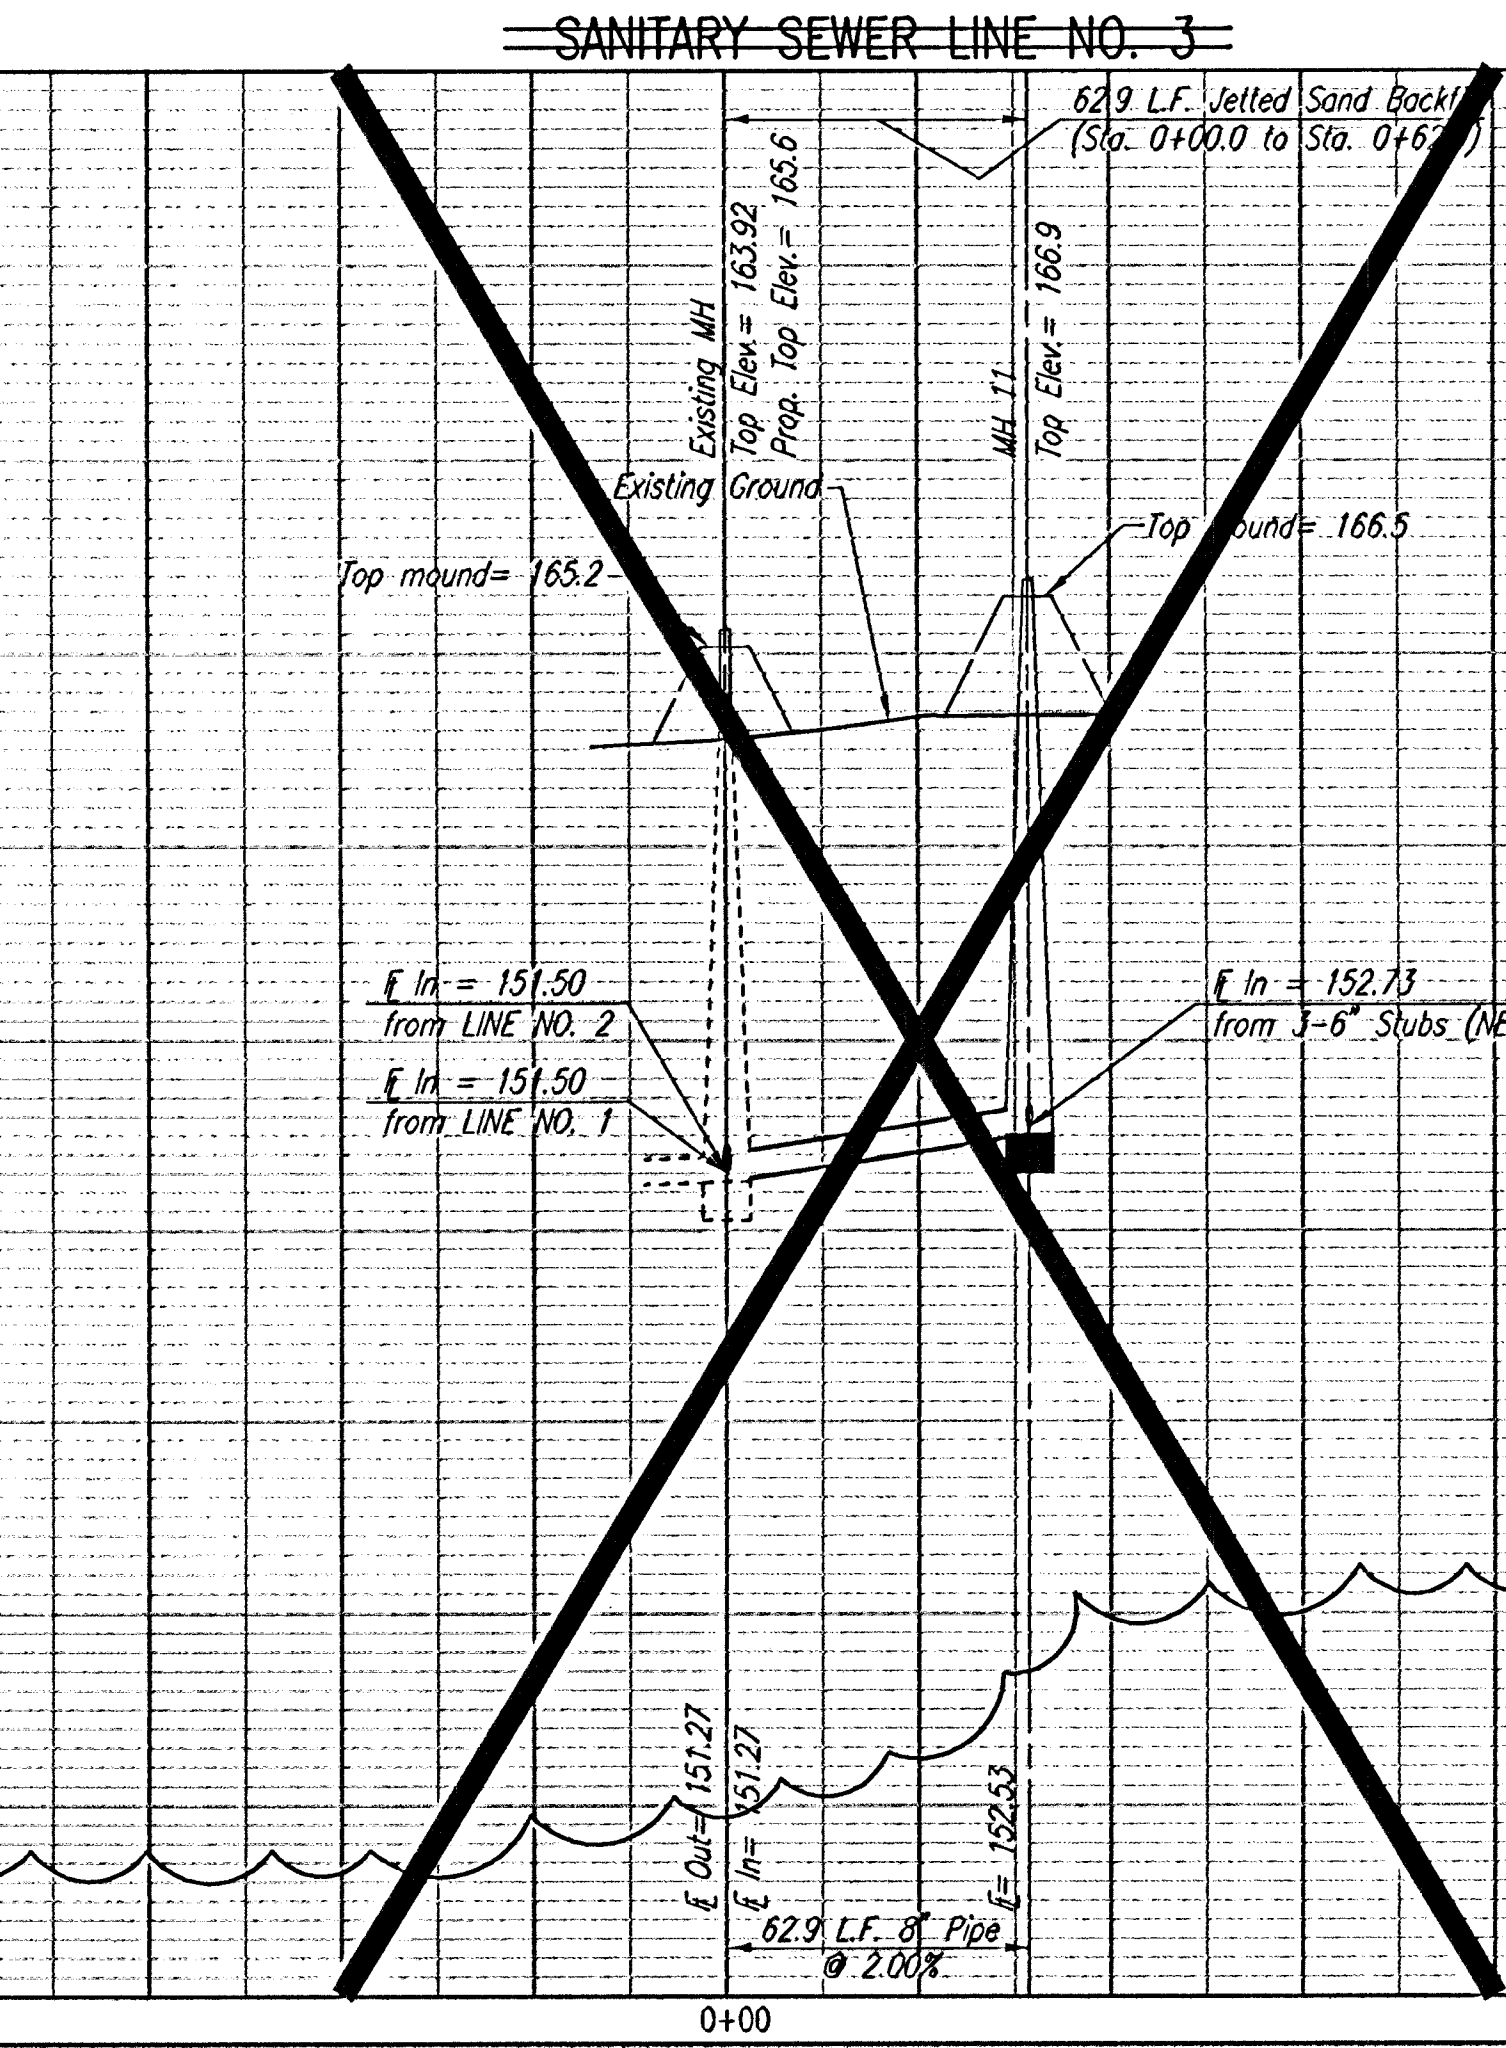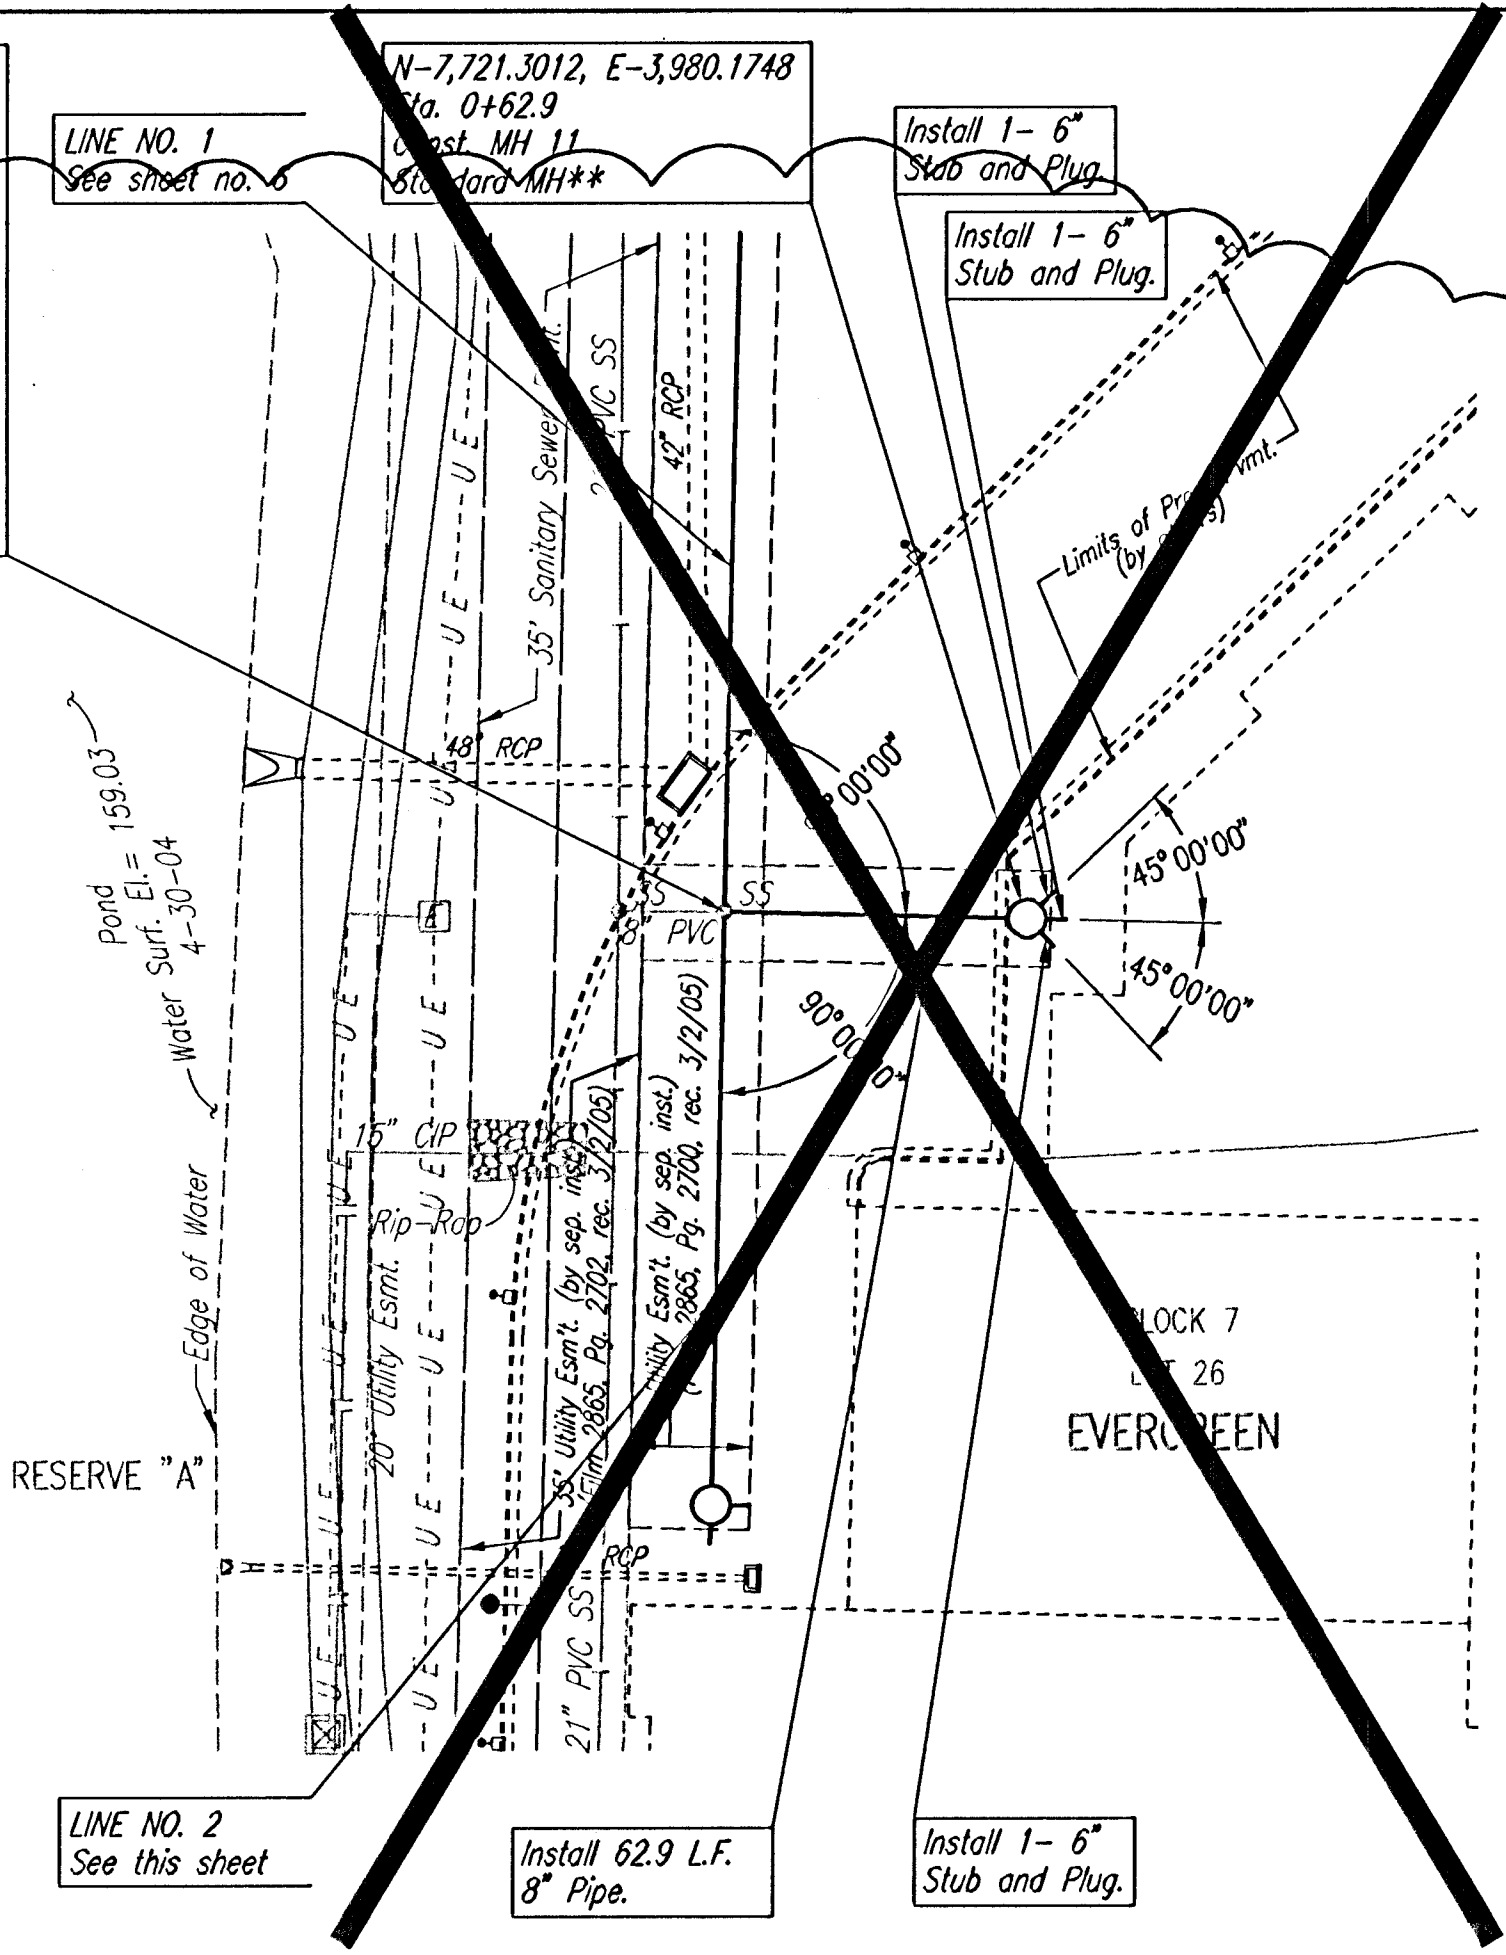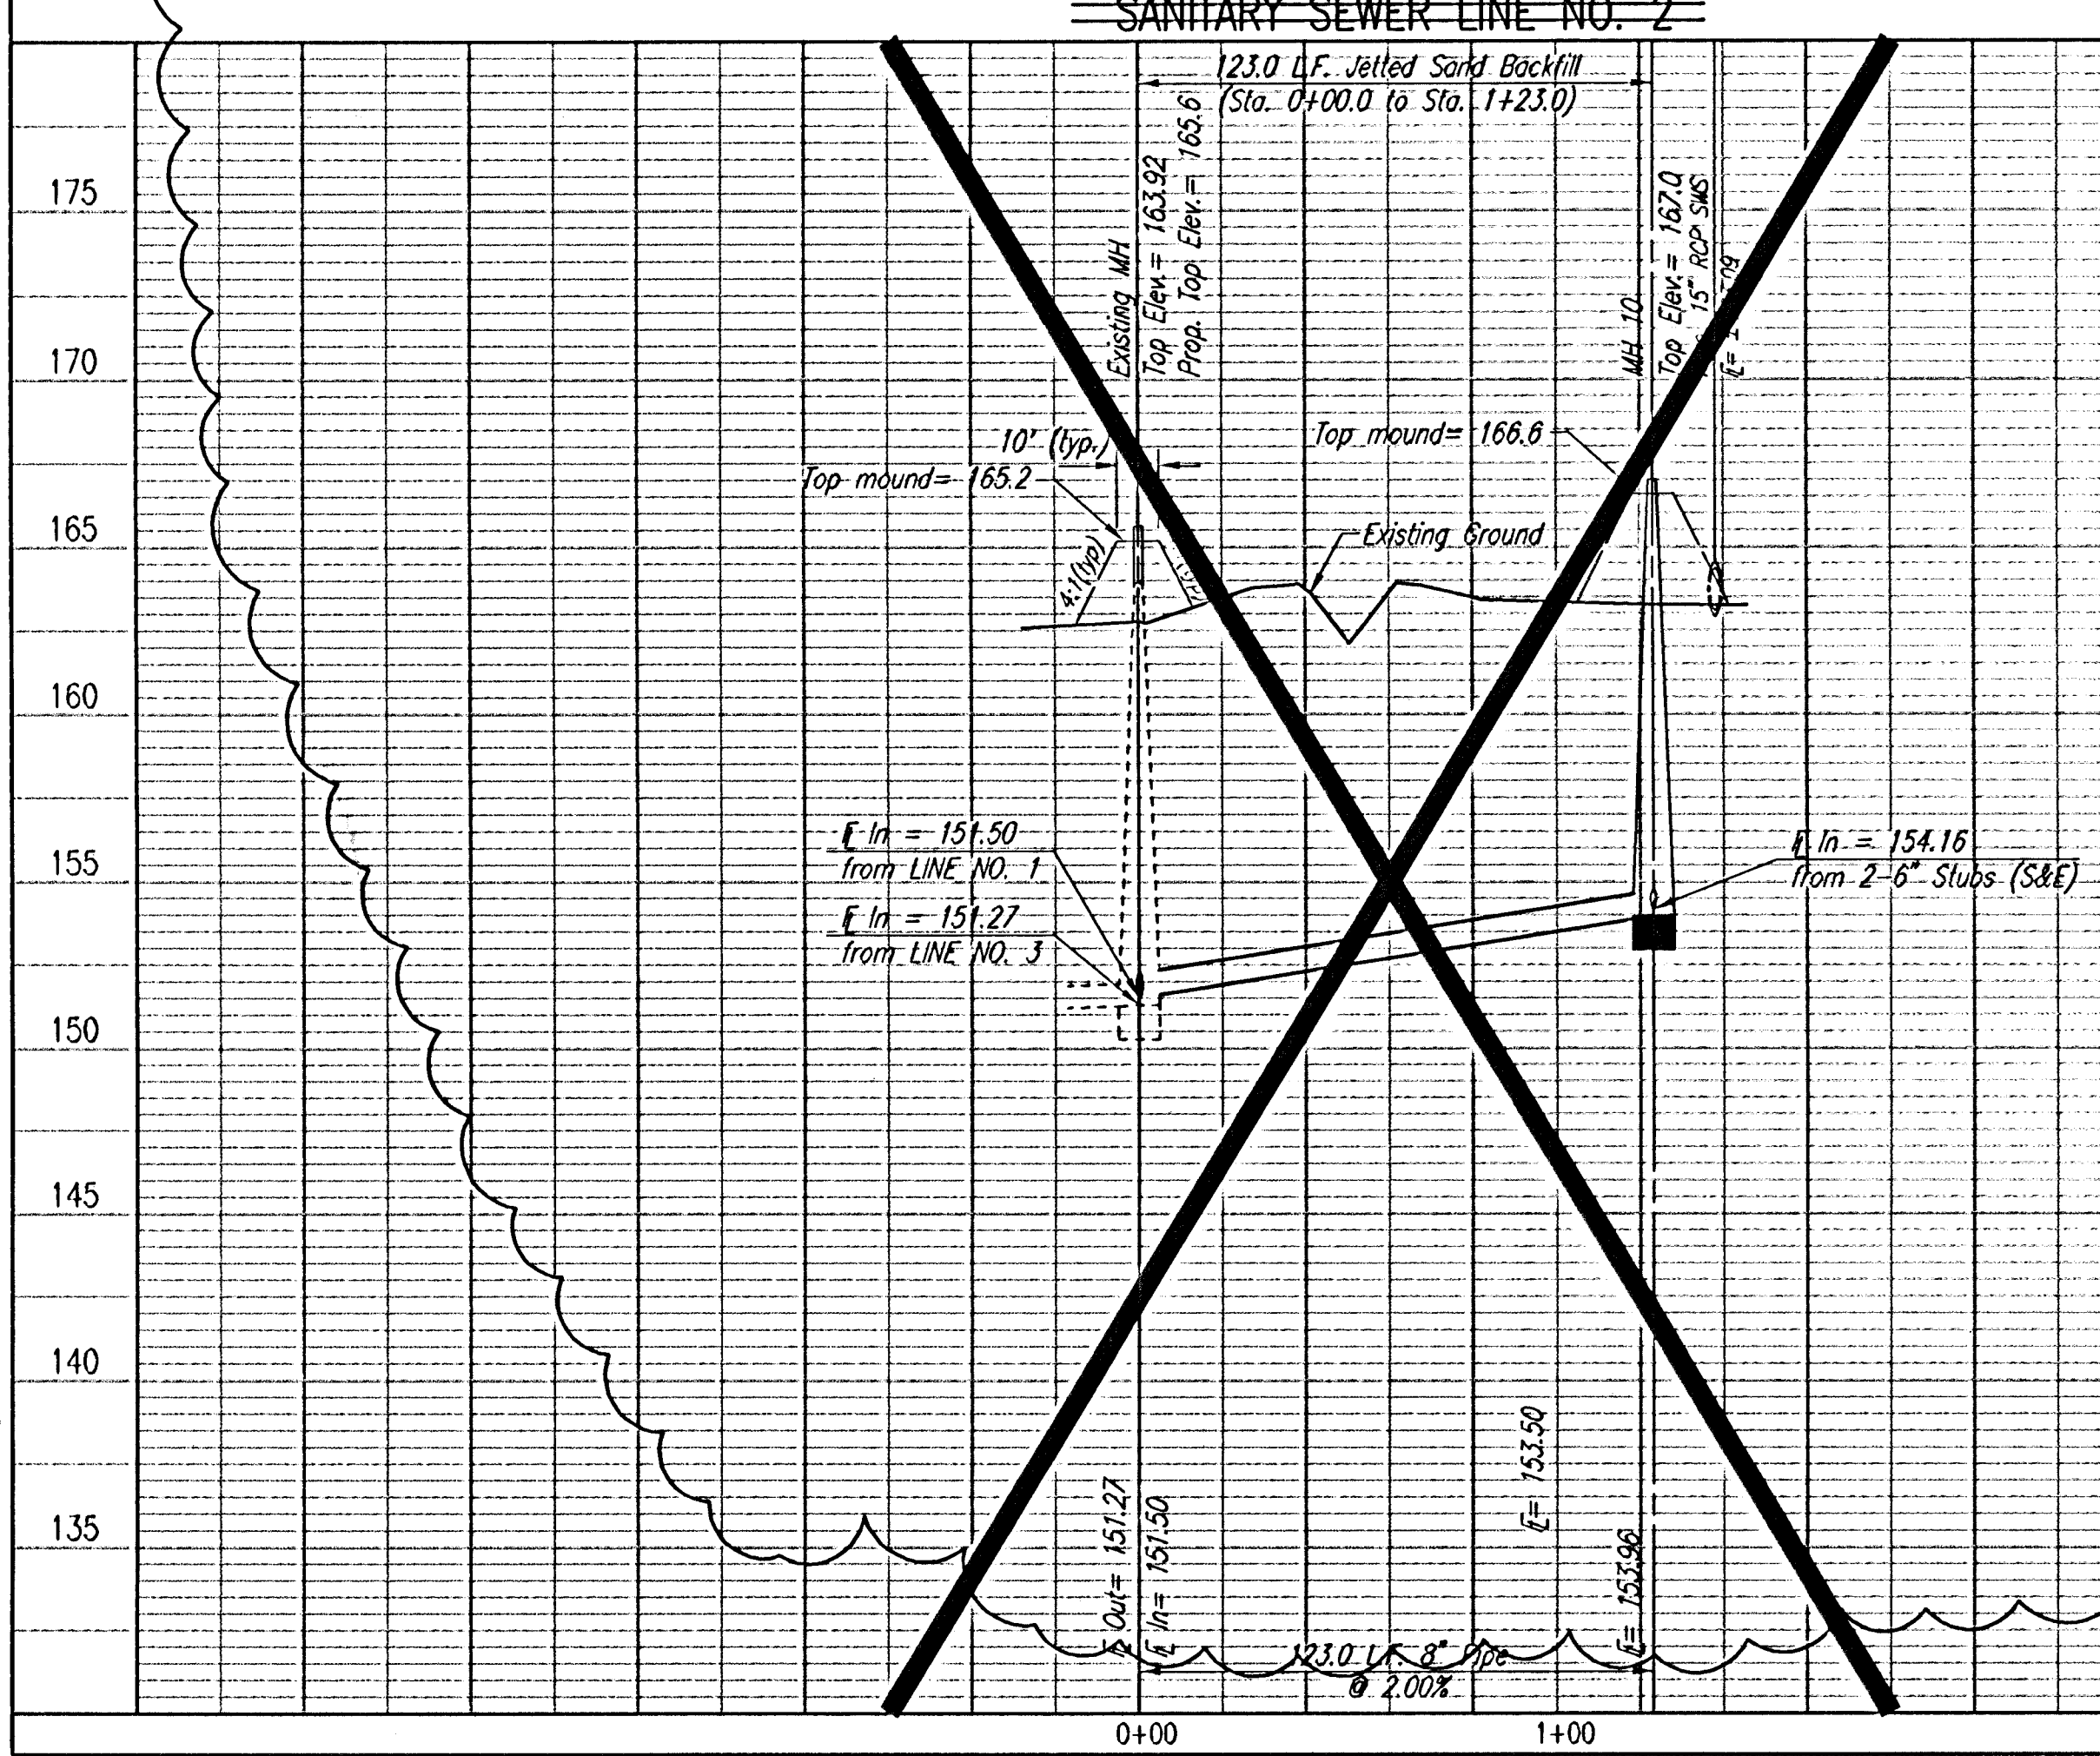

CHANGE ORDER NO. 1 5-02-05

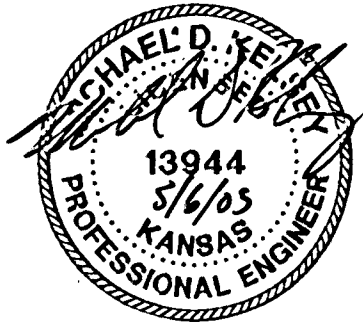

LATERAL 1, MAIN 6 OF THE
NORTHWEST INTERCEPTOR SEWER
SANITARY SEWER LINE NO. 2 & 3
JAMES L. ARMOUR, P.E. - ACTING CITY ENGINEER
CITY OF WICHITA PROJECT NO. 468-83969

Professional Engineering Consultants, P.A.
303 S. TOPSKA • WICHITA, KANSAS 67202
316-262-2691 • FAX 316-262-3003
Designed By MDK
Drawn By JCA
Job No. 35-04090-5054
Date January 2005

Sheet 8 of 18