


PLAN	CHECKED	DATE

PROFILE	CHECKED	DATE





DSUR: OPER. JCA SCALE: 1"=40.00
 Q:\2004\04090\000\Change Order No. 1\04090-000-C-SSPP04 05-05-2005 01:12:30 pm

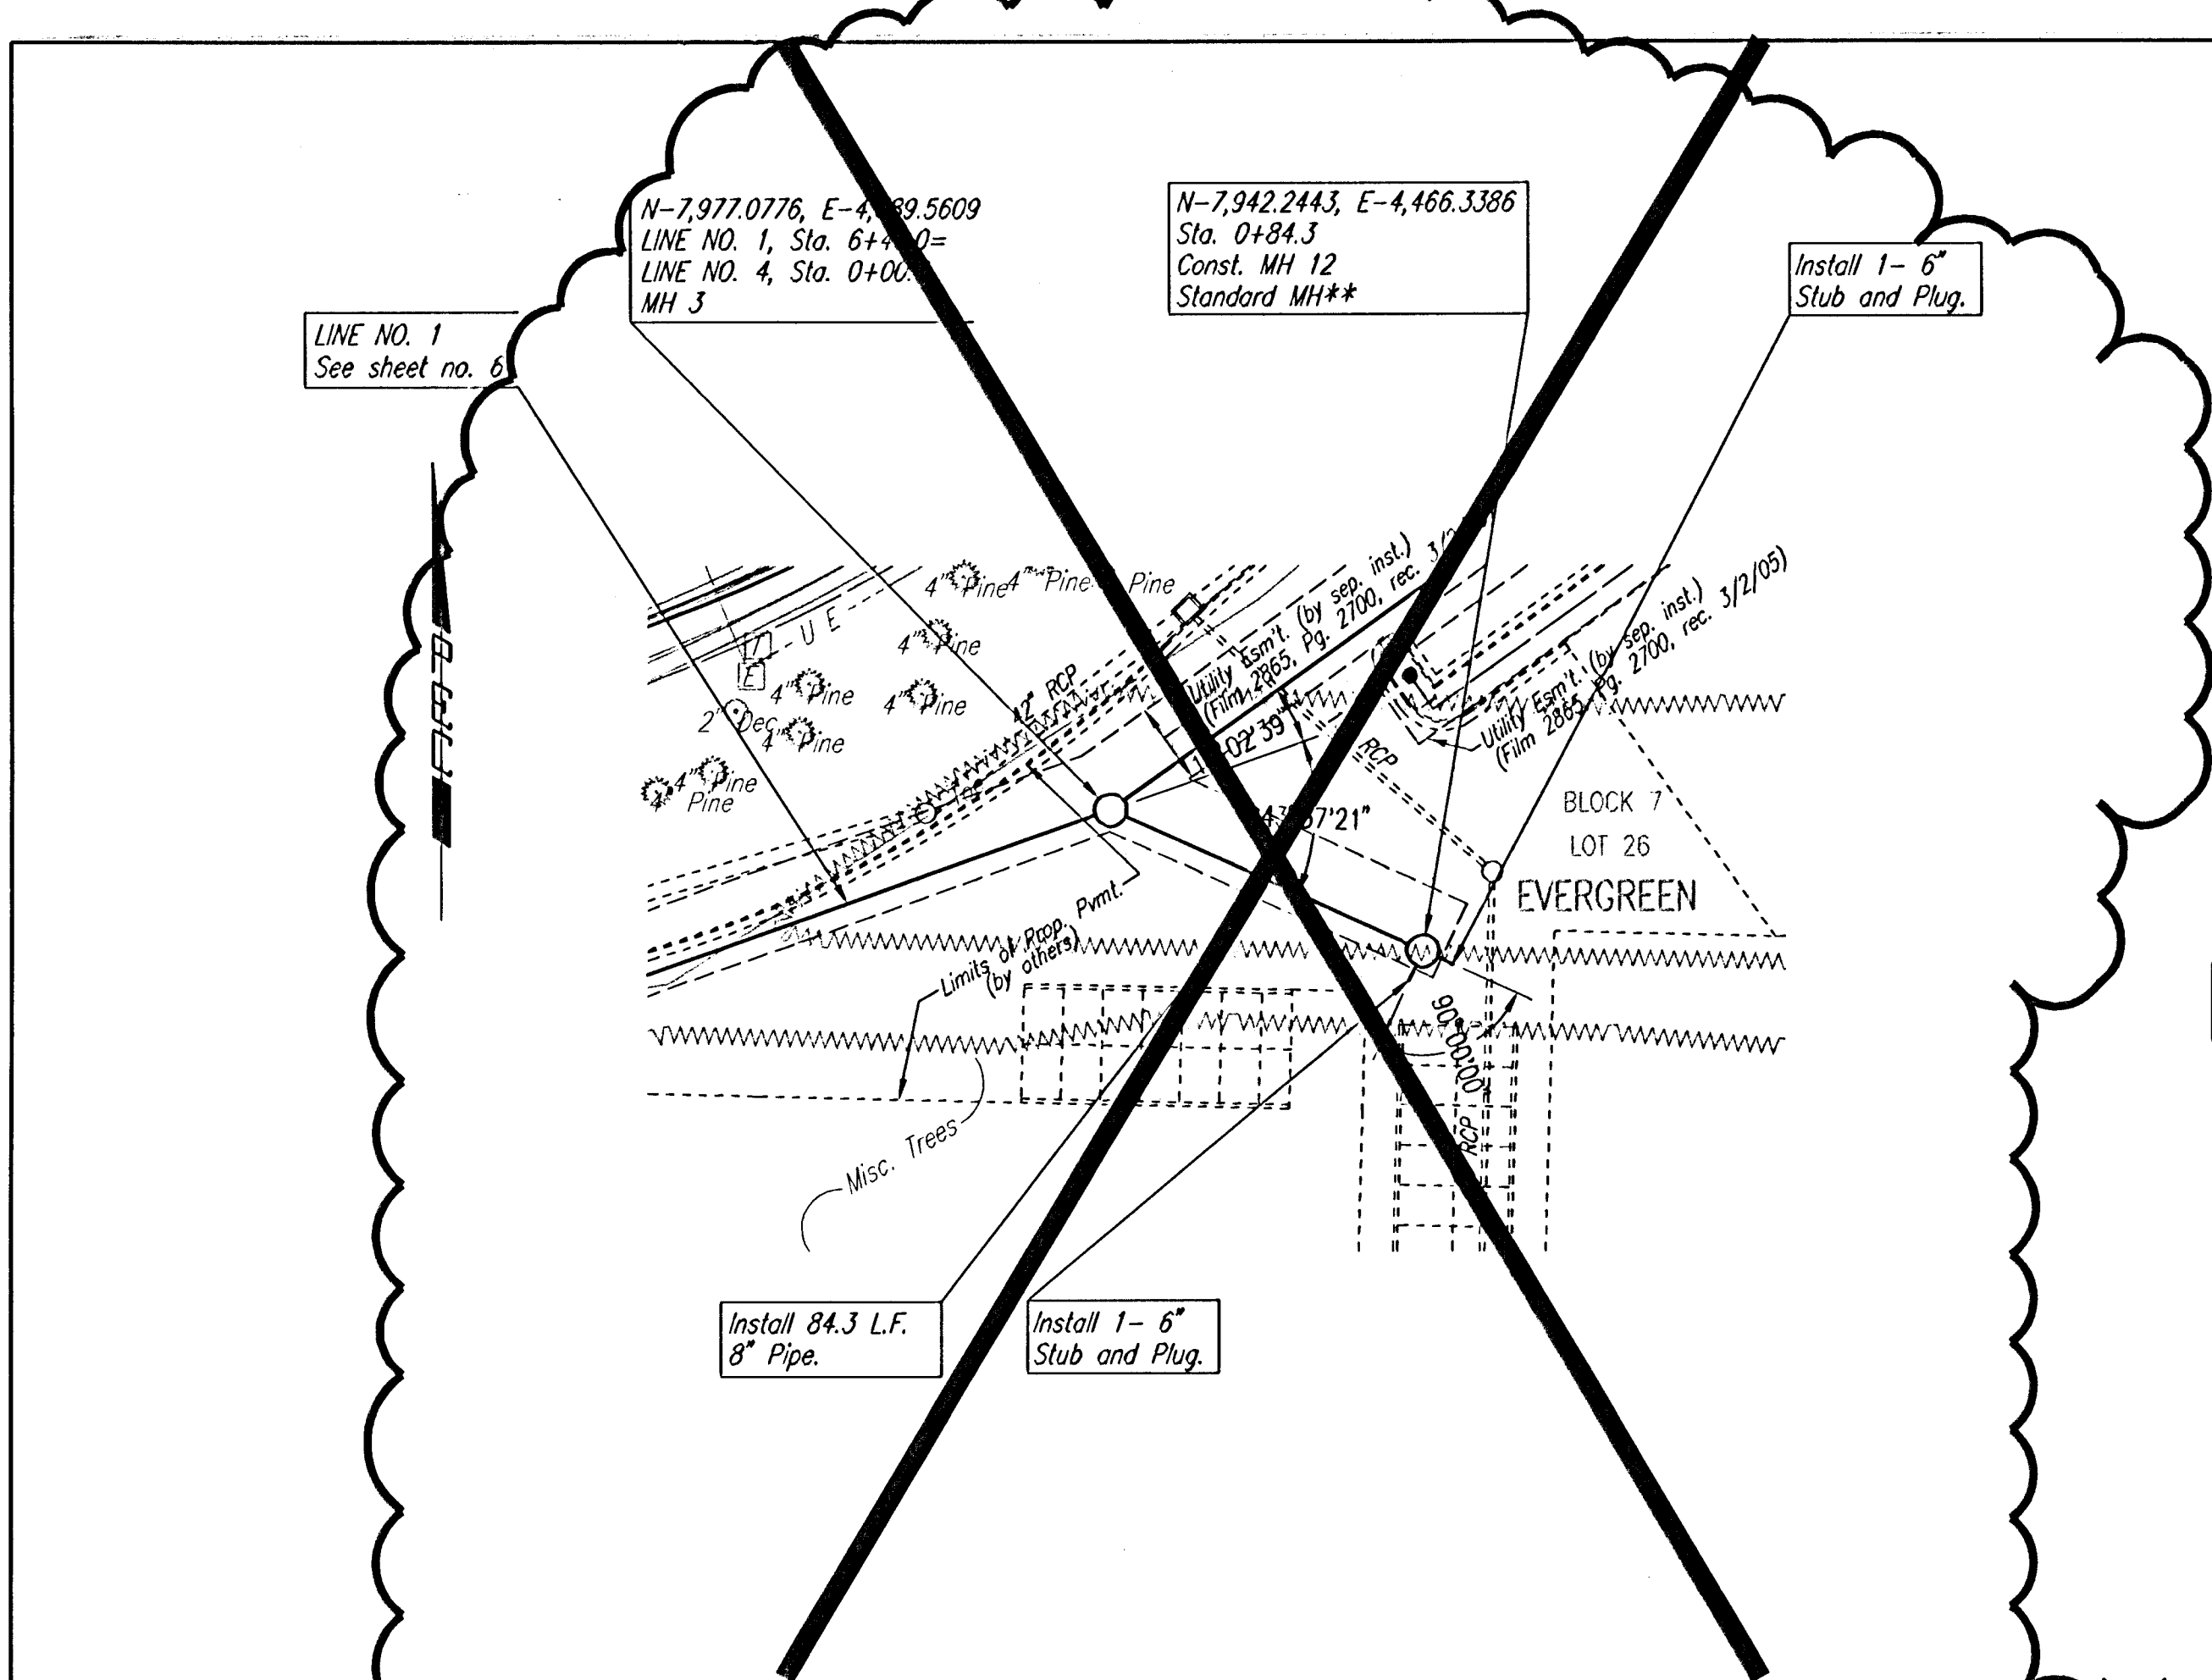

SEE SHEET NO. 3, 4, AND 5
FOR PLAT COORDINATES

** ALL MH'S TO INCLUDE
ONE (1) 6" ADJUSTMENT RING

X = TREE REMOVAL

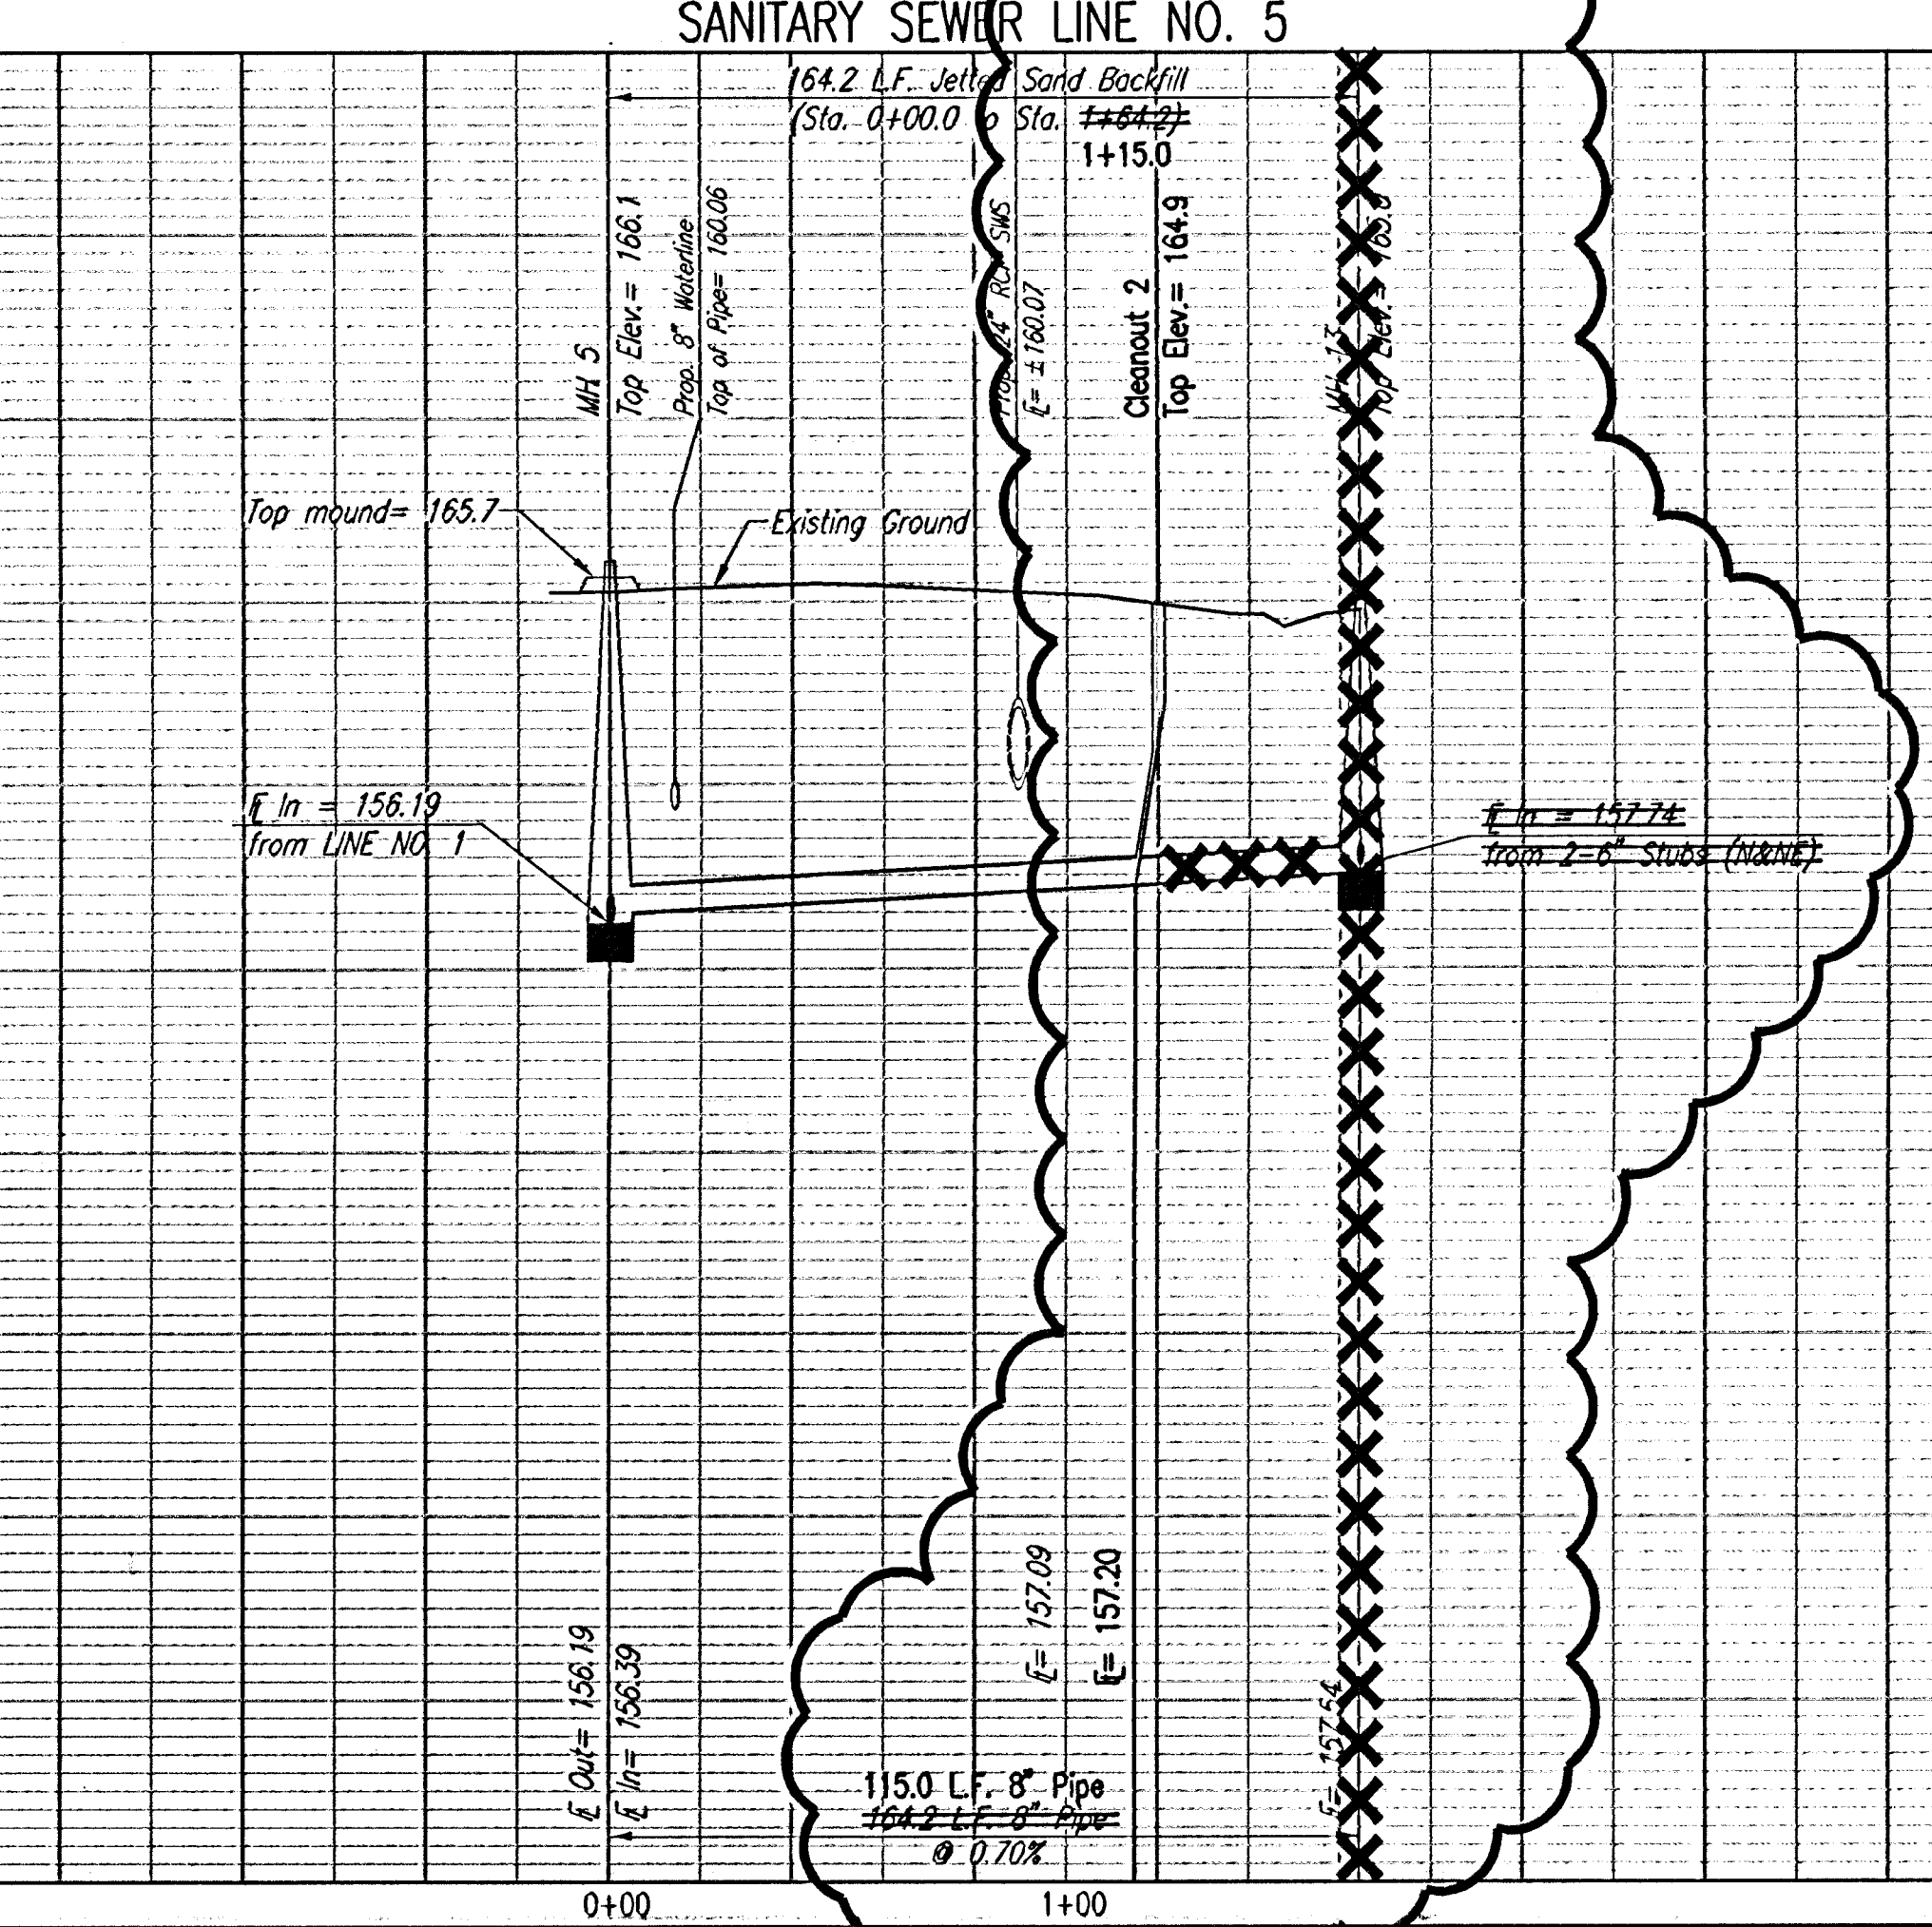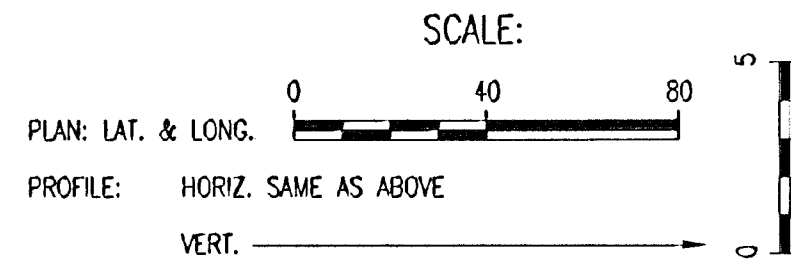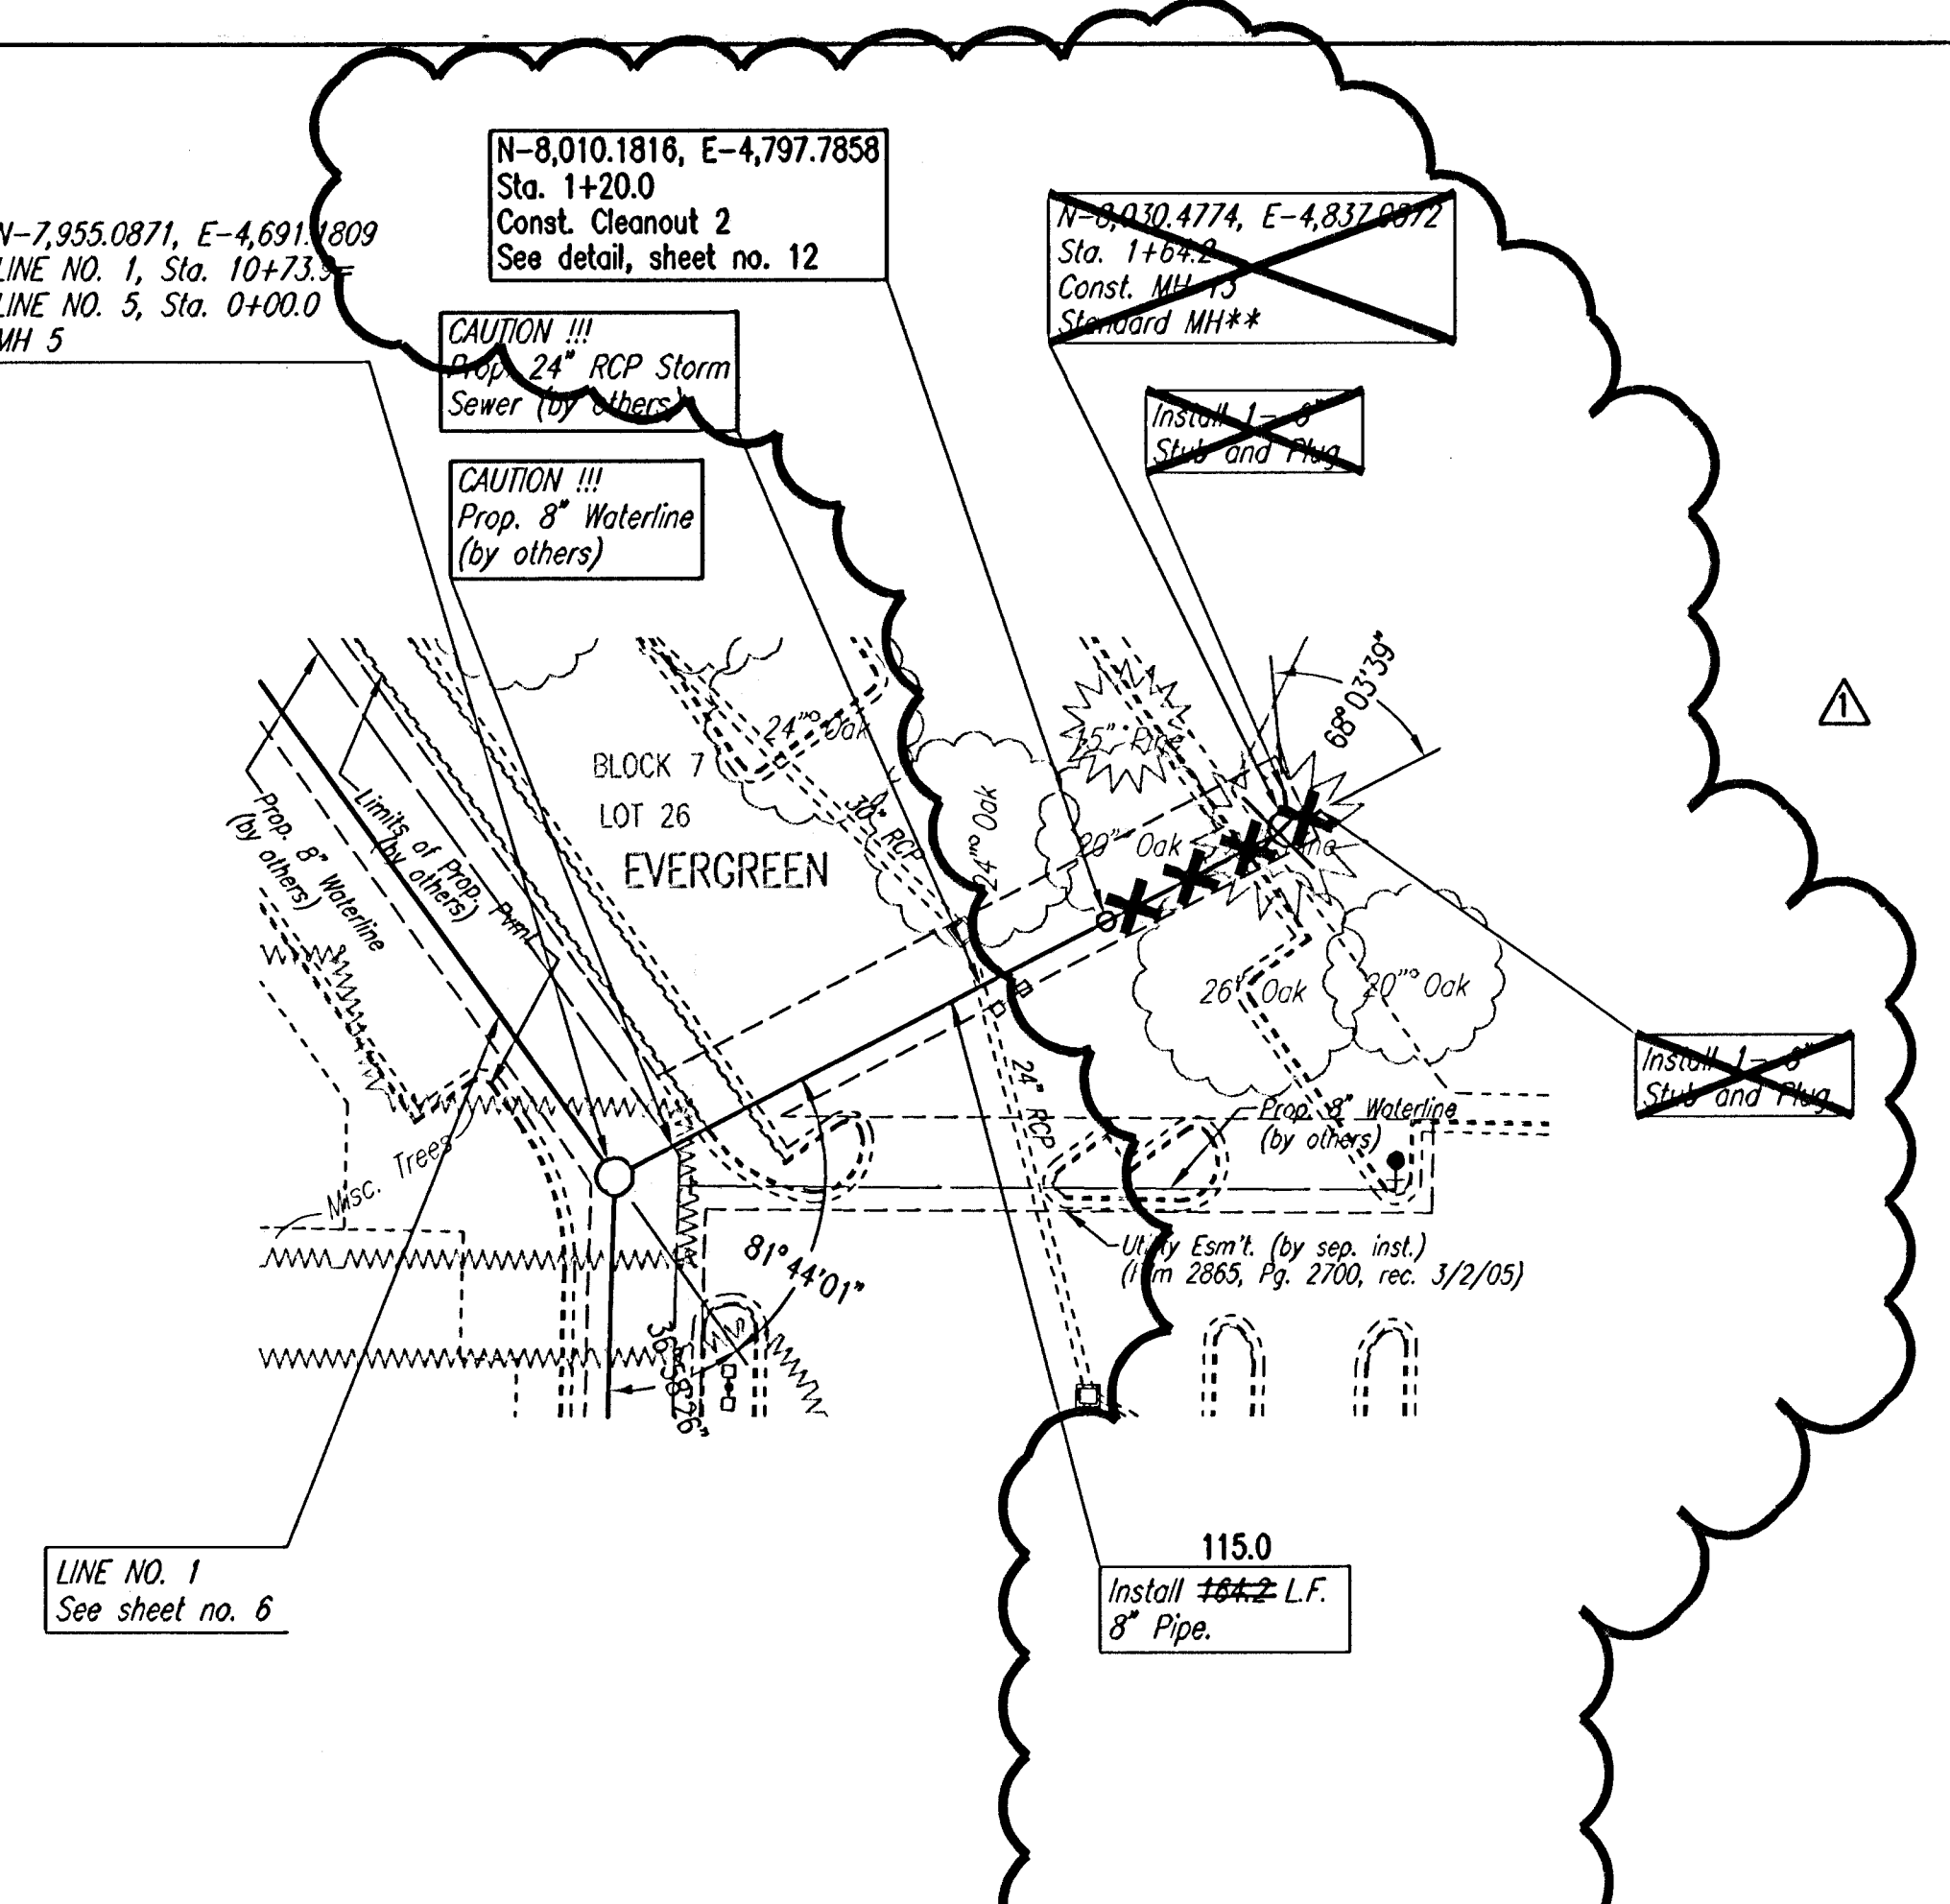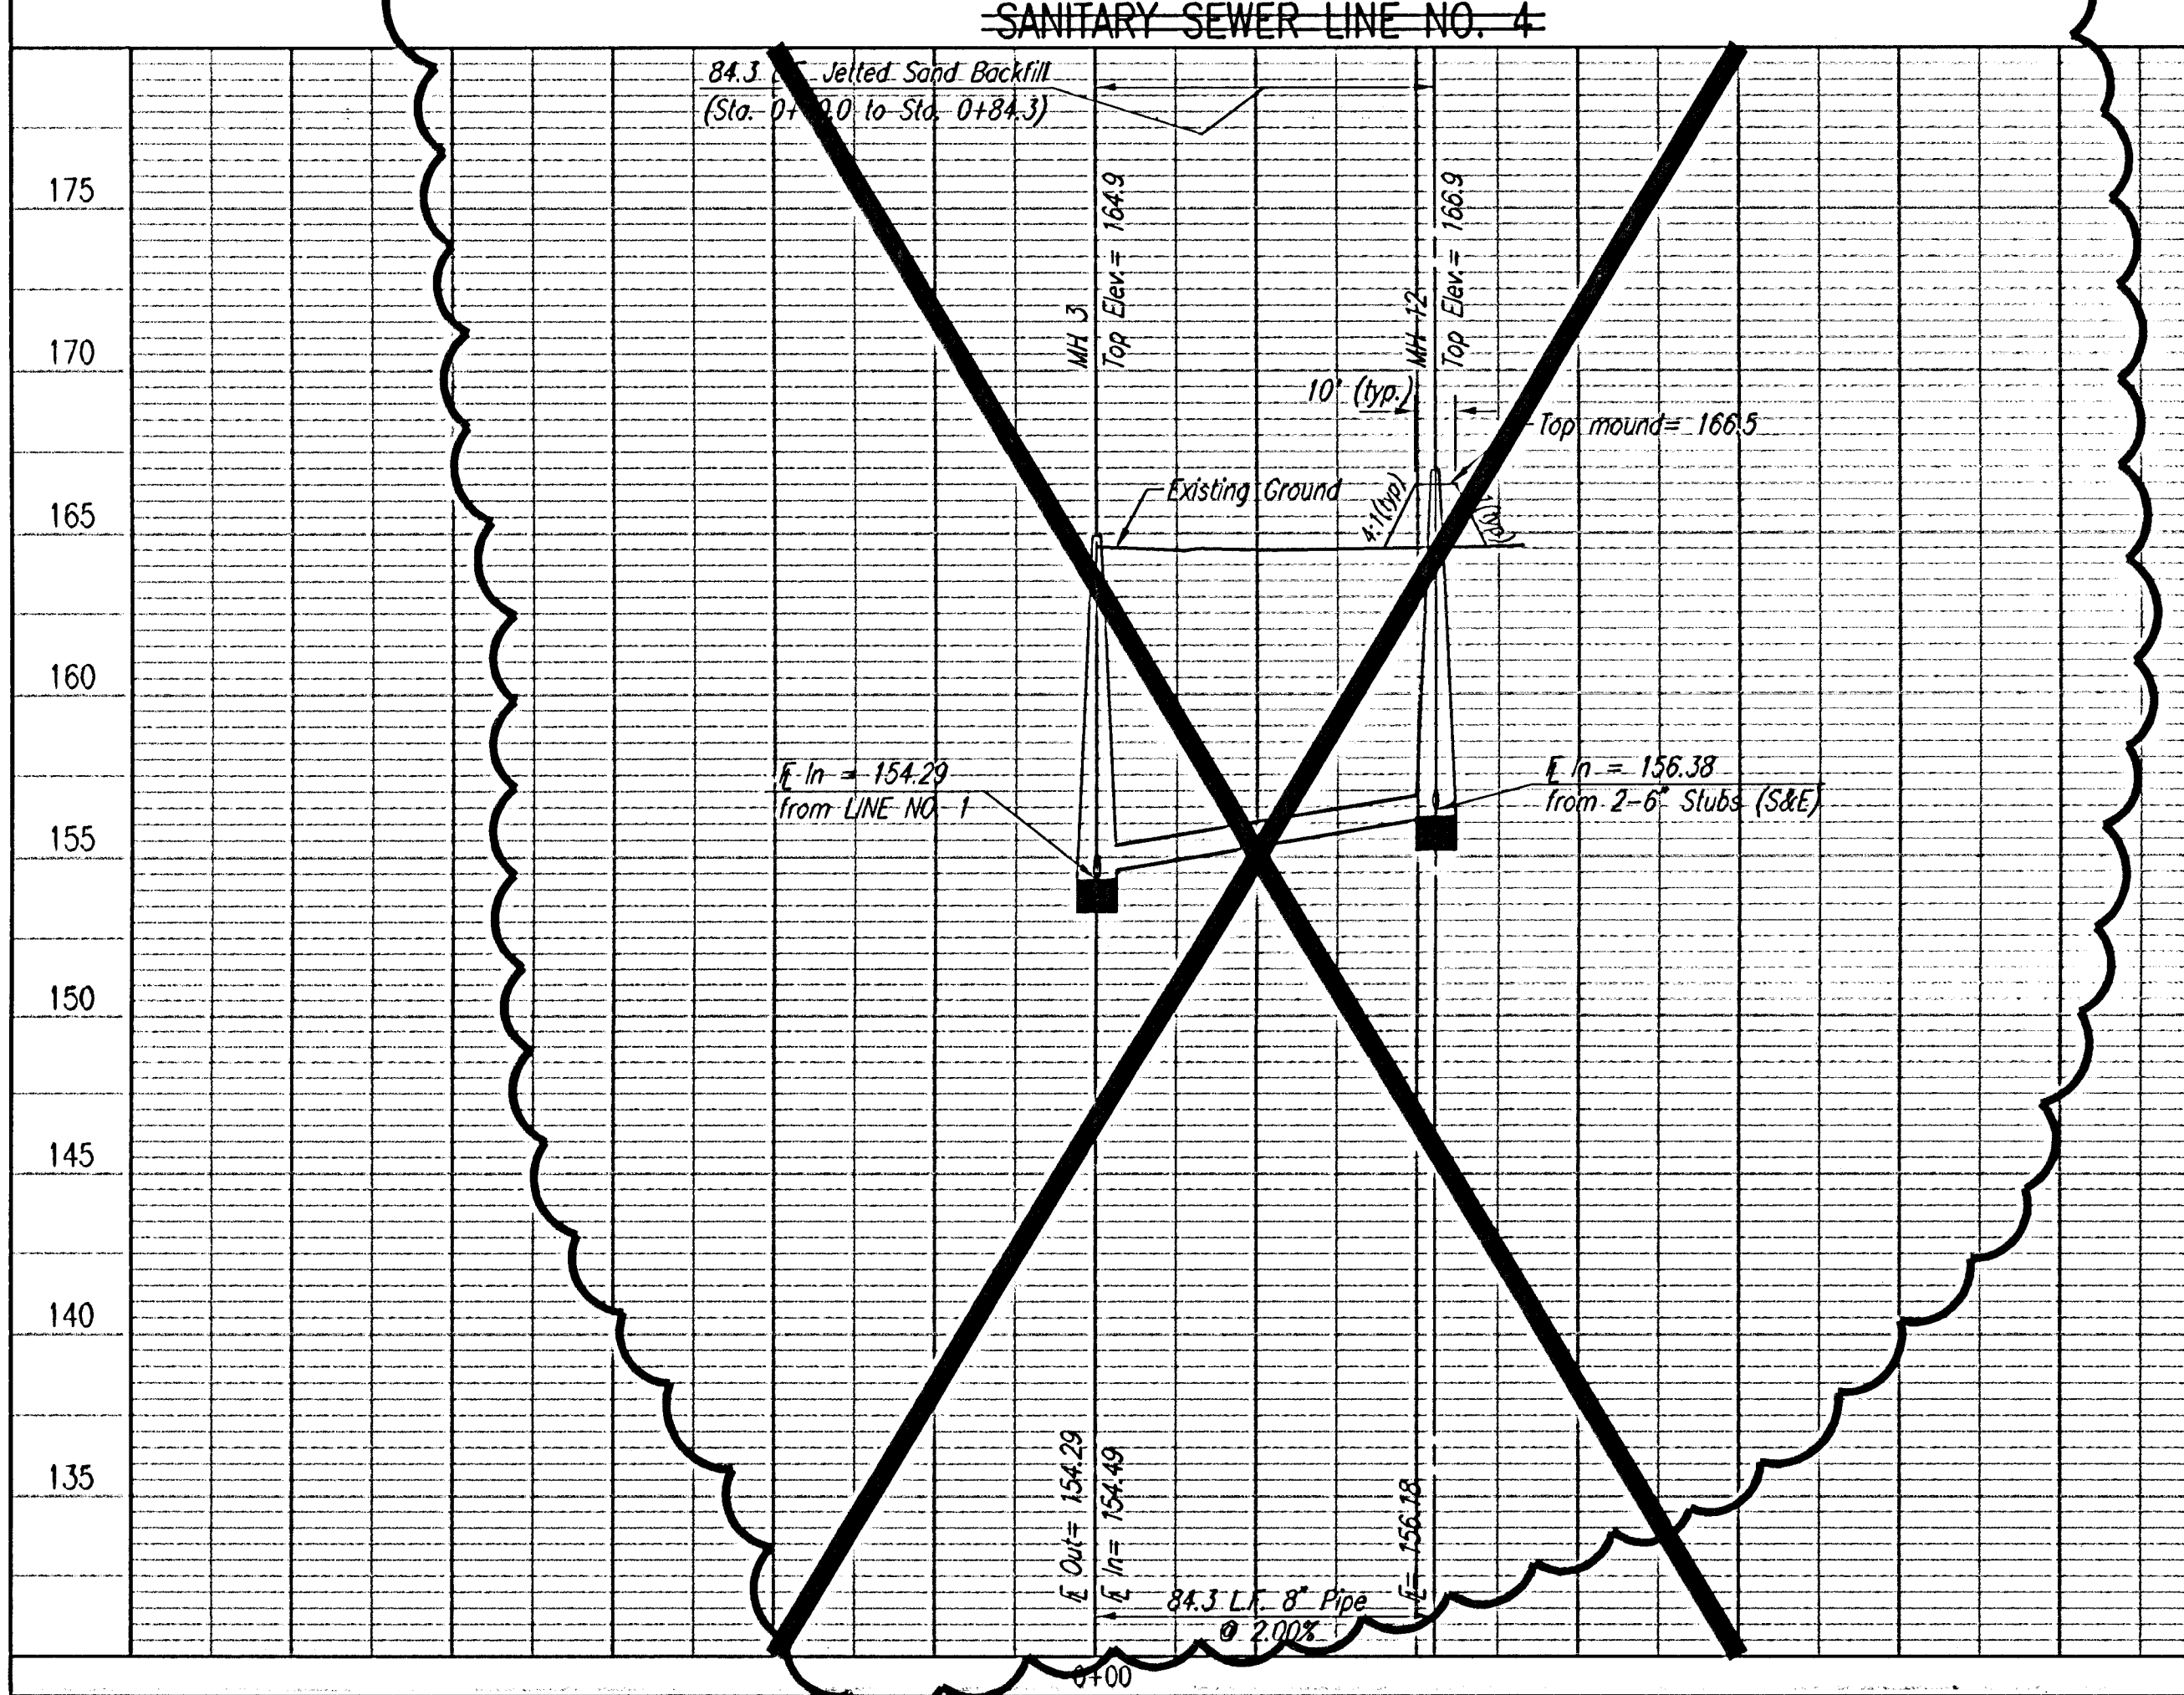

LATERAL 1, MAIN 6 OF THE NORTHWEST INTERCEPTOR SEWER	
SANITARY SEWER LINE NO. 4 & 5	
JAMES L. ARMOUR, P.E. - ACTING CITY ENGINEER CITY OF WICHITA PROJECT NO. 468-83969	
Professional Engineering Consultants, P.A. 303 S. TOPEKA • WICHITA, KANSAS 67202 316-262-2691 • FAX 316-262-3003	Job No. 35-04090-5054 Date January 2005
Designed By MDK	Drawn By JCA