



BENCHMARK:

City Disc In T.C. Adj. to F.H.
17.5' North of Monterey. At the
South West Corner of Lot 10
Block C Auburn Hills 15th
Addition.
Elev. = 177.39 (City Datum)

City Disc In T.C. Adj. to F.H.
27' North of Monterey. At the
Intersection of Monterey and
Auburn Hills.
Elev. = 179.40 (City Datum)

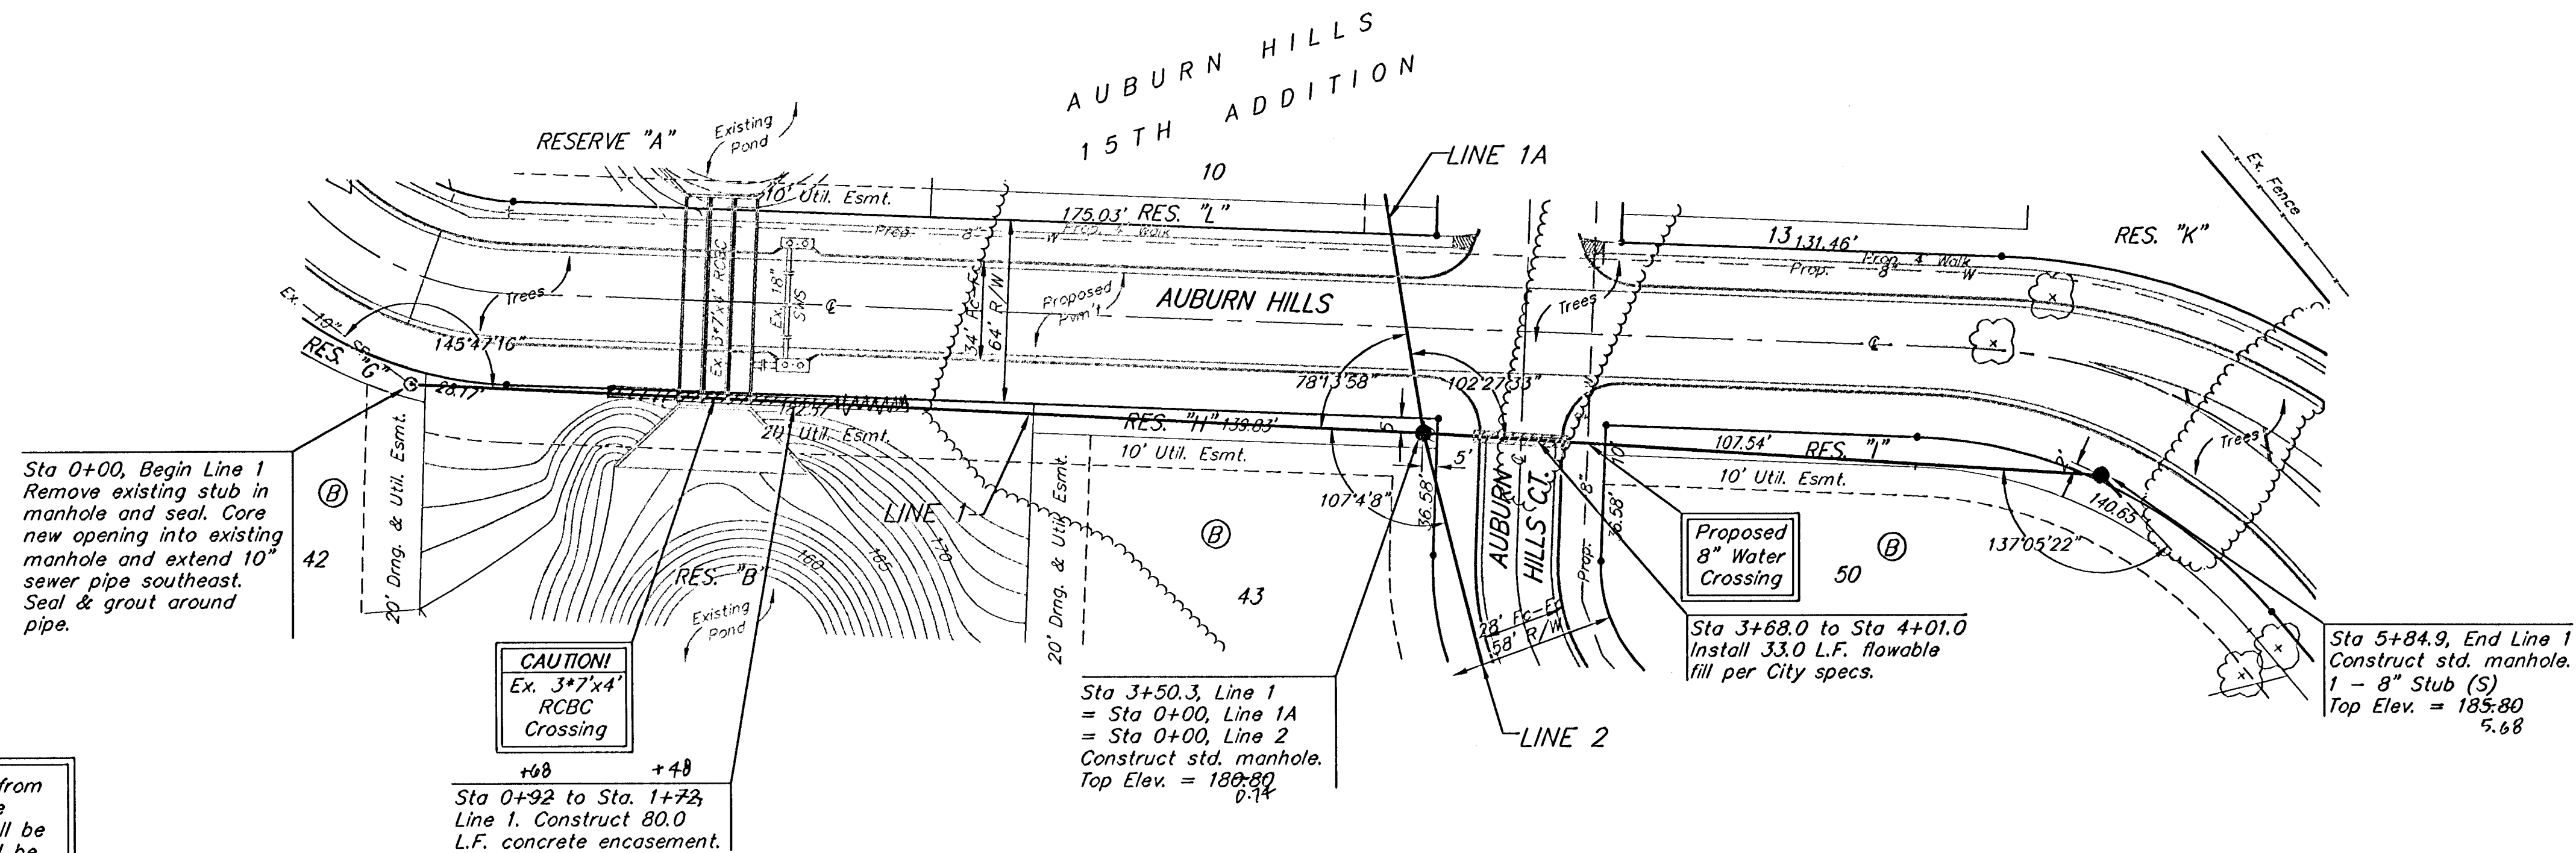

All trench and manhole excavation areas from Sta. 0+00 to Sta. 5+84.9, Line 1 shall be backfilled with sand. The sand backfill shall be within two feet of existing grade and shall be water-jatted and vibrated during backfilling. All costs shall be subsidiary to pipe cost.

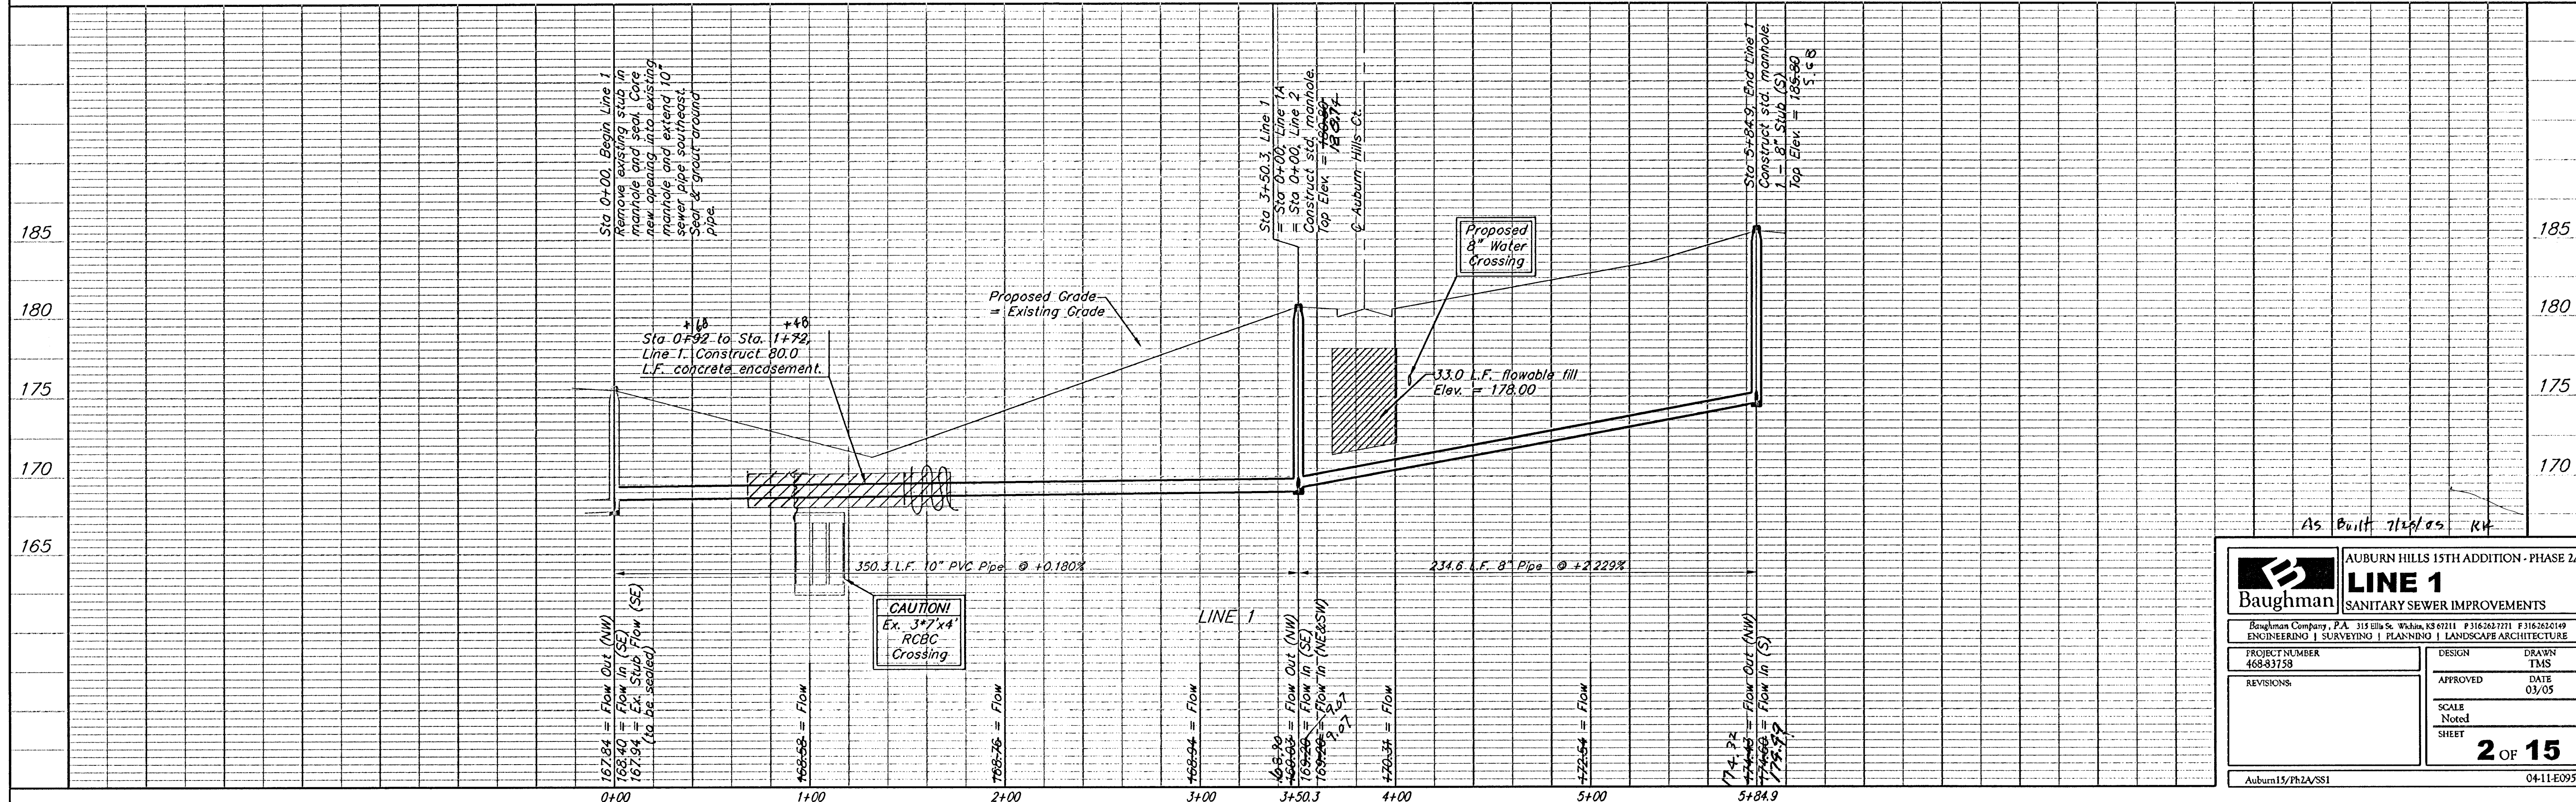

Baughman		AUBURN HILLS 15TH ADDITION - PHASE 2A	
LINE 1		SANITARY SEWER IMPROVEMENTS	
ENGINEERING SURVEYING PLANNING LANDSCAPE ARCHITECTURE			
PROJECT NUMBER 468-83738	DESIGN TMS	APPROVED DATE 03/05	SCALE Noted SHEET 2 OF 15
REVISIONS:		Auburn15/Ph2A/SSI 04-11-E093	