



City Disc In T.C. Adj. to F.H.
17.5' North of Monterey. At the
South West Corner of Lot 10
Block C Auburn Hills 15th
Addition.
Elev. = 177.39 (City Datum)

City Disc In T.C. Adj. to F.H.
27' North of Monterey. At the
Intersection of Monterey and
Auburn Hills.
Elev. = 179.40 (City Datum)

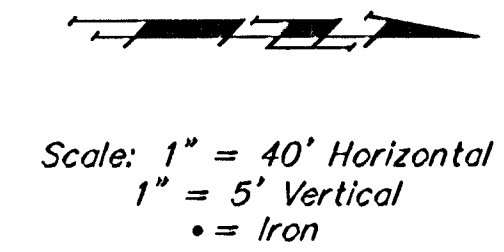

Remove trees only as necessary for sanitary sewer construction and only with permission of Developer or Baughman Co. Cost of removal to be incidental to lump sum bid item "Site Clearing & Restoration".

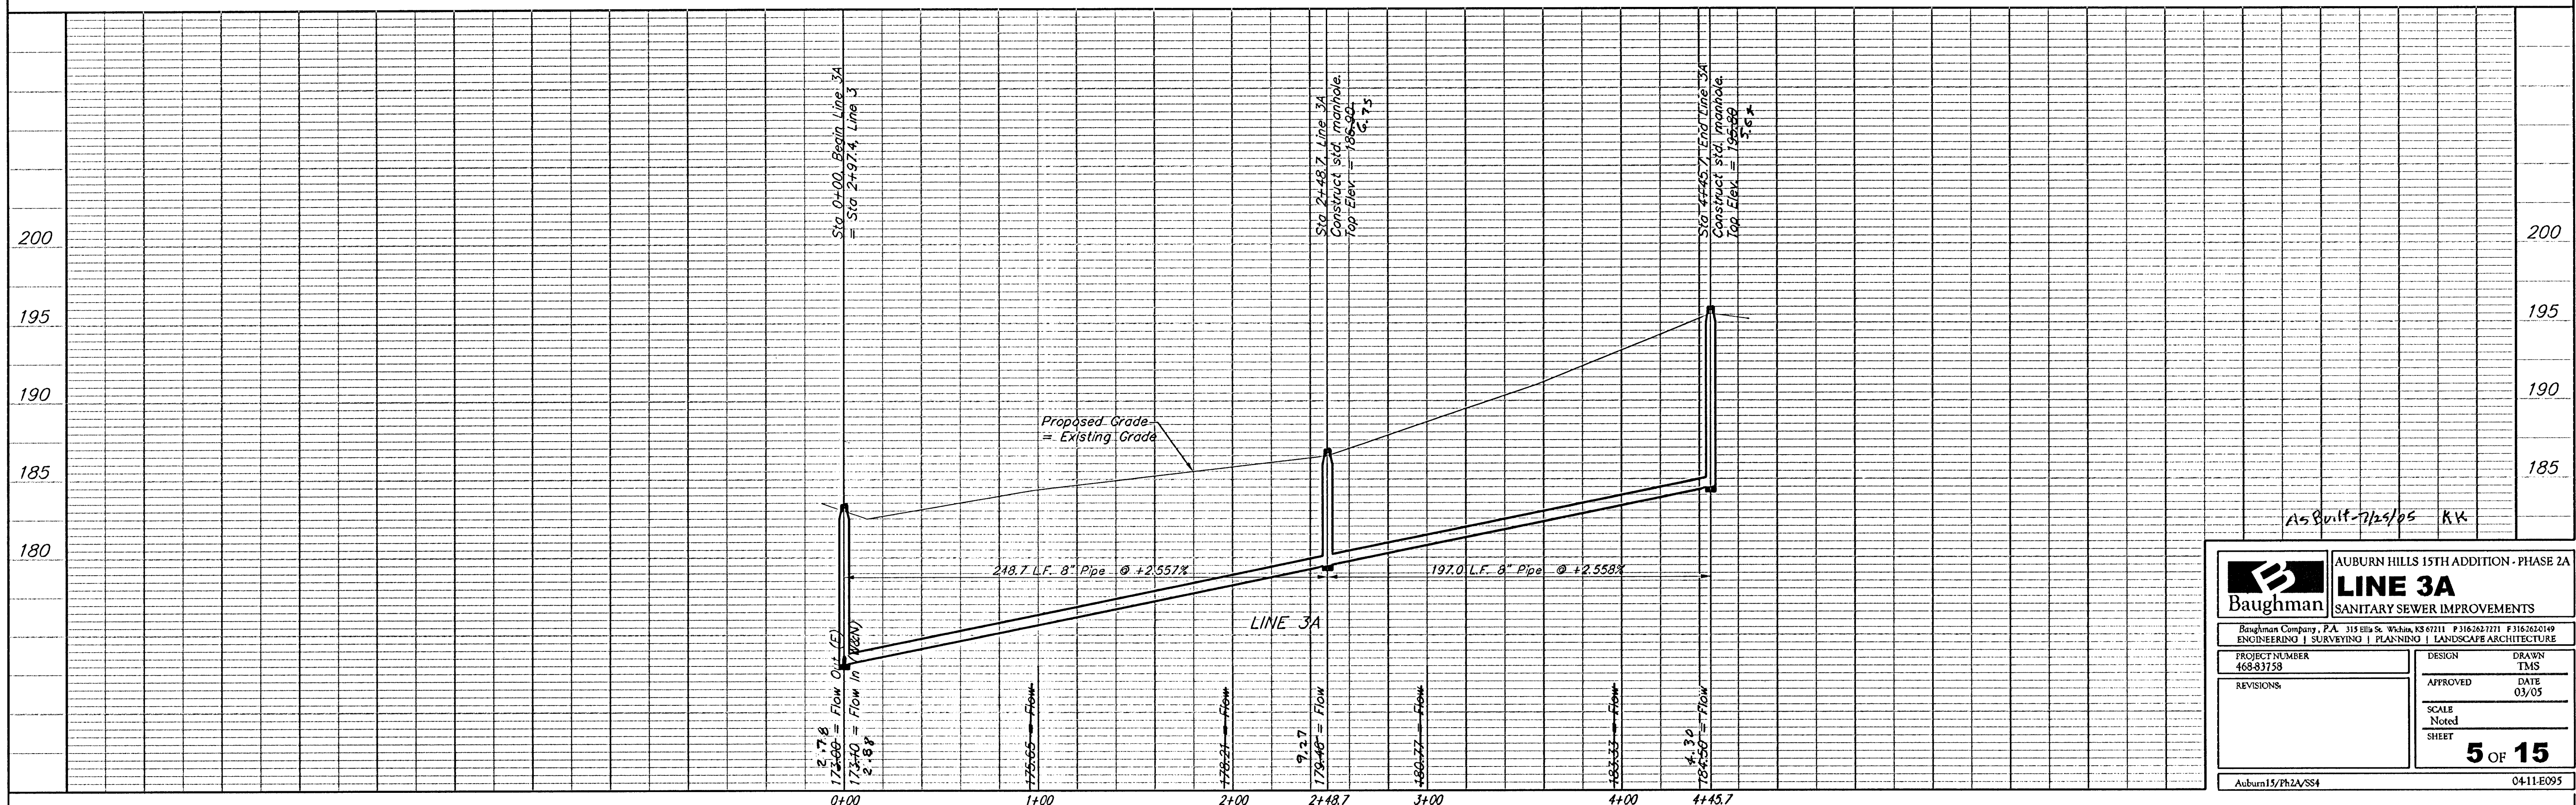

 Baughman	AUBURN HILLS 15TH ADDITION - PHASE 2A	
	LINE 3A SANITARY SEWER IMPROVEMENTS	
PROJECT NUMBER 468-83758	DESIGN DMS	DRAWN DMS
REVISIONS:	APPROVED	DATE 03/05
	SCALE Noted	
	SHEET	
	5 OF 15	
Auburn's P:PS/2A/SS/4		