

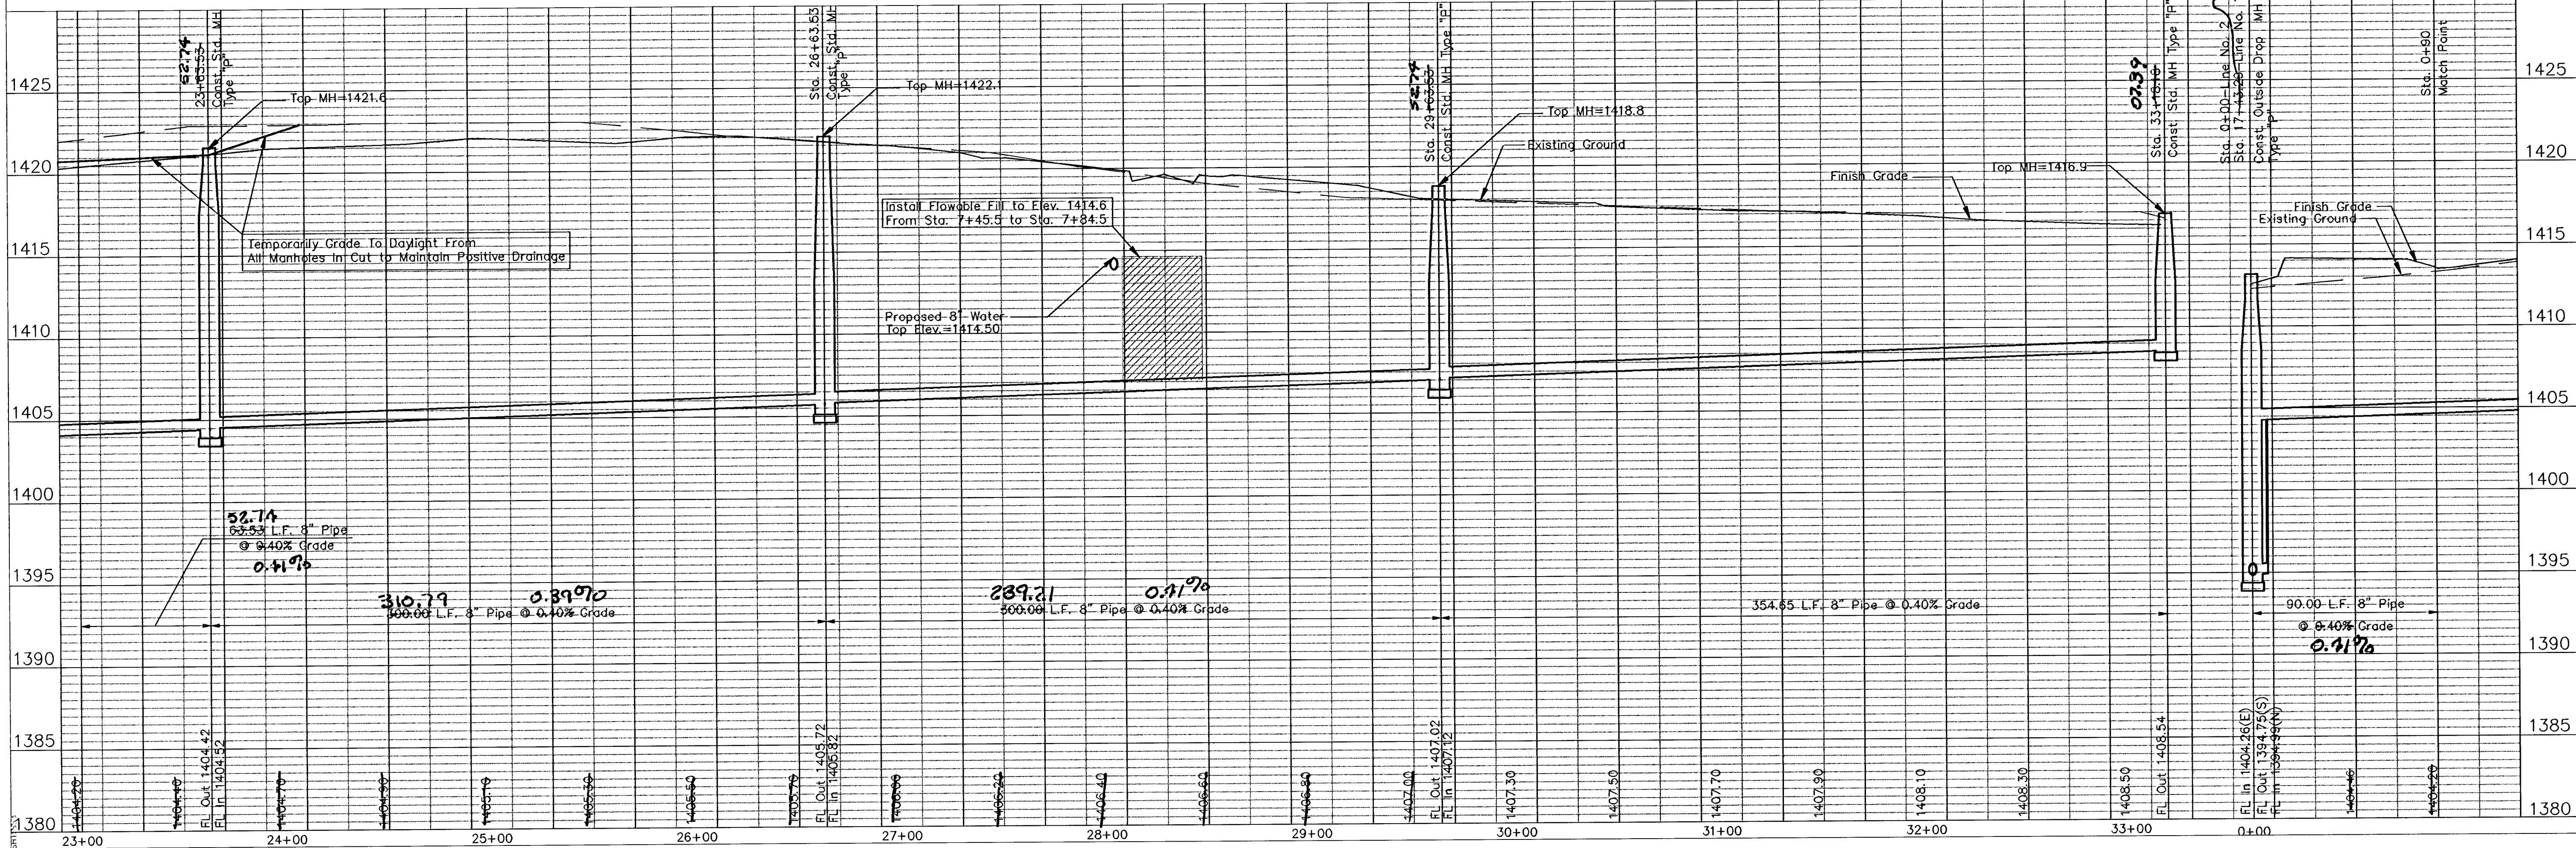


SANITARY SEWER RISER SUMMARY									
No.	Line	Sta./Dir.	Lot No.	Block No.	Saddle Size	8" Main FL	4" Pipe		Coordinates at End of 4" Pipe
							Vert.	Horiz.	
10	1	23+28 RL	15	2	8" x 4"	1404.30	16'	13' 20"	11296.69
11	1	24+00 RL	15	2	8" x 4"	1404.90	16'	13' 20"	11293.45
12	1	25+00 RL	16	2	8" x 4"	1405.30	17'	13' 20"	11294.46
13	1	26+00 RL	17	2	8" x 4"	1405.70	13'	13' 20"	11293.47
14	1	27+00 RL	18	2	8" x 4"	1406.20	15'	13' 20"	11292.47
15	1	29+00 RL	2	1	8" x 4"	1406.80	12'	13' 20"	11290.99

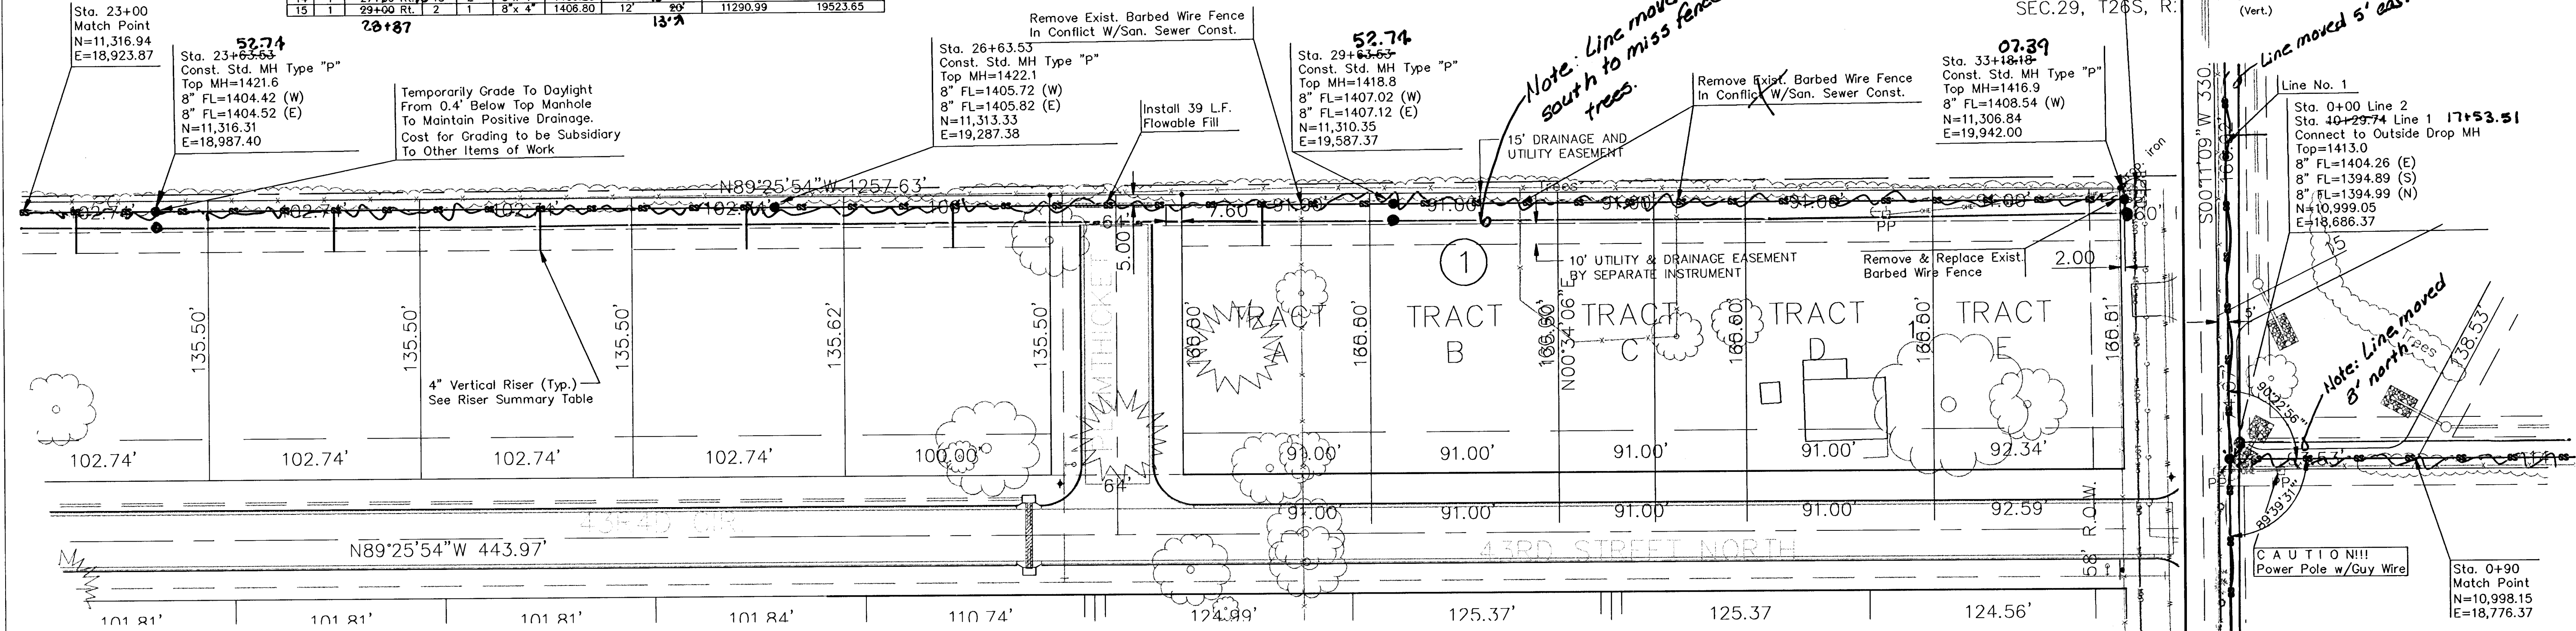

SAND PLUM ADDITION
SANITARY SEWER IMPROVEMENTS
SEWER LINE NO. 1 & 2
CITY OF WICHITA, KANSAS
JAMES ARMOUR, P.E. - CITY ENGINEER
Proj.# 468-53822 O.C.A.# 744073

POE & ASSOCIATES, INC.
CONSULTING ENGINEERS
5940 E. Central, Suite 200 • Wichita, KS 67209-4242
Phone 316/685-4114 • FAX 316/685-4444

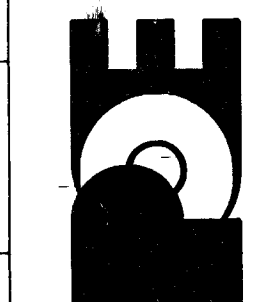

FINAL
Designed By: T. Austin
Drawn By: S. Schmidt
Poe Job No.: 02153-03
Date: December 2004
Sheet
4 of 14