



02102153 02153-03 base ss.dwg Tue Jan 04 08:50:50 2005 Steve Schmidt-Poe & Associates of Kansas, Inc.

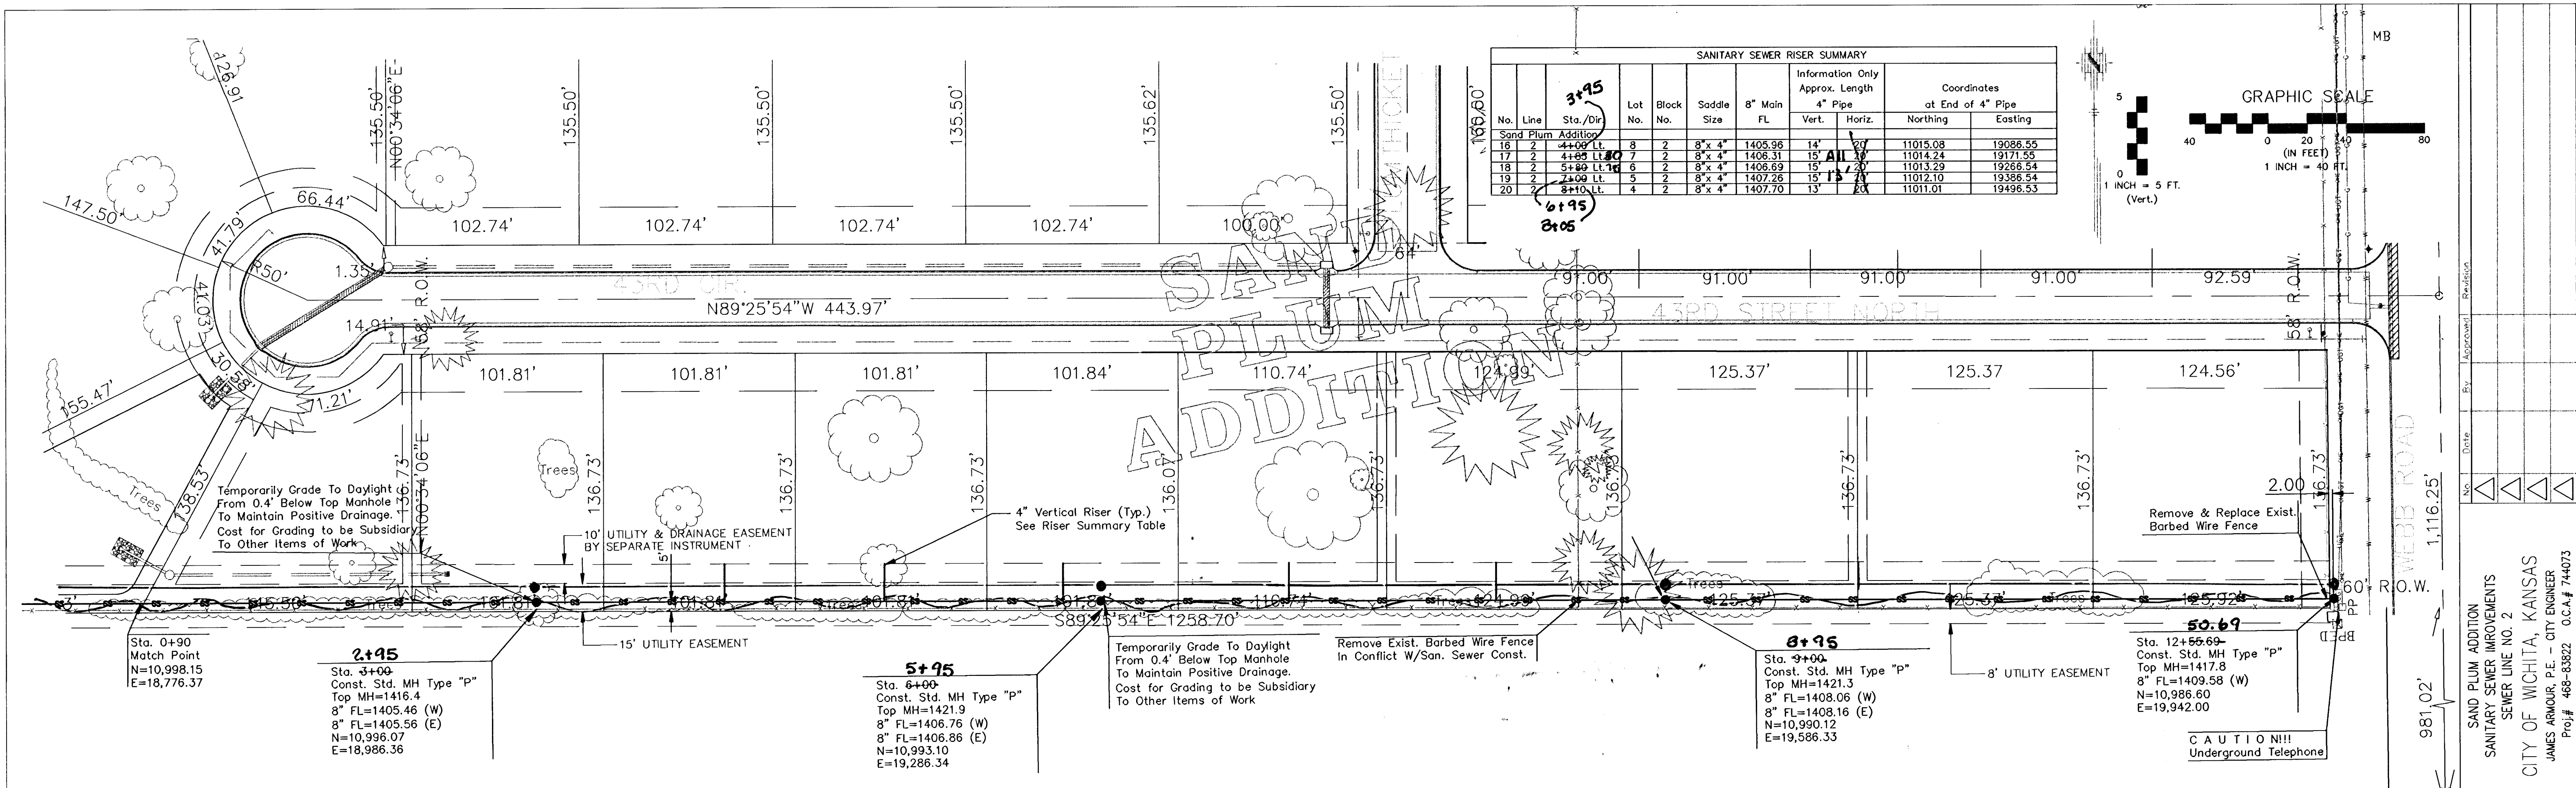

LINE NO. 2

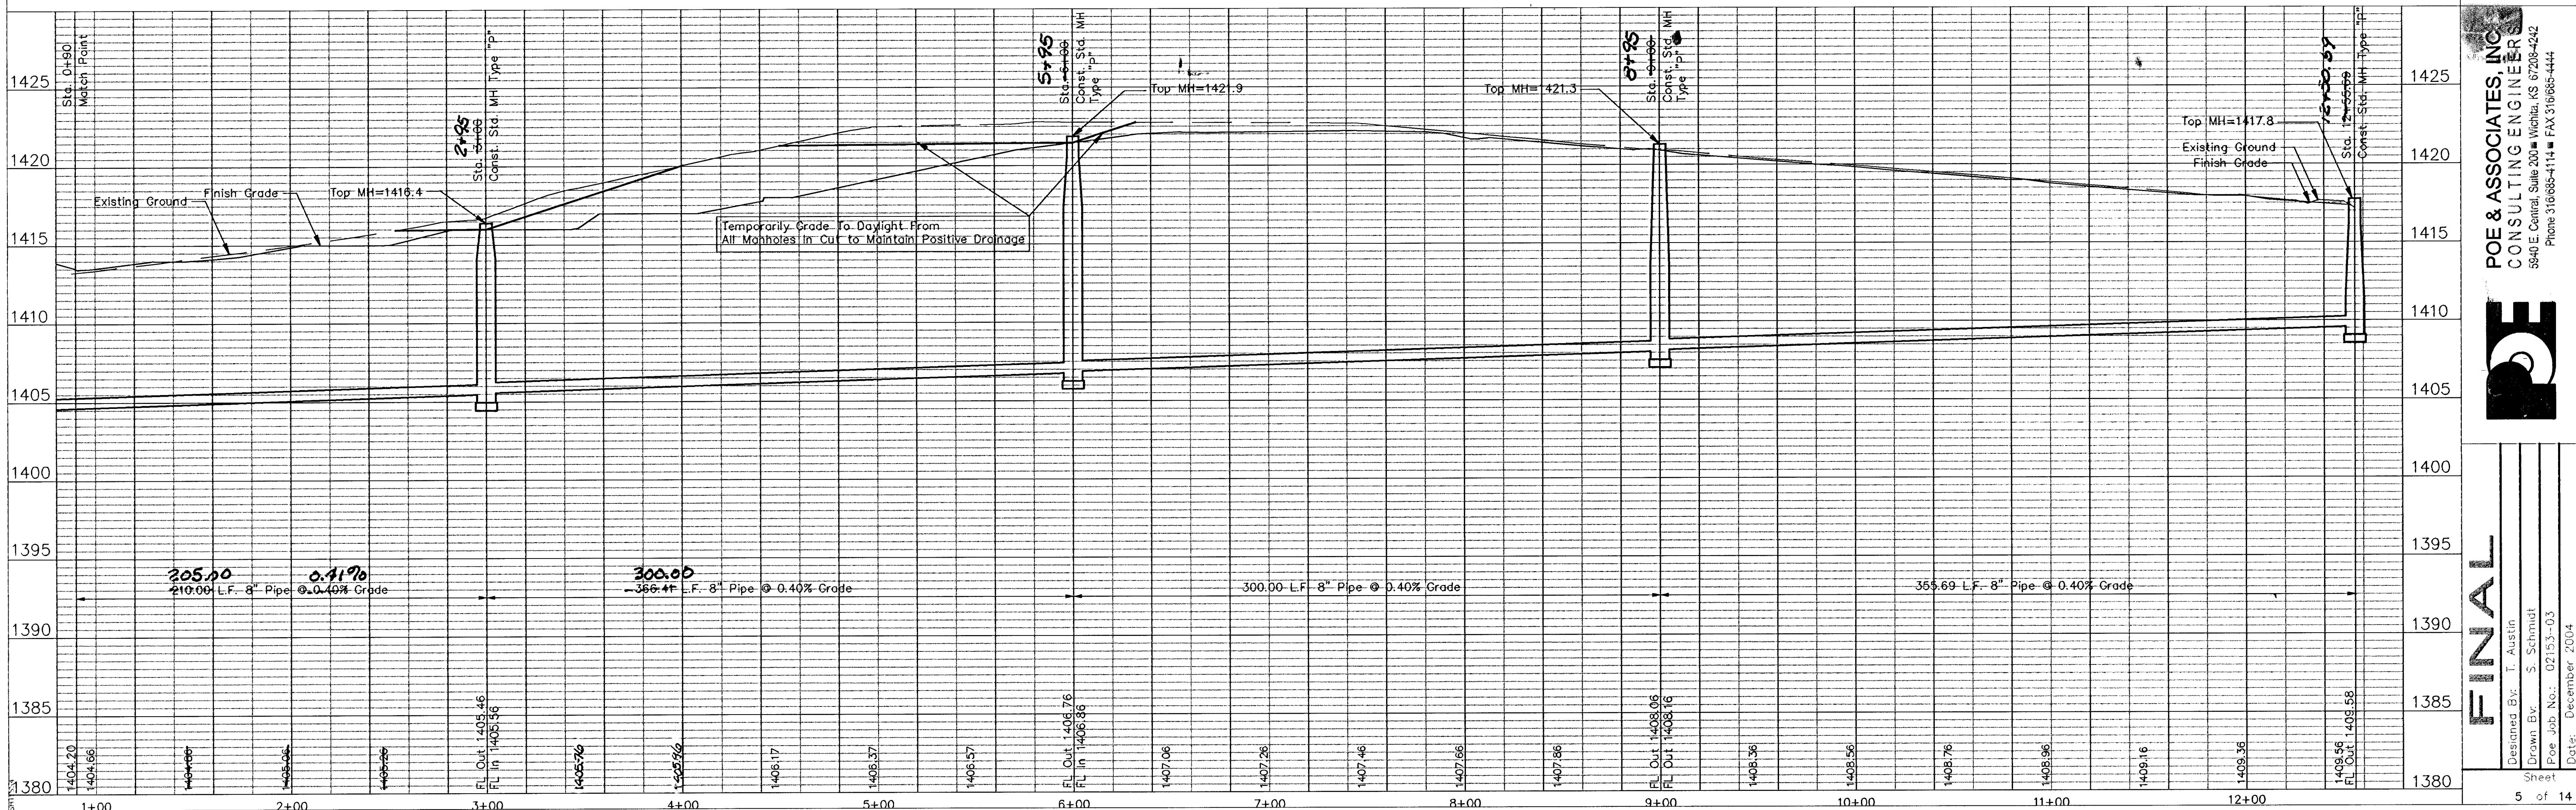

POE & ASSOCIATES, INC.
CONSULTING ENGINEERS
5840 E. Central, Suite 200 • Wichita, KS 67208-4242
Phone 316/685-4114 • FAX 316/685-4444

FINAL

Designed By: T. Austin
Drawn By: S. Schmidt
Poe Job No.: 02153-03
Date: December 2004

5 of 14