

FOX RIDGE ADDITION

FOX RIDGE ADDITION


FOX RIDGE ADDITION

FOX RIDGE ADDITION

PLAN LINE 3

PROFILE LINE 3

SCALE: HORIZ 1"=40'
SCALE: VERT 1"=5'

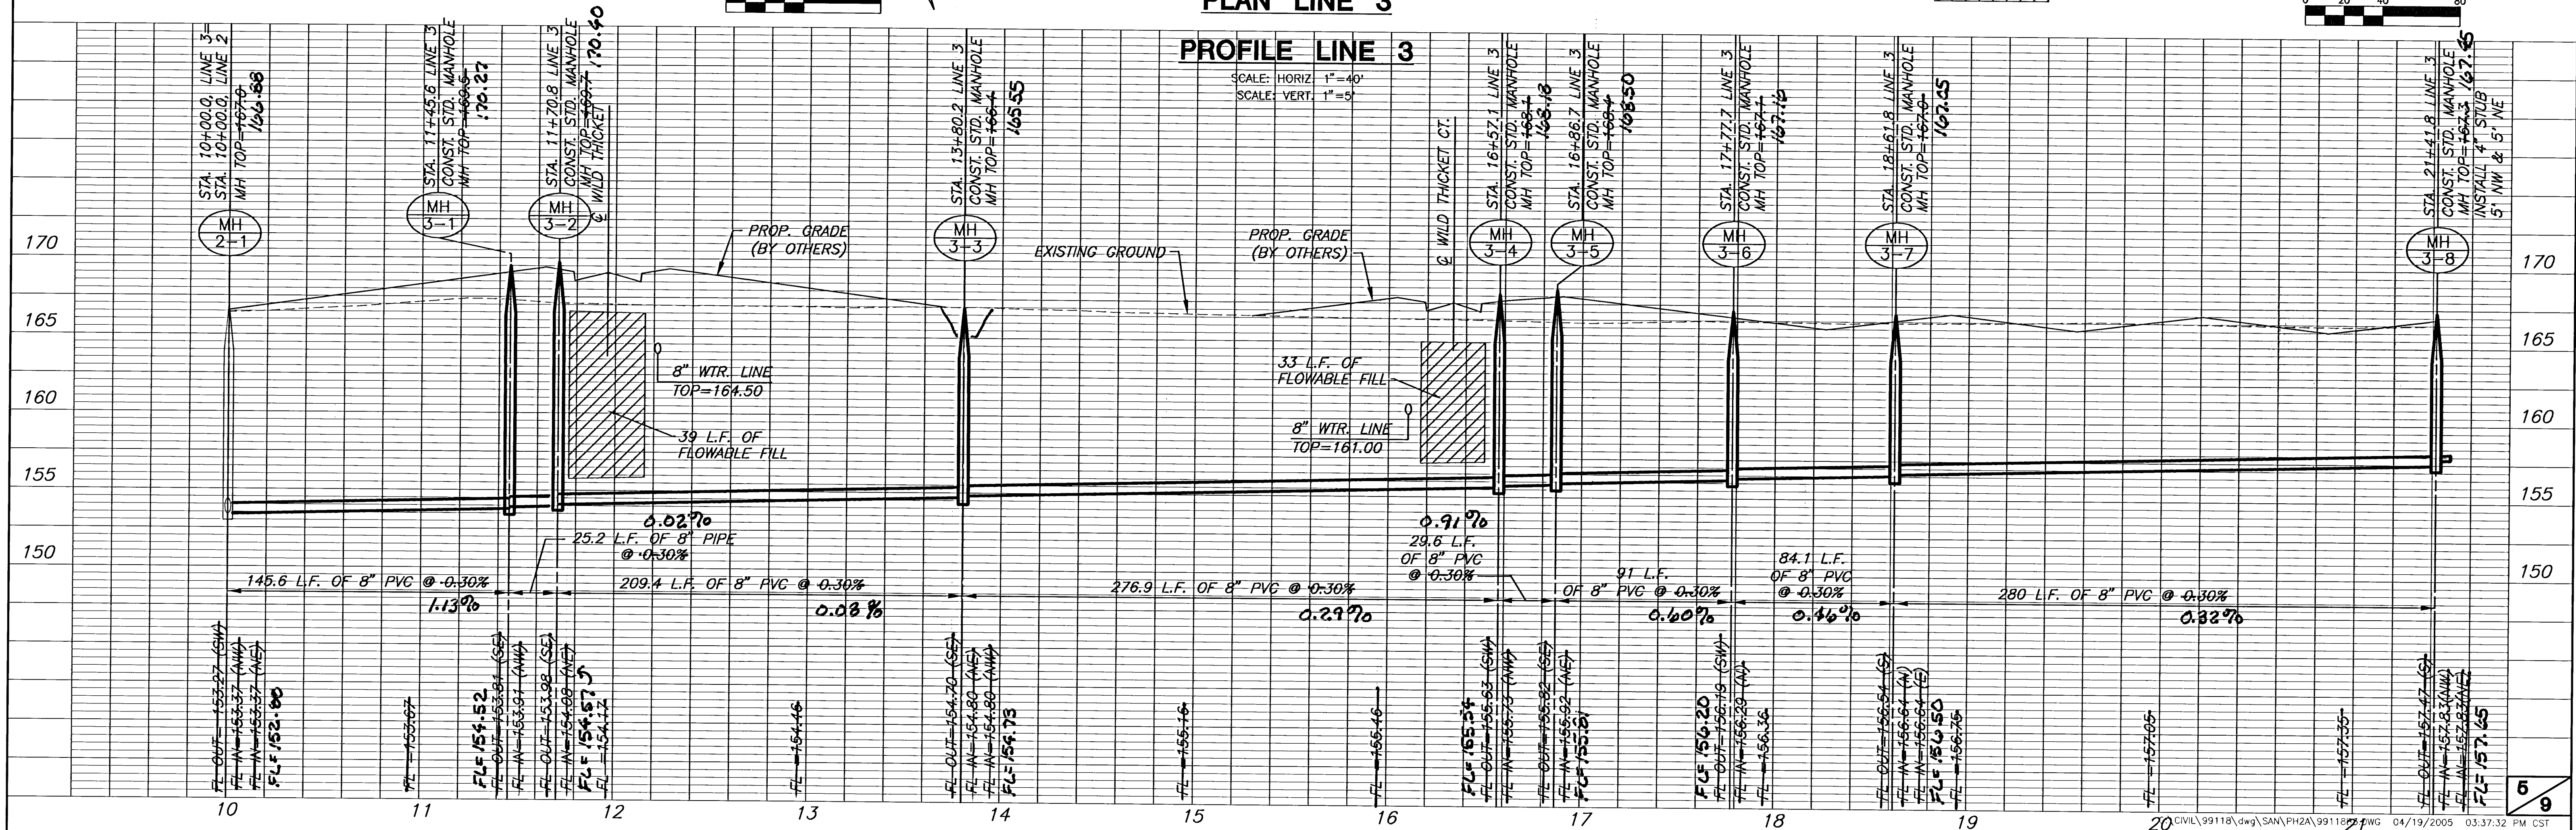

SCALE: 1"=40'
0 20 40 80

FLOWABLE FILL

