
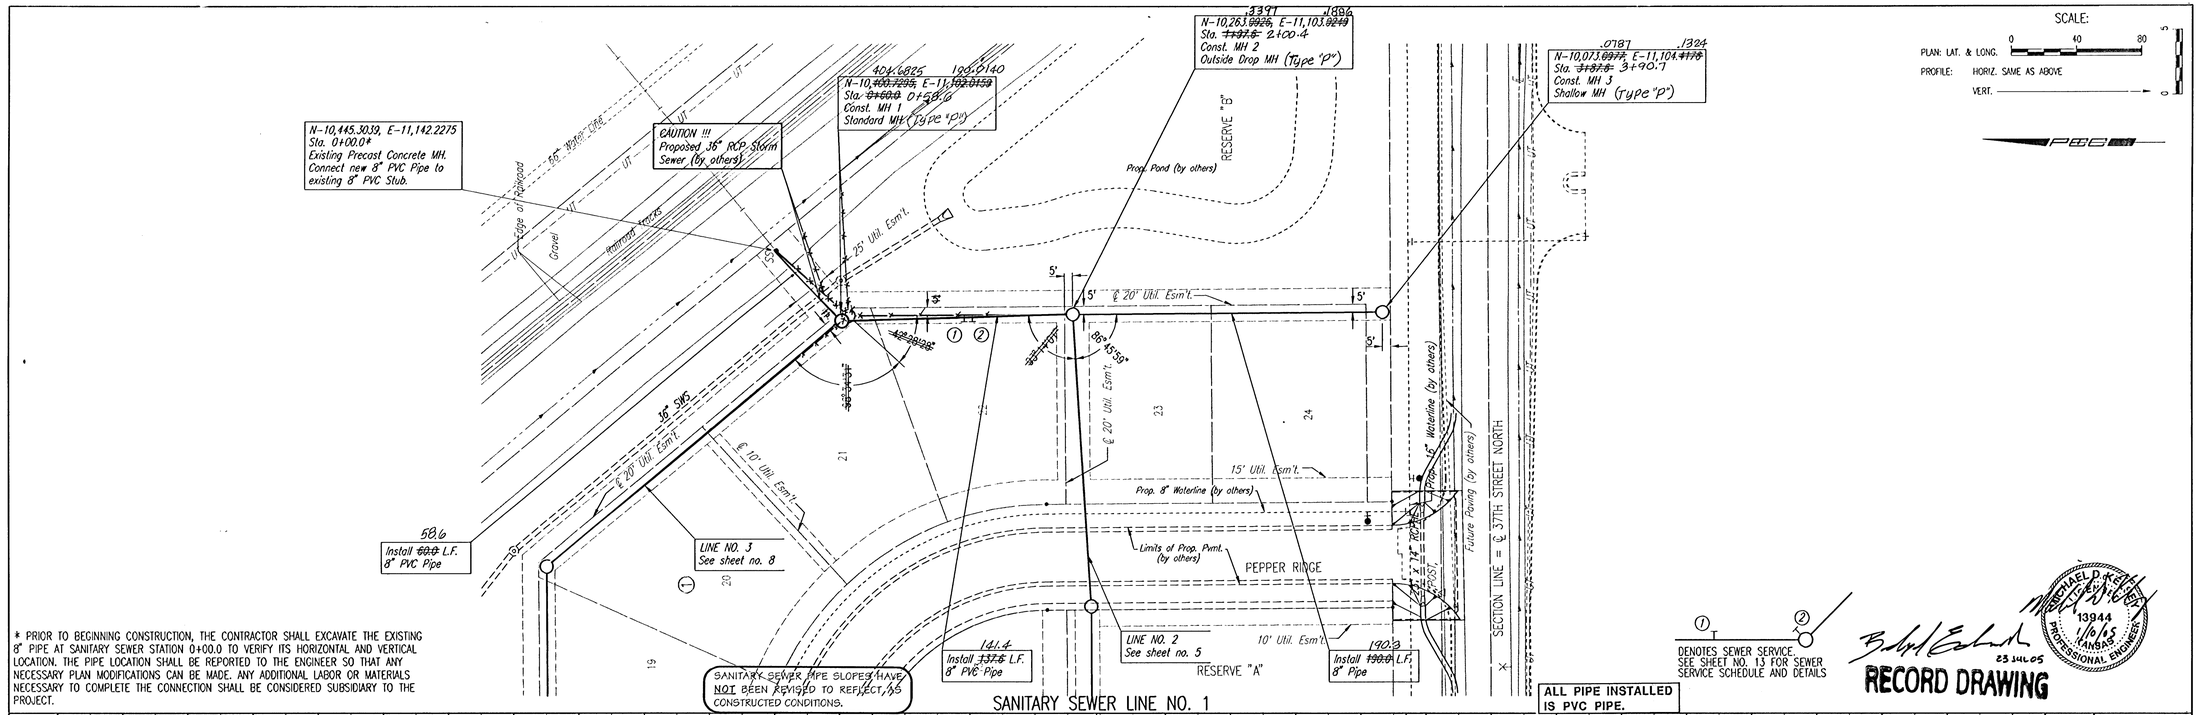


* PRIOR TO BEGINNING CONSTRUCTION, THE CONTRACTOR SHALL EXCAVATE THE EXISTING 8" PIPE AT SANITARY SEWER STATION 0+00.0 TO VERIFY ITS HORIZONTAL AND VERTICAL LOCATION. THE PIPE LOCATION SHALL BE REPORTED TO THE ENGINEER SO THAT ANY NECESSARY PLAN MODIFICATIONS CAN BE MADE. ANY ADDITIONAL LABOR OR MATERIALS NECESSARY TO COMPLETE THE CONNECTION SHALL BE CONSIDERED SUBSIDIARY TO THE PROJECT.

PLAN: BY | DATE | CHECKED | CHECKED

PROFILE: BY | DATE | CHECKED | CHECKED

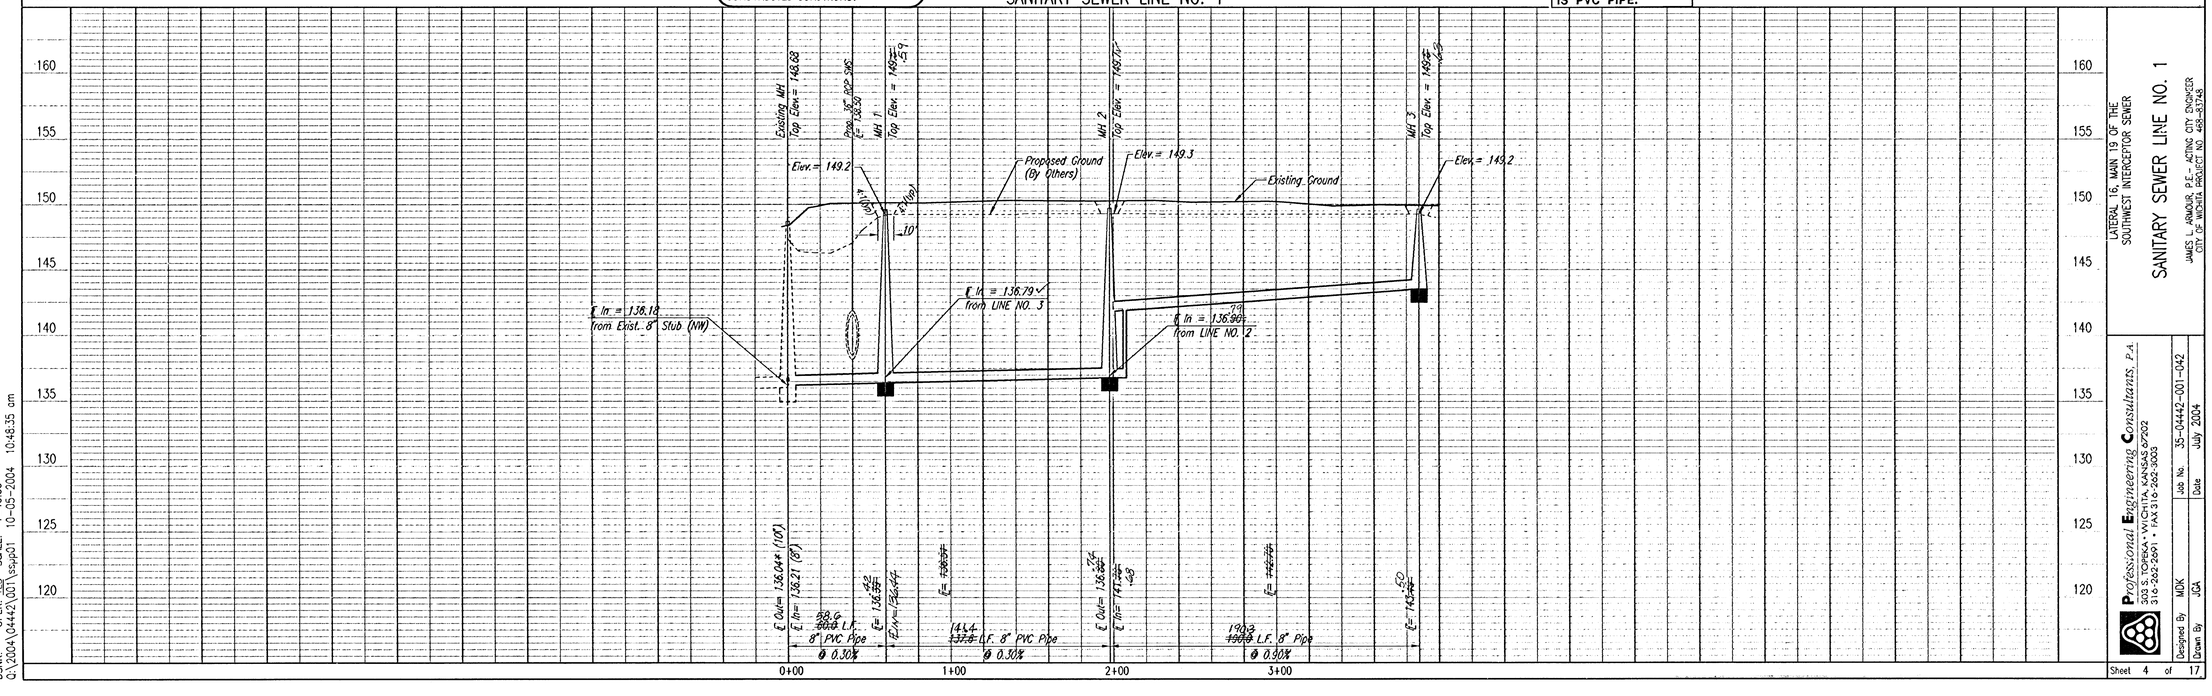

DSNG: OPER. TLS SCALE: 1=40.00
Q:\2004\04442\001\sspl01 10-05-2004 10:48:35 am

LATERAL 16, MAIN 19 OF THE SOUTHWEST INTERCEPTOR SEWER

SANITARY SEWER LINE NO. 1

JAMES L. ARMOUR, P.E. – ACTING CITY ENGINEER
CITY OF WICHITA PROJECT NO. 468-83748

Professional Engineering Consultants, P.A.
303 S. TOPEKA • WICHITA, KANSAS 67202
316-262-2691 • FAX 316-262-3003

Designed By	MDK	Job No.	35-04442-001-042
Drawn By	JDA	Date	July 2004