


PLAN	CHECKED	DATE

PROFILE	CHECKED	DATE

DSNR: OPER ILS SCALE: 1"=40.00
Q:\2004\0442\001\sspp02 10-05-2004 10:46:29 am

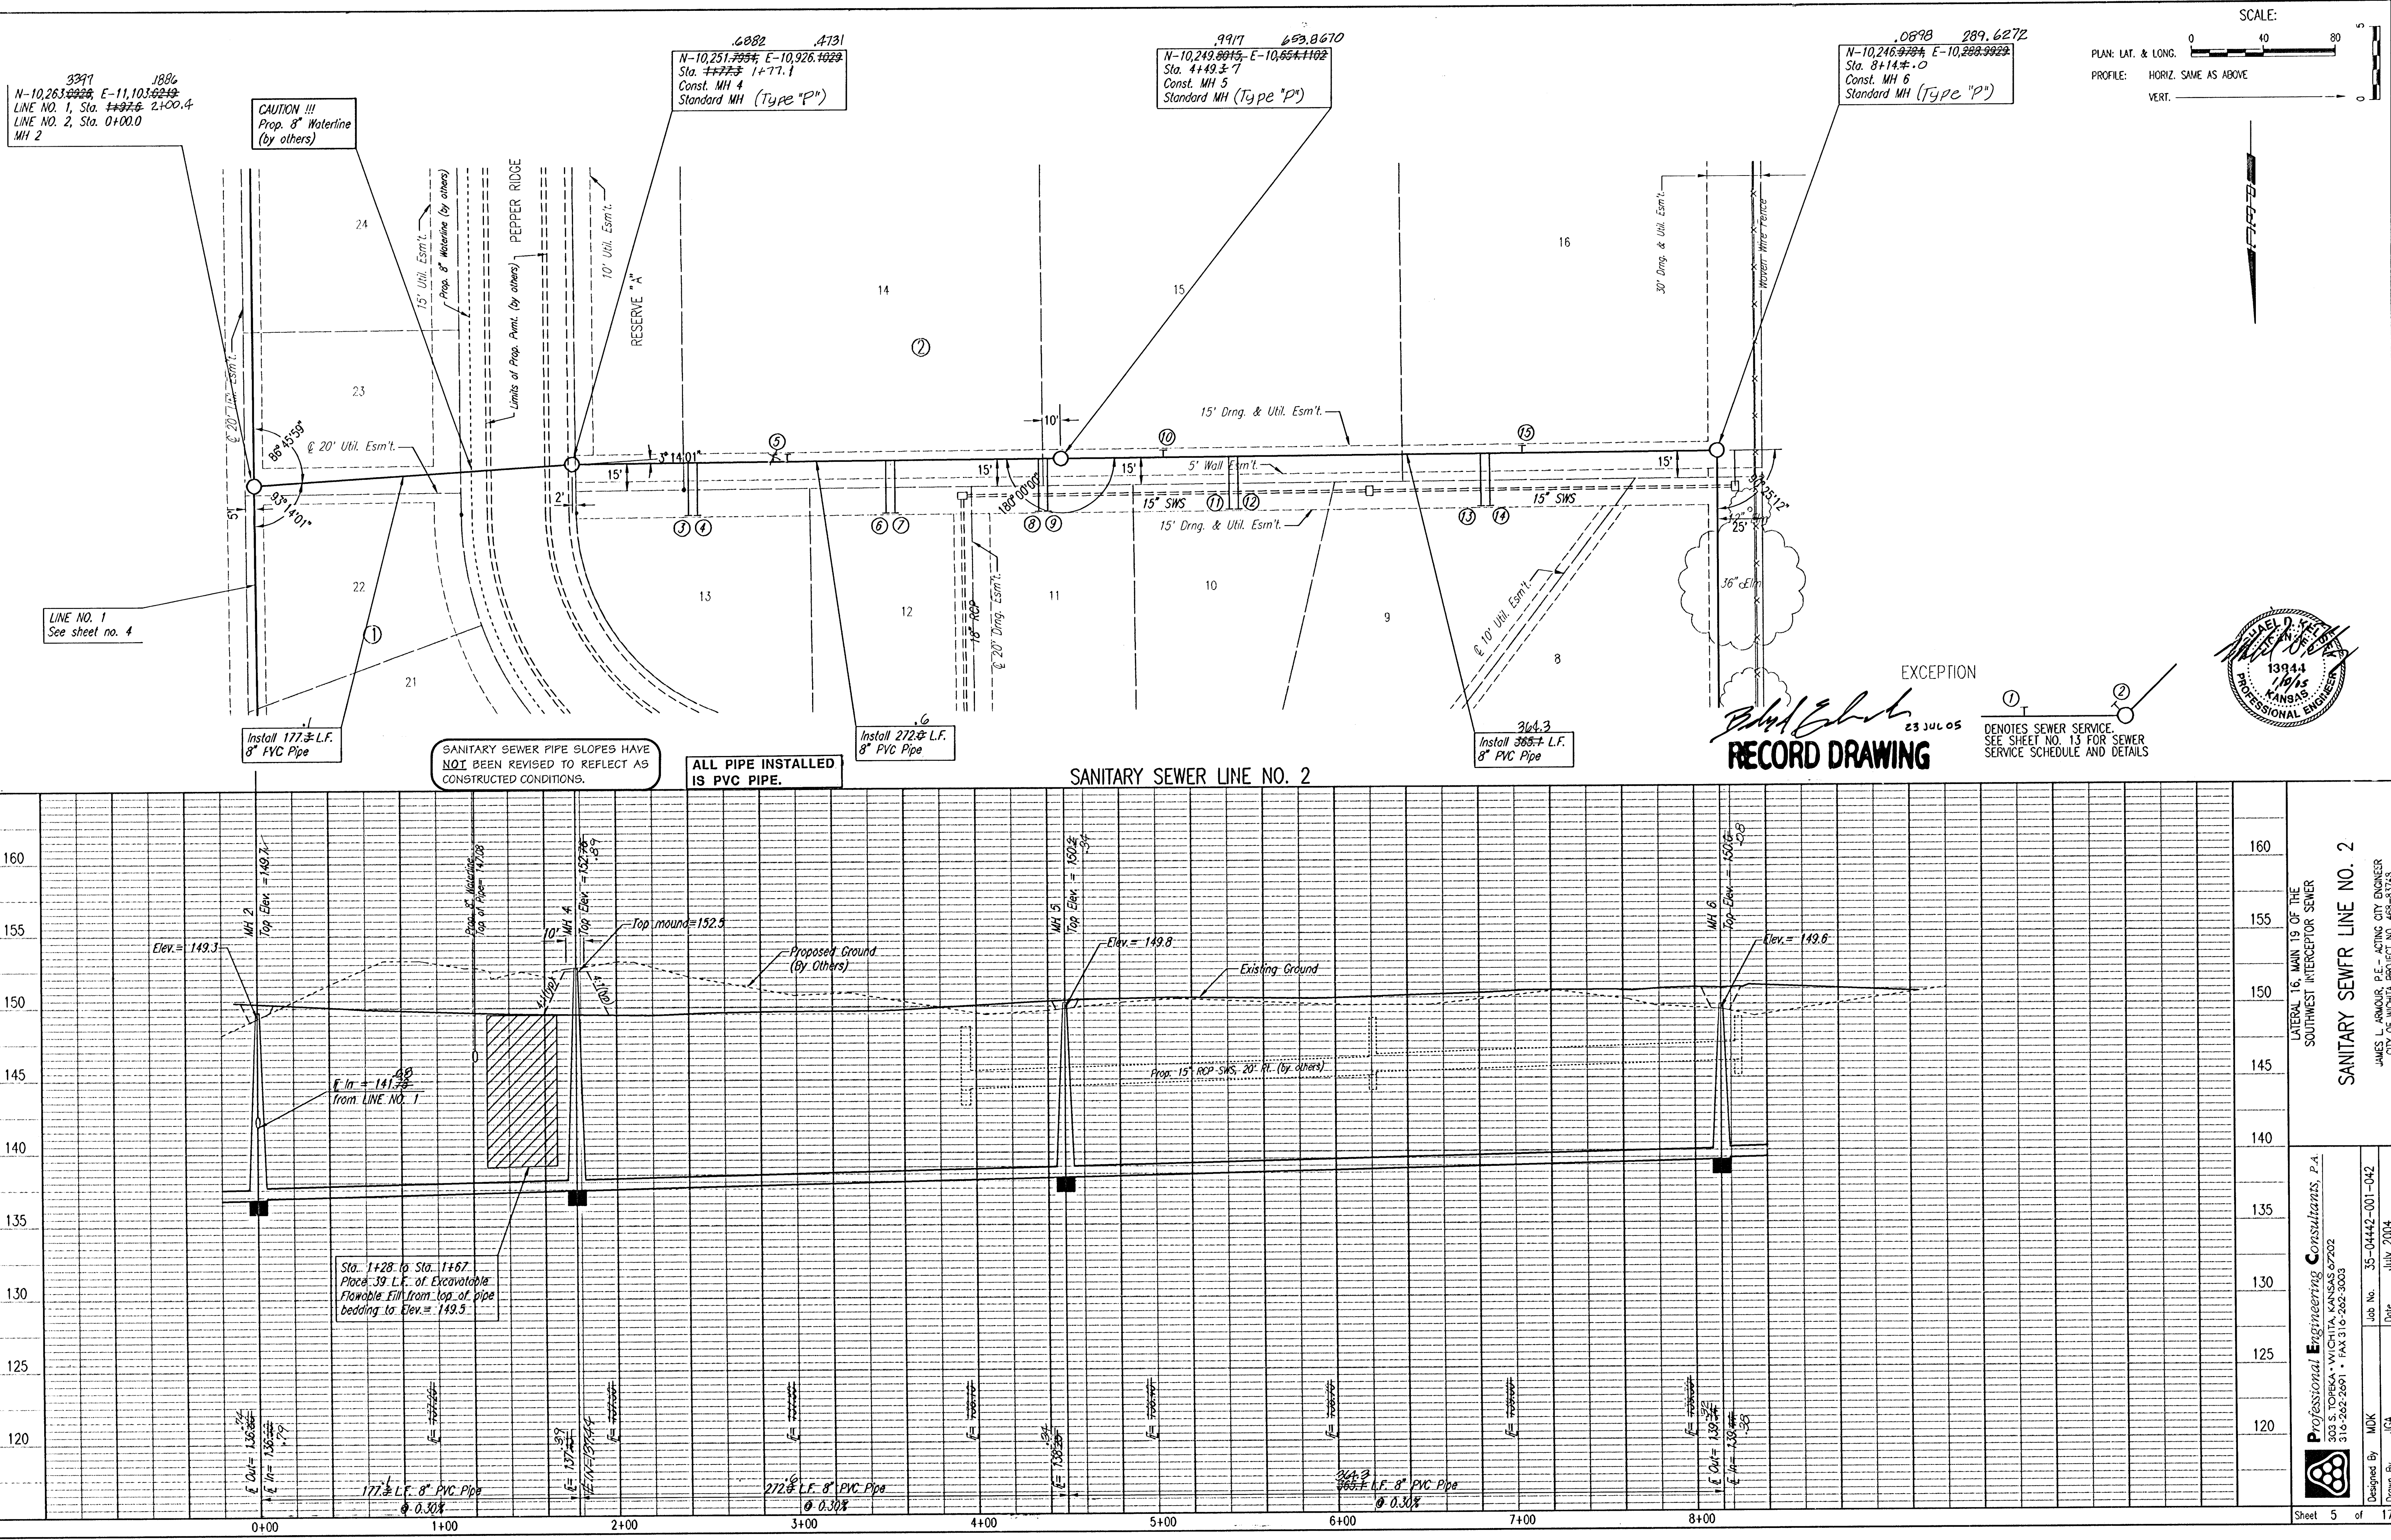

SCALE: 0 40 80
PLAN: LAT. & LONG.
PROFILE: HORIZ. SAME AS ABOVE
VERT. 0 10 20 30 40 50

EXCEPTION
23 JUL 05
DENOTES SEWER SERVICE. SEE SHEET NO. 13 FOR SEWER SERVICE SCHEDULE AND DETAILS

13944
10/15
KANSAS
PROFESSIONAL ENGINEER

LATERAL 16, MAIN 19 OF THE
SOUTHWEST INTERCEPTOR SEWER

SANITARY SEWER LINE NO. 2

JAMES L. ARMOUR, P.E. - ACTING CITY ENGINEER
CITY OF WICHITA PROJECT NO. 488-5725

Professional Engineering Consultants, P.A.
303 S. TOPEKA • WICHITA, KANSAS 67202
316-262-2691 • FAX 316-262-3003

Designed By: MDK
Drawn By: JCA
Job No.: 35-04442-001-042
Date: July 2004

Sheet 5 of 17