
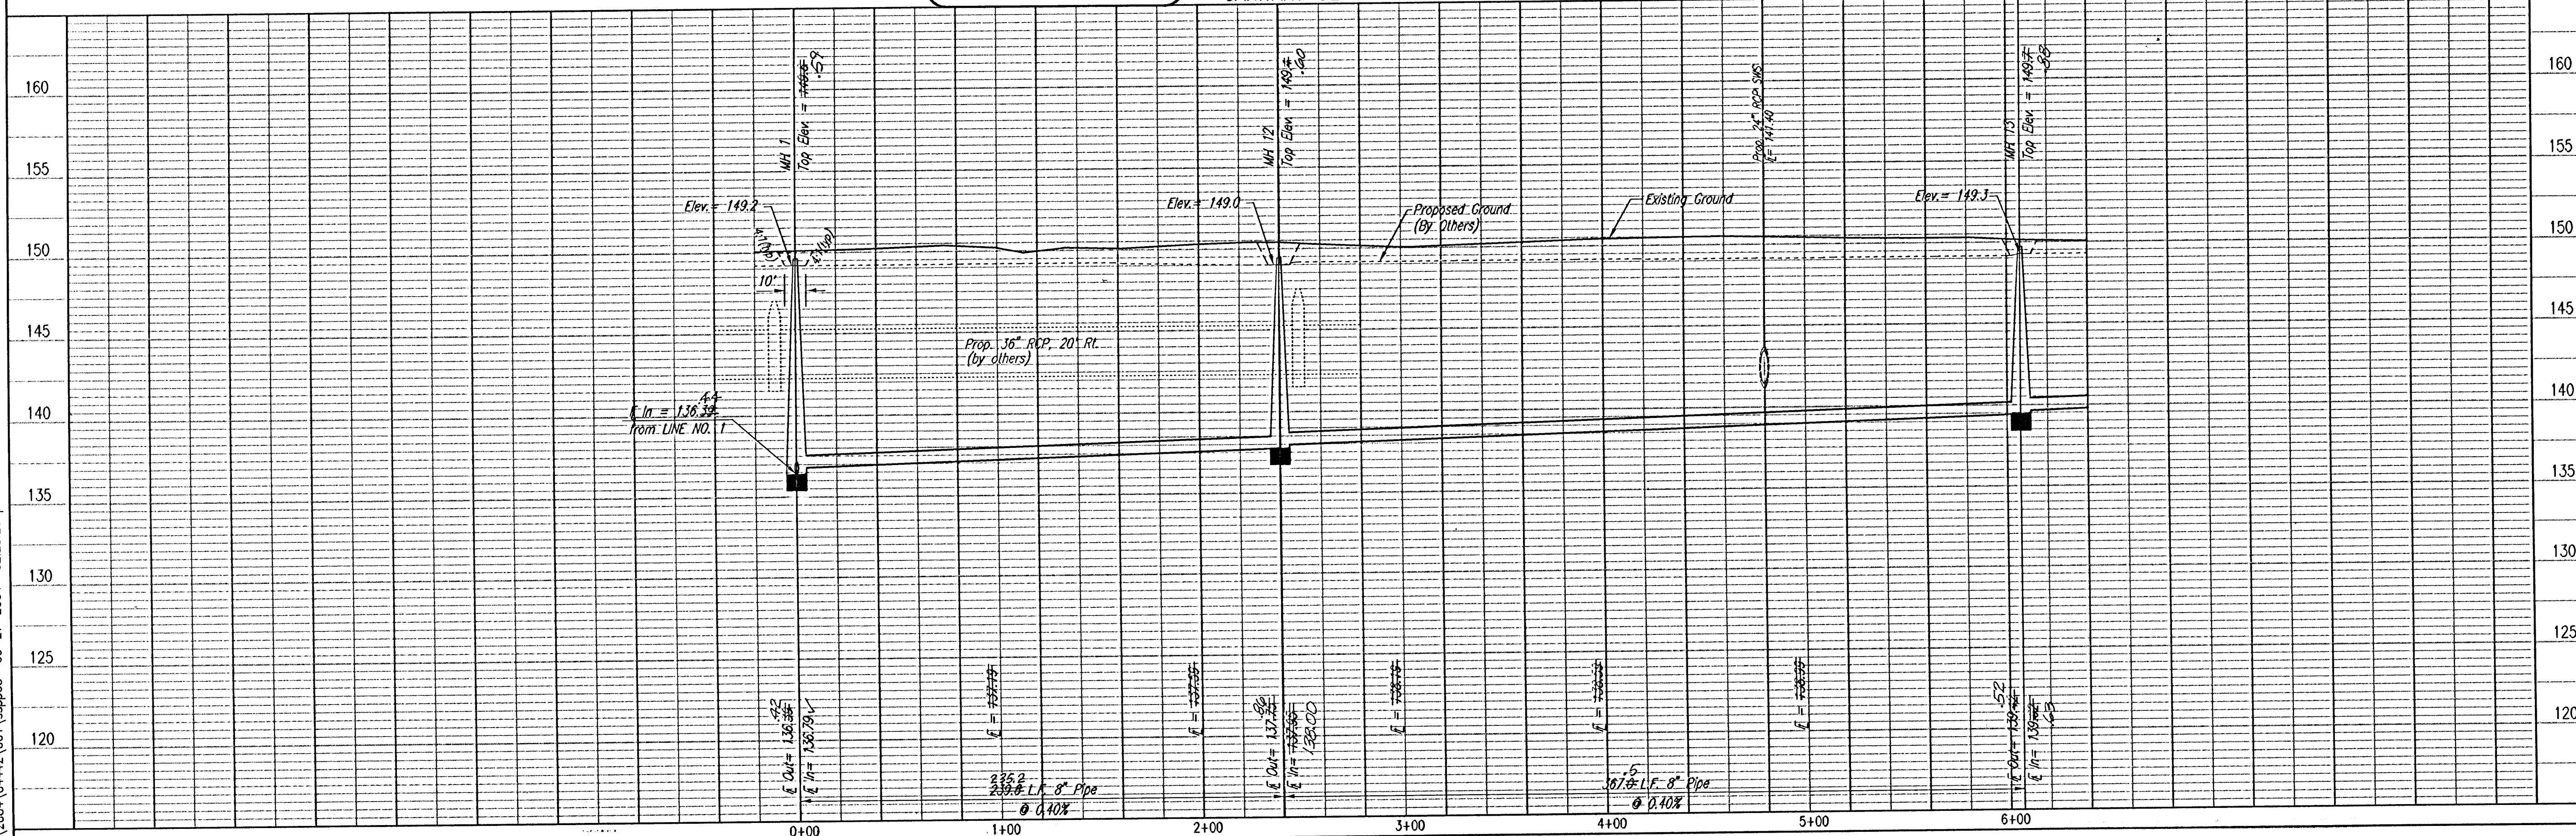


PROFILE	BY	DATE
CHECKED		
CHECKED		

OSNR: OPER: TLS SCALE: 1=40.00

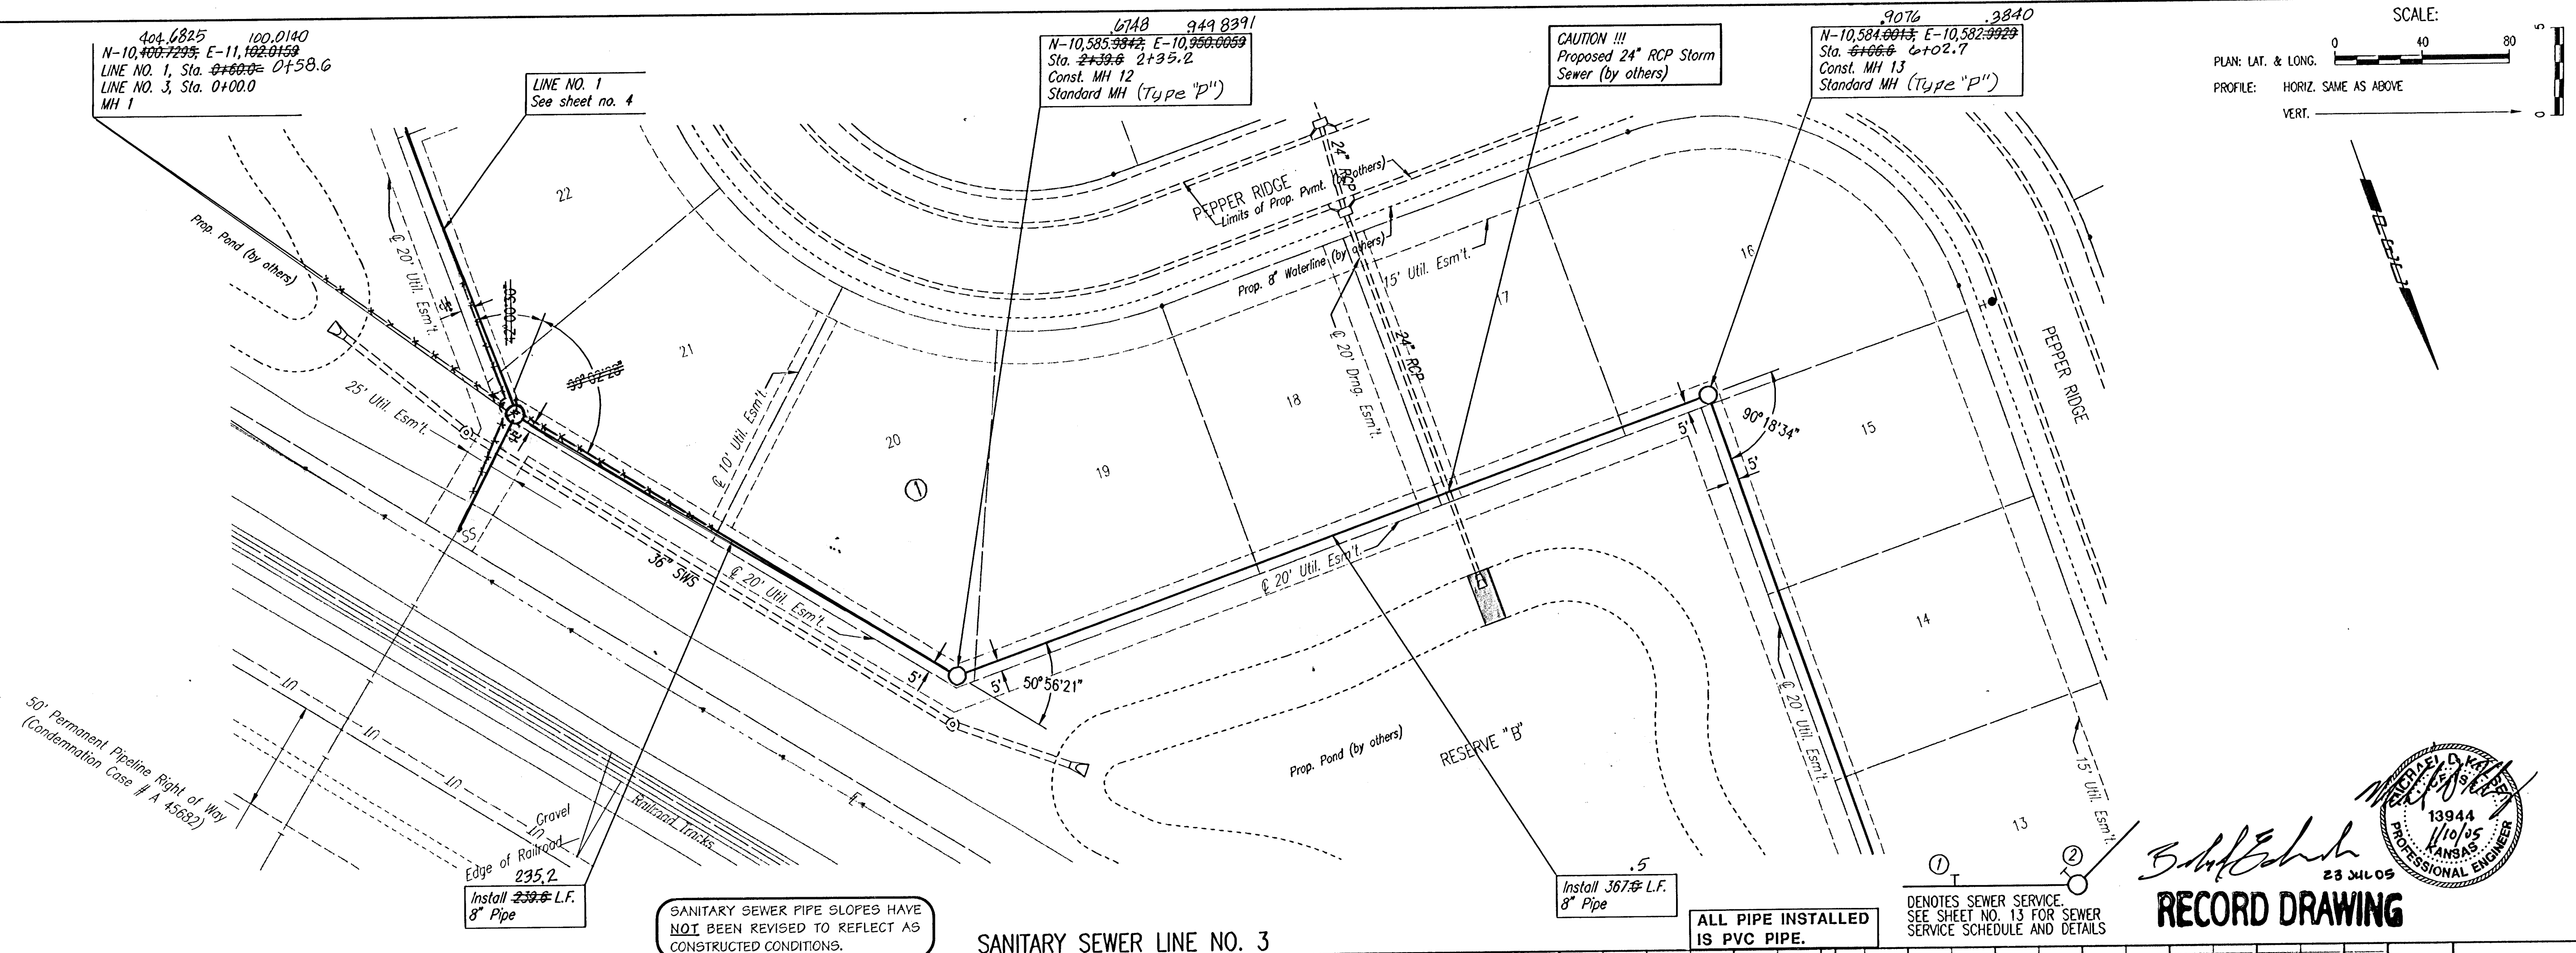

LATERAL 16, MAIN 19 OF THE

SANITARY SEWER LINE NO. 3

JAMES L. ARMOUR, P.E.—ACTING CITY ENGINEER

Professional Engineering Consultants, P.A.

303 S. TOPEKA • WICHITA, KANSAS 67202
316-262-2691 • FAX 316-262-3003

Designed By	MDK	Job No.	35-04442-001-042
-------------	-----	---------	------------------

Drawn By	JGA	Date	july 2004
----------	-----	------	-----------