RIGHT-OF-WAY VACATION EXHIBIT
SAND PLUM ADDITION
WICHITA, SEDGWICK COUNTY, KANSAS

SCALE

50 0 50 100

LEGEND

=Right-of-Way to be Vacated

= Proposed Right-of-Way

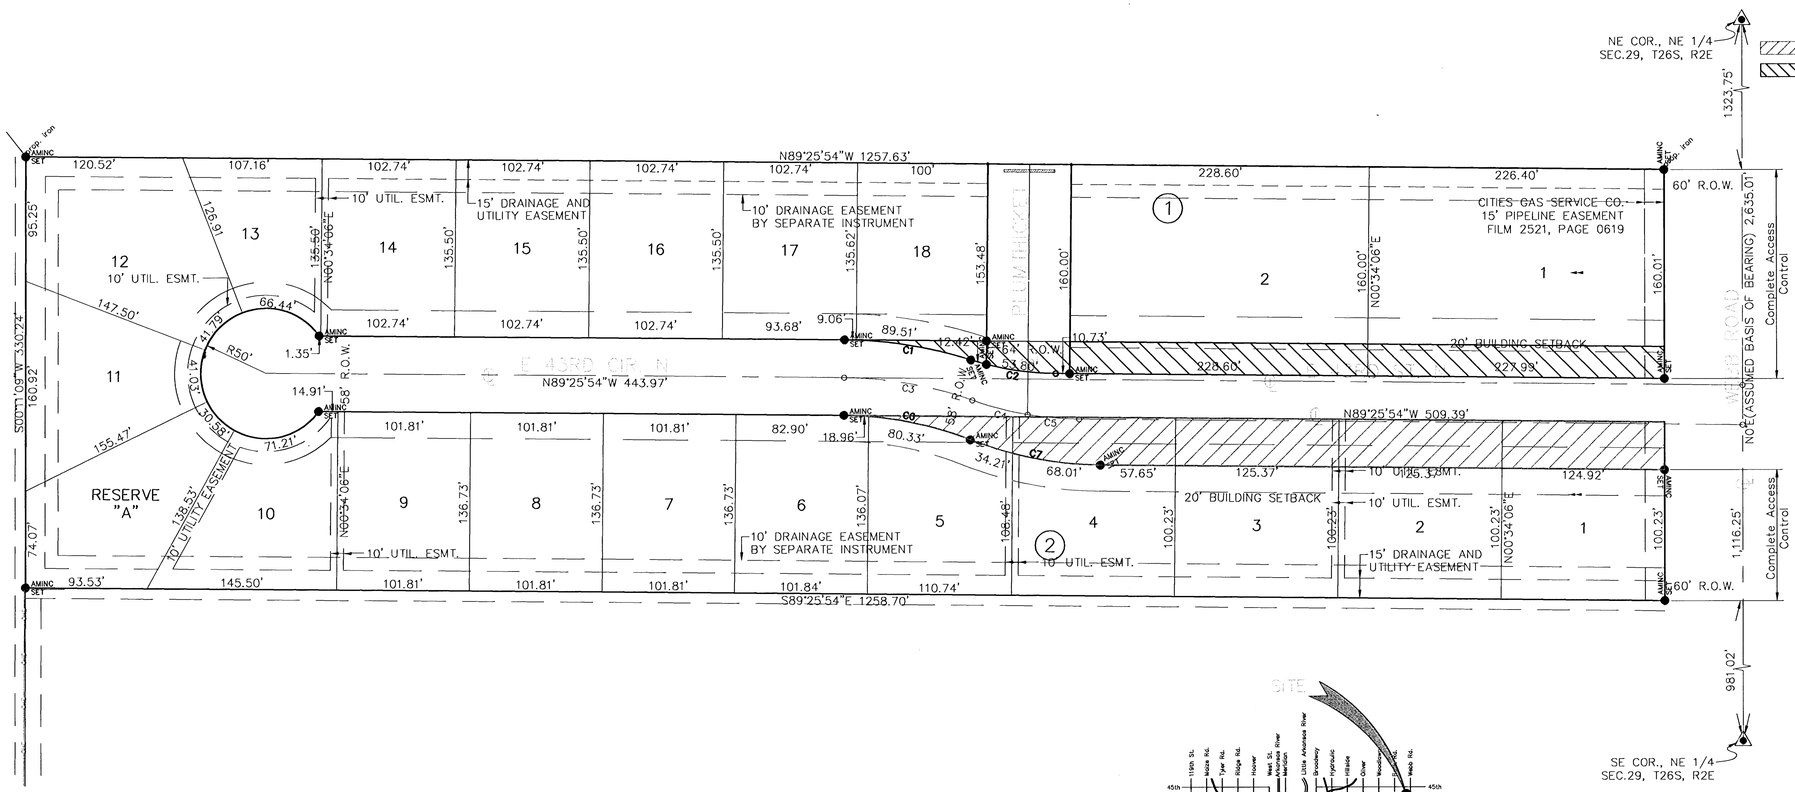

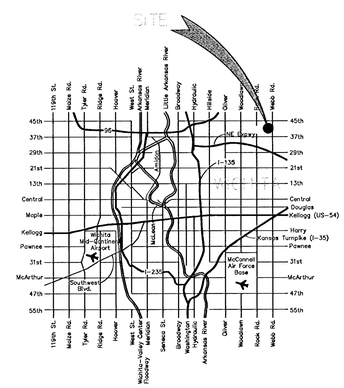

VICINITY MAP

FILENAME: 02153-02/vacate

AM CONSULTING Inc.
ENGINEERING SERVICES
142 N. Emporia Wichita, KS 67202
316/265-2870 fax: 316/265-2839

© AM Consulting, Inc.

01-20-11-AT

121\02153\02153-05\35_pav-vacate.dwg Wed Jan 05 08:18:07 2005 Steve Schmidt-Pop & Associates of Kansas, Inc.