



HAWTHORNE PHASE 1
STORM WATER SEWER PLANS
PLAN AND PROFILE

HAWTHORNE THIRD ADDITION

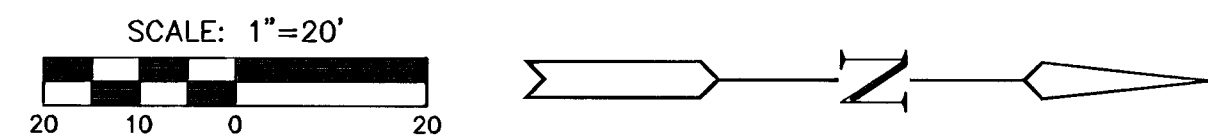

HAWTHORNE THIRD ADDITION

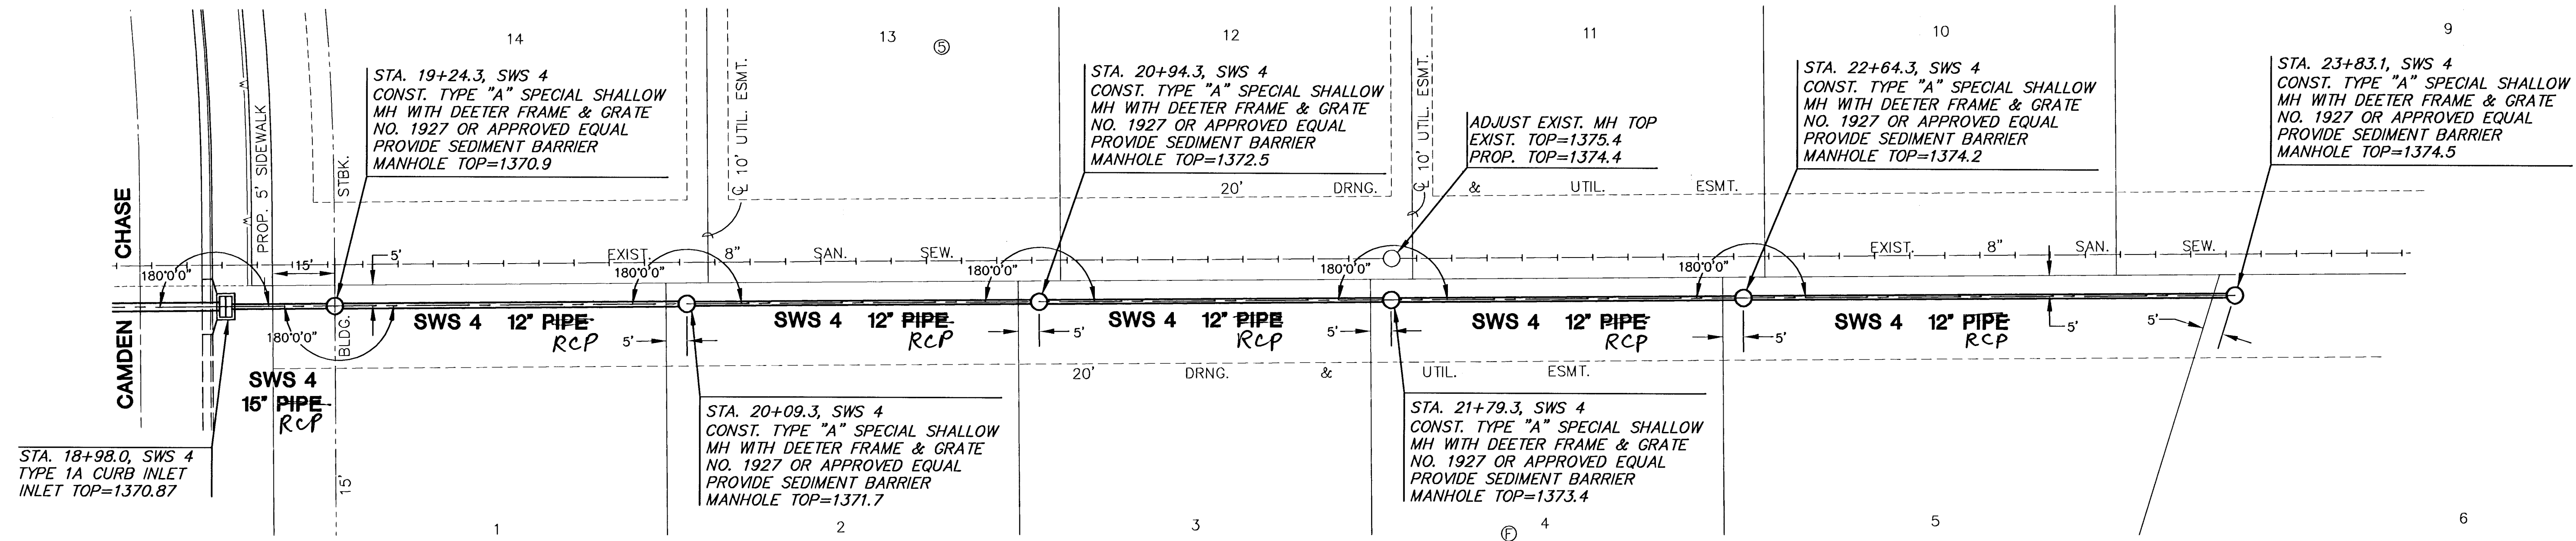