
HAWTHORNE PHASE 1
STORM WATER SEWER PLANS
PLAN AND PROFILE

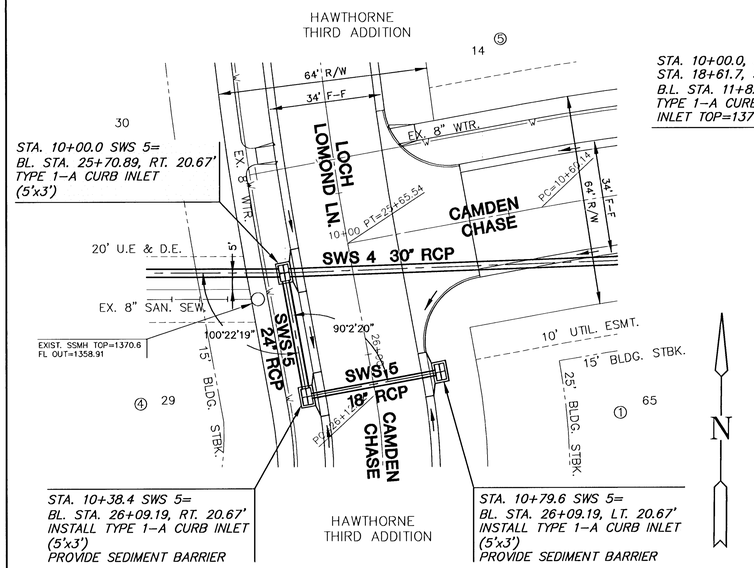


= FLOWABLE FILL

PLAN SWS 5

SCALE: 1"=20'

SCALE: 1"=20'

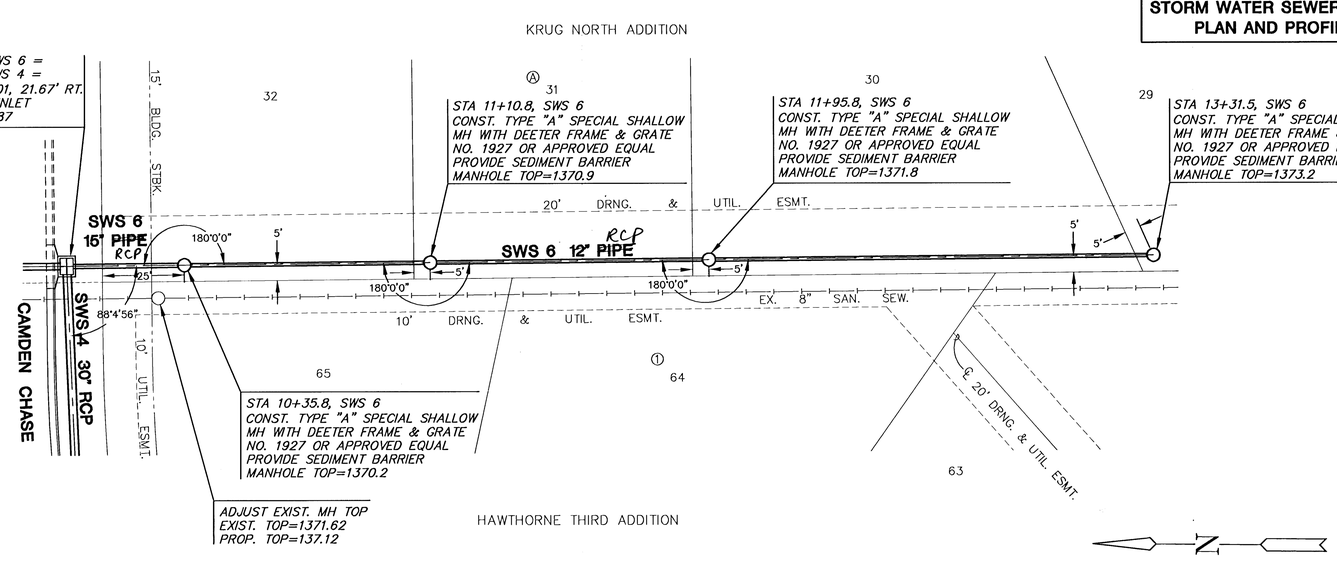


PLAN SWS 6

SCALE: 1"=20'

PROFILE SWS 5

SCALE: HORIZ. 1"=20'
SCALE: VERT. 1"=5'

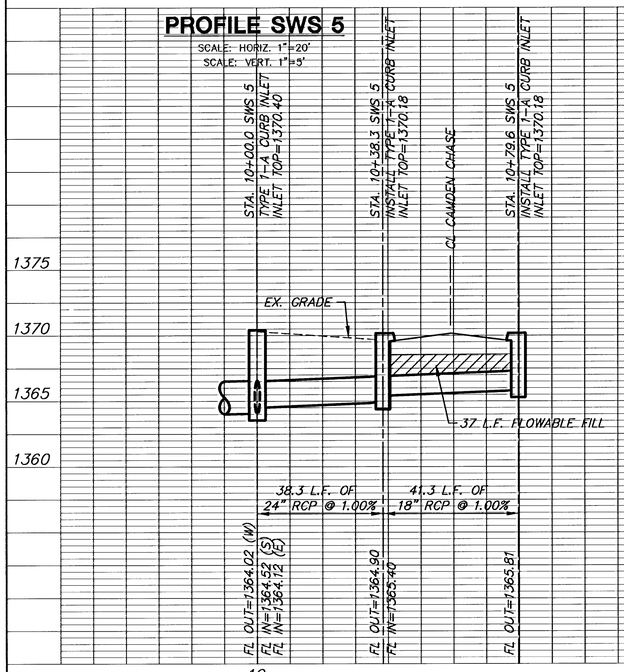

PROFILE SWS 6

SCALE: HORIZ. 1"=20'
SCALE: VERT. 1"=5'

