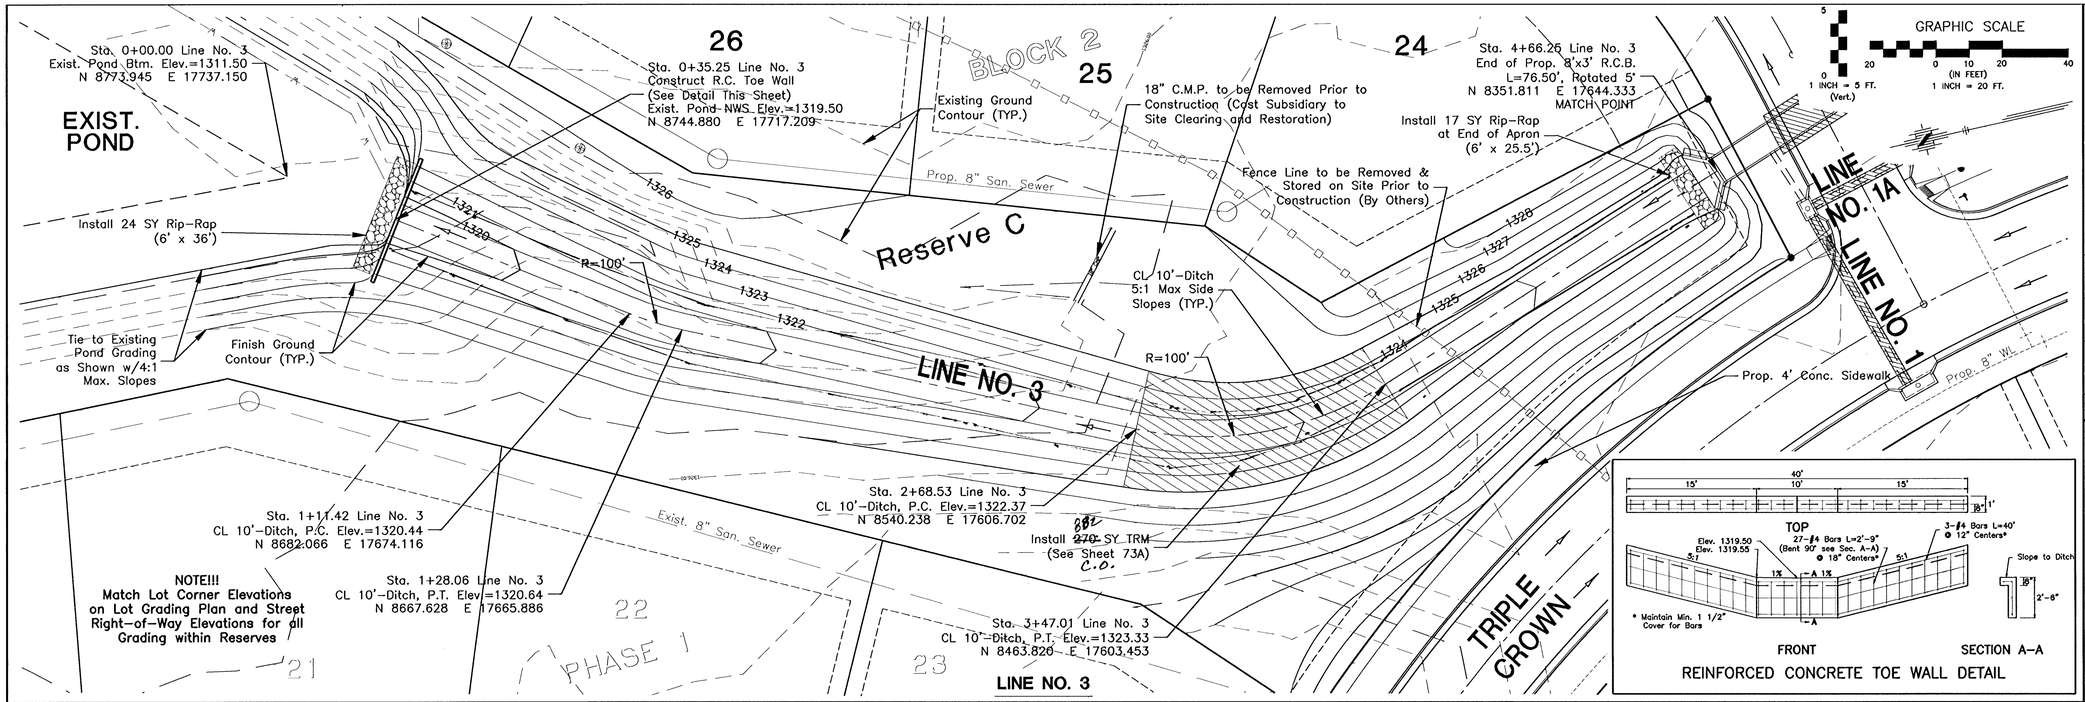

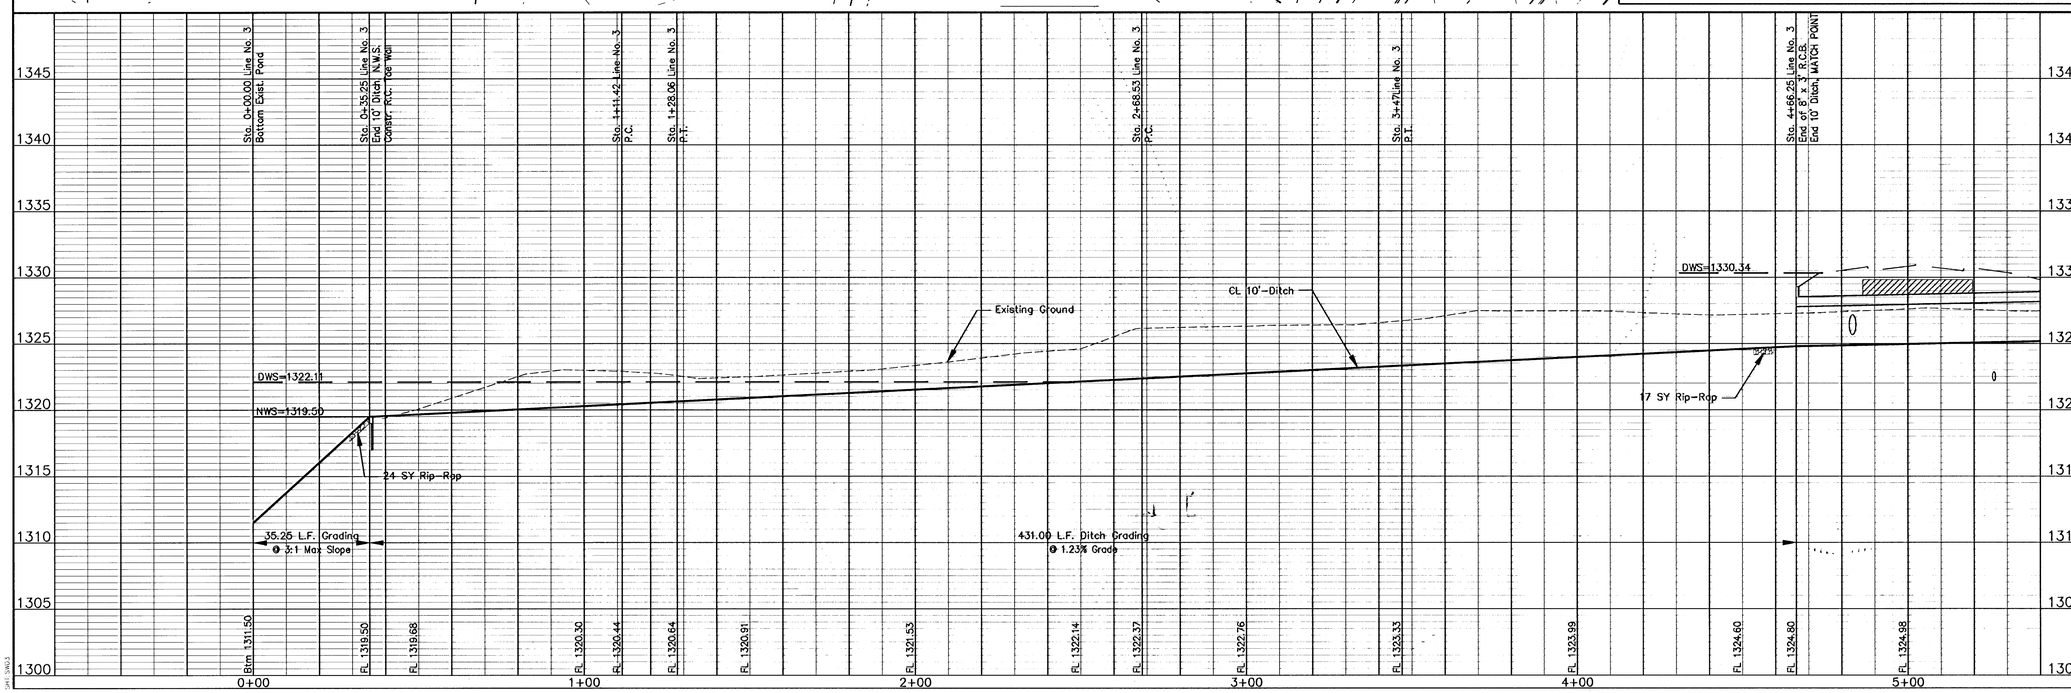

No.	Date	By	Approved	Revision

EQUESTRIAN ESTATES ADDITION - PHASE 2
STORM WATER SEWER
LINE NUMBER 3

CITY OF WICHITA, KANSAS
JAMES L. ARNOLD, P.E. - CITY ENGINEER
C.O.W. Proj.# 472-85430 C.O.K.# 765869

POE & ASSOCIATES, INC.
CONSULTING ENGINEERS
39940 E. Central, Suite 200 ■ Wichita, KS 67208-4242
Phone 316/685-4111 ■ FAX 316/685-4444

FINAL

Designed By: JMU/JPD
Drawn By: JPD
Poe Job No.: 1694J
Date: January 2006

Sheet 16 of 78