


BASE BID

REMOVE EXISTING ASPH. PAVEMENT
INSIDE OF THE FENCE IN COURTS 2,3,4.
CONSTRUCT 3" ASPH. ON 4" REINFORCED CRUSHED ROCK.
INSTALL 3, 4" DIA PERFORATED PIPE.

ADD ALTERNATE #1

ADD EXTRA 1" ASPH. TO THE BASE BID. THE COST OF
EXTRA EXCAVATION FOR THIS ADDITIONAL 1" ASPH. IS
SUBSIDIARY TO THE OTHER BID ITEMS.

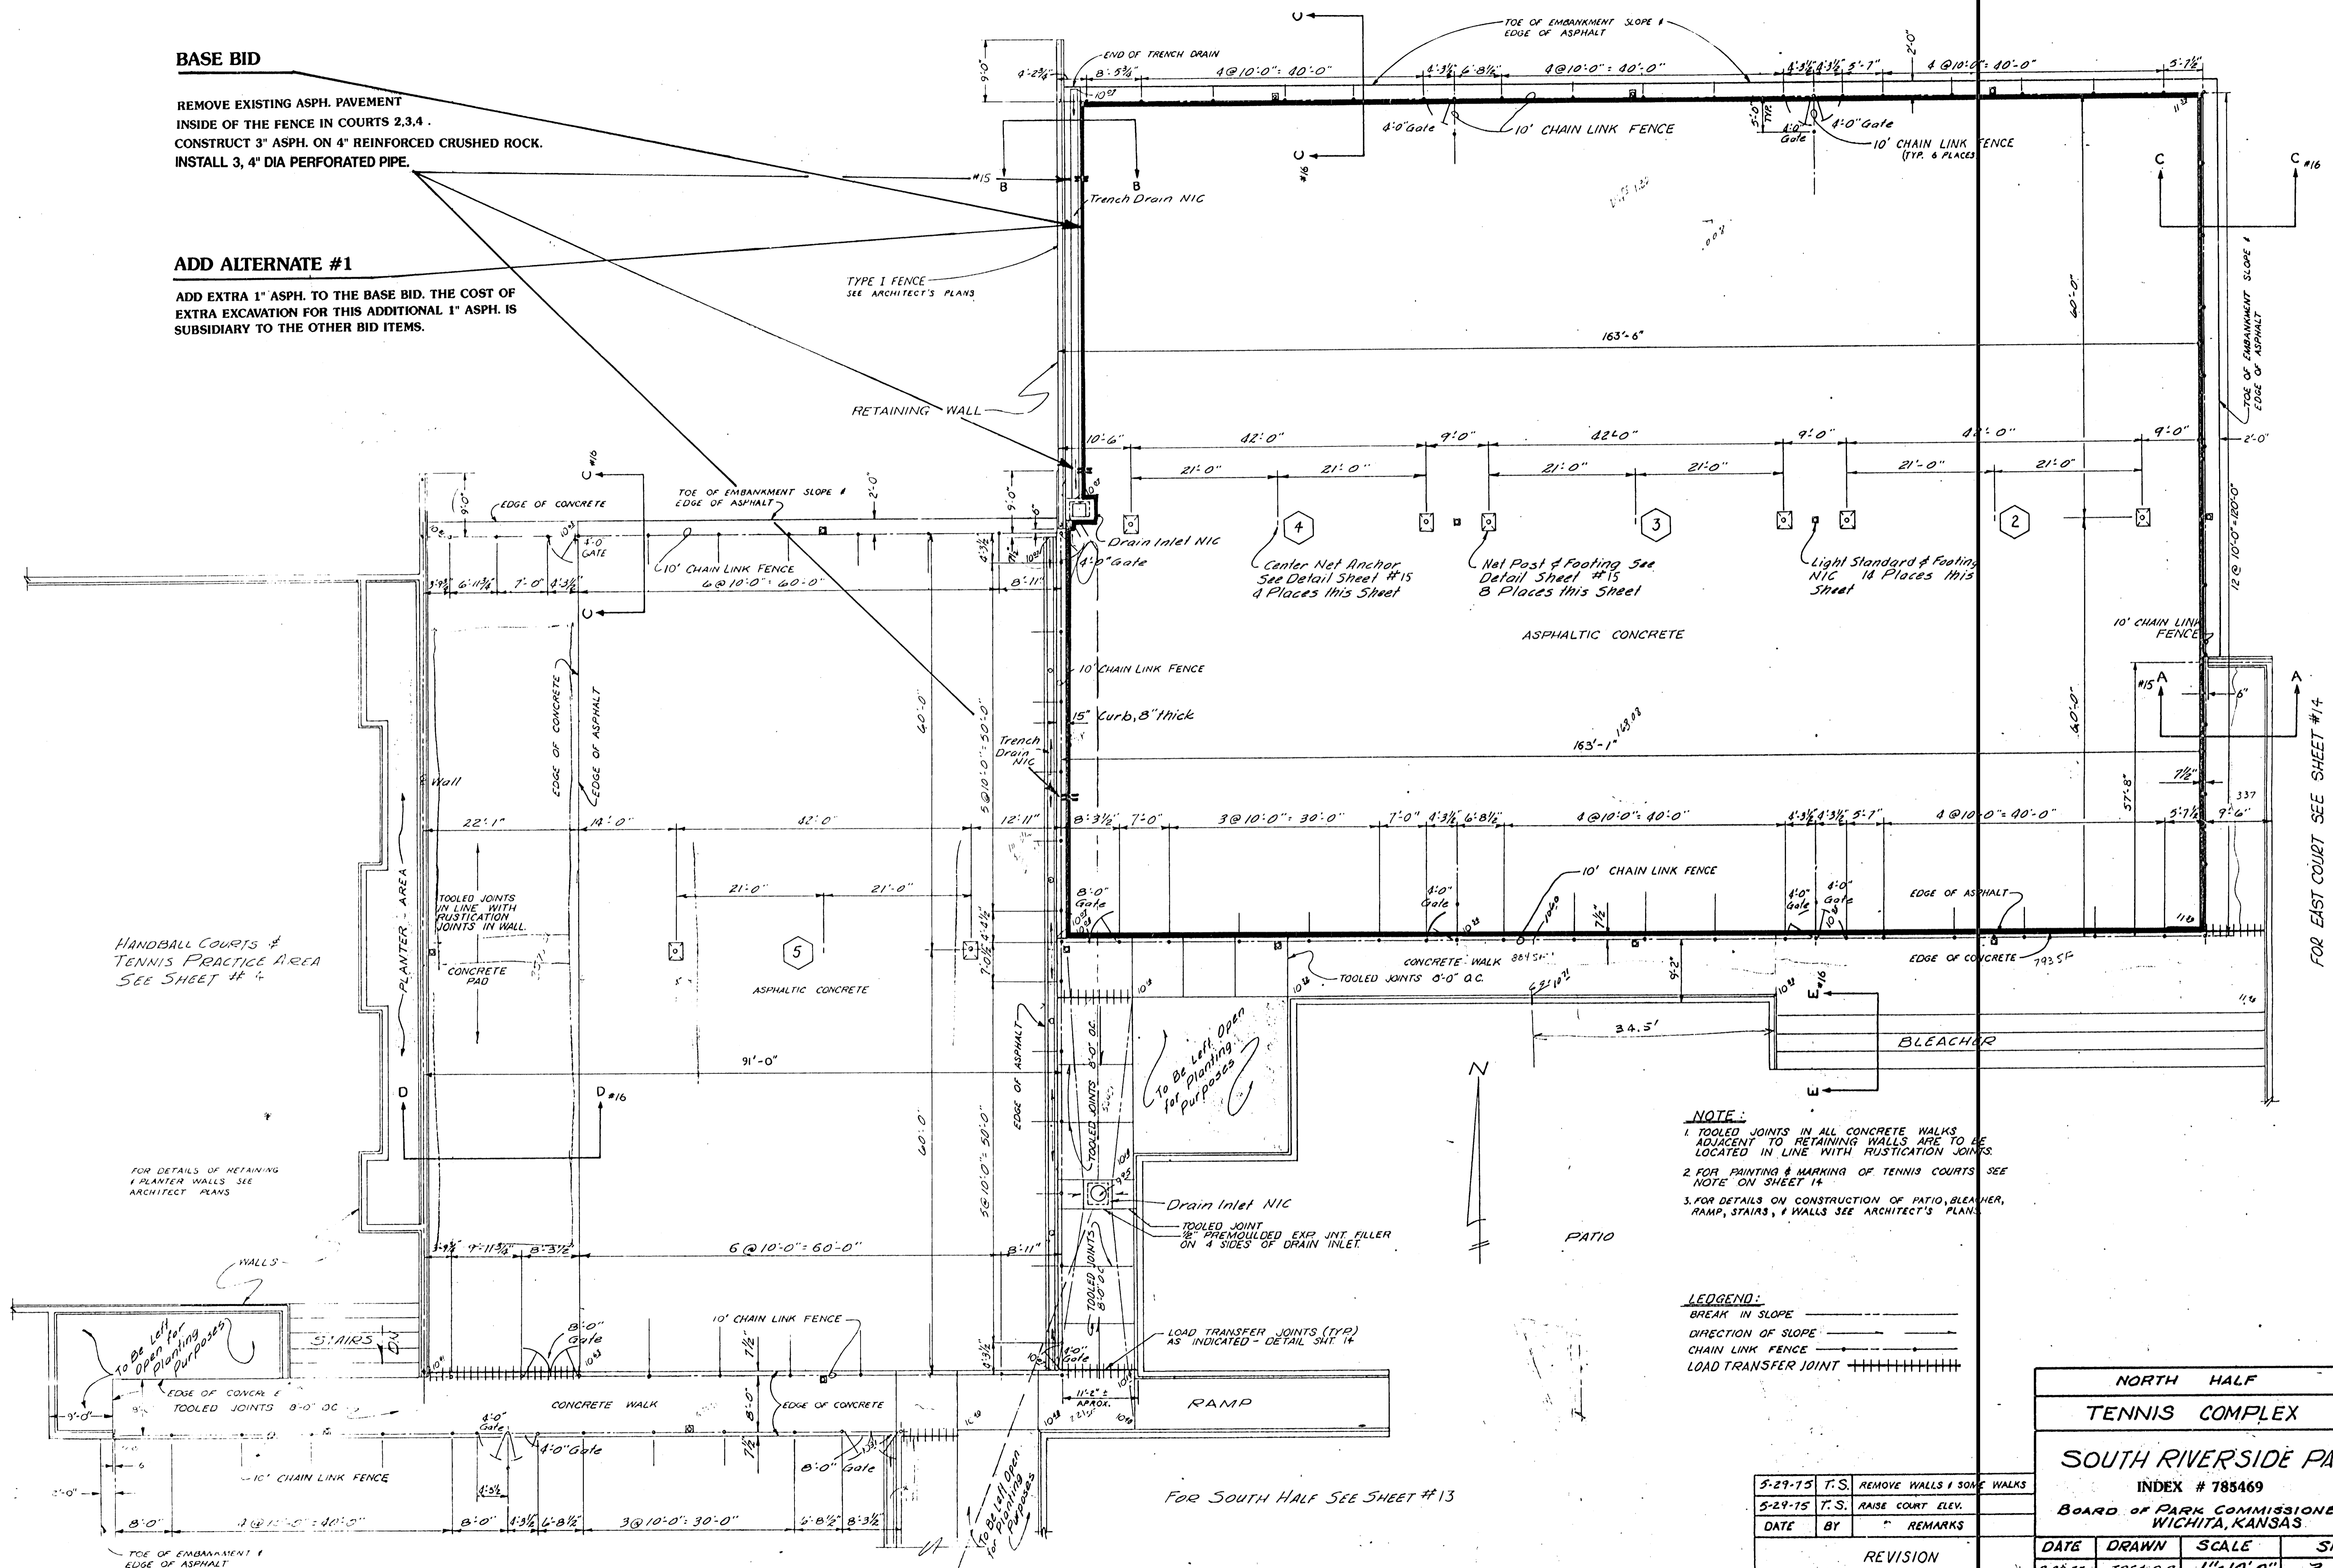

NOTE:
1. TOOLED JOINTS IN ALL CONCRETE WALKS
ADJACENT TO RETAINING WALLS ARE TO BE
LOCATED IN LINE WITH RUSTICATION JOINTS
2. FOR PAINTING & MARKING OF TENNIS COURTS SEE
NOTE ON SHEET 14
3. FOR DETAILS ON CONSTRUCTION OF PATIO, BLEACHER,
RAMP, STAIRS, & WALLS SEE ARCHITECT'S PLANS.

LEGEND:
BREAK IN SLOPE
DIRECTION OF SLOPE
CHAIN LINK FENCE
LOAD TRANSFER JOINT

NORTH HALF	
TENNIS COMPLEX	
SOUTH RIVERSIDE PARK	
INDEX # 785469	
BOARD OF PARK COMMISSIONERS WICHITA, KANSAS	
DATE	DRAWN
2-28-75	TGF D.R.
SCALE	SHEET
1"=10'-0"	3 of 6

5-29-75	T.S.	REMOVE WALLS & SOME WALKS
5-29-75	T.S.	RAISE COURT ELEV.
DATE	BY	REMARKS
REVISION		

FOR SOUTH HALF SEE SHEET #13

FOR EAST COURT SEE SHEET #14