


[illegible]

TRAFFIC SIGN INSTALLATION DETAIL
FOR SIGNS NOT GREATER THAN 12" WIDE

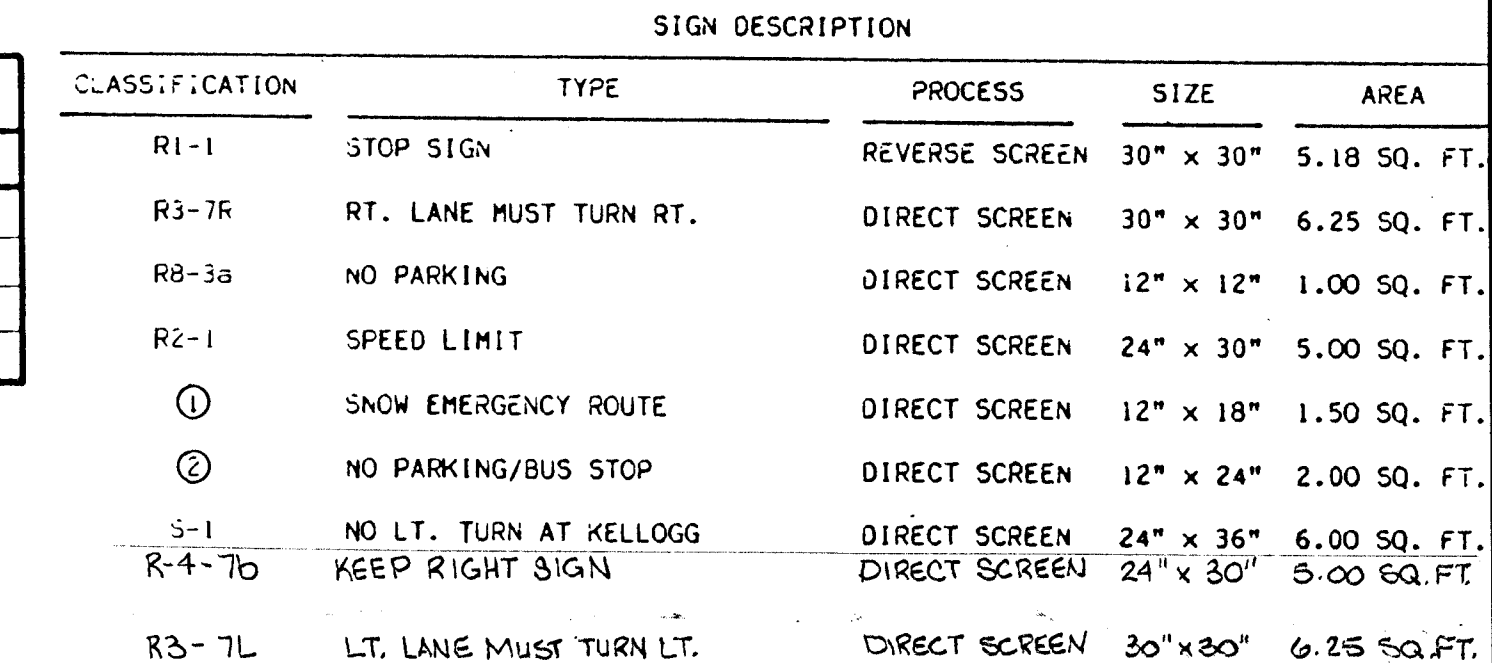


SUMMARY OF QUANTITIES		
BID ITEMS	TOTAL	UNIT
<i>Signing</i>	<i>Lump Sum</i>	<i>L.S.</i>

PAVEMENT INSTALLATION SEQUENCE

1. SIGN POST ANCHOR DRIVEN INTO SUBGRADE PRIOR TO THE PLACEMENT OF THE PAVEMENT.
2. ANCHOR SLEEVE DRIVEN INTO SUBGRADE OVER THE SIGN POST ANCHOR PRIOR TO THE PLACEMENT OF THE PAVEMENT.
3. INSERT SIGN POST INTO THE SIGN POST ANCHOR AND BOLT IN PLACE.

GROUND INSTALLATION SEQUENCE

1. SIGN POST ANCHOR DRIVEN INTO THE GROUND.
2. ANCHOR SLEEVE DRIVEN INTO THE GROUND OVER THE SIGN POST ANCHOR.
3. INSERT SIGN POST INTO THE SIGN POST ANCHOR AND BOLT IN PLACE.

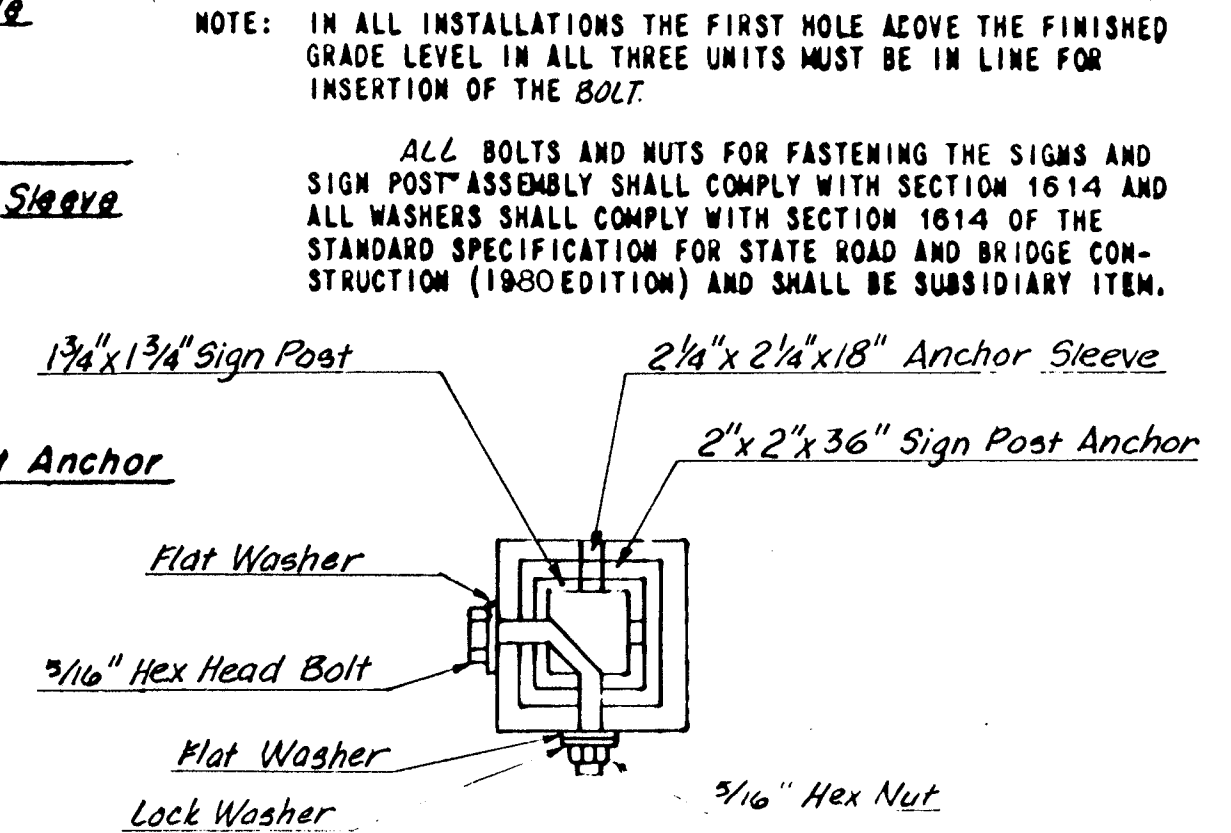

SECTION A-A
BREAK-AWAY SIGN POST DETAIL

WICHITA, KANSAS			
SIGNING DETAILS			
JOB NO.	DATE:	CHKD:	
SCALE: <i>None</i>	DRAWN:	APPRD:	SK 18 of 27