
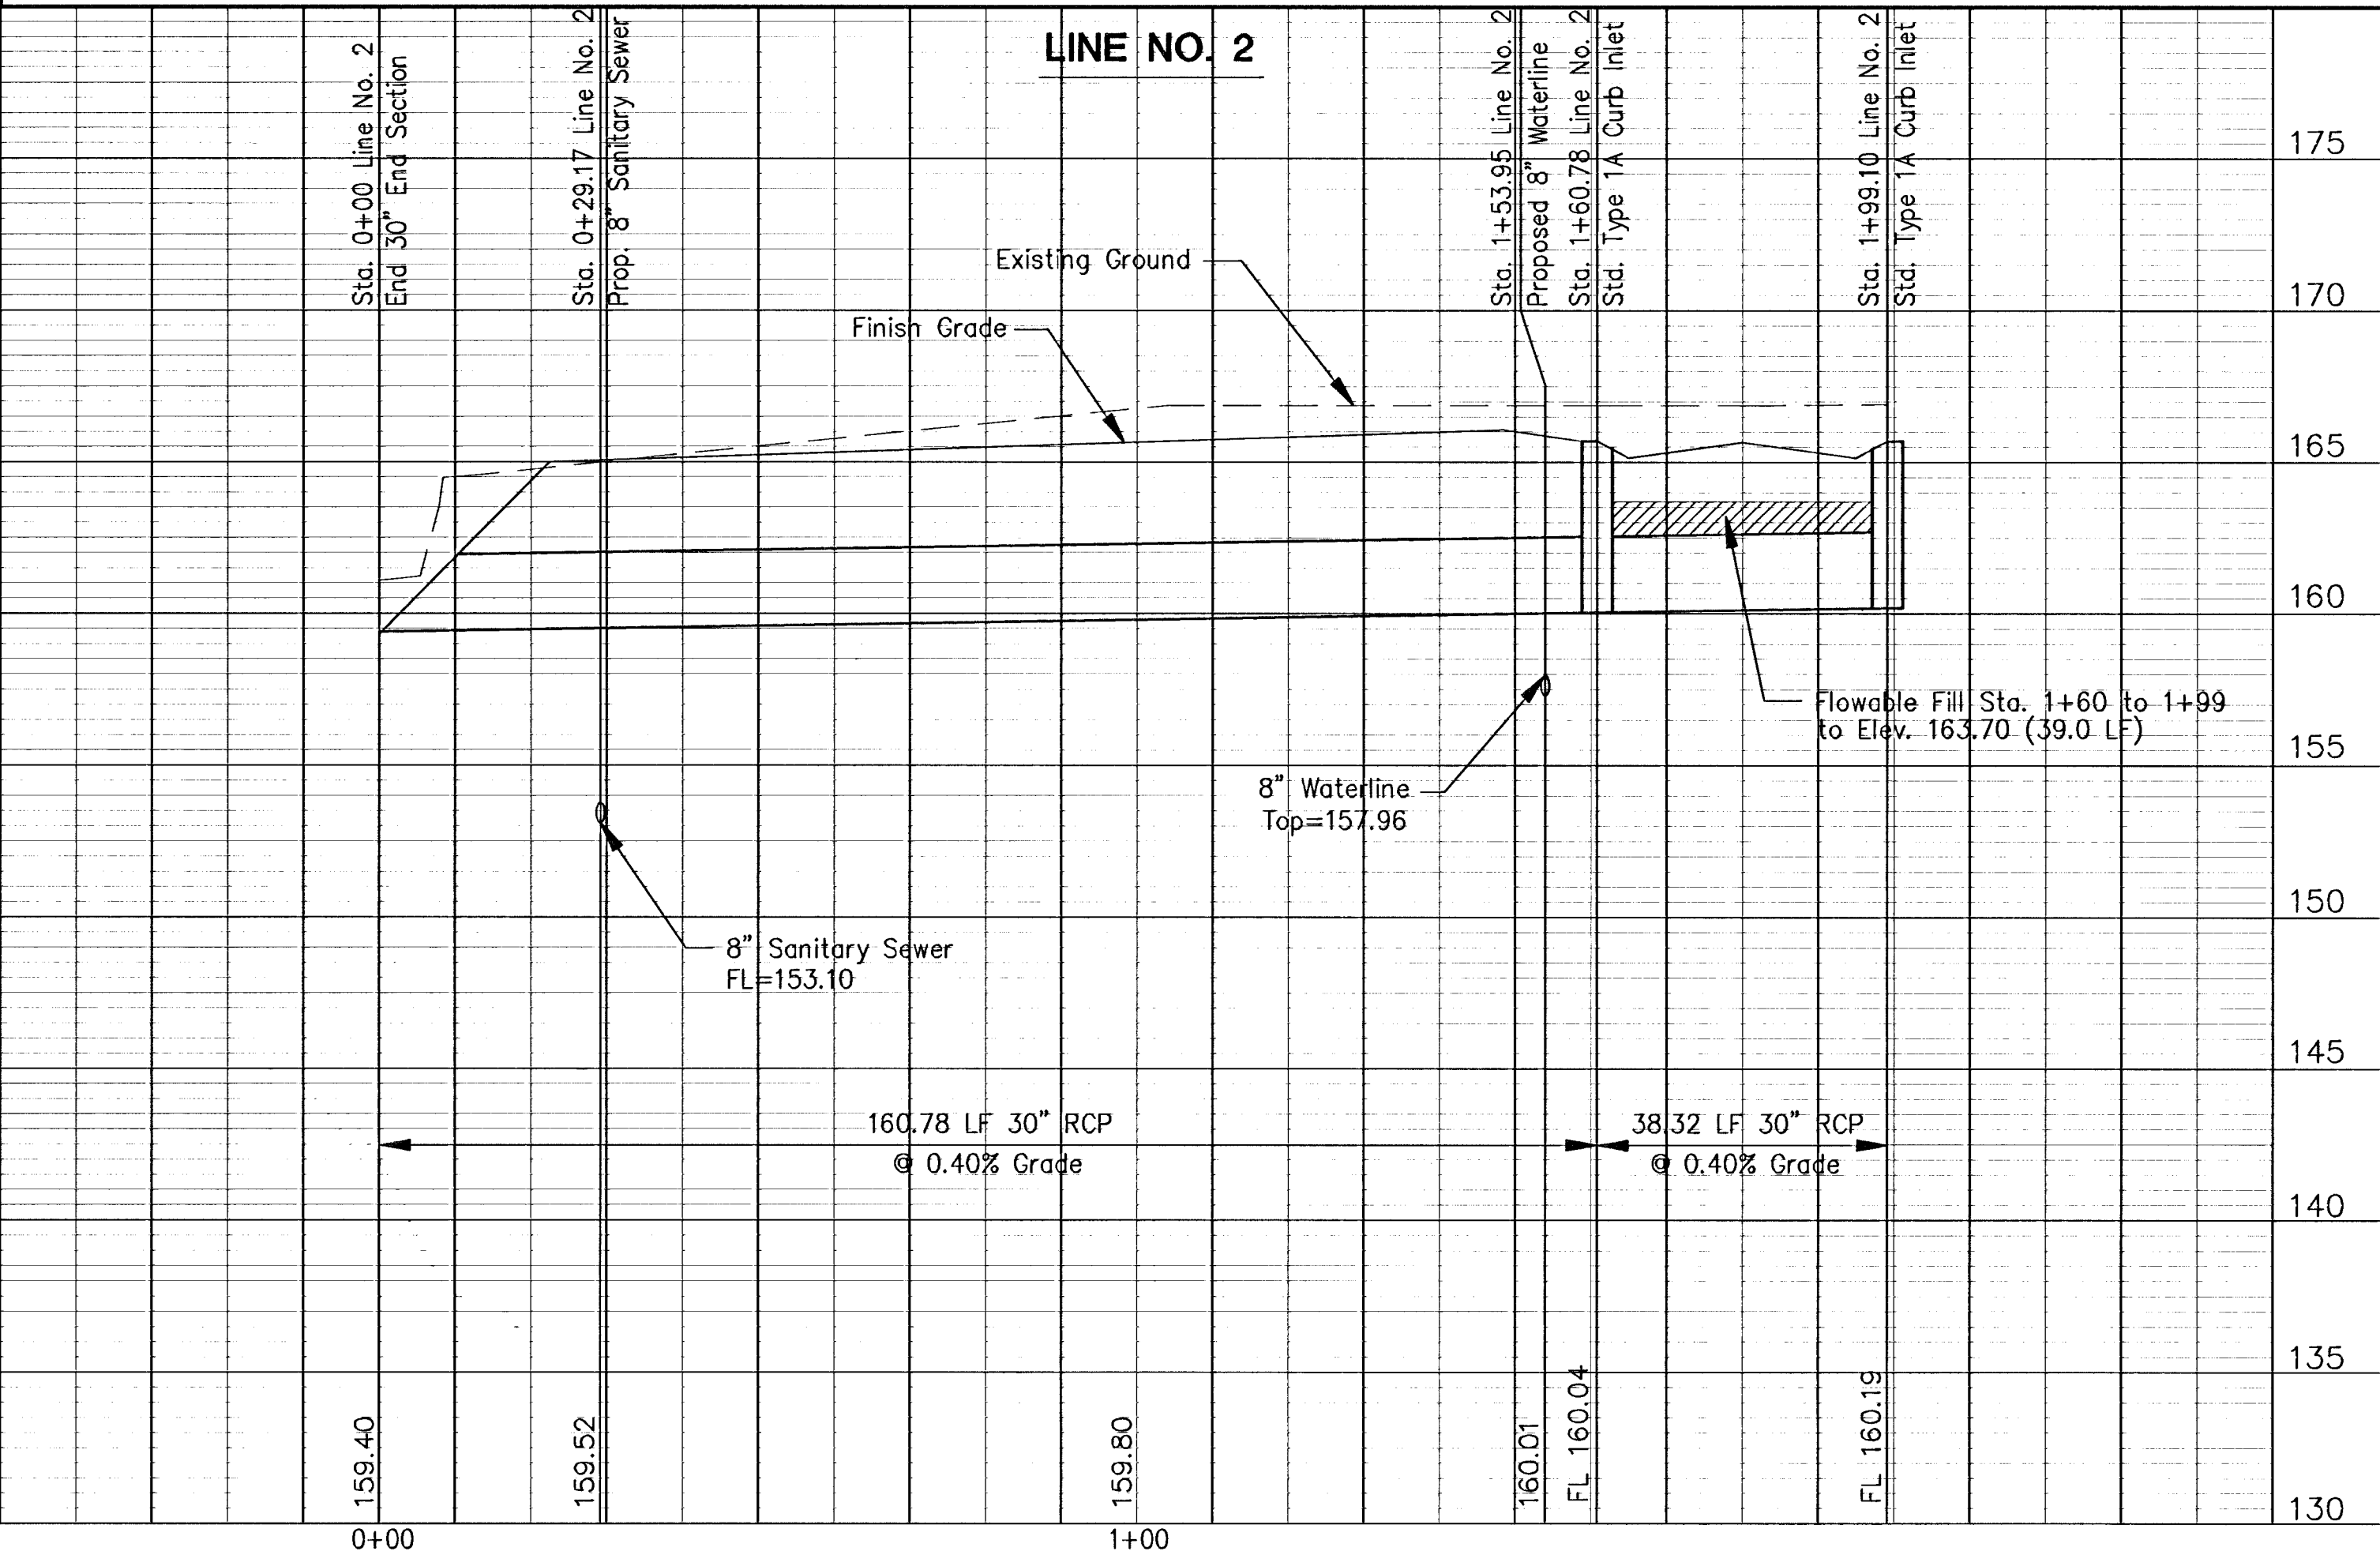
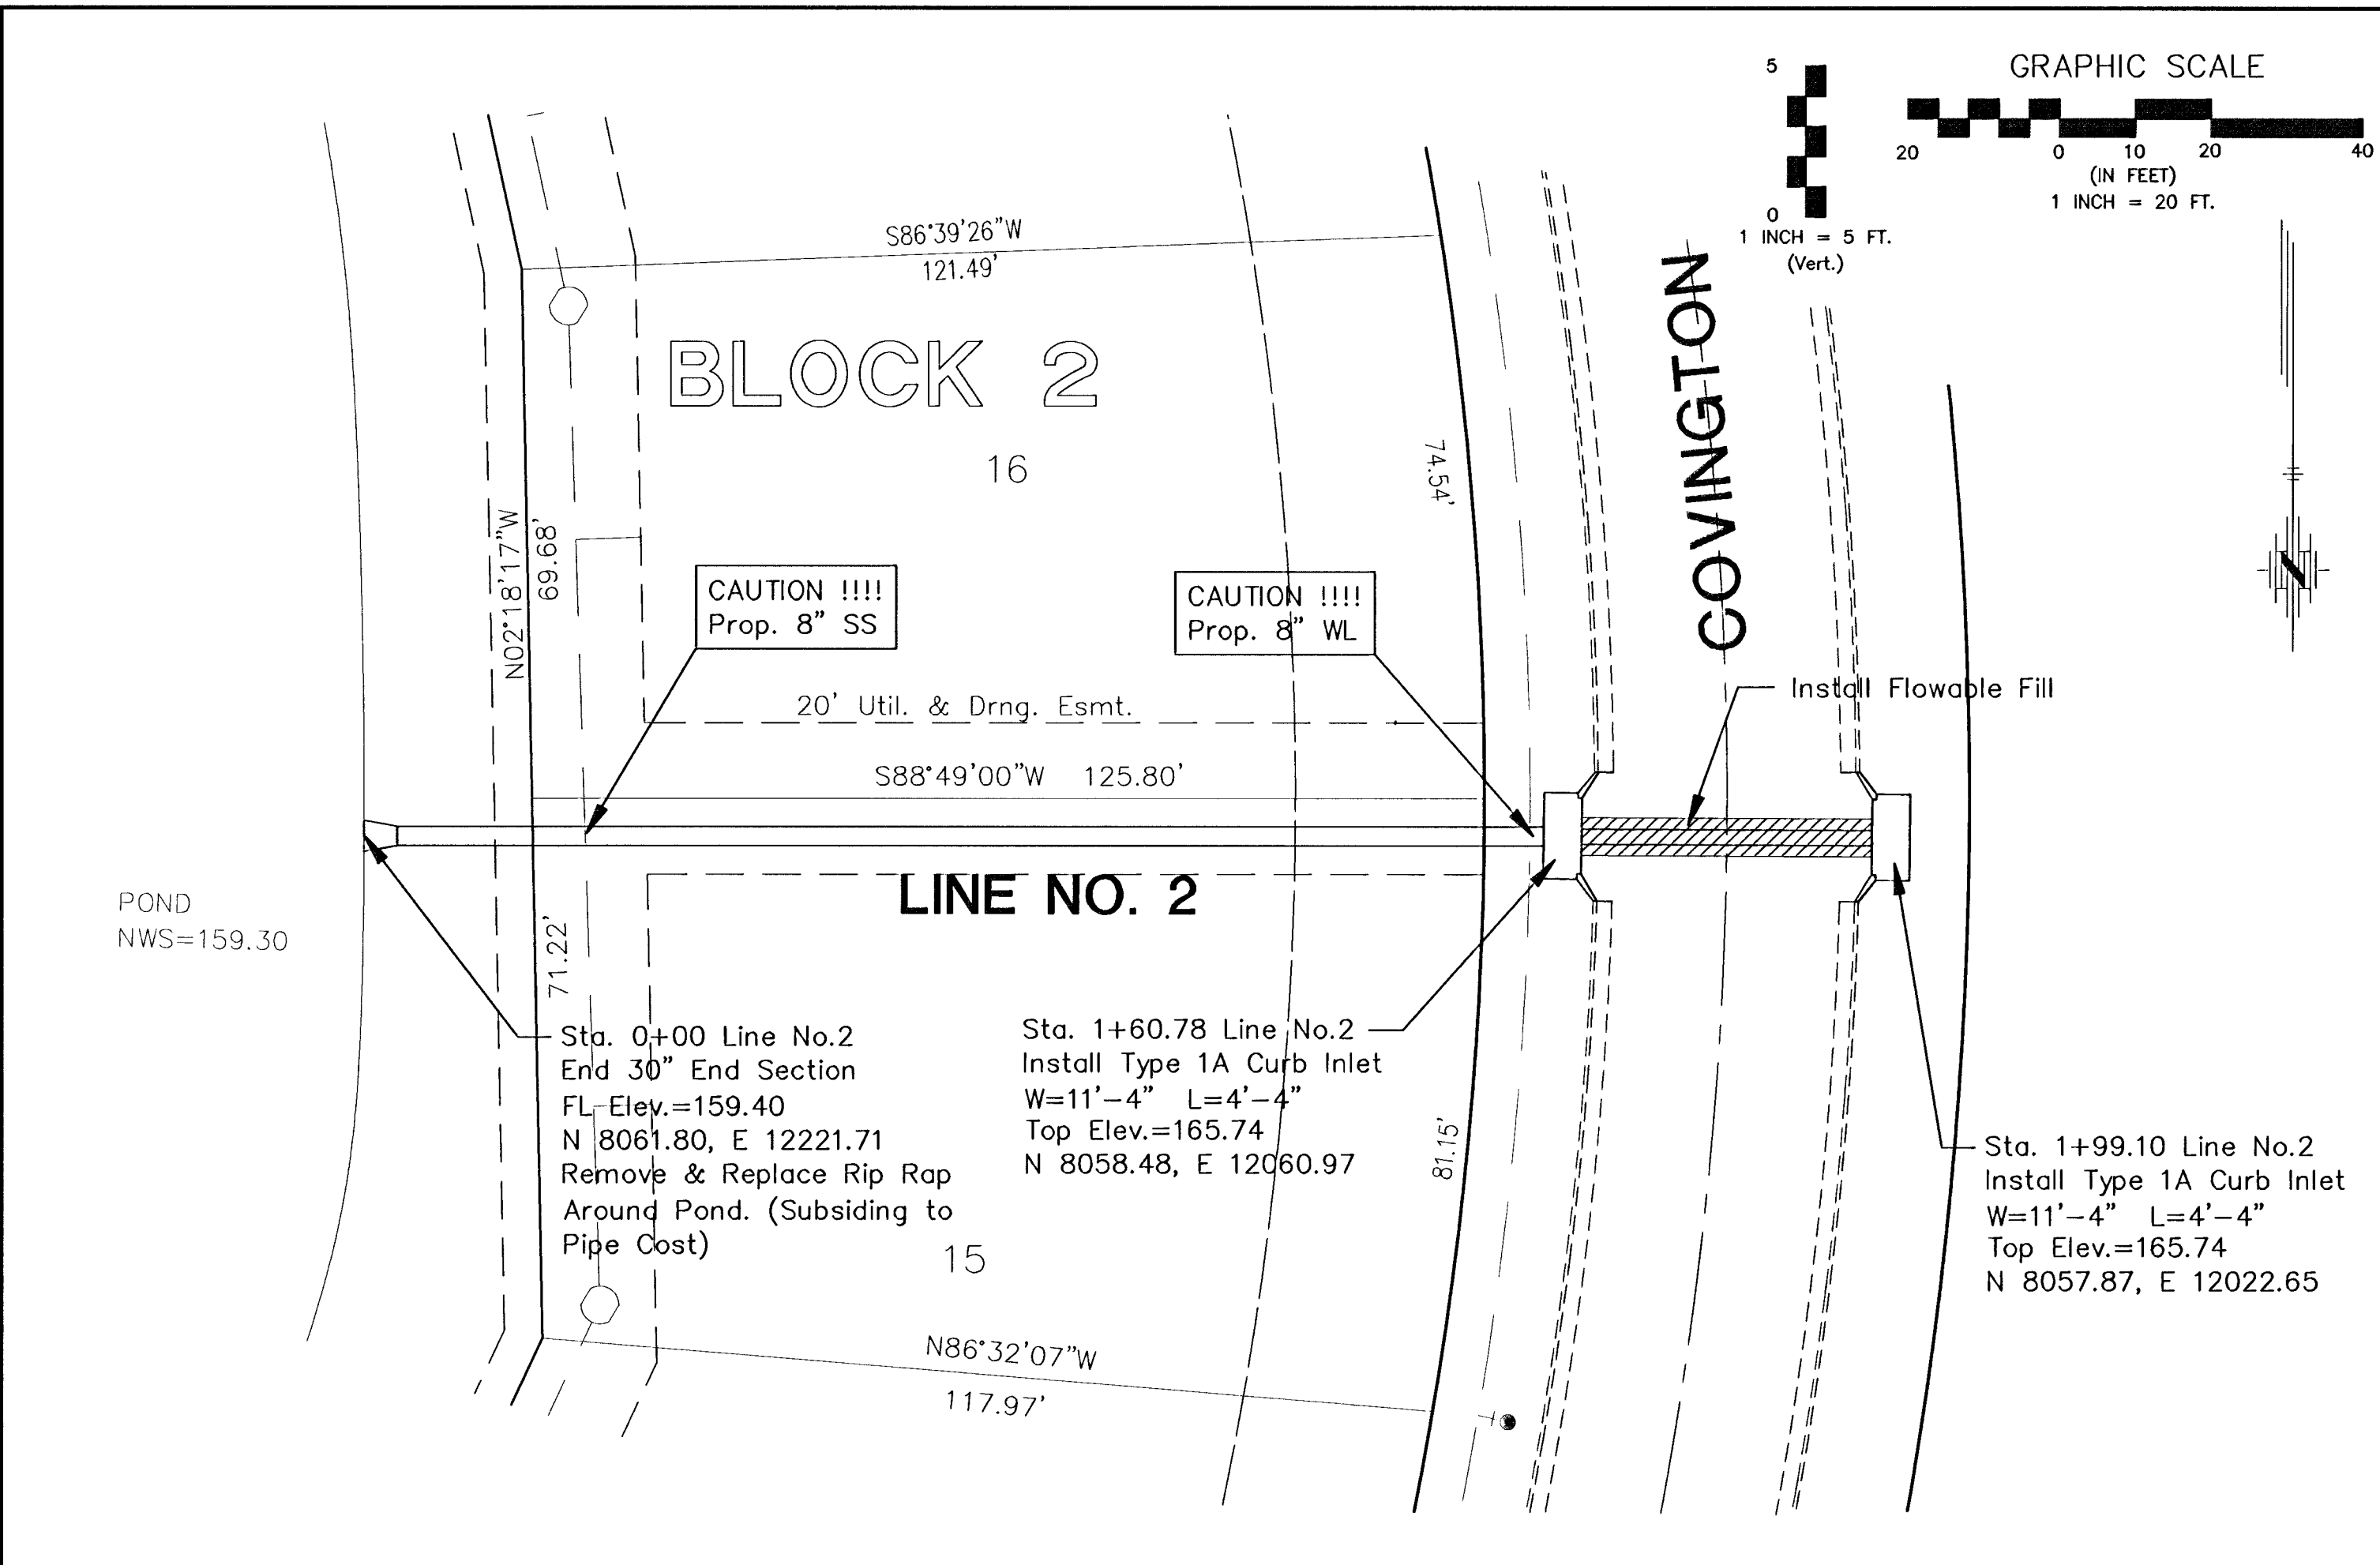
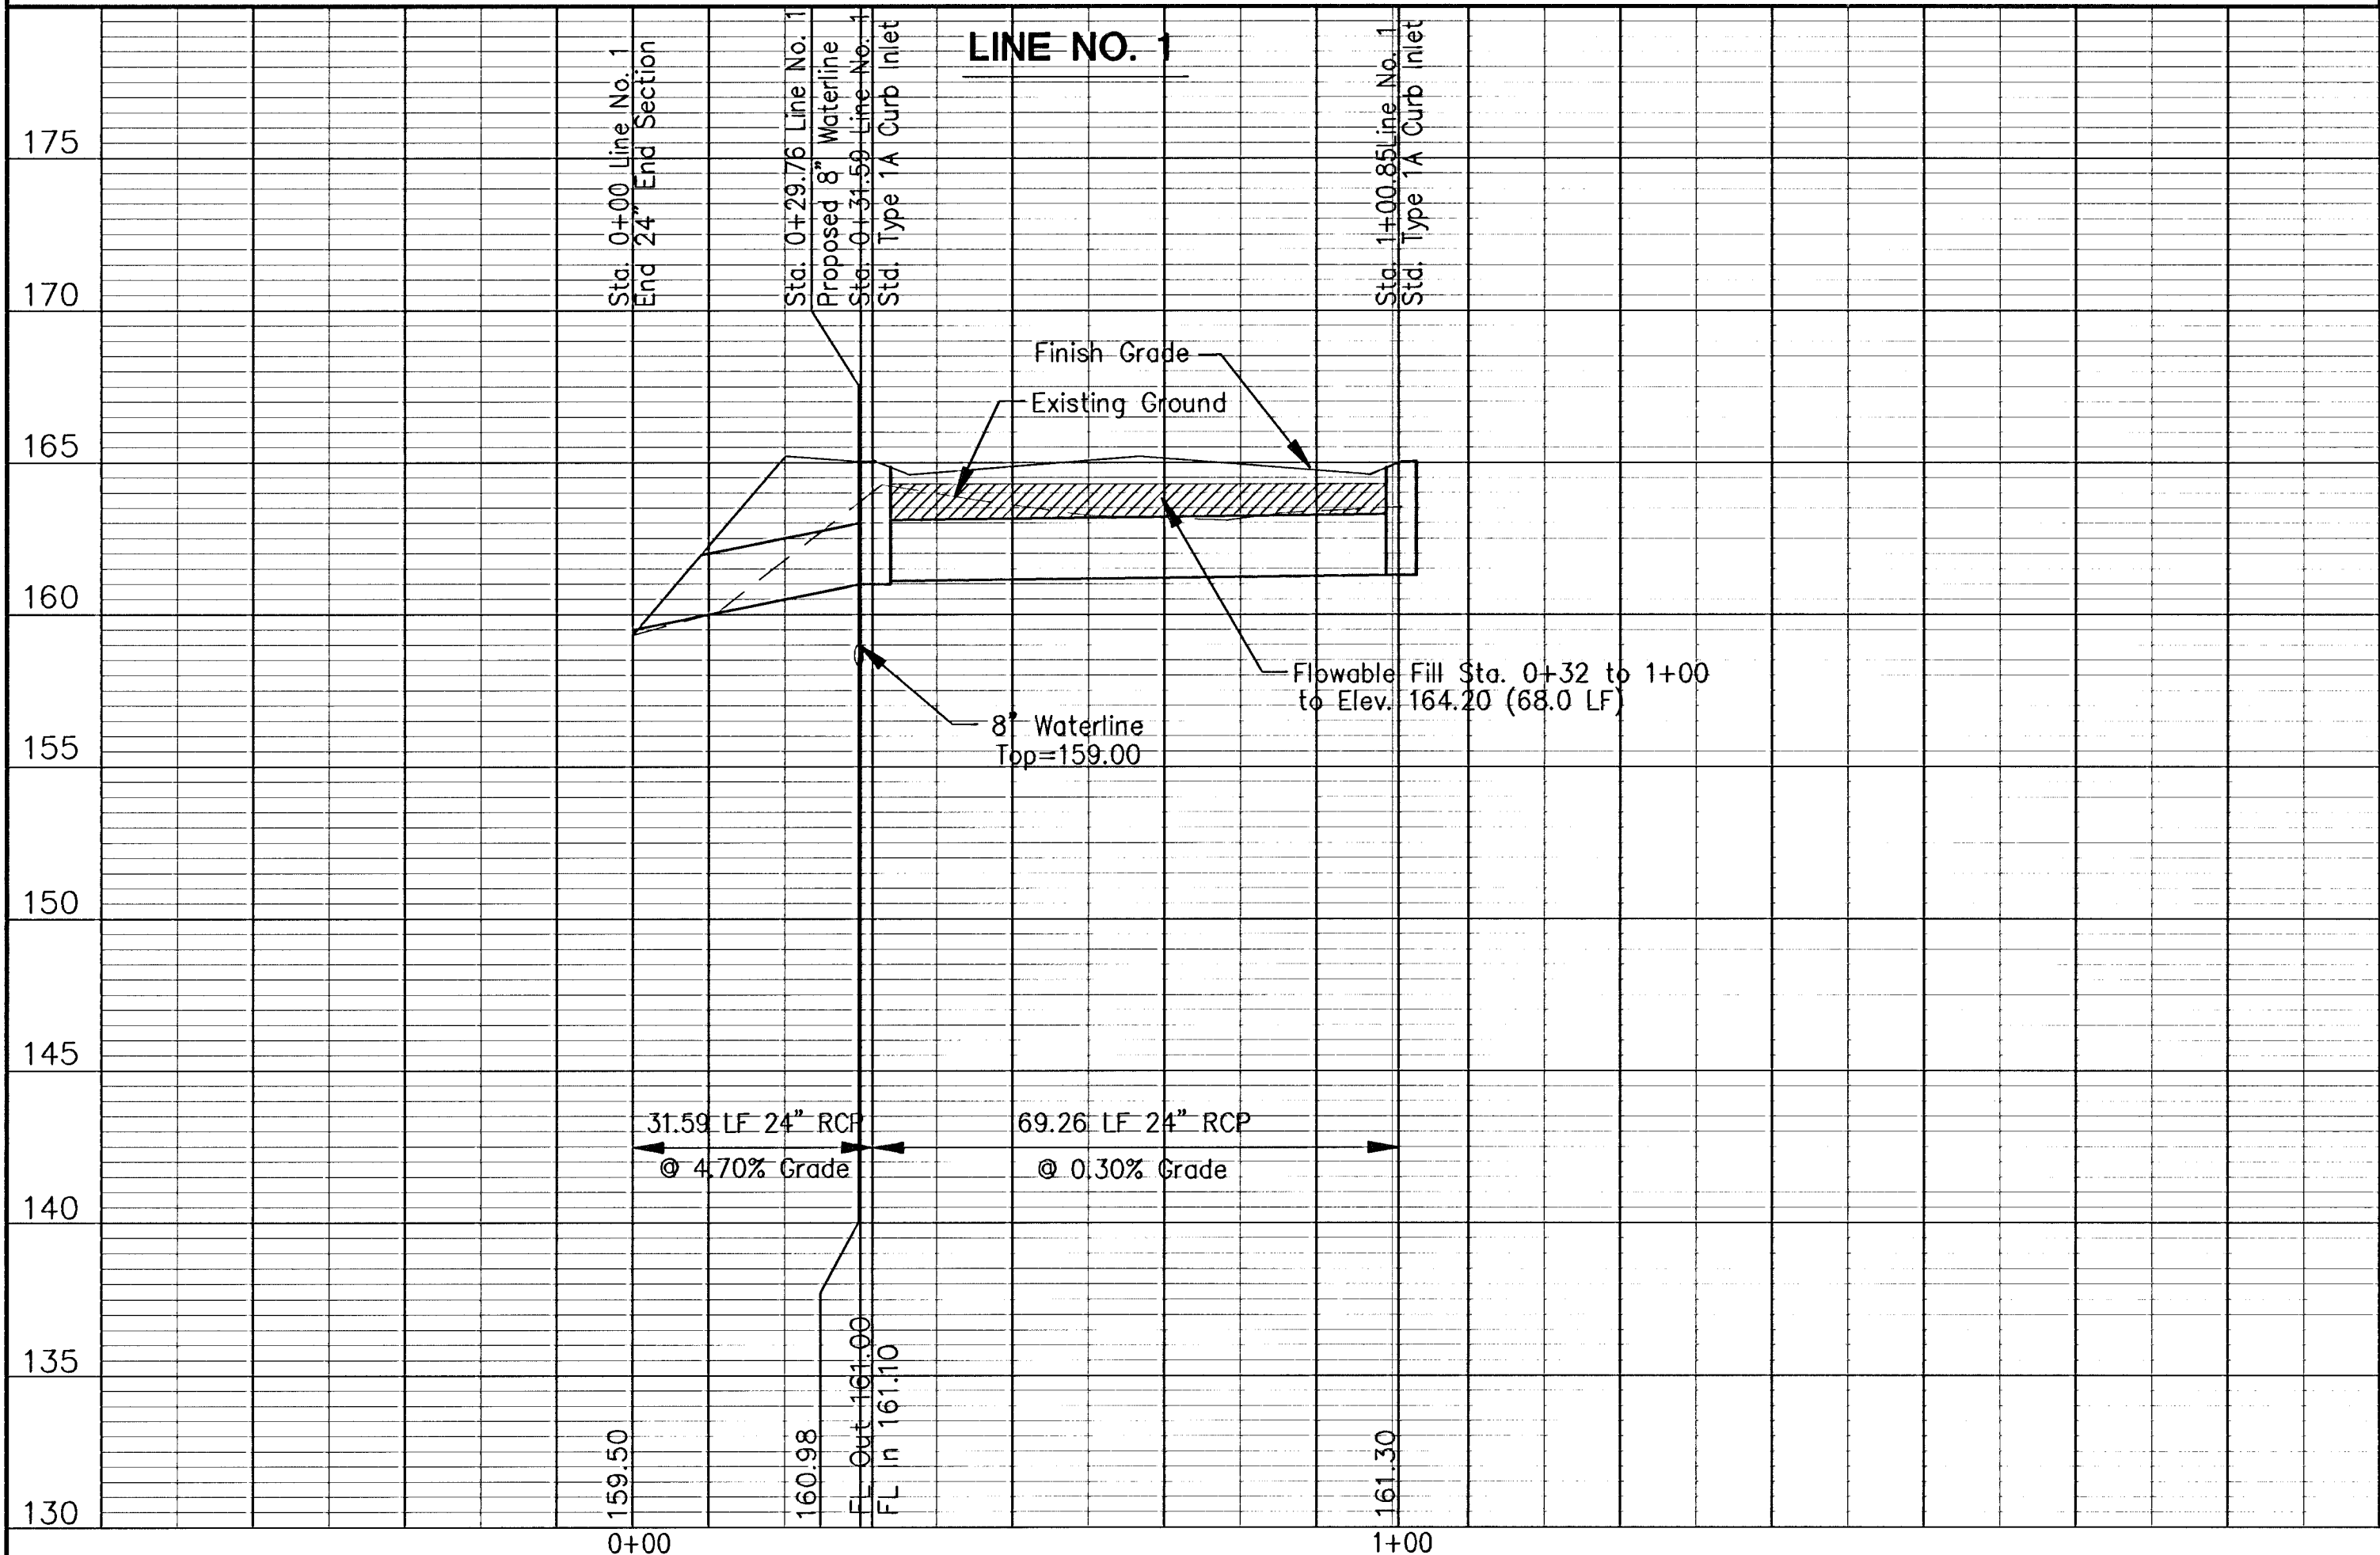


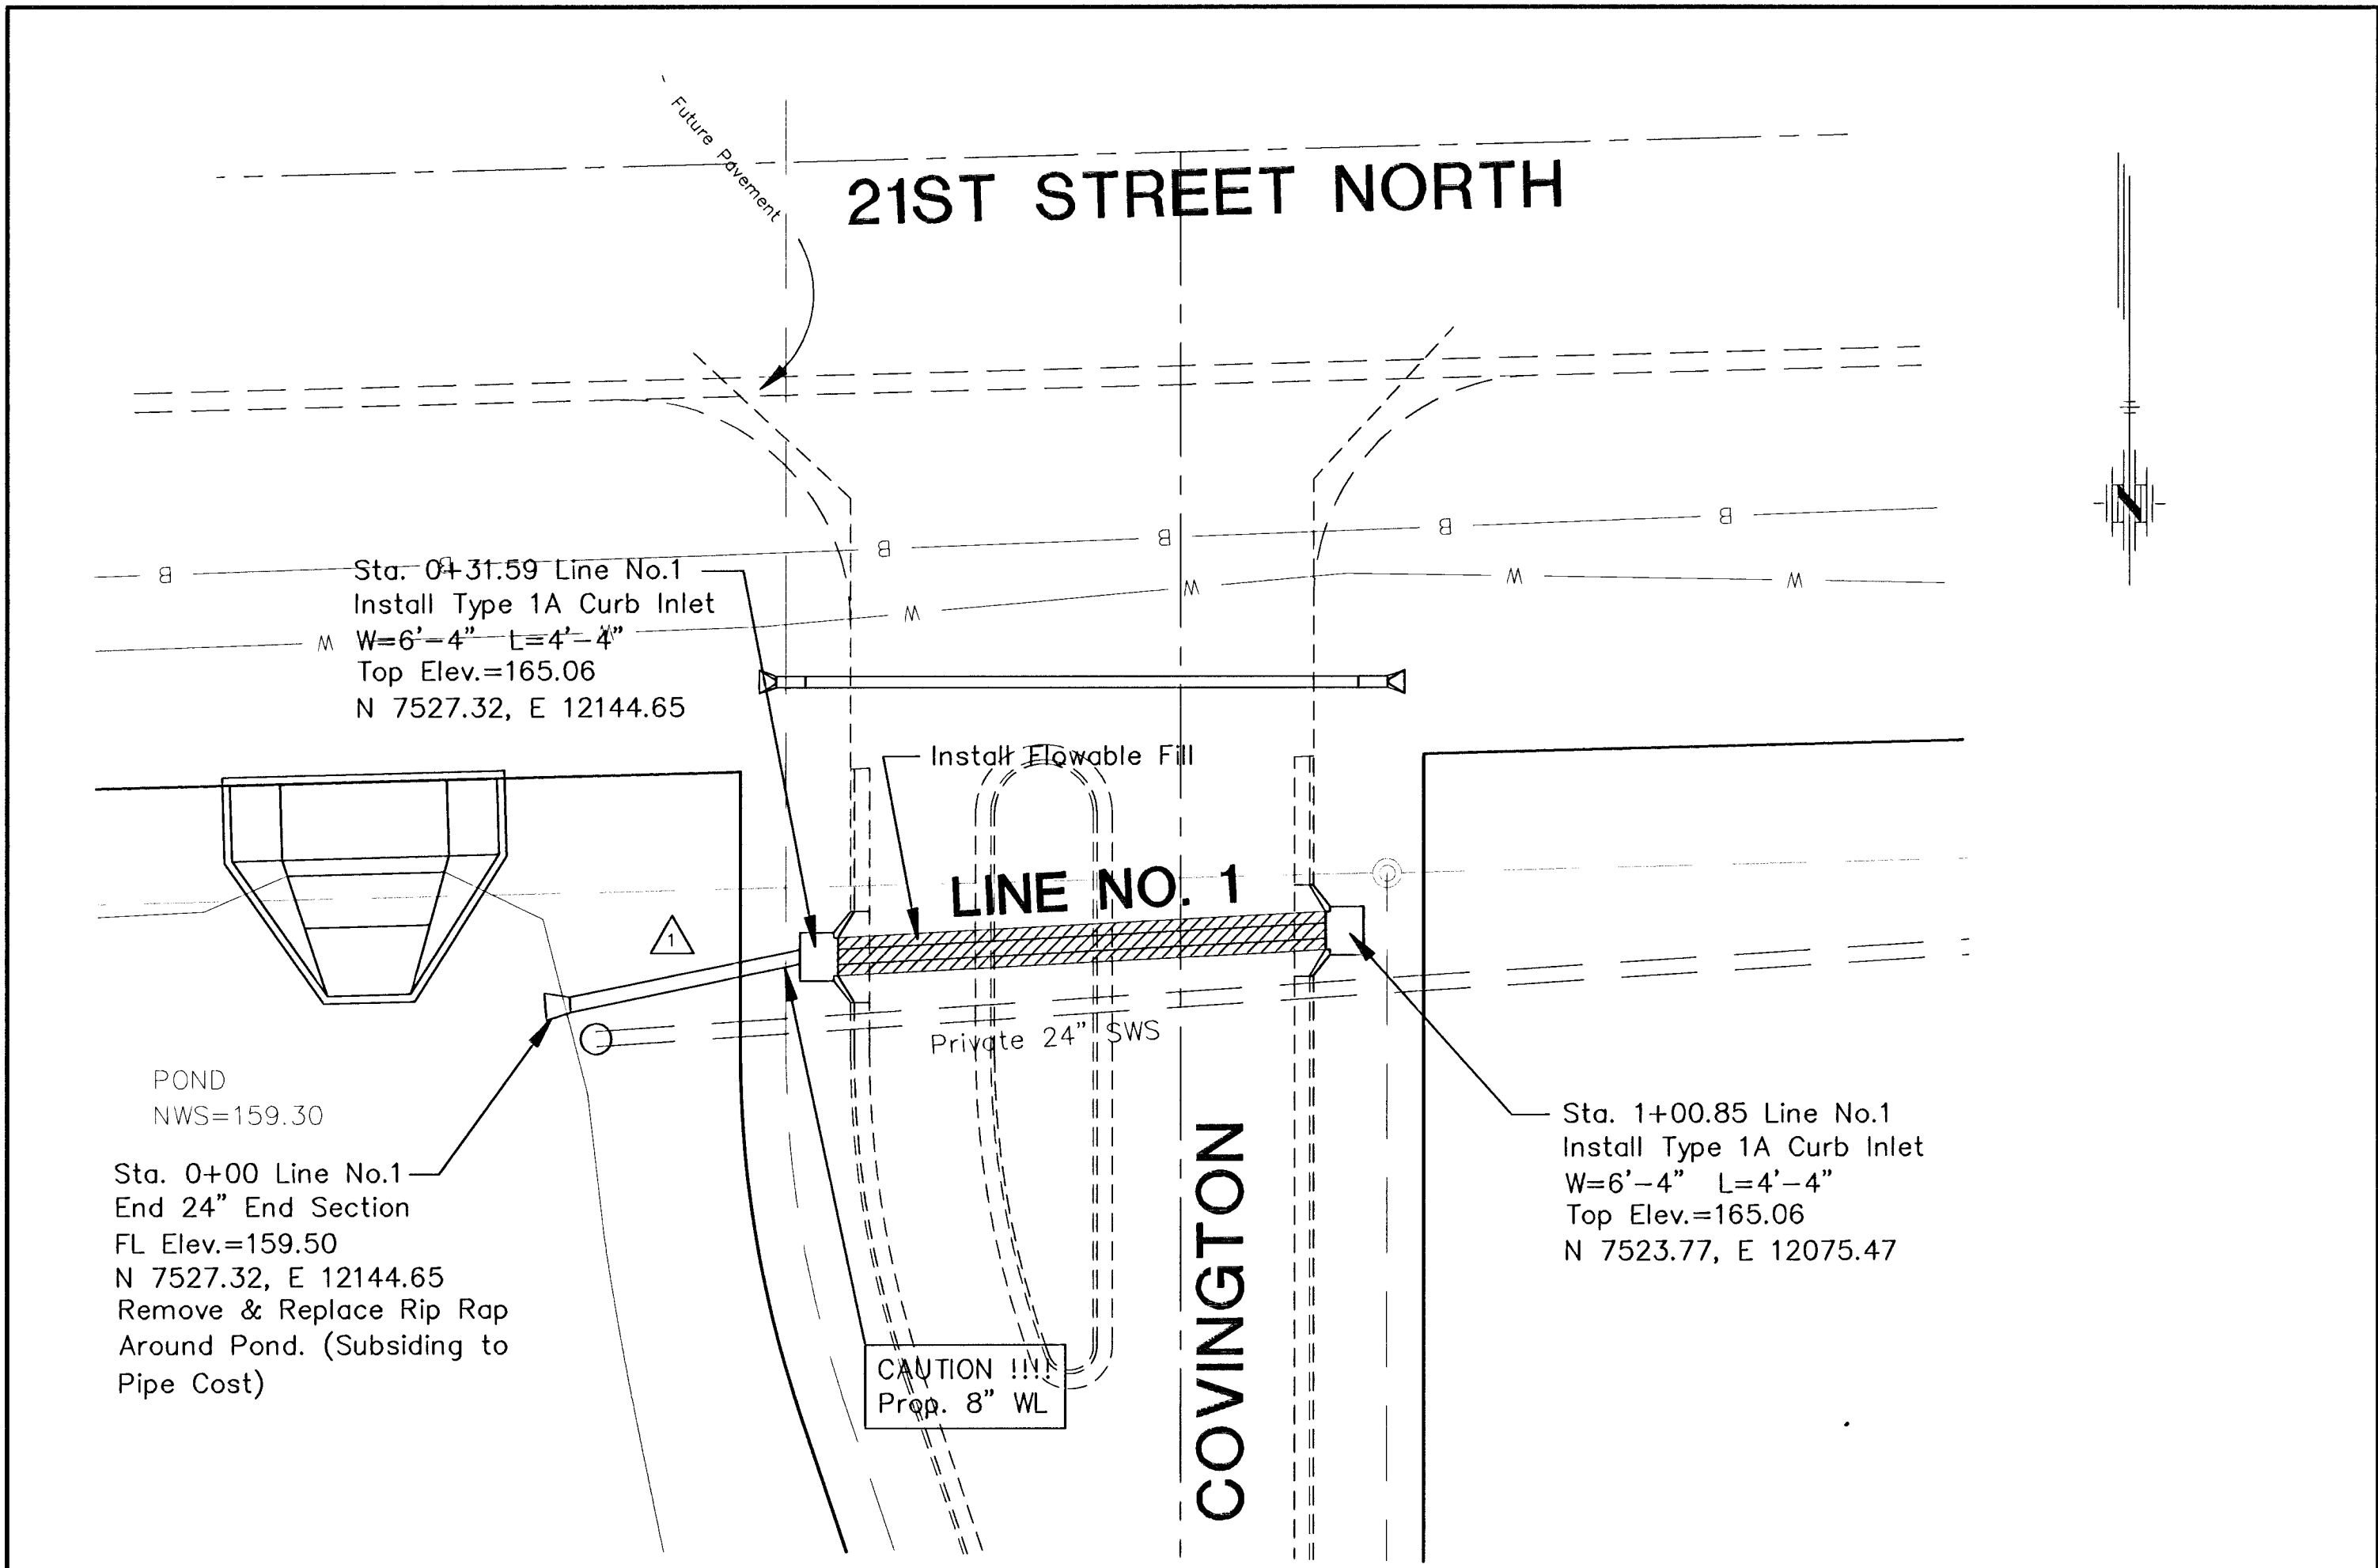

No.	Date	By	Approved	Revision	Revised Inlet Locations
1	8/6/01	JMU			
2					
3					
4					

THE LOOKS AT ABERDEEN STORM WATER SEWER LINE NO. 1, & 2 CITY OF WICHITA, KANSAS MICHAEL E. LINDEBAK, P.E. - CITY ENGINEER Proj.# 472-83359 O.C.A.# 765881
POE & ASSOCIATES OF KANSAS, INC. CONSULTING ENGINEERS 3709 E. Central, Suite 200 • Wichita, KS 67208-4242 Phone 316-685-1114 • FAX 316-685-4444
Engineer: J. Ubert Drawn By: B. Kulla Poe Job No.: 1656B Date: May 2001
Sheet 13 of 58