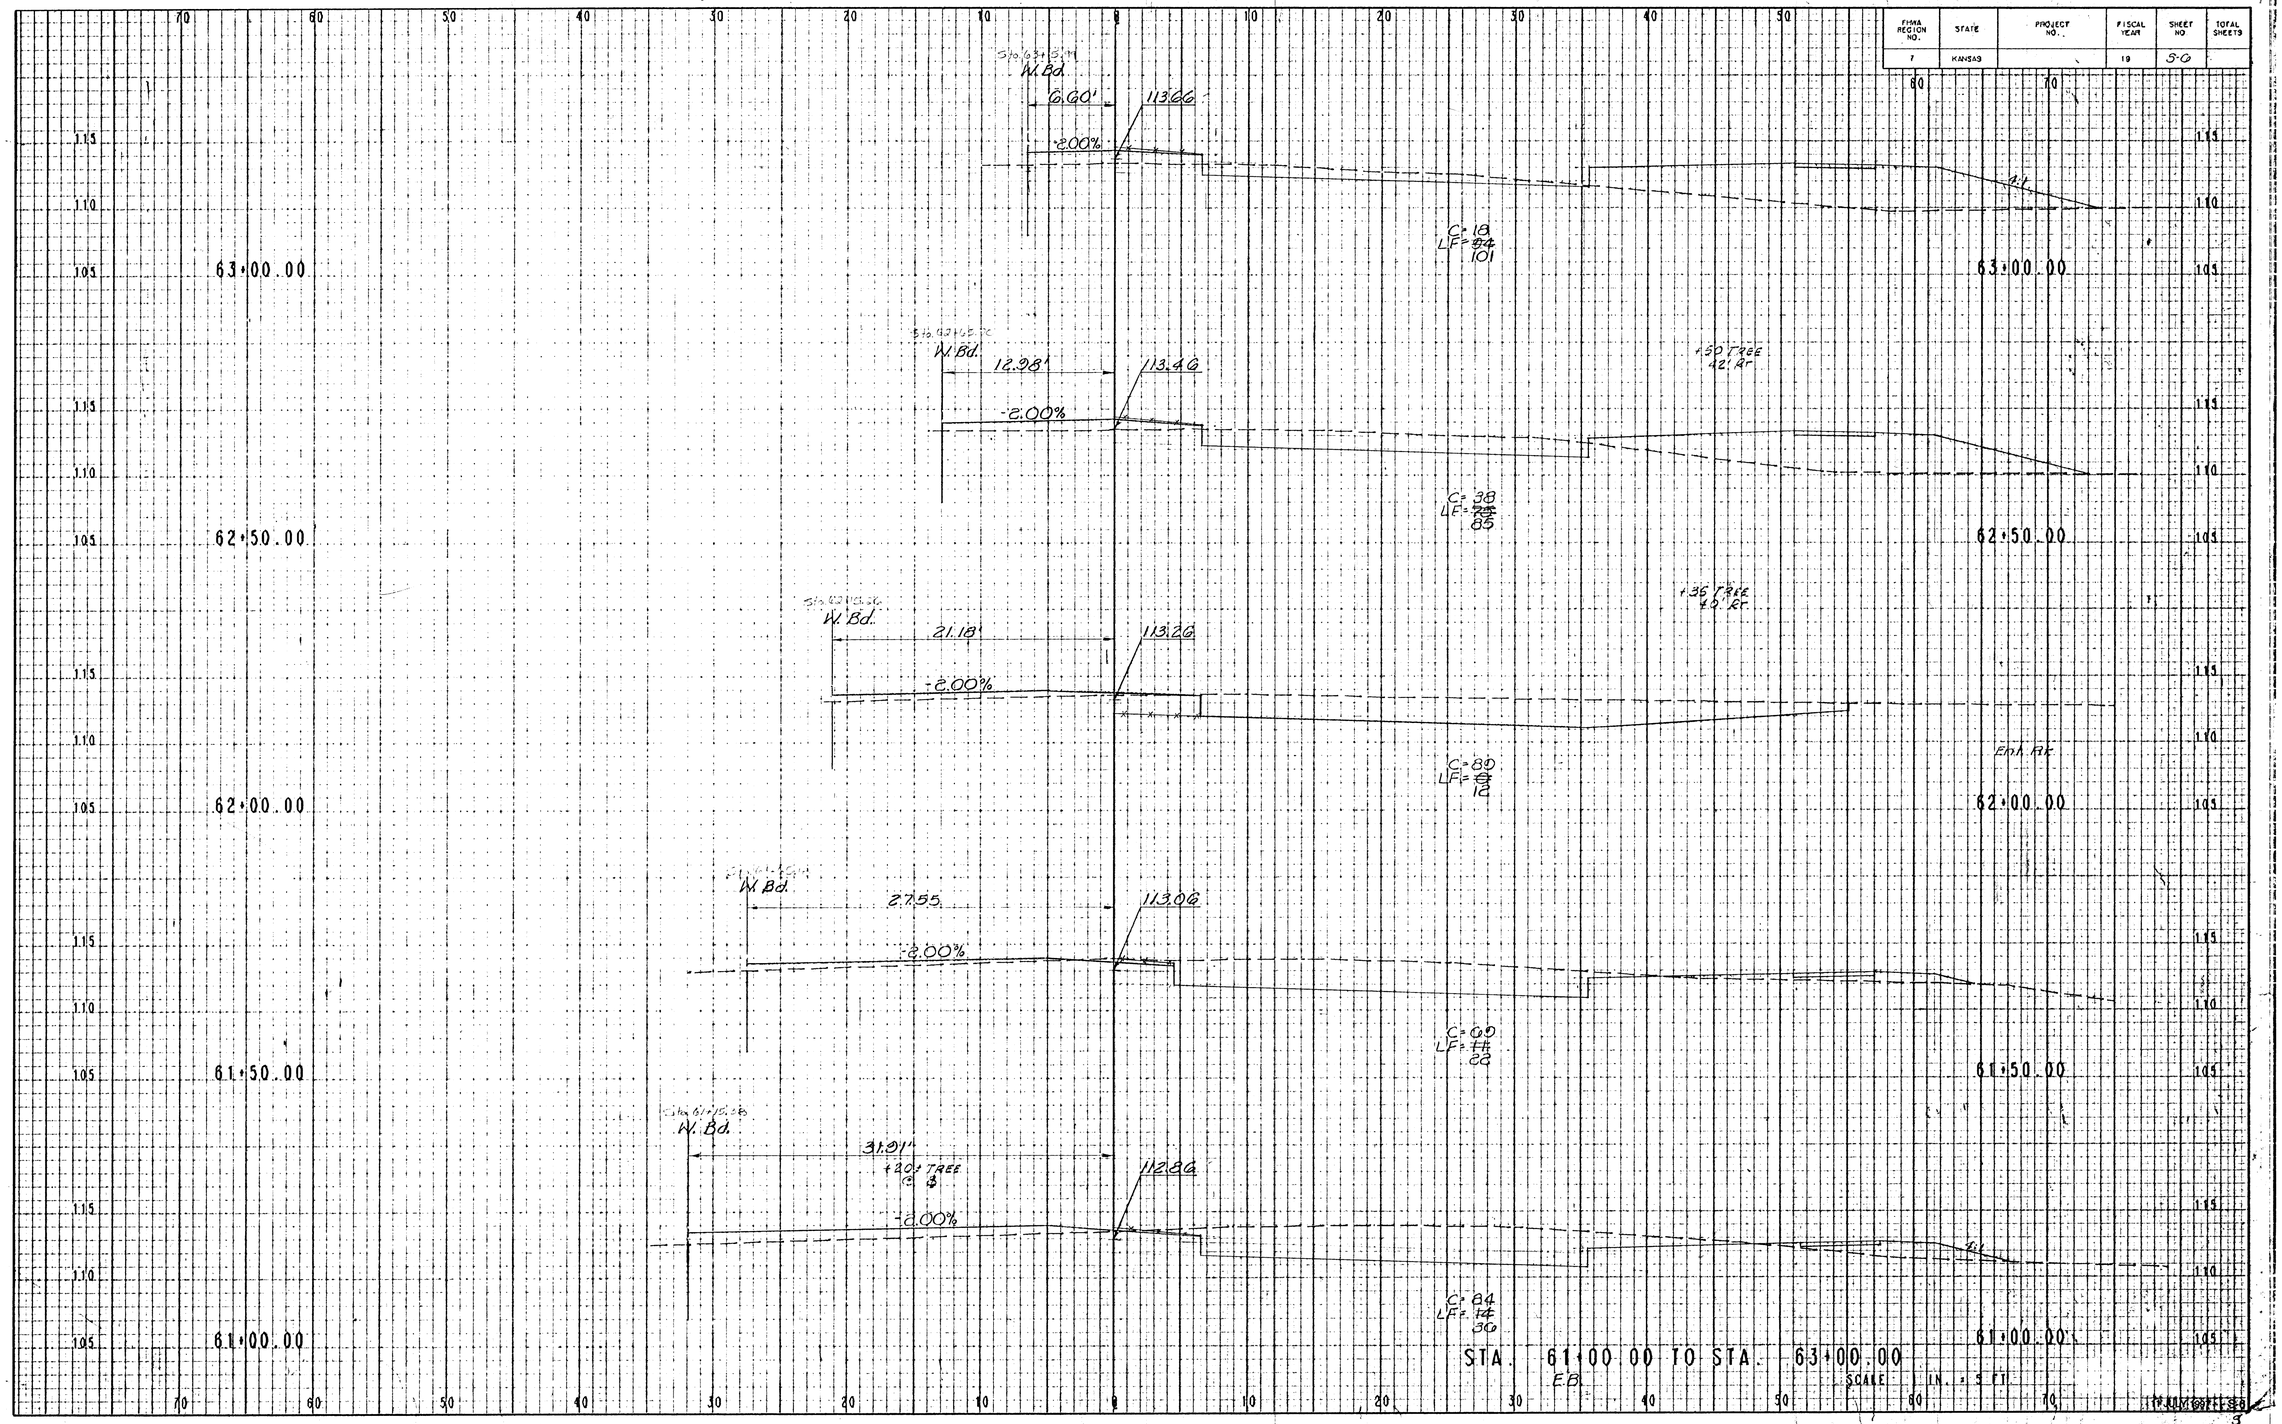FHWA REGION NO.	STATE	PROJECT NO.	FISCAL YEAR	SHEET NO	TOTAL SHEETS
7	KANSAS		19	5-G