



PROJECT NO.	SHEET NO.	TOTAL SHEETS
472-83330	10	16

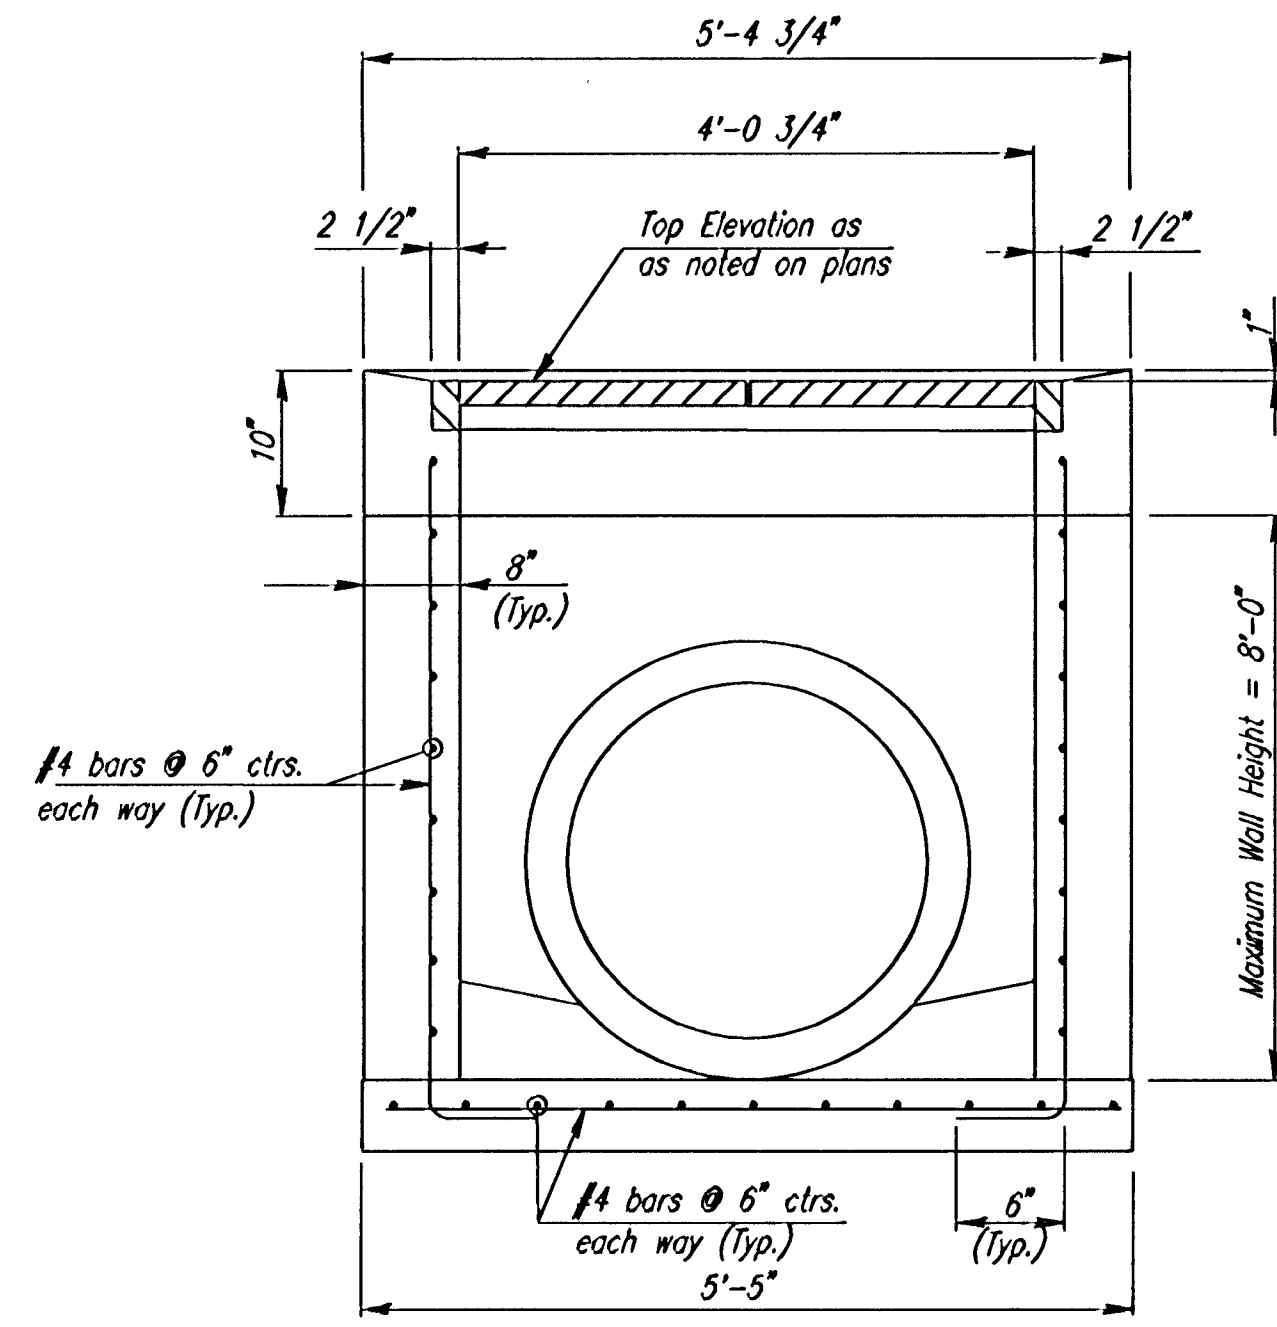


SECTION A-A

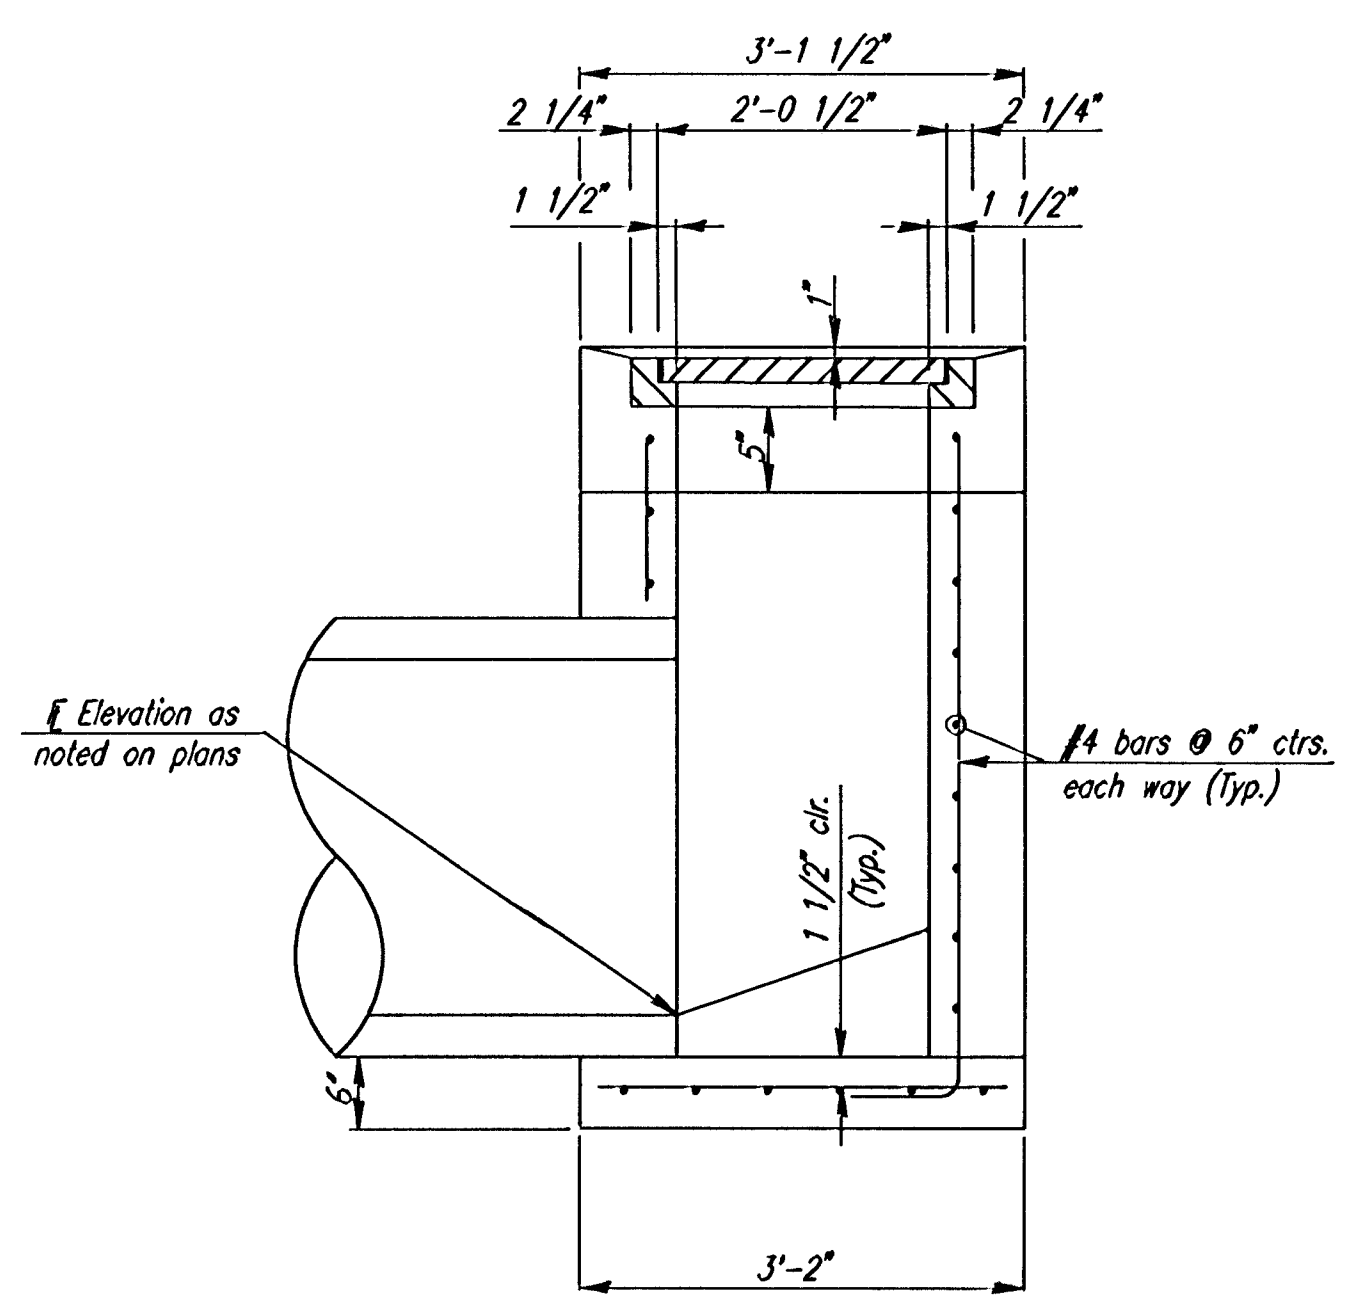

SECTION B-B

STANDARD AREA INLET

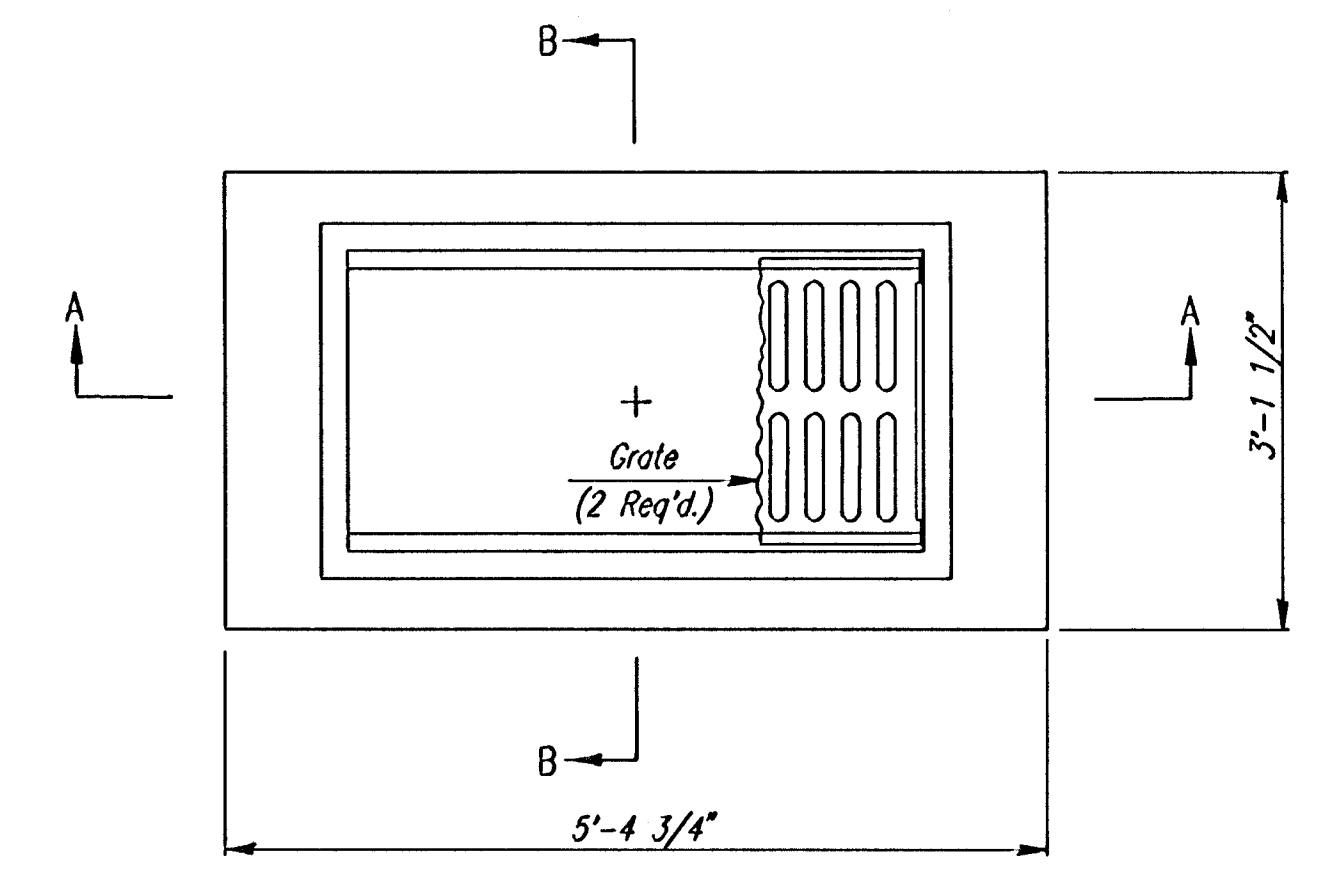

PLAN

GENERAL NOTES

CONCRETE SHALL HAVE A MINIMUM 28 DAY COMPRESSIVE STRENGTH OF 4000 PSI. ALL PIPES SHALL BE FLUSH CUT PRIOR TO BEING CAST INTO WALLS.


REINFORCING STEEL SHALL BE GRADE 60, A.S.T.M. A615. ALL DIMENSIONS RELATIVE TO PLACEMENT OF REINFORCING ARE TO THE CENTERLINE OF BARS UNLESS OTHERWISE NOTED.

INLET CASTINGS SHALL BE MANUFACTURED USING DUCTILE IRON CONFORMING TO ASTM A536-80 GRADE 65-45-12. DIMENSIONS AND WEIGHTS SHOWN ON THE DETAILED DRAWINGS SHALL BE CONSIDERED AS MINIMUM REQUIREMENTS AND ANY DEVIATIONS FROM THE DIMENSIONS SHOWN MUST BE SPECIFICALLY APPROVED. THE FINISHED CASTINGS SHALL BE OF UNIFORM QUALITY, FREE FROM BLOWHOLES, POROSITY, HARD SPOTS, SHRINKAGE DISTORTIONS OR OTHER DEFECTS.


INLET FLOOR SHALL BE SHAPED WITH UNREINFORCED CONCRETE (3 SACK SAND MIX) TO CREATE FLOW CHANNELS AND TO INCREASE HYDRAULIC EFFICIENCY SUCH THAT THE INLET WILL BE SELF CLEANING BETWEEN ALL INLET AND/OR OUTLET PIPES.

PIPES ENTERING EXISTING STRUCTURE SHALL BE CENTERED ON INSIDE FACE OF WALL.


ALL EXPOSED STRUCTURAL STEEL SHALL BE PAINTED WITH A COAT OF INORGANIC ZINC PRIMER AND THEN WITH A TOP COAT OF OR A FIELD COAT OF ORGANIC ZINC, EACH COAT TO BE 3 TO 4 MILS. STRUCTURAL STEEL USED TO FABRICATE THE SPECIAL AREA INLET FRAME SHALL COMPLY WITH A.S.T.M. A56. WELDING SHALL CONFORM TO THE STRUCTURAL WELDING CODE A.W.S. D1.1-88.

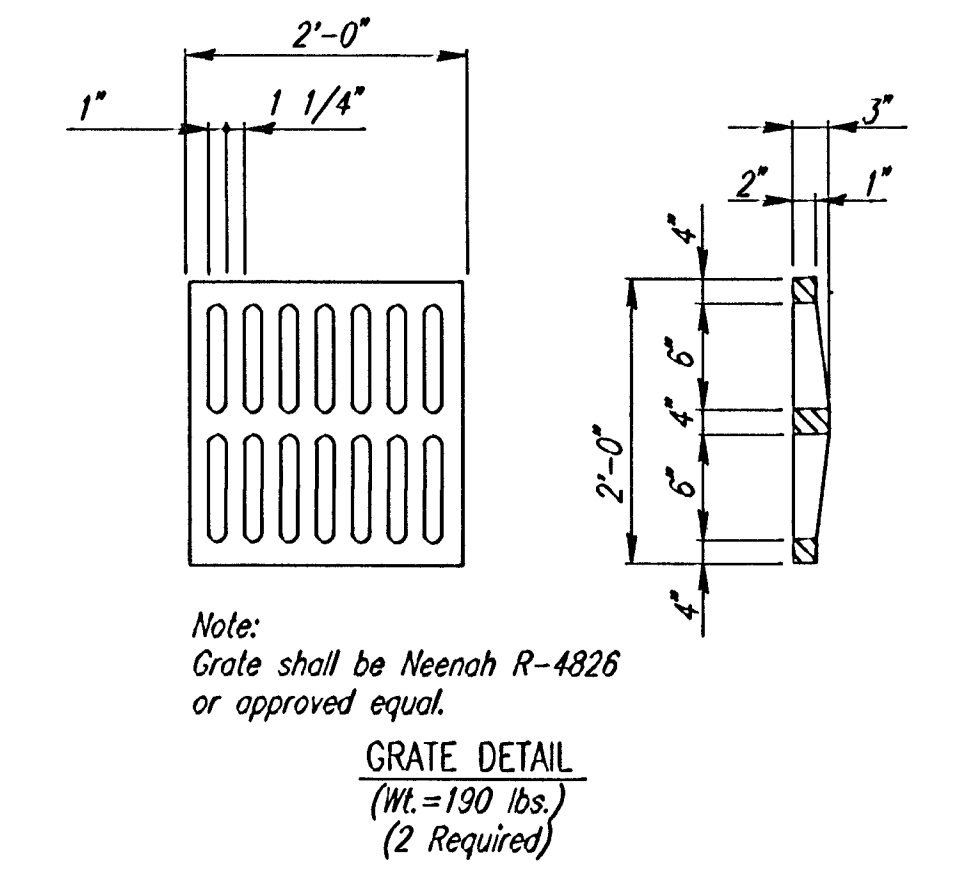


GRATE DETAIL
(Wt.=190 lbs.)
(2 Required)

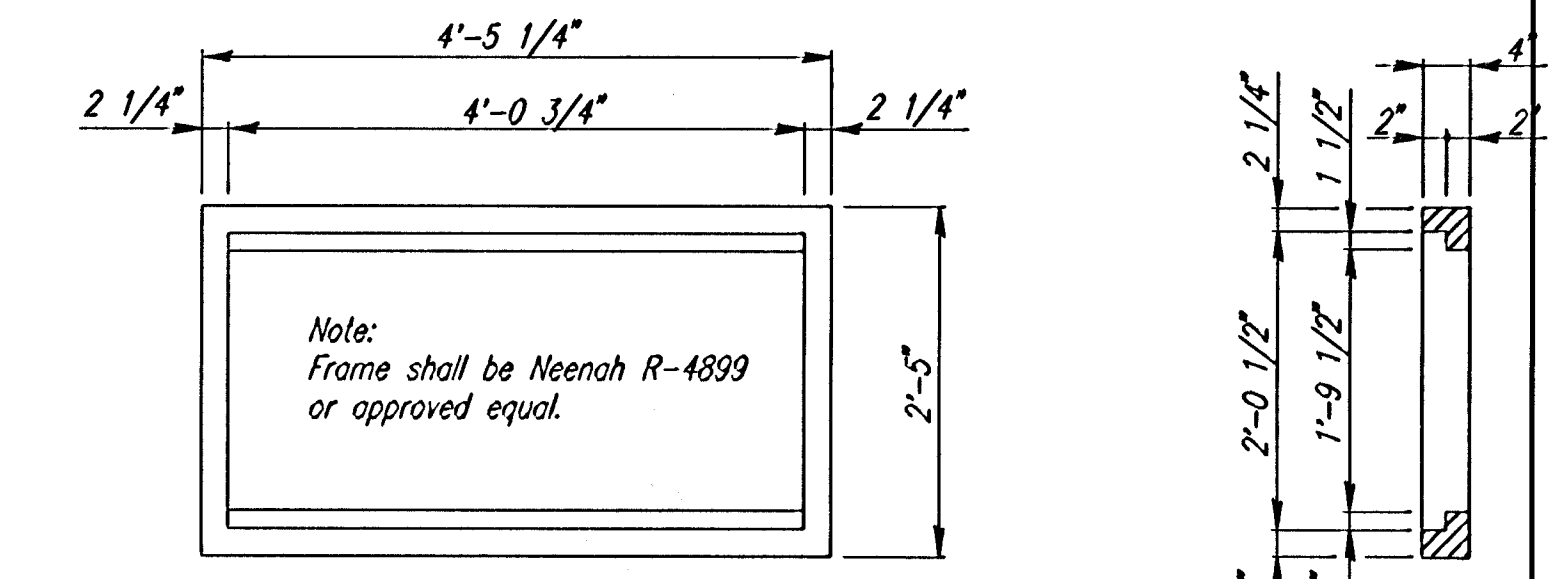

FRAME DETAIL
(Wt.=440 lbs.)
Note: Frame to mate with 2 Neenah R-4826 Grates or approved equal.

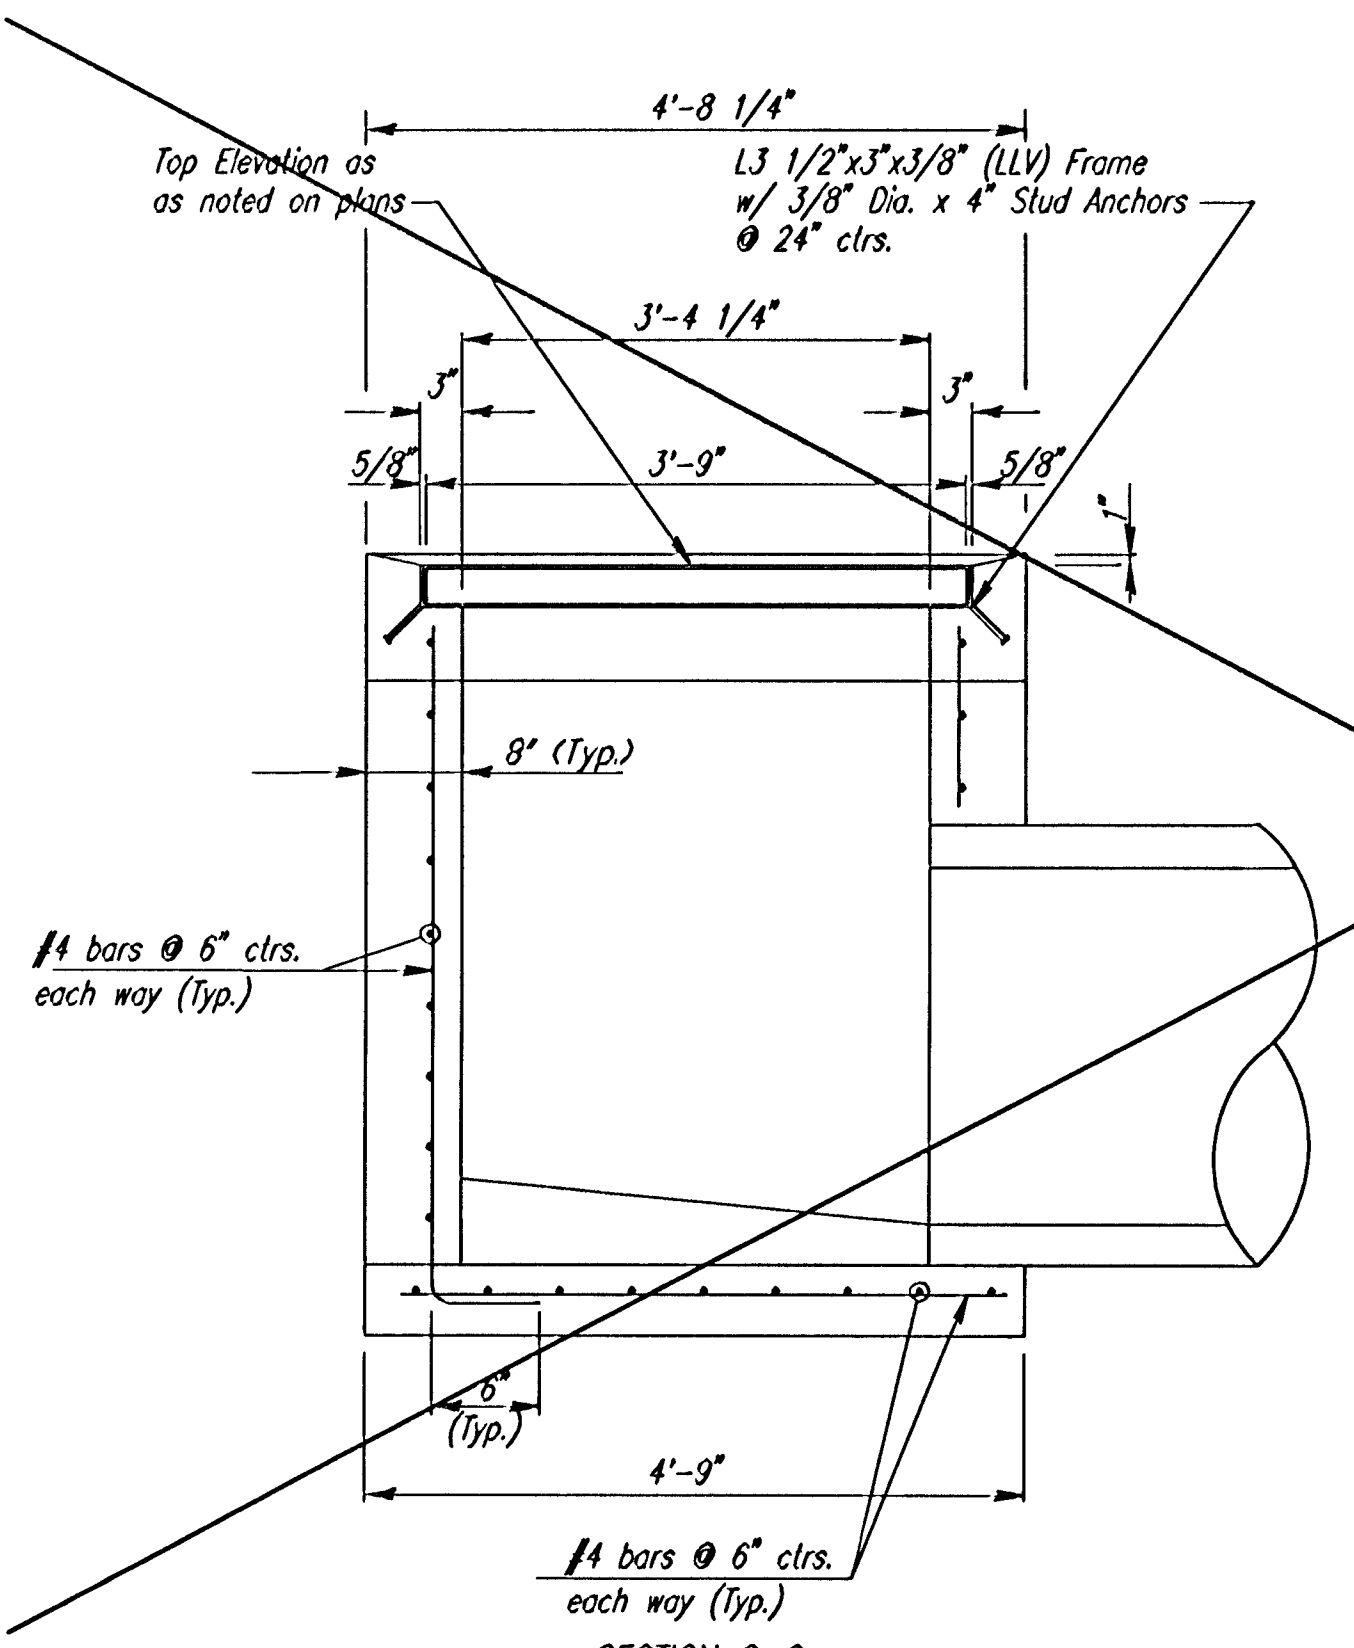


SECTION C-C

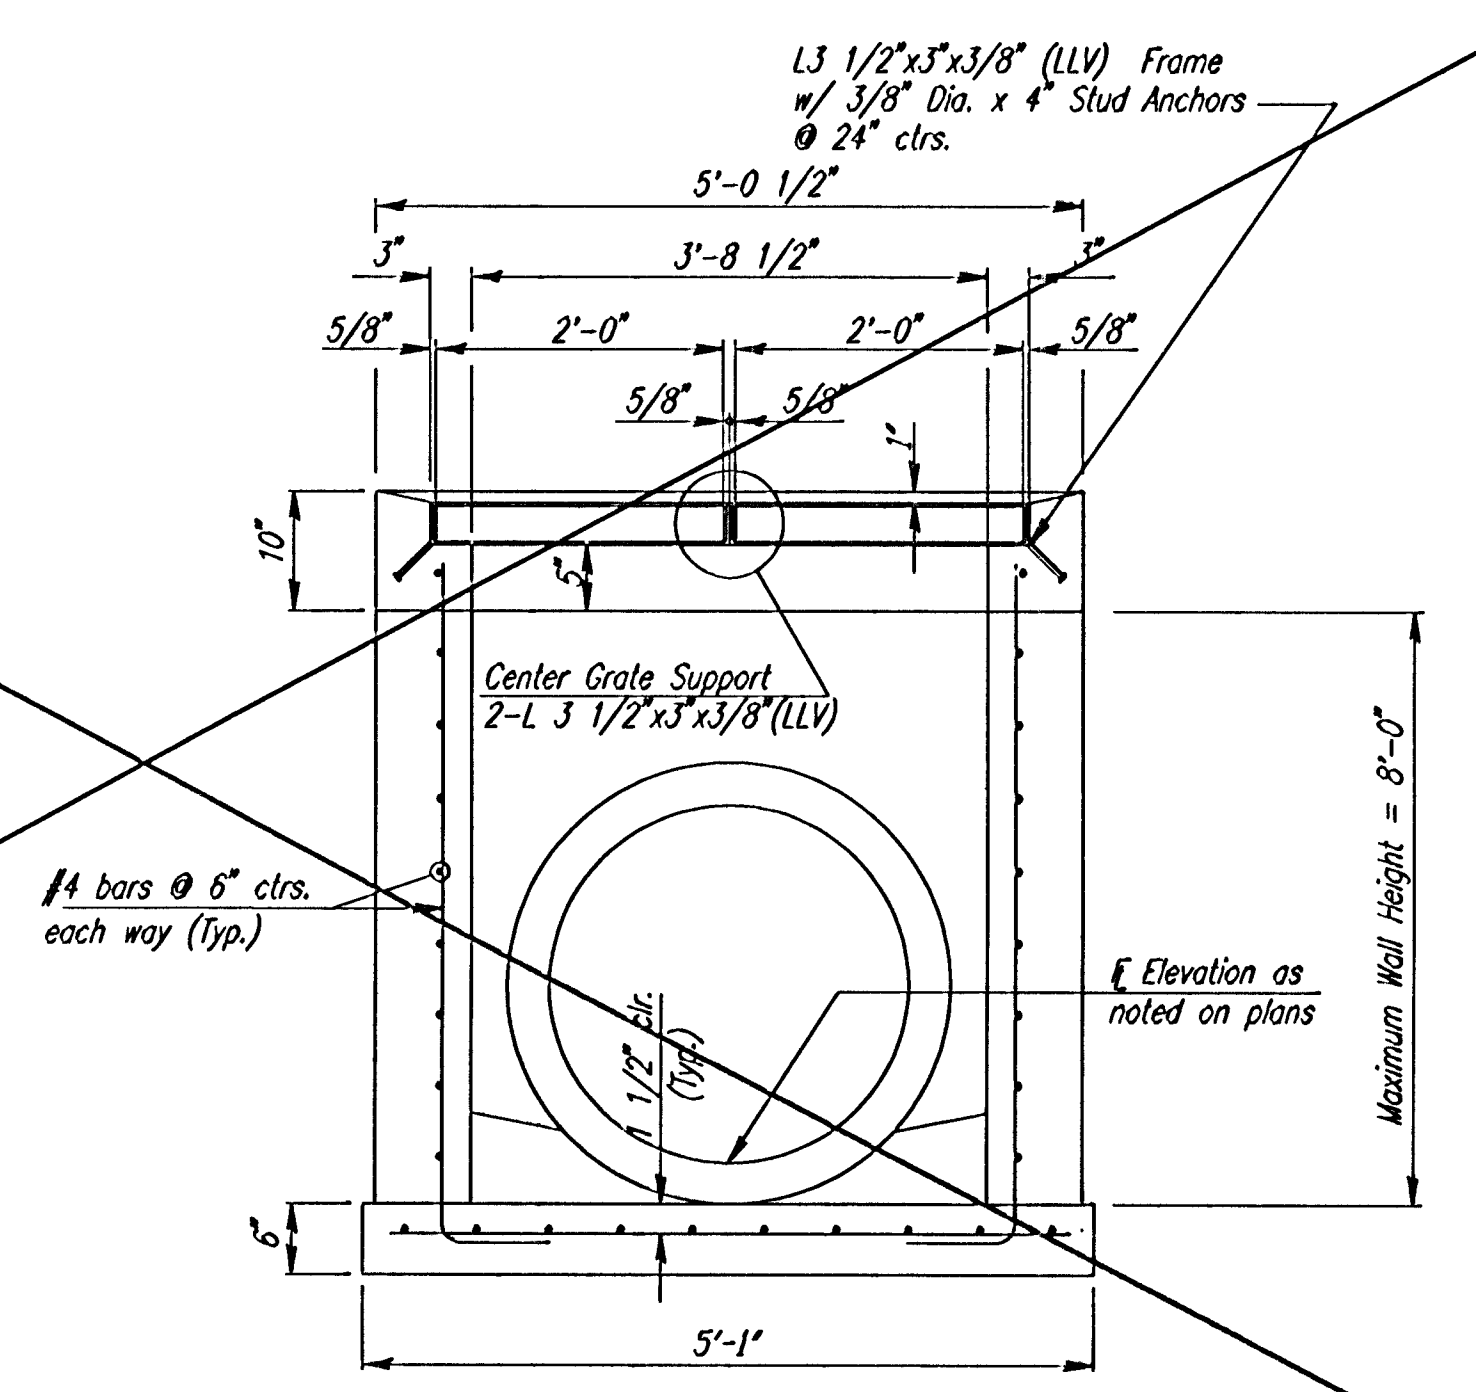


SECTION D-D

SPECIAL AREA INLET

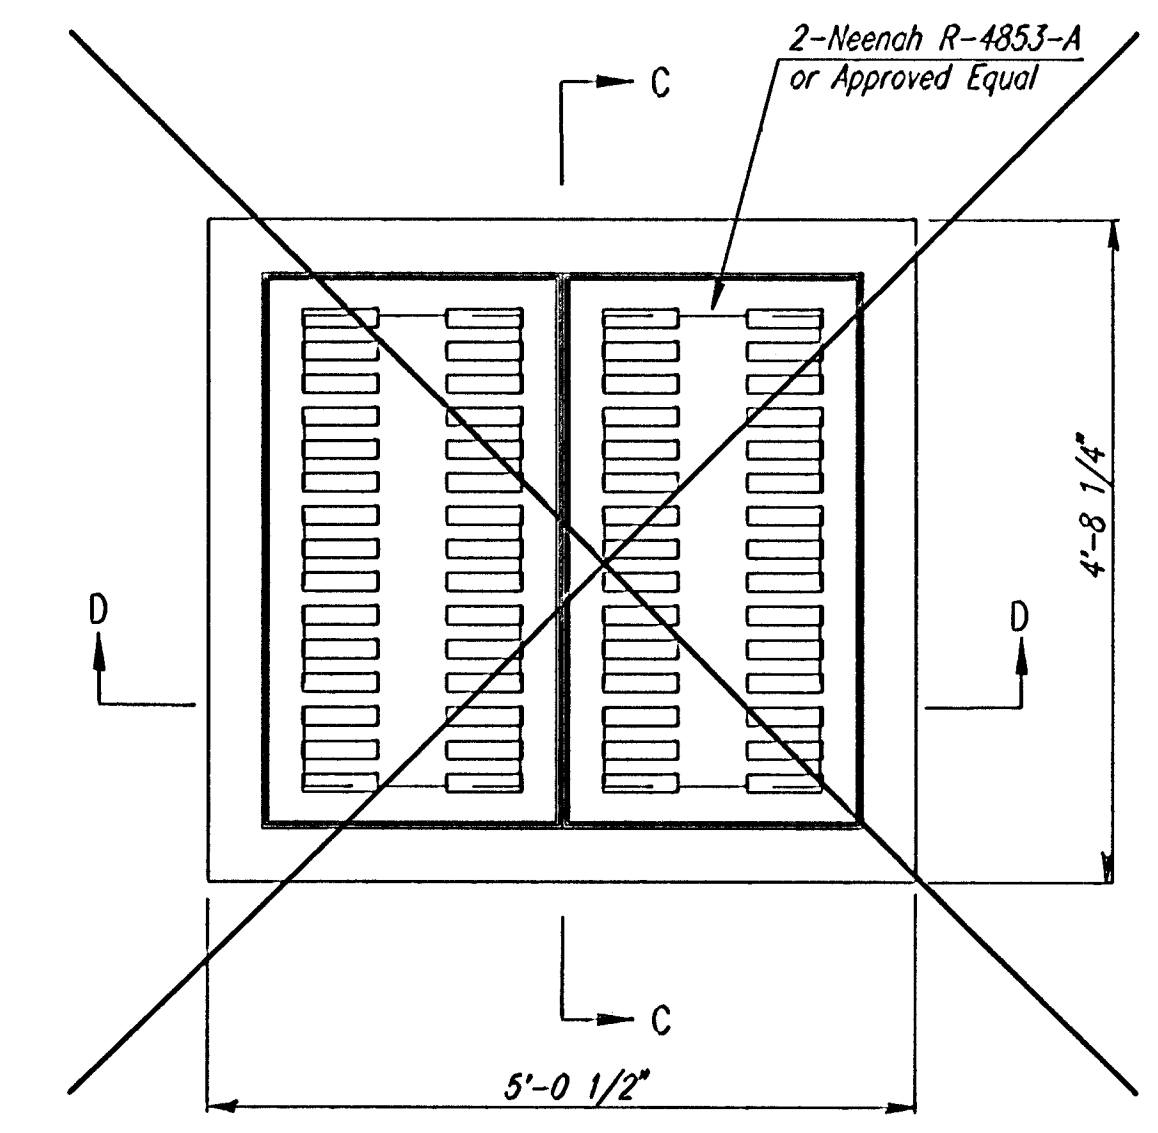

PLAN

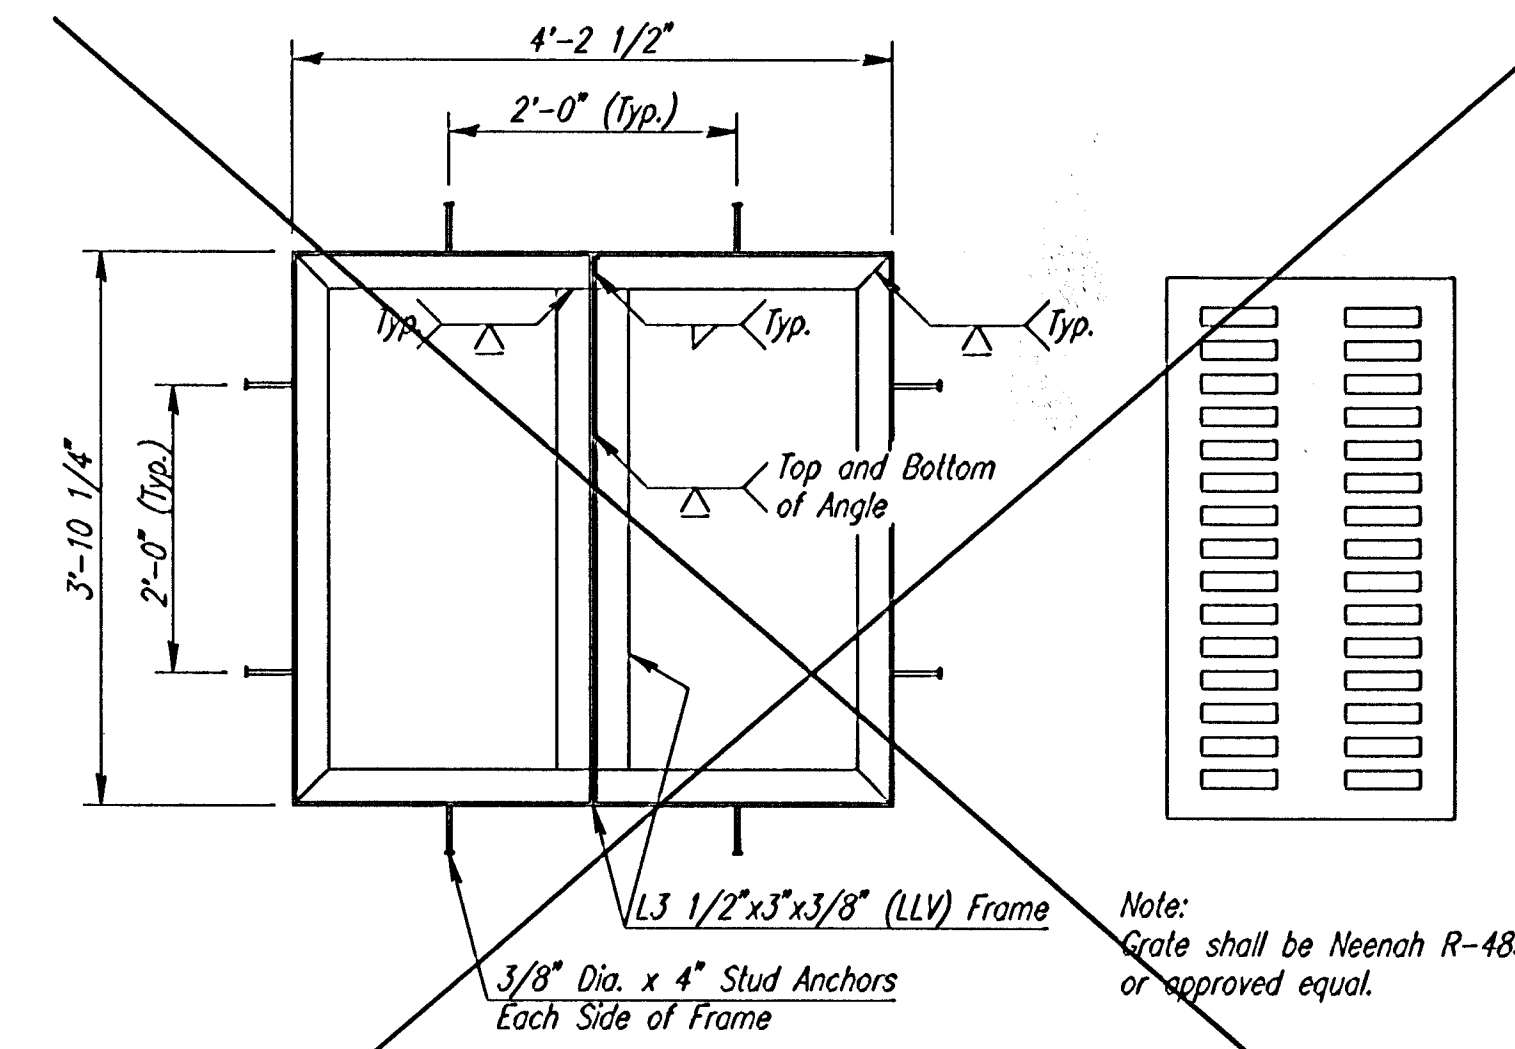

FRAME DETAIL
(For Special Area Inlet)
Note: Frame to mate with 2 Neenah R-4853-A Grates or approved equal.

GRATE DETAIL
(Wt.=520 lbs.)
(2 Required)

DSNR: BER OPER: DEP SCALE: 1"=4'-00"
 C:\2001\01054\000\37th\PEDAREINLET - 11-14-2001 11:17:55 am

37TH STREET NORTH

AREA INLET DETAILS

Professional Engineering Consultants, P.A.
 303 S. TOPEKA • WICHITA, KANSAS 67202
 316-262-2691 • FAX 316-262-3003

Designed by DRC	Checked by
Drawn by DEP	Date JUNE, 2000 Job No. 01034