


LATERAL 42, DISTRICT T, SANITARY SEWER NO. 12

84115

TO SERVE 21ST STREET KIDS AND FAMILY EMPOWERMENT IN THE CITY OF WICHITA, KANSAS

OCA NO. 622099
CITY OF WICHITA PROJECT NO. 468-84115
JAMES L. ARMOUR, P.E. - CITY ENGINEER

*WB Carter Construction Co., Inc. - Contractor
Oetken, City - Inspector
Released 4/18/06
Per Plan
Stub
.pdf by JDL 8/10/06*

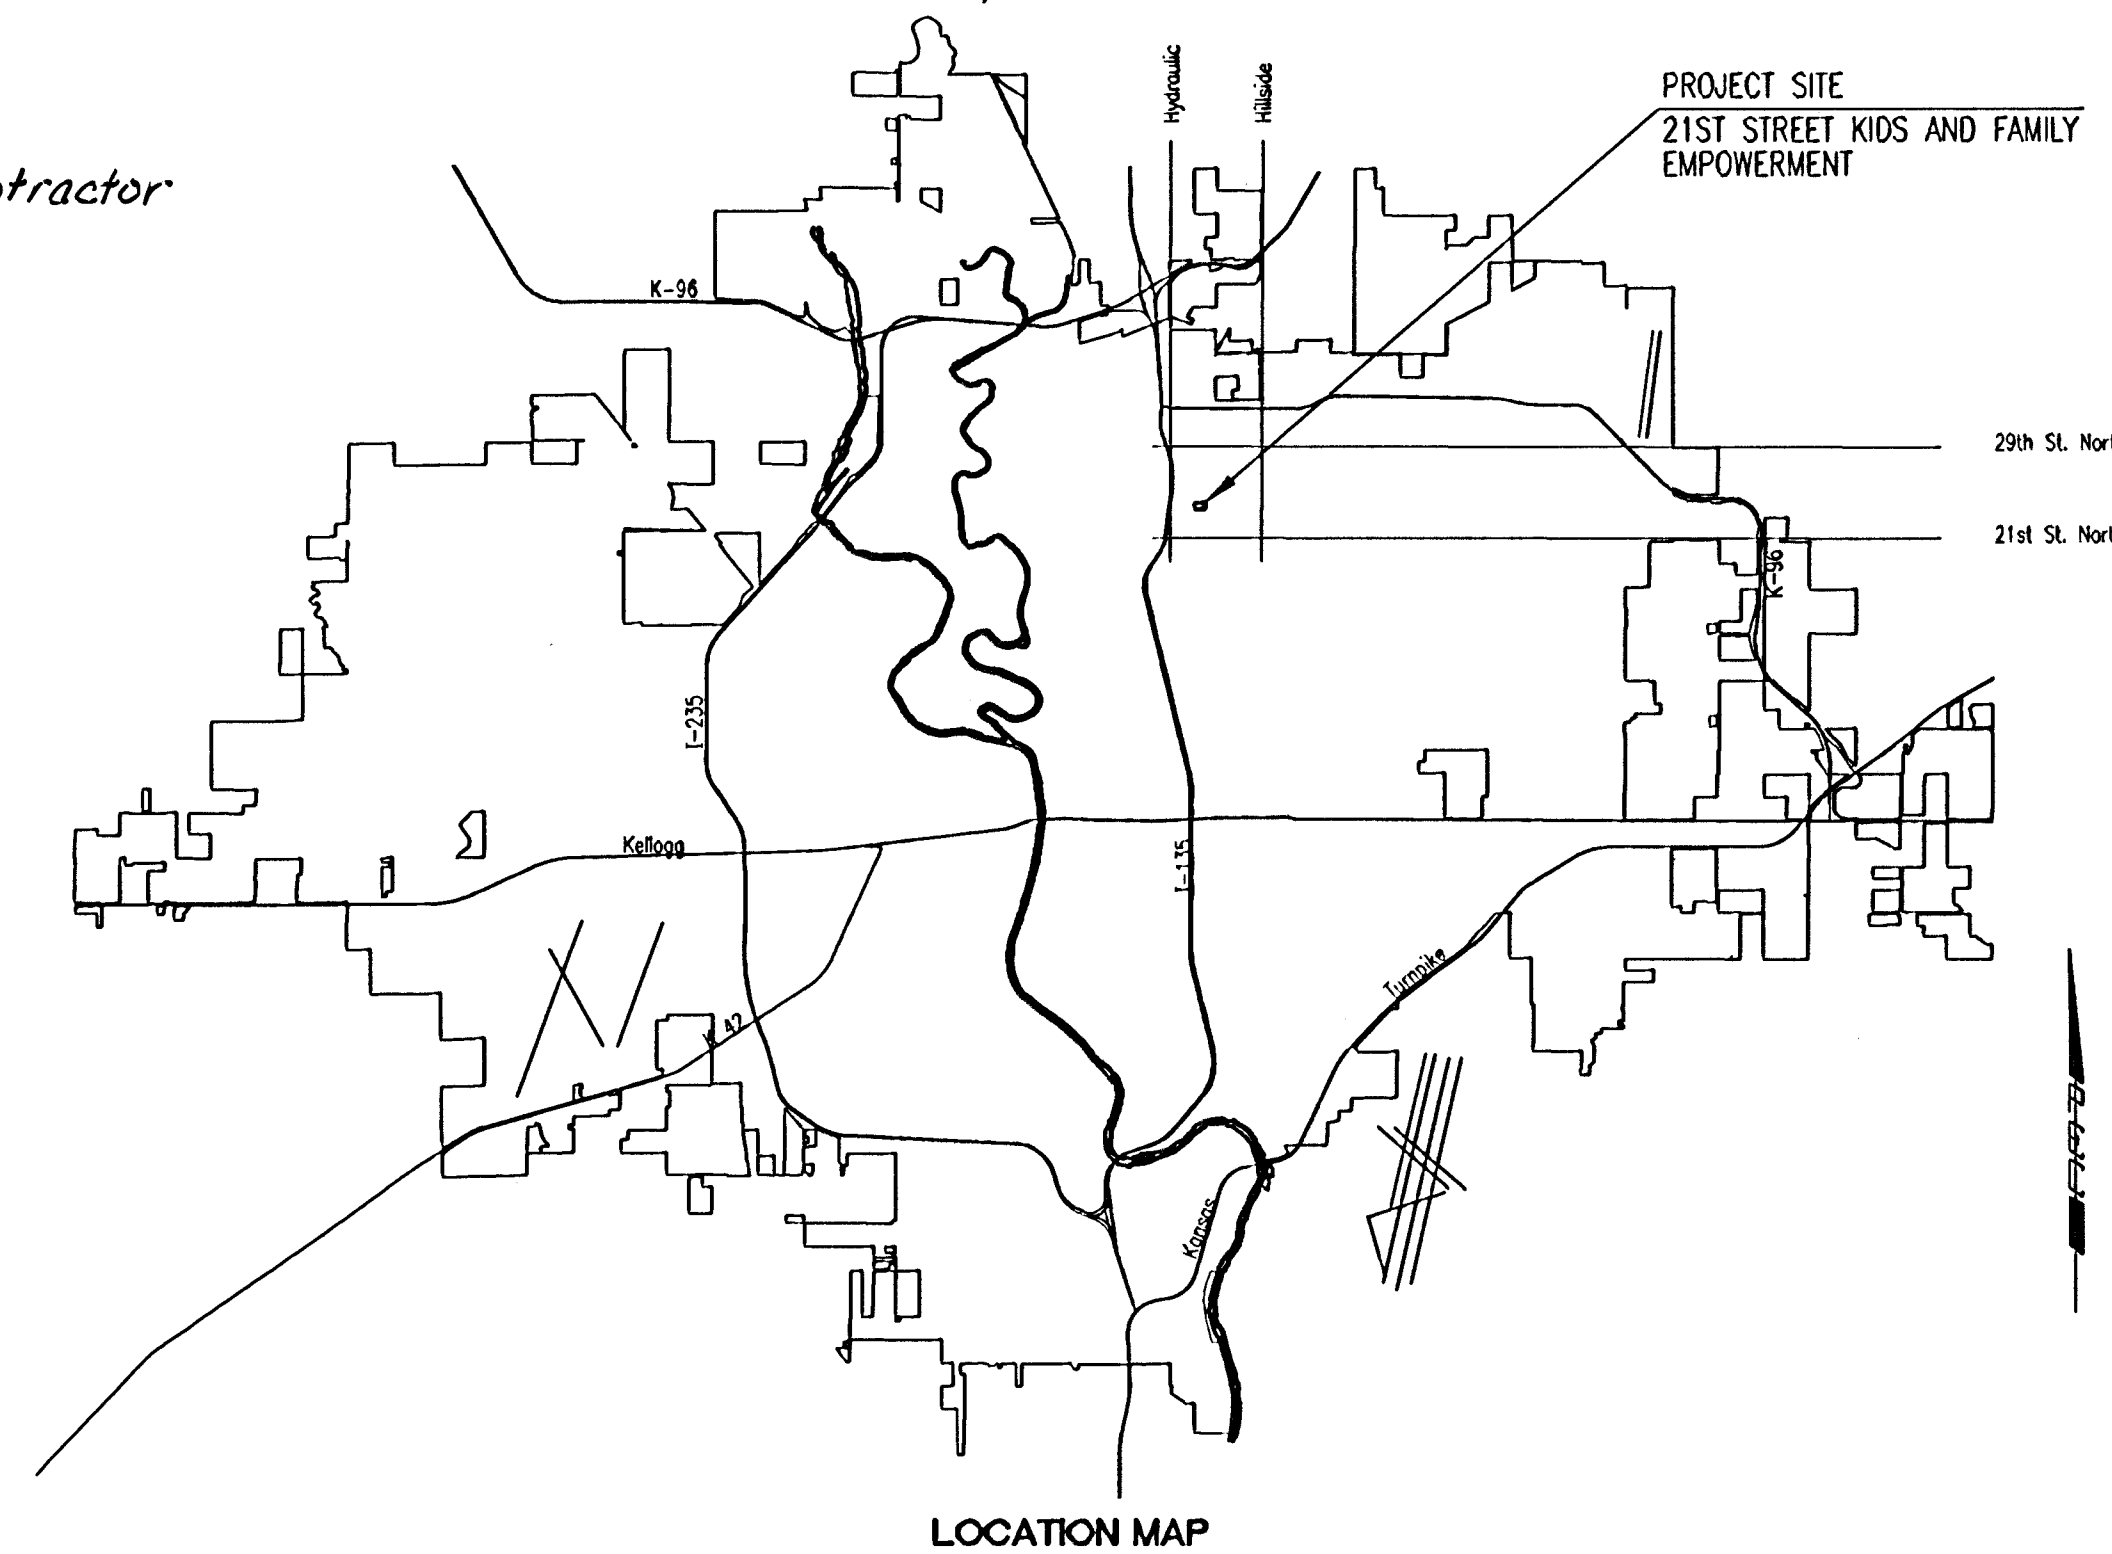

INDEX OF SHEETS

SHEET NO. 1	TITLE SHEET
SHEET NO. 2	KEY MAP AND GENERAL NOTES
SHEET NO. 3	PLAT
SHEET NO. 4	PROJECT COORDINATES
SHEET NO. 5	PLAN/PROFILE
SHEET NO. 6	TYPE "P" MANHOLE DETAILS
SHEET NO. 7	FRAME & COVER DETAILS
SHEET NO. 8	RISER DETAILS
SHEET NO. 9-12	SOIL EROSION BMP DETAILS

CONSTRUCTION SCHEDULE/SEQUENCE

THE CONTRACTOR FOR EACH OF THE FOLLOWING 21ST STREET KIDS AND FAMILY EMPOWERMENT PROJECTS SHALL COORDINATE THEIR EFFORTS WITH EACH OTHER SUCH THAT ANY NECESSARY SIMULTANEOUS CONSTRUCTION CAN PROCEED CONCURRENTLY WITHOUT CAUSING UNDUE DELAYS SO THAT ALL CONSTRUCTION CAN BE COMPLETED ON OR BEFORE THE DATES INDICATED.

SANITARY SEWER

THE CONTRACTOR SHALL COMPLETE THE 21ST STREET KIDS AND FAMILY EMPOWERMENT SANITARY SEWER CONSTRUCTION (PROJECT NO. 468-84115) BY JANUARY 25, 2006.

WATERLINES

THE CONTRACTOR SHALL COMPLETE THE 21ST STREET KIDS AND FAMILY EMPOWERMENT WATERLINE CONSTRUCTION (PROJECT NO. 448-90143) BY JANUARY 30, 2006.

STREETS/DRAINAGE

THE CONTRACTOR SHALL COMPLETE THE 21ST STREET KIDS AND FAMILY EMPOWERMENT STREET/DRAINAGE CONSTRUCTION (PROJECT NO. 472-84282) BY MAY 1, 2006.

NOVEMBER 2005

PLANS PREPARED BY
PROFESSIONAL ENGINEERING CONSULTANTS, P.A.
ENGINEERS
WICHITA, KANSAS

