

LATERAL 11, MAIN 7
OF THE
NORTHWEST INTERCEPTOR SEWER
IN
THE CITY OF WICHITA


83900

OCA NO. 744146
CITY OF WICHITA PROJECT NO. 468-83900
JAMES L. ARMOUR, P.E. - CITY ENGINEER

INDEX OF SHEETS

SHEET NO. 1	TITLE SHEET
SHEET NO. 2	KEY MAP AND GENERAL NOTES
SHEET NO. 3	PLAN
SHEET NO. 4-6	PLAN/PROFILE
SHEET NO. 7	TYPE "P" MANHOLE DETAILS
SHEET NO. 8	FRAME & COVER DETAILS
SHEET NO. 9	RISER DETAILS
SHEET NO. 10	SHALLOW MANHOLE DETAILS
SHEET NO. 11-14	SOIL EROSION BMP DETAILS

WB Carter Construction Co., Inc. - Contractor
Koleszek/Sholander, City - Inspectors
Released 2/11/06
Per Plan
Risers & Stubs
.pdf by JDL 5/22/06

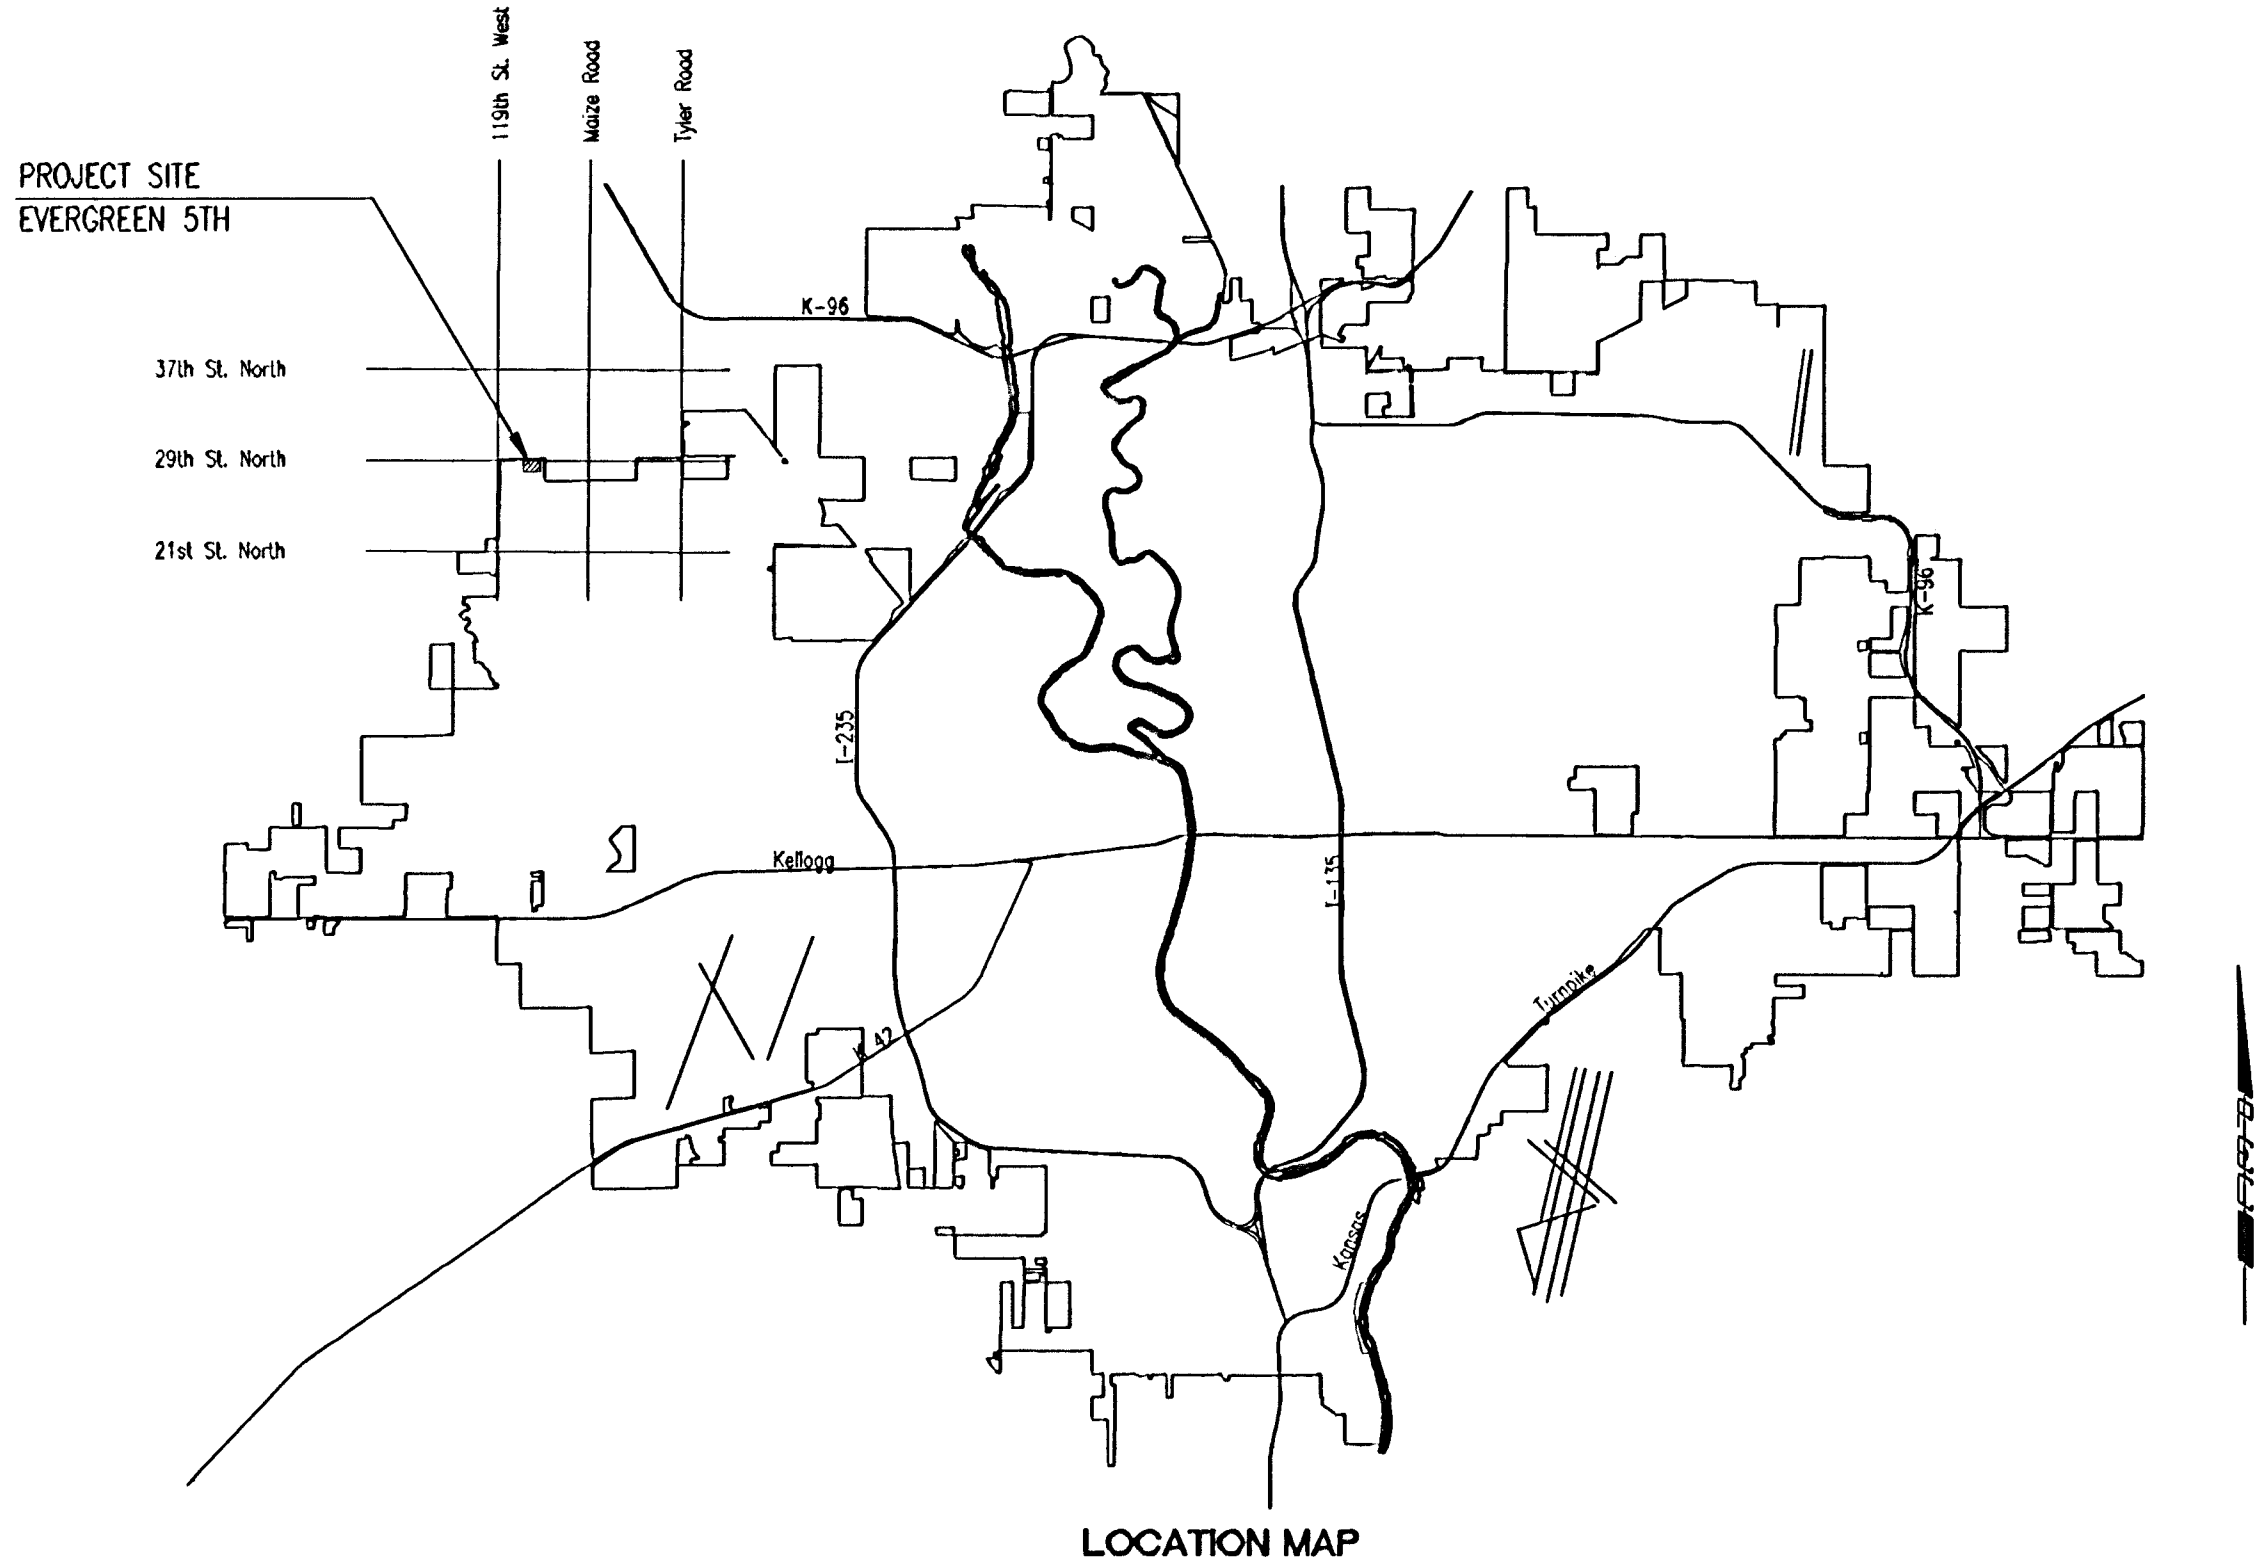

CONSTRUCTION SCHEDULE/SEQUENCE

THE CONTRACTOR FOR EACH OF THE FOLLOWING EVERGREEN 5TH PROJECTS SHALL COORDINATE THEIR EFFORTS WITH EACH OTHER SUCH THAT ANY NECESSARY SIMULTANEOUS CONSTRUCTION CAN PROCEED CONCURRENTLY WITHOUT CAUSING UNDUE DELAYS SO THAT ALL CONSTRUCTION CAN BE COMPLETED ON OR BEFORE THE DATES INDICATED.

SANITARY SEWER

THE CONTRACTOR SHALL COMPLETE THE EVERGREEN 5TH SANITARY SEWER CONSTRUCTION (PROJECT NO. 468-83900) BY JANUARY 6, 2006.

WATERLINES

THE CONTRACTOR SHALL COMPLETE THE EVERGREEN 5TH WATERLINE CONSTRUCTION (PROJECT NO. 448-90013) BY FEBRUARY 3, 2006.

STREETS/DRAINAGE

THE CONTRACTOR SHALL COMPLETE THE EVERGREEN 5TH STREETS/DRAINAGE CONSTRUCTION (PROJECT NO. 472-84103) BY APRIL 14, 2006

OCTOBER 2005

PLANS PREPARED BY
PROFESSIONAL ENGINEERING CONSULTANTS, P.A.
ENGINEERS
WICHITA, KANSAS

