BENCHMARK:
" □ " cut on traffic signal light pole base, NW corner at Kellogg & 143rd Street East.
Elev. = 1318.61 NGVD
(131.21 City Datum)

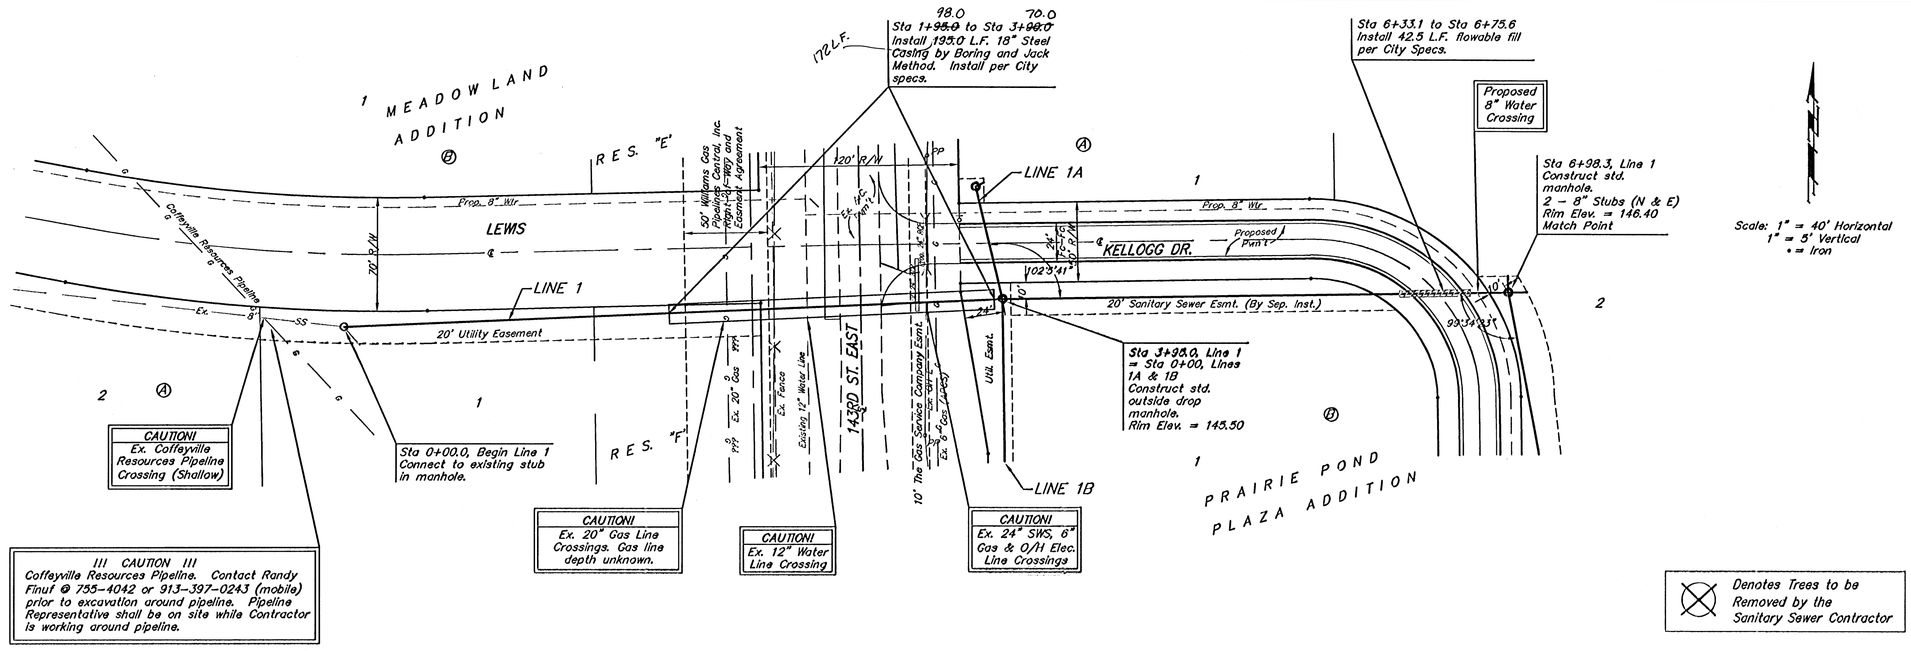

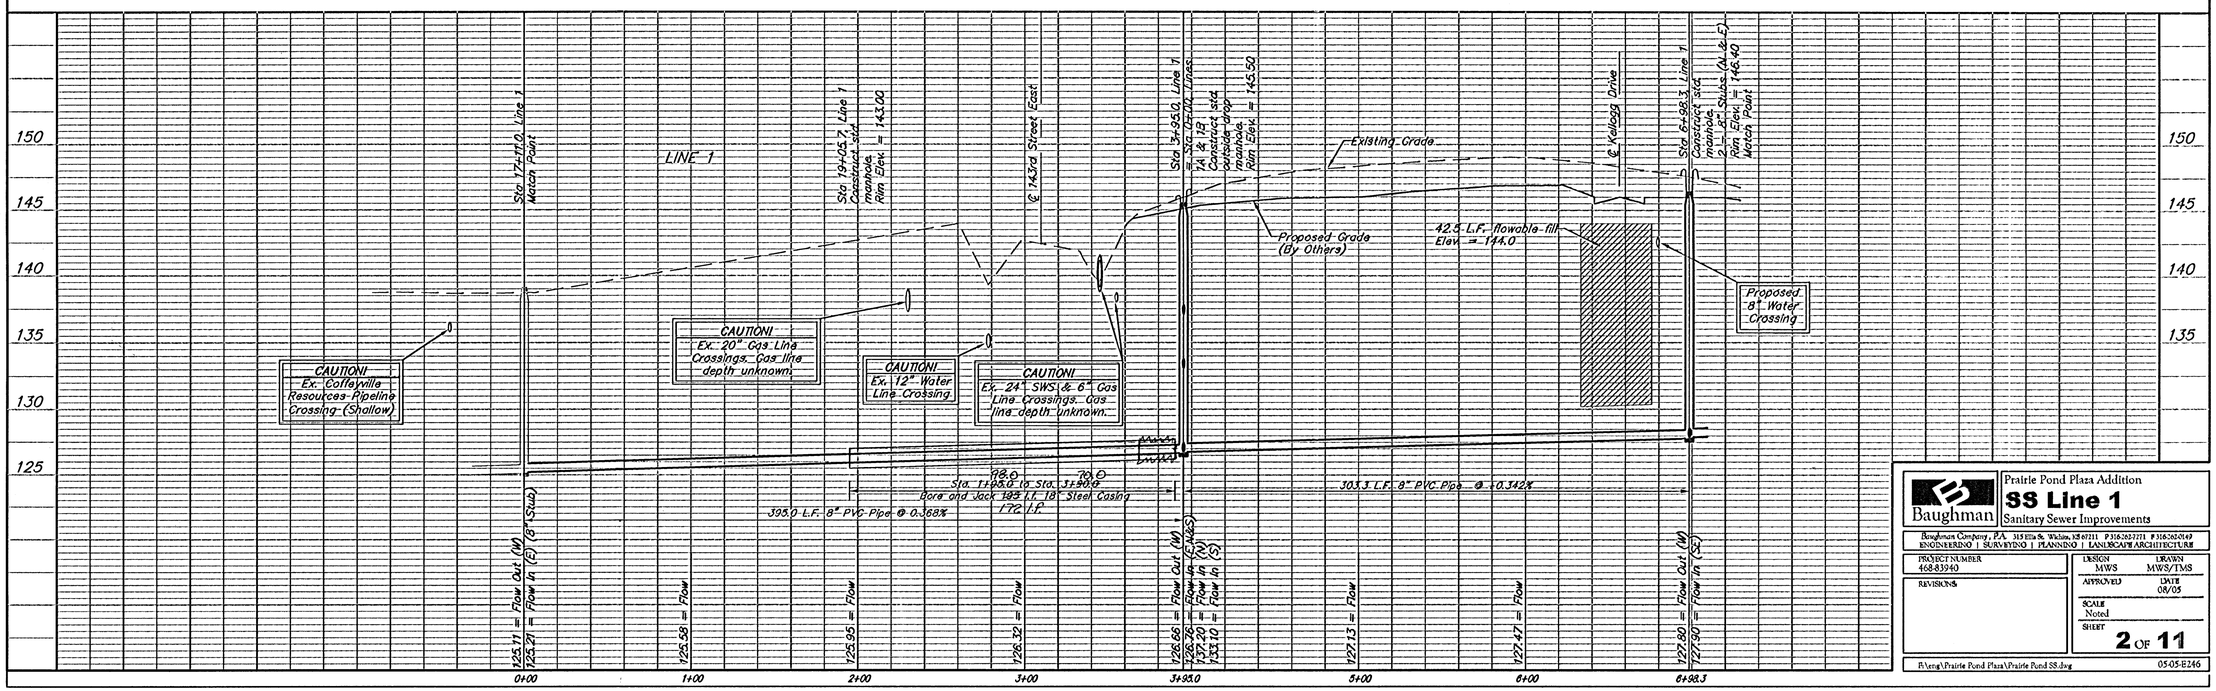

Baughman

Prairie Pond Plaza Addition
SS Line 1
Sanitary Sewer Improvements

Baughman Company, P.A. 315 Ellis St. Wichita, KS 67211 P 316.262.2771 F 316.262.0149
ENGINEERING | SURVEYING | PLANNING | LANDSCAPE ARCHITECTURE

PROJECT NUMBER	DESIGN	DRAWN
468-83940	MWS	MWS/TMS
REVISIONS	APPROVED	DATE 08/05
	SCALE Noted	
	SHEET	2 OF 11

P:\eng\Prairie Pond Plaza\Prairie Pond SS.dwg 05-05-8246