BENCHMARK:
" □ " cut on traffic signal light pole base, NW corner of Kellogg & 143rd Street East.
Elev. = 1318.61 NGVD
(131.21 City Datum)

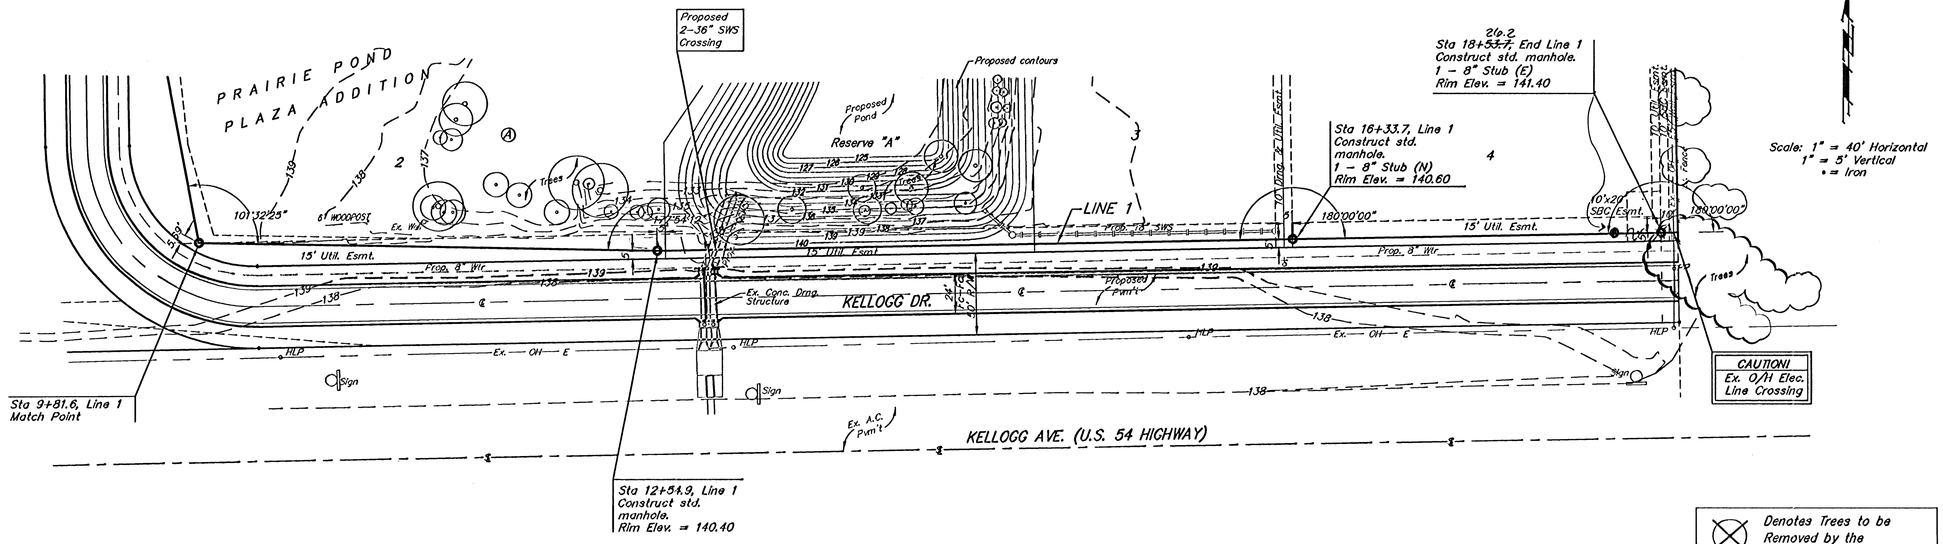

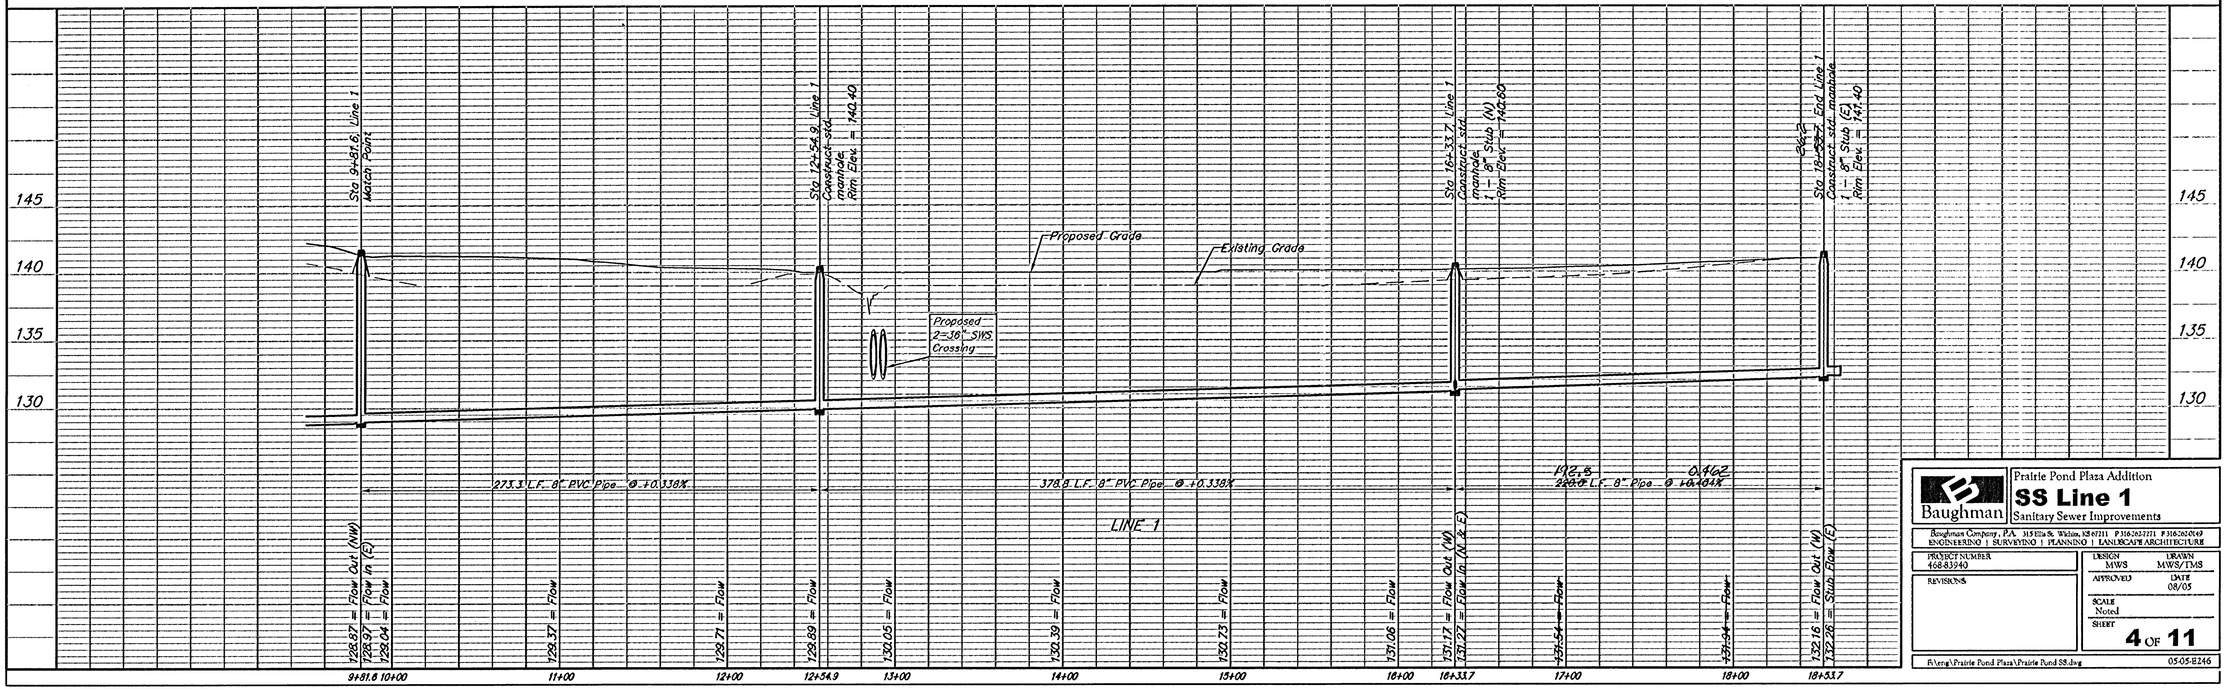

Baughman

Prairie Pond Plaza Addition
SS Line 1
Sanitary Sewer Improvements

Baughman Company, P.A. 315 Ella St. Wichita, KS 67211 P 316.263.7721 F 316.263.0749
ENGINEERING | SURVEYING | PLANNING | LANDSCAPE ARCHITECTURE

PROJECT NUMBER 468-83940	DESIGN MWS / DRAWN MWS/TMS
REVISIONS	APPROVED / DATE 08/05
	SCALE Noted
	SHEET 4 OF 11

F:\eng\Prairie Pond Plaza\Prairie Pond SS.dwg 05-05-8246