


BENCHMARK:
Arkansas River bridge & 63rd St. S. City of
Wichita Benchmark Disc. SW Cor. of bridge,
top of hubguard. 500'± E. of Grove.
Elev. = 1269.95 NGVD29 (per City record)

Brass plate on the NE wingwall of Arkansas
River bridge & 63rd St. S.
Elev. = 1267.48 NGVD29 (per County record)

SCALE:
1" = 20' HORIZONTAL
1" = 5' VERTICAL
• = IRON


POND DATA:
STATIC POOL ELEVATION: 1246.6 NGVD29
100 YEAR DWS: 1256.0 NGVD29

RESERVE "B"

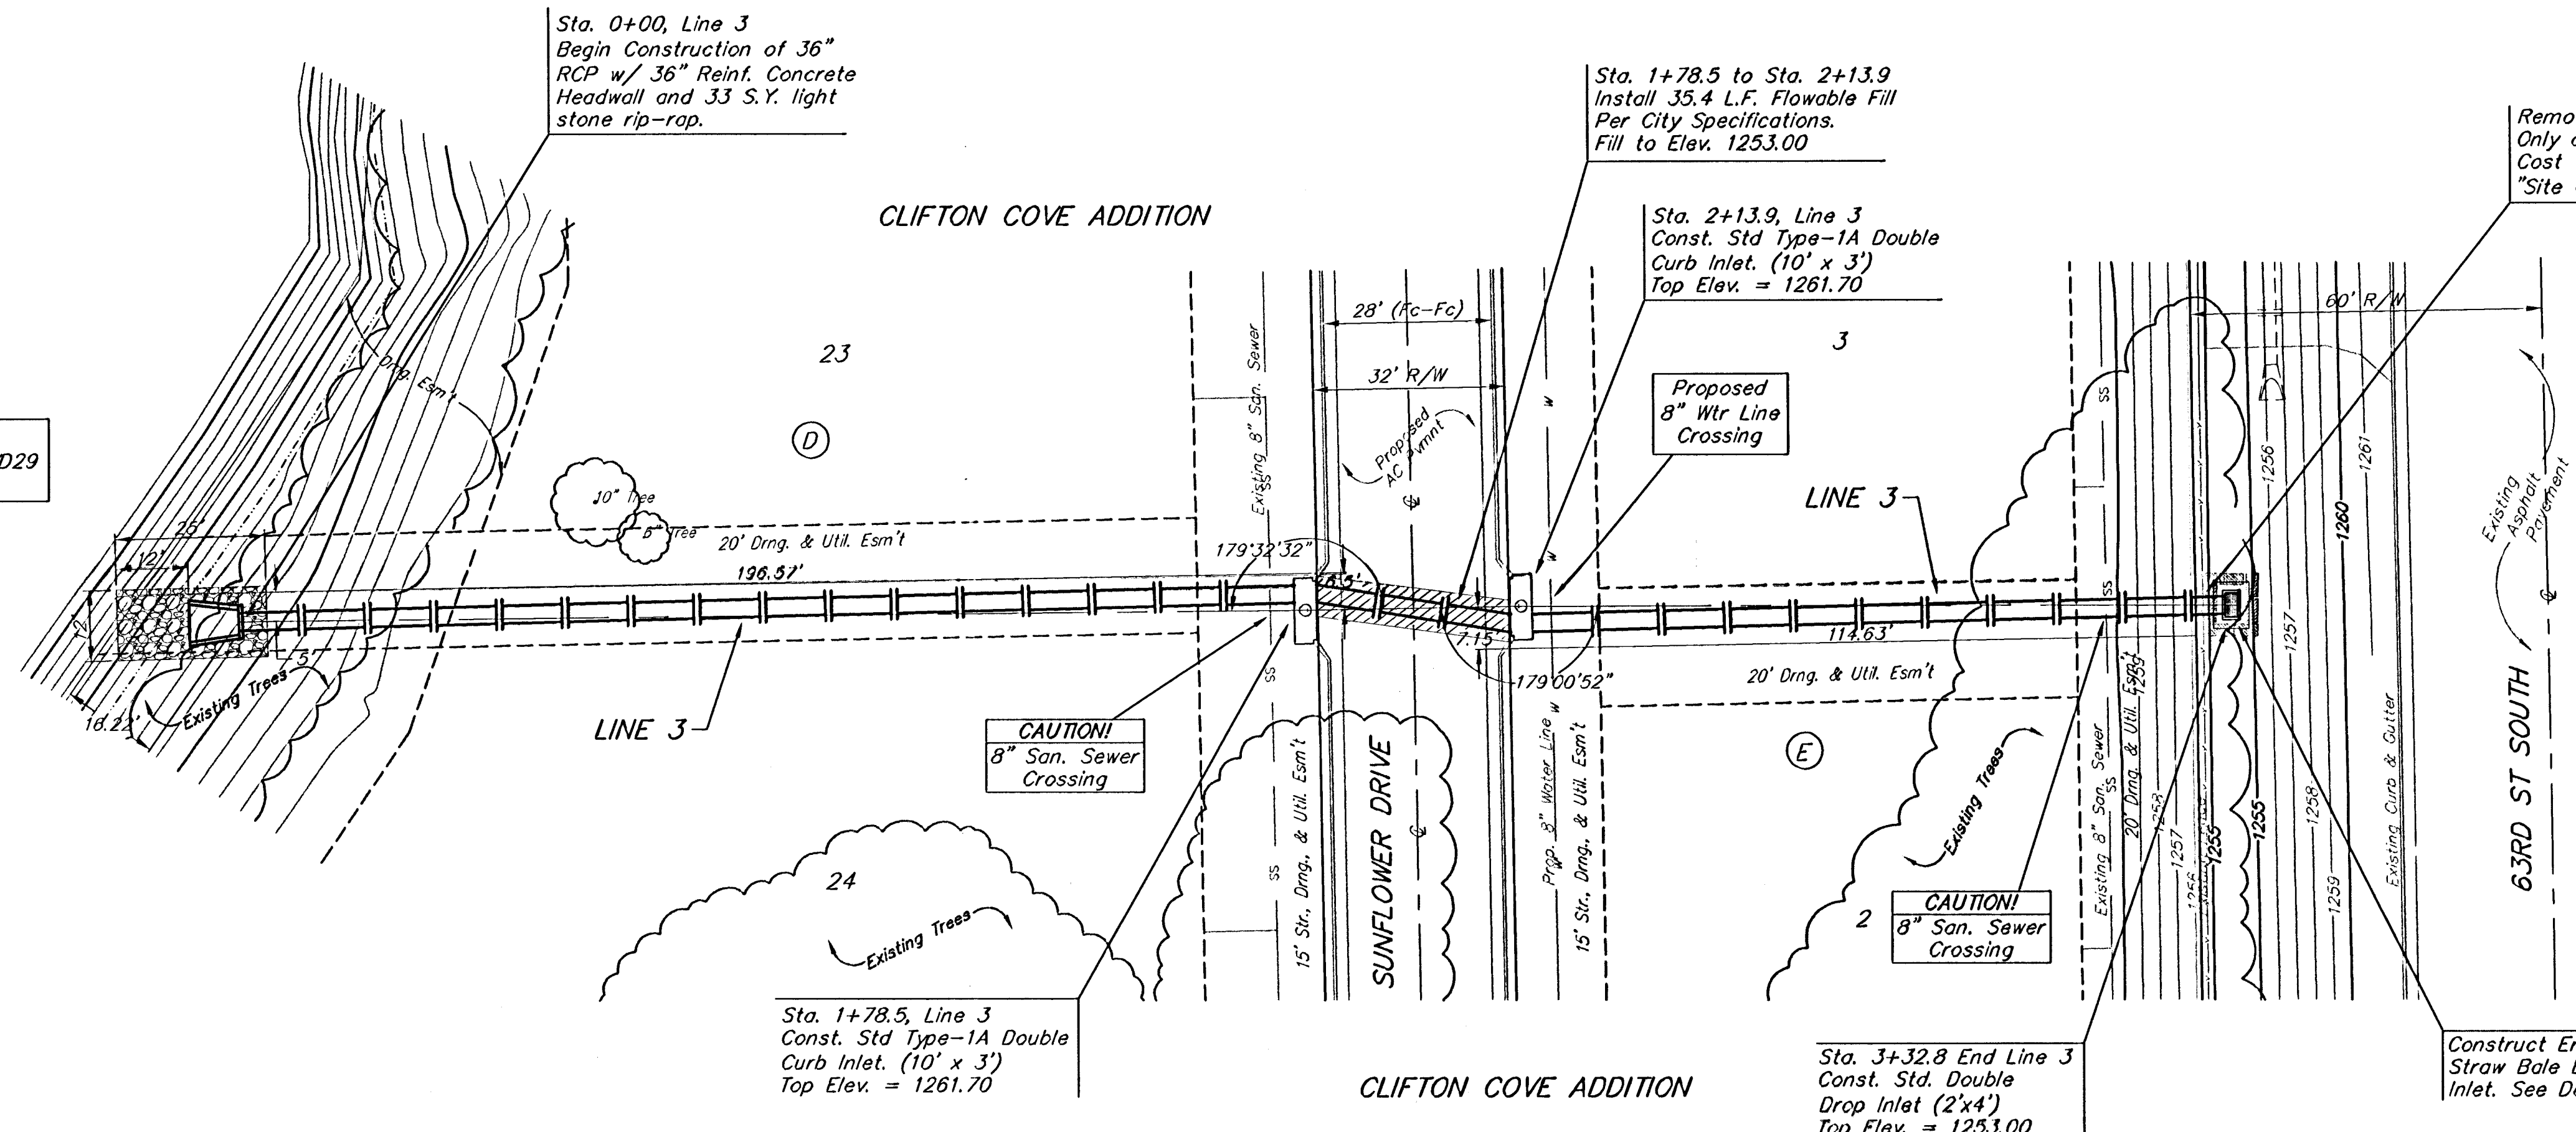

Remove Existing Trees Only as ABSOLUTELY Necessary For Construction. Trees Not in Direct Conflict With Proposed New Construction Shall Remain And Be Protected From Damage. Cost to be Included in Bid Item "Site Clearing & Restoration"

Construct Erosion Control Straw Bale Barrier Around Inlet. See Detail, Sheet 28.

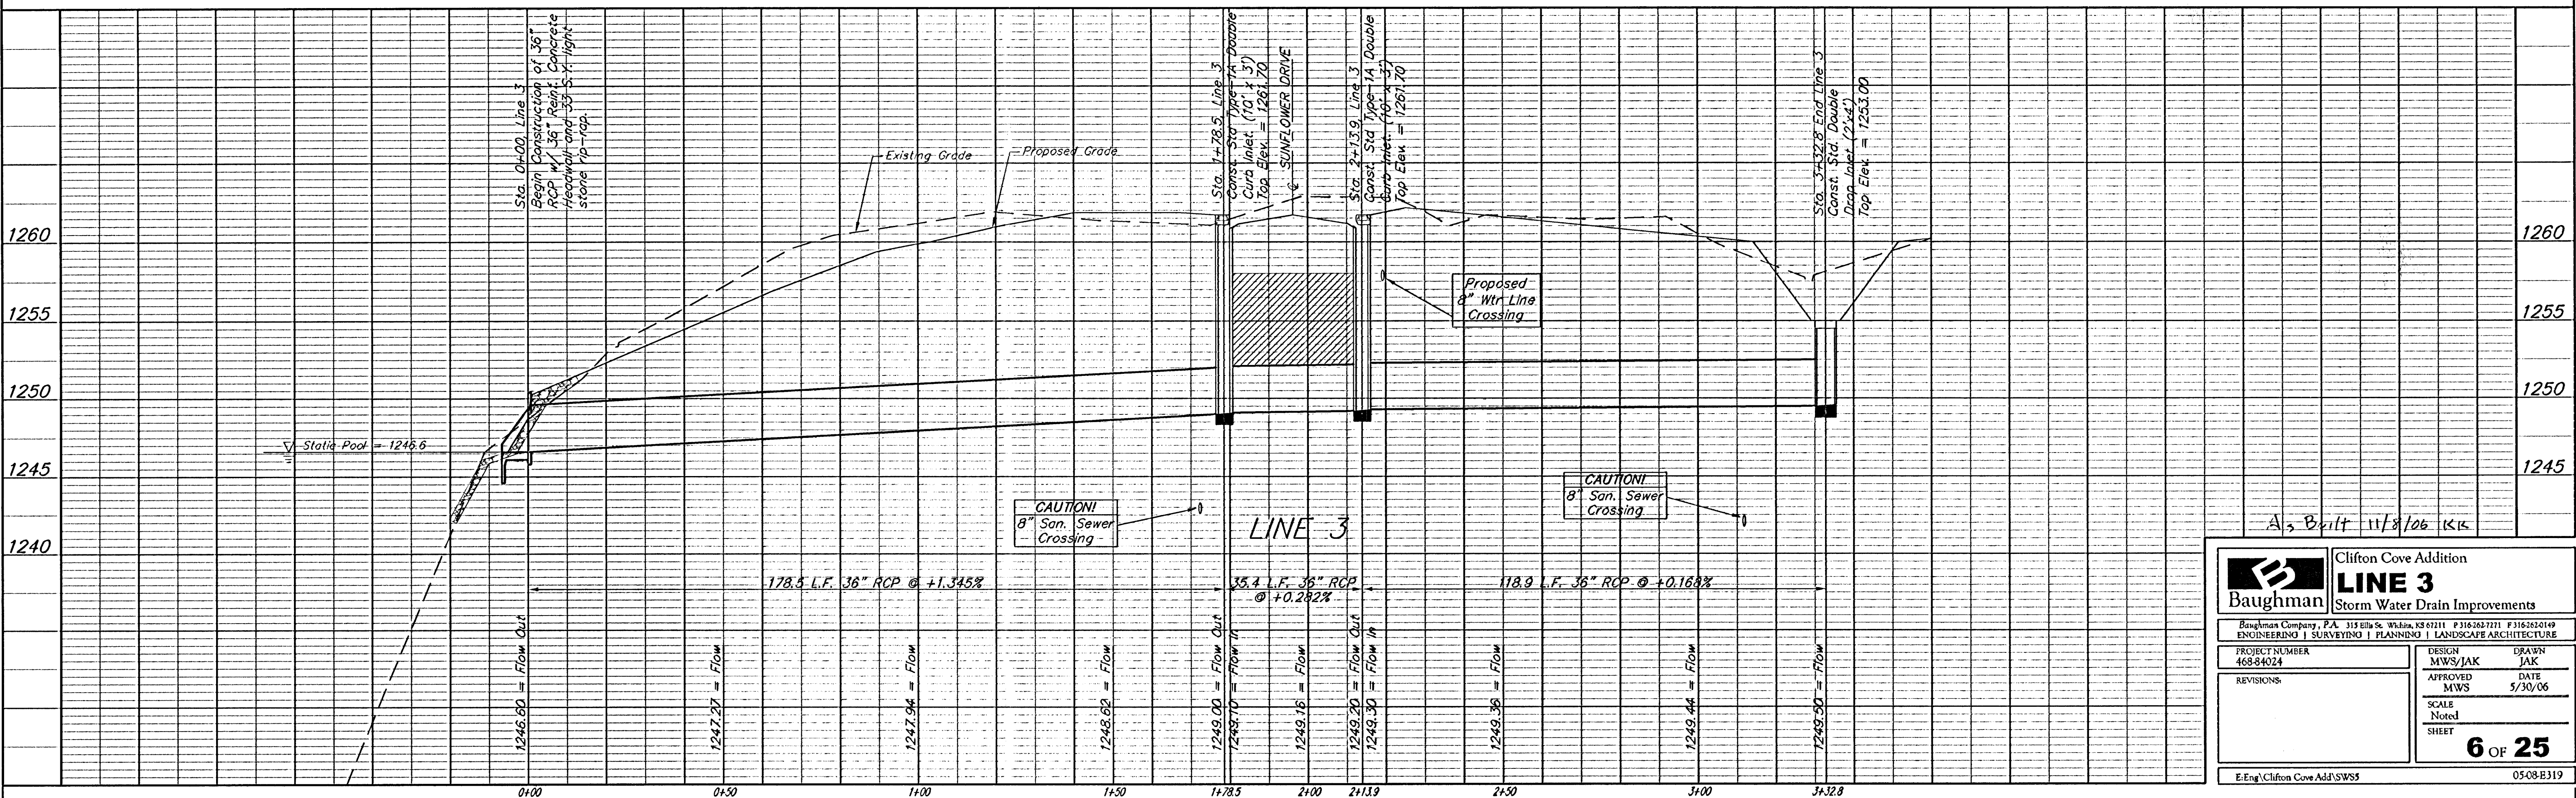

A3 Bilt 11/8/06 KLB

Baughman		Clifton Cove Addition	
LINE 3		Storm Water Drain Improvements	
Baughman Company, P.A. 315 Ellis St. Wichita, KS 67211 P 316-262-7271 F 316-262-0149 ENGINEERING SURVEYING PLANNING LANDSCAPE ARCHITECTURE			
PROJECT NUMBER 468-84024	DESIGN MWS/JAK	DRAWN JAK	
REVISIONS:	APPROVED MWS	DATE 9/30/06	
SCALE Noted		SHEET	
		6 OF 25	
E:\Eng\Clifton Cove Add\SWSS		05-08-B319	