
BENCHMARK:
Arkansas River bridge & 63rd St. S. City of Wichita Benchmark Disc. SW Cor. of bridge, top of hubguard. 500'± E. of Grove.
Elev. = 1269.95 NGVD29 (per City record)

Brass plate on the NE wingwall of Arkansas River bridge & 63rd St. S.
Elev. = 1267.48 NGVD29 (per County record)


POND DATA:
STATIC POOL ELEVATION: 1246.6 NGVD29
100 YEAR DWS: 1256.0 NGVD29

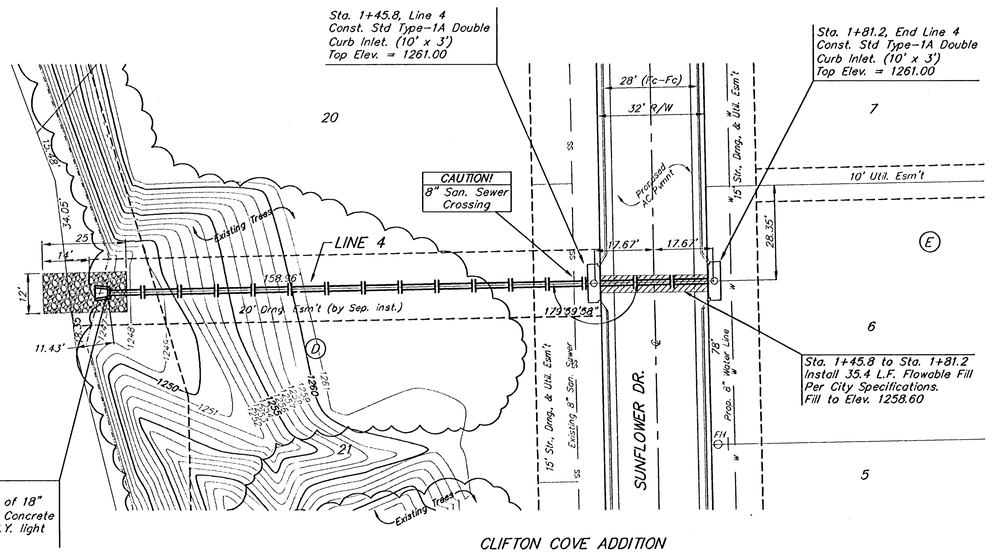

CLIFTON COVE ADDITION

SCALE:
1" = 20' HORIZONTAL
1" = 5' VERTICAL
• = IRON

Remove Existing Trees Only as ABSOLUTELY Necessary For Construction. Trees Not In Direct Conflict With Proposed New Construction Shall Remain And Be Protected From Damage. Cost to be Included in Bid Item "Site Clearing & Restoration"

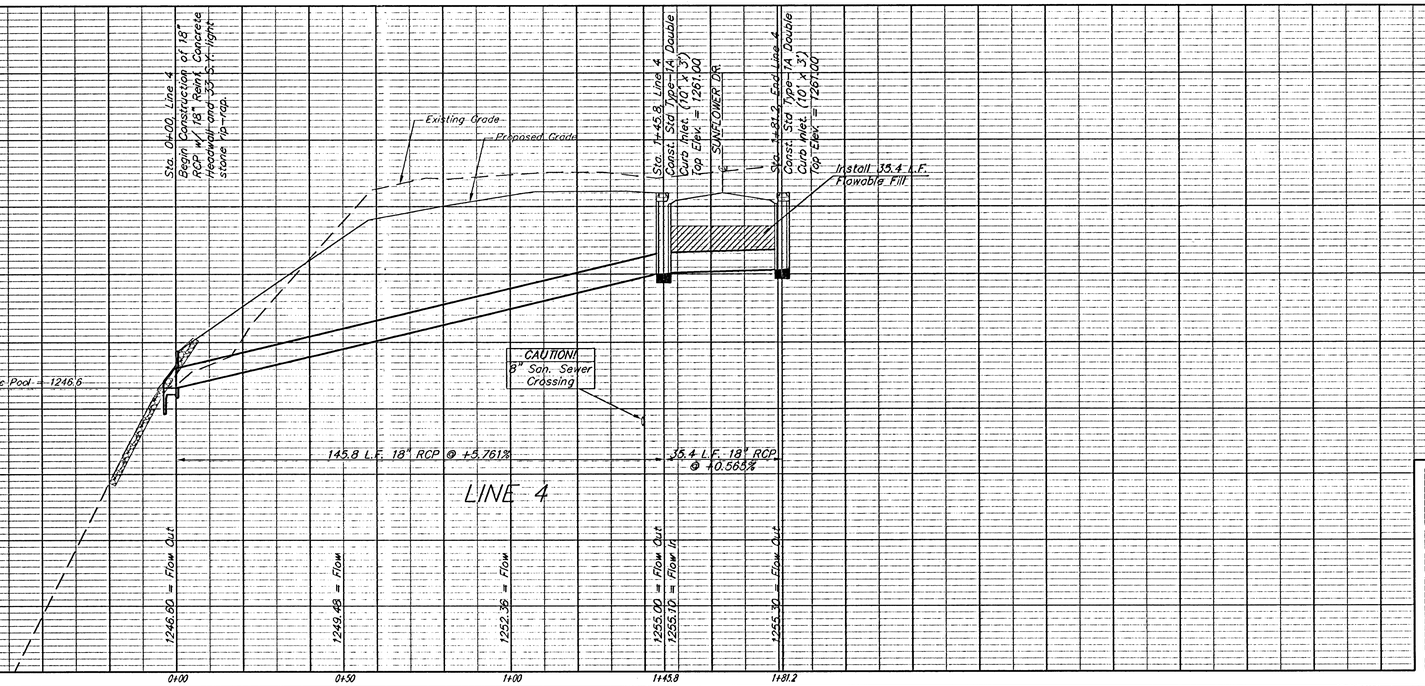

As Built 11/8/06 LAK

Baughman

Clifton Cove Addition
LINE 4
Storm Water Drain Improvements

Baughman Company, P.A. 315 Ella St. Wichita, KS 67211 P 316.262.7271 F 316.262.0149
ENGINEERING | SURVEYING | PLANNING | LANDSCAPE ARCHITECTURE

PROJECT NUMBER 468-84024
REVISIONS
DESIGN MWS/JAK
DRAWN JAK
APPROVED MWS
DATE 5/30/06
SCALE Noted
SHEET 7 OF 25

E:Eng\Clifton Cove Add\SWS6
05-08-E319