


PROFILE	CHECKED	BY	DATE
	CHECKED		

DSNR: OPER: JGA SCALE: 1=40.00

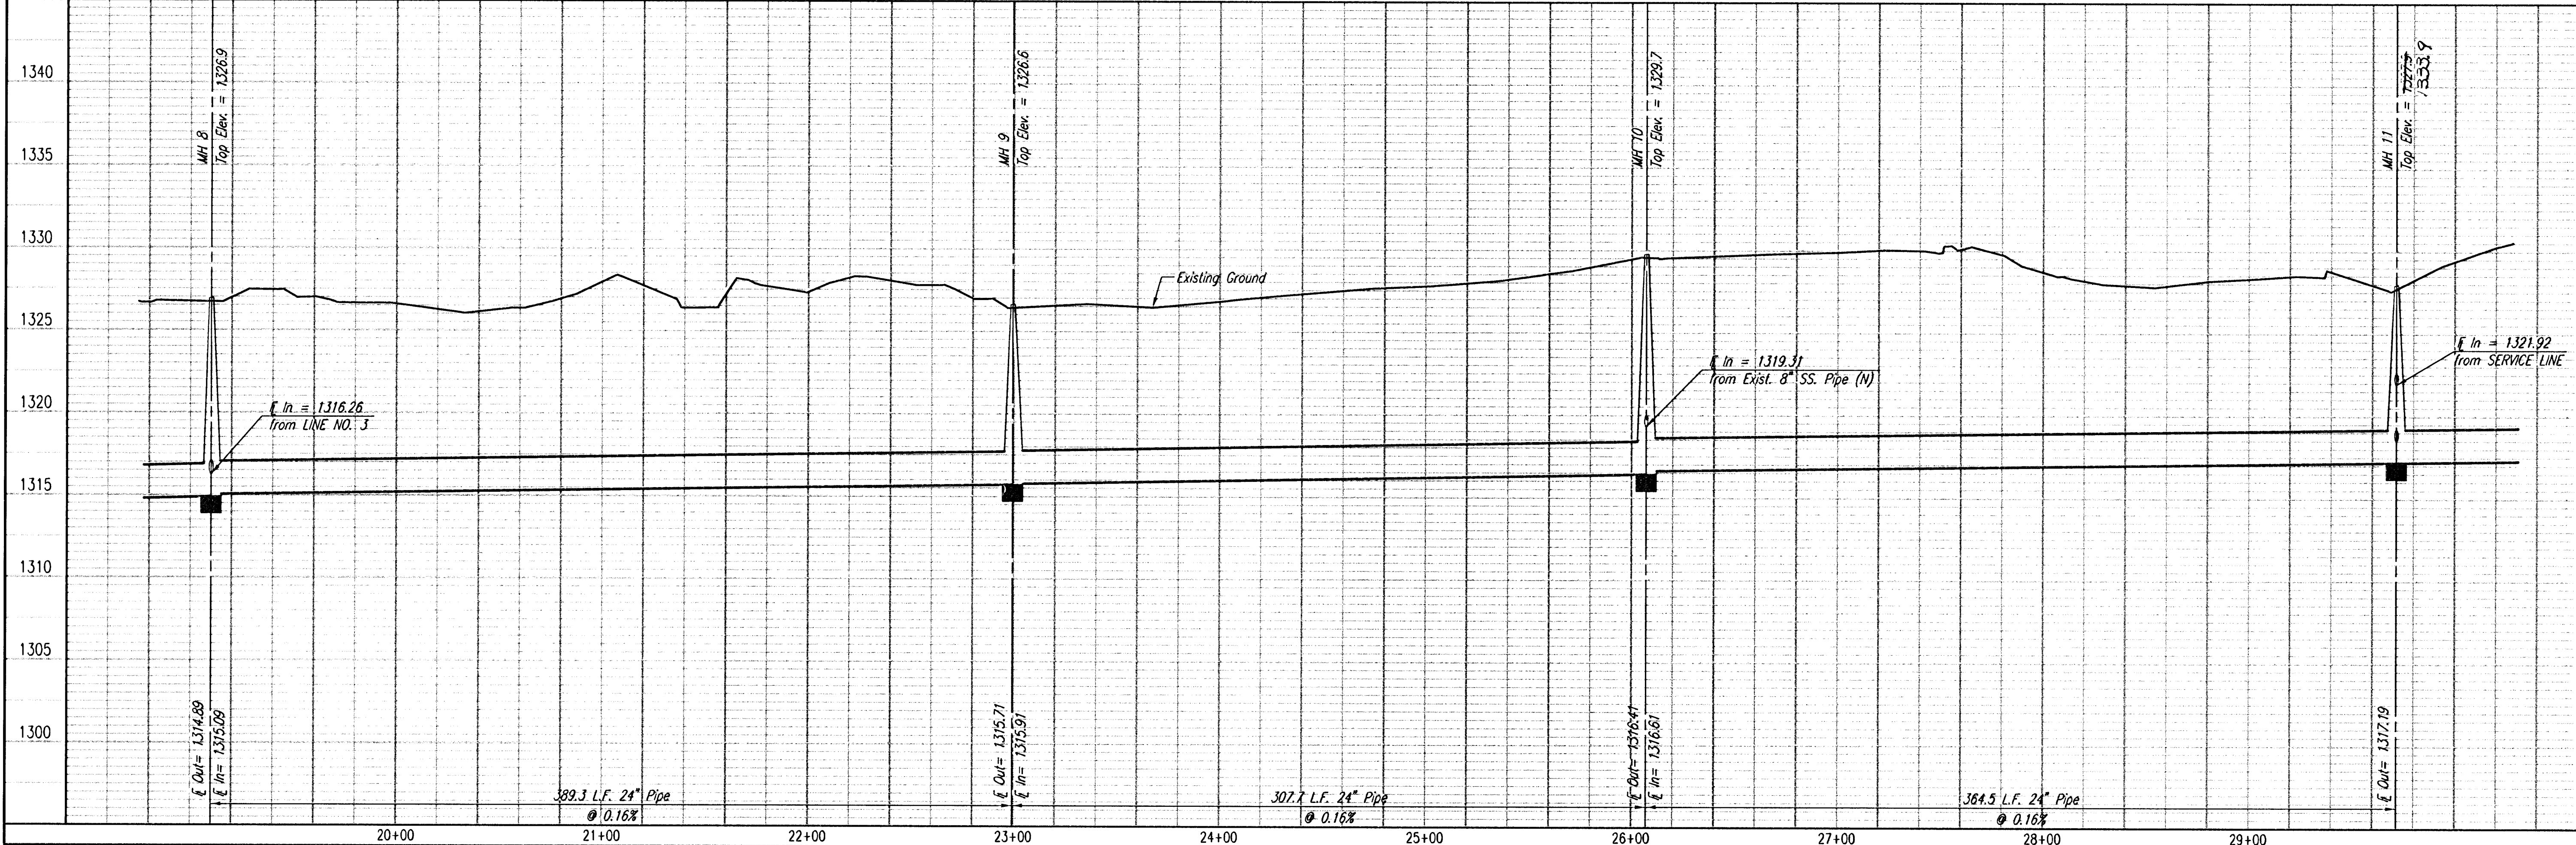

MAIN 17, FOUR MILE CREEK
CRESTVIEW SEWER - PHASE 1

JAMES L. ARMOUR, P.E. - ACTING CITY ENGINEER
CITY OF WICHITA PROJECT NO. 468-83903

Designed By	MUK	Job No.	35-02
Drawn By	JCA	Date	JULY 2

Designed By	MDK	Job No.
Drawn By	JGA	Date

Designed By	
Drawn By	

23