
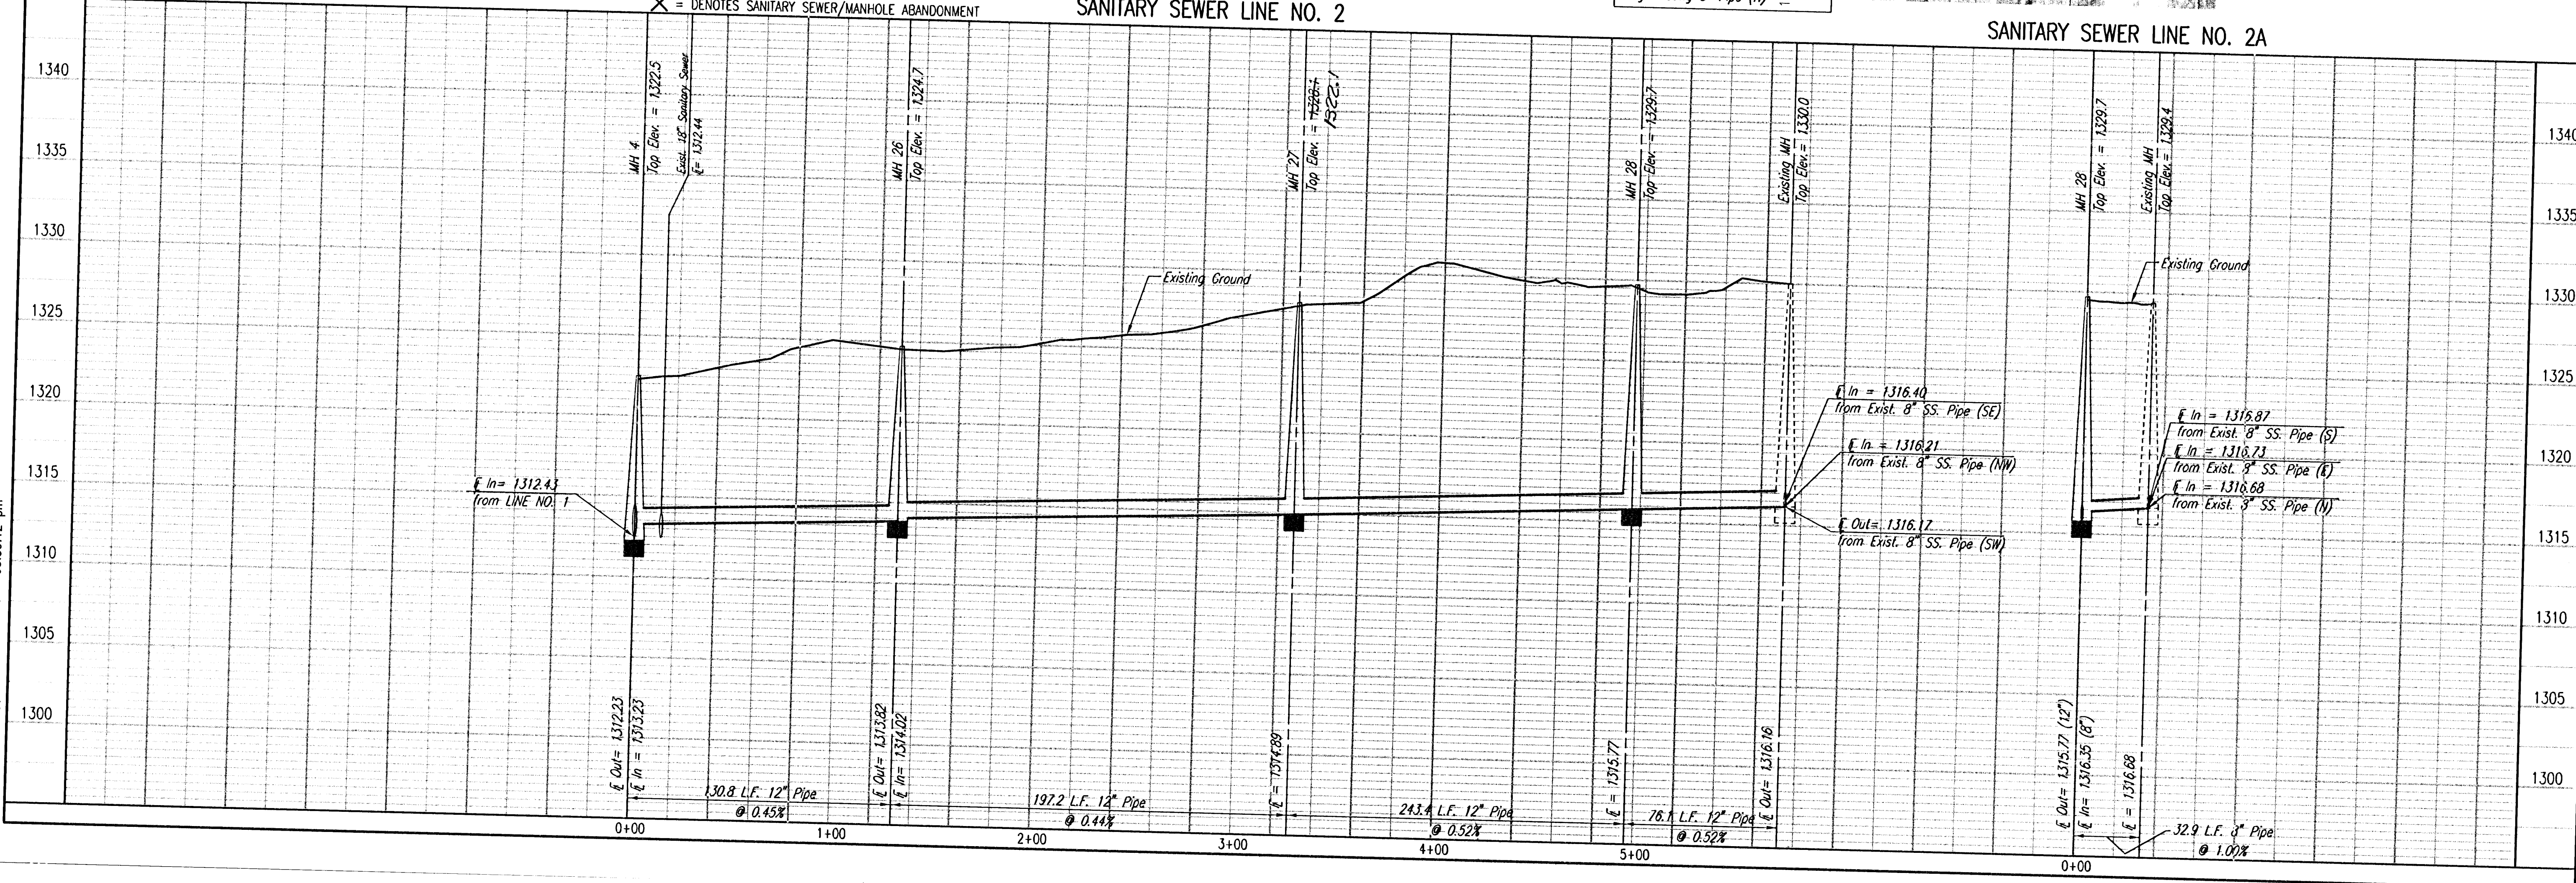
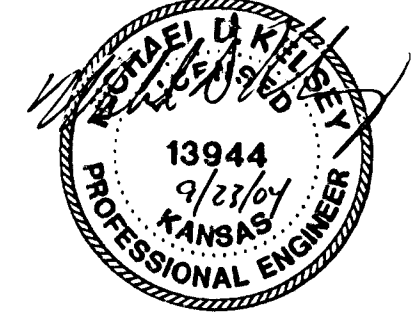
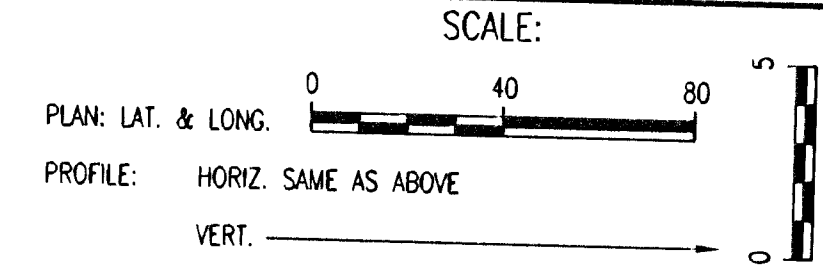


PLAN	CHECKED	DATE
	CHECKED	

PROFILE	CHECKED	DATE
	CHECKED	

DSNR: OPER: JCA SCALE: 1=40.00
 Q:\2002\02633\sepp07 09-22-2004 05:39:12 pm

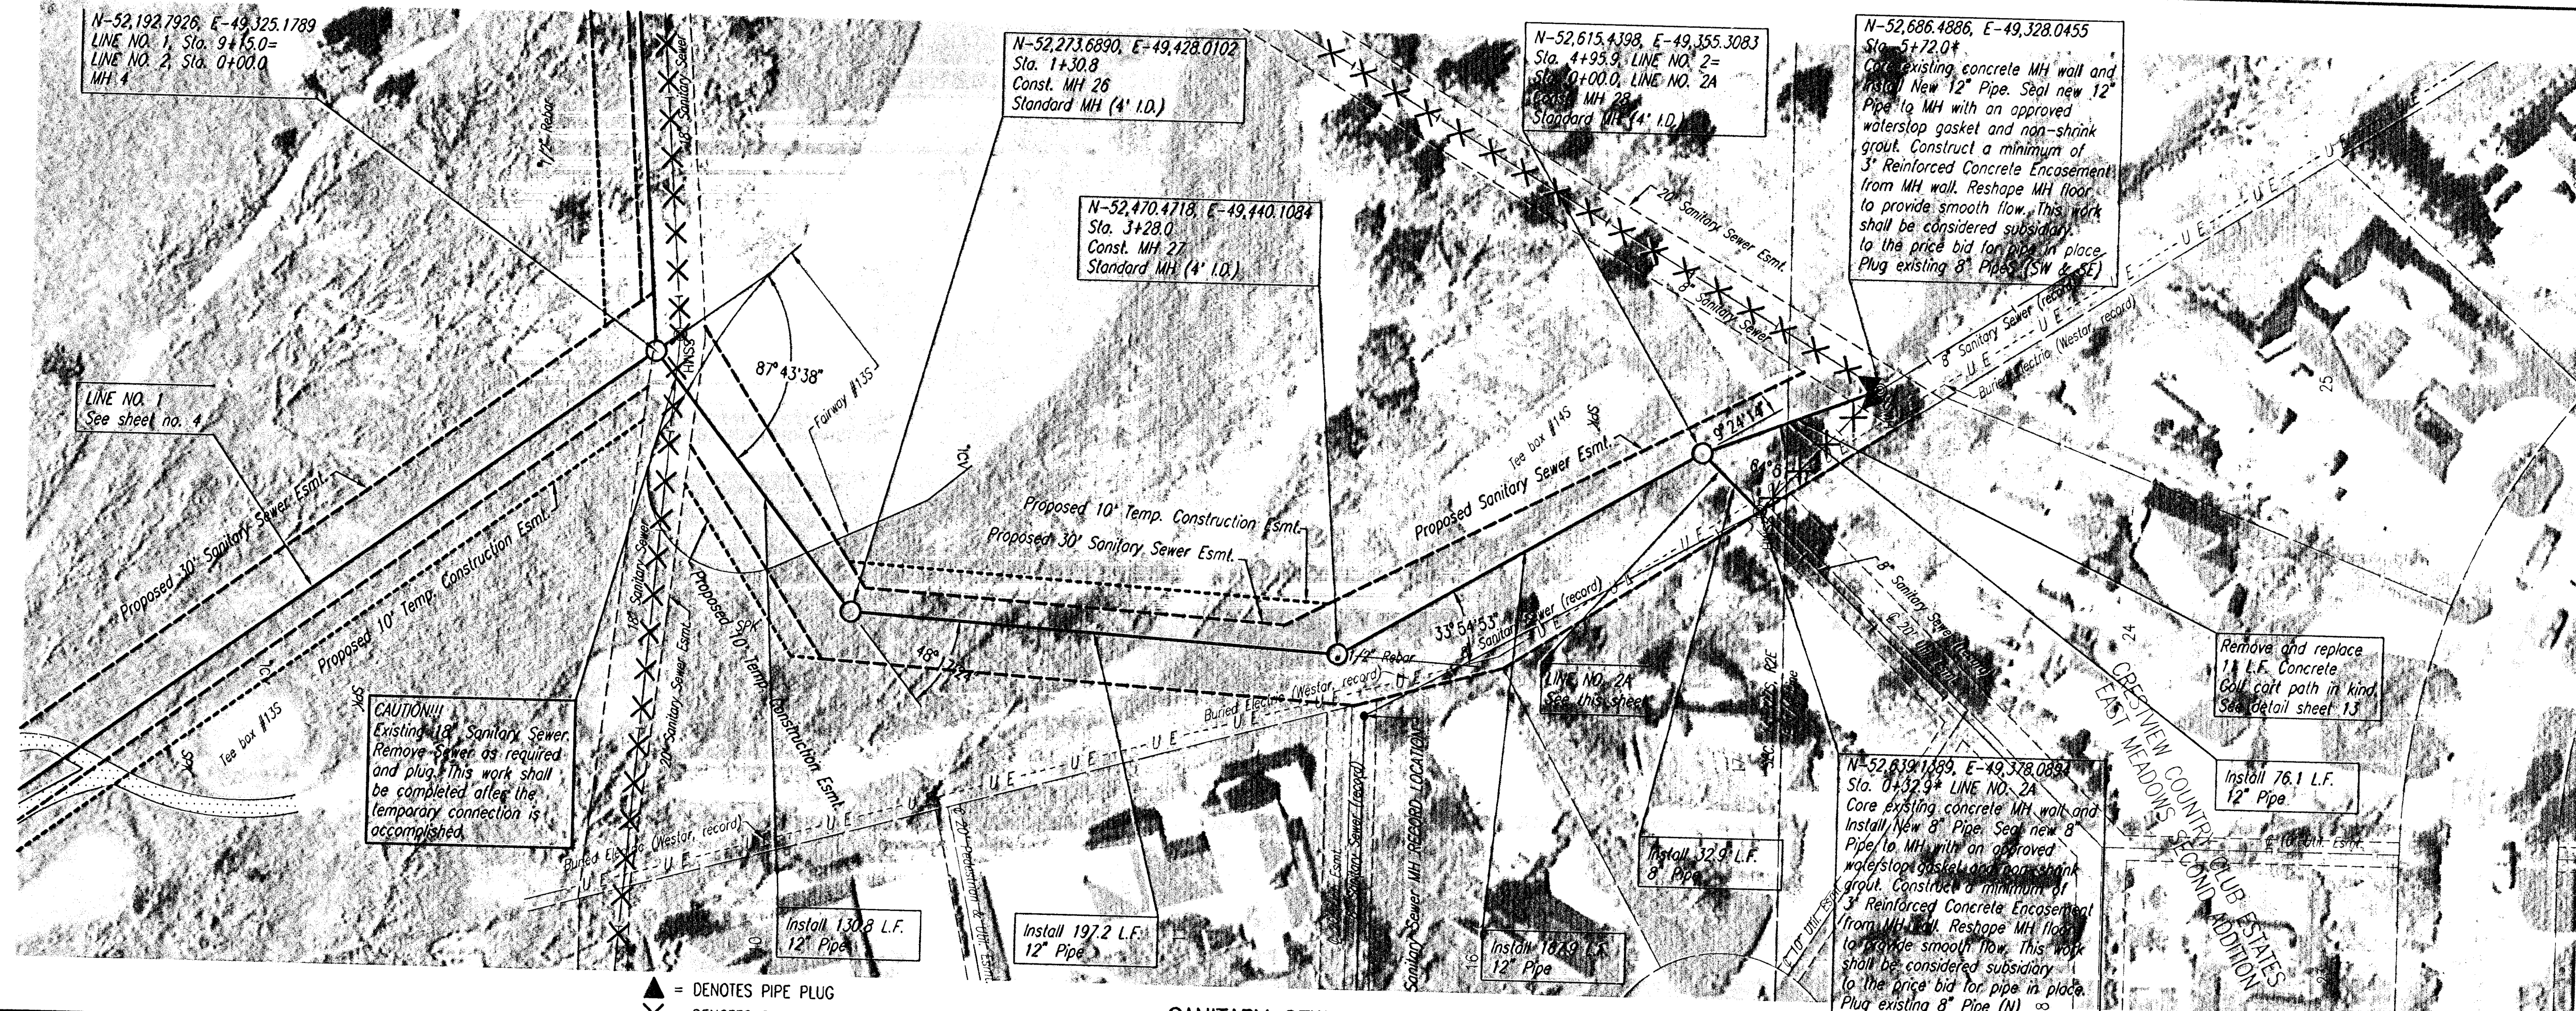

Professional Engineering Consultants, P.A.
 303 S. TOPEKA • WICHITA, KANSAS 67202
 316-262-2691 • FAX 316-262-3003

Designed By: MDK
 Drawn By: JCA
 Job No.: 35-02633-3667
 Date: JULY 2004

Project: MAIN 17, FOUR MILE CREEK CRESTVIEW SEWER - PHASE 1
 SANITARY SEWER LINE NO. 2
 JAMES L. ARMOUR, P.E. - ACTING CITY ENGINEER
 CITY OF WICHITA PROJECT NO. 468-83003