
SWS STRUCTURE POINTS			
POINT NO.	NORTHING	EASTING	DESCRIPTION
1896	1698995.42	1692175.55	MANHOLE 1-0
1897	1698988.52	1692100.70	MANHOLE 1-1
1898	1698986.44	1692018.72	MANHOLE 1-2
1899	1698982.26	1691853.82	MANHOLE 1-3

N

SCALE: 1" = 100'

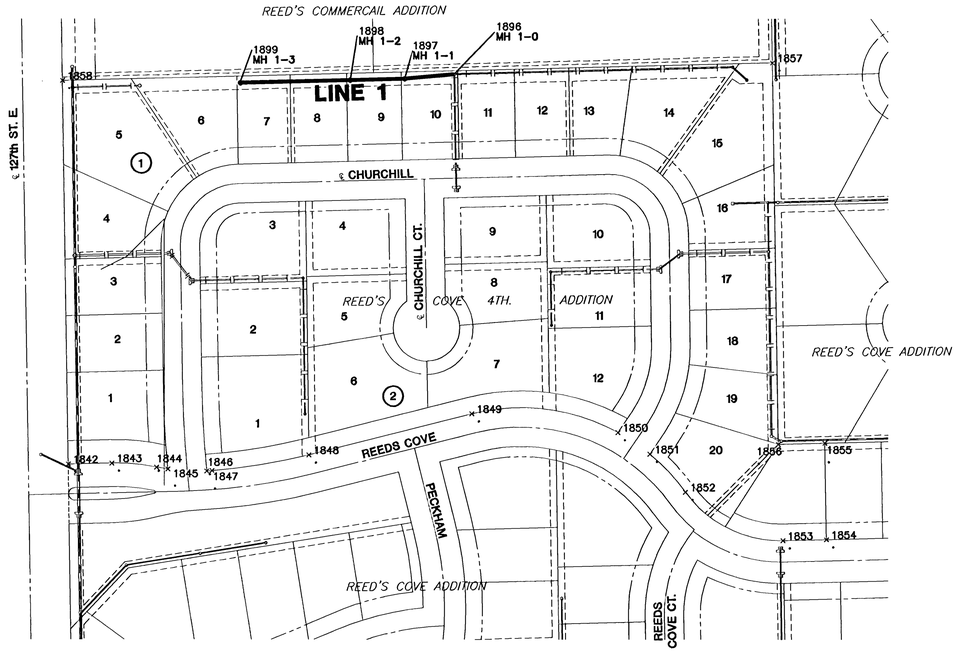

PLAT IRONS			
POINT NO.	NORTHING	EASTING	DESCRIPTION
1842	1698410.49	1691594.48	P.I.
1843	1698412.05	1691660.43	P.I.
1844	1698406.03	1691727.70	P.I.
1845	1698403.09	1691744.45	P.I.
1846	1698400.30	1691803.00	P.I.
1847	1698400.80	1691810.79	P.I.
1848	1698424.53	1691956.65	P.I.
1849	1698486.12	1692201.69	P.I.
1850	1698458.22	1692421.27	P.I.
1851	1698425.73	1692469.32	P.I.
1852	1698368.63	1692522.71	P.I.
1853	1698295.80	1692669.19	P.I.
1854	1698297.45	1692734.55	P.I.
1855	1698442.43	1692732.11	P.I.
1856	1698440.66	1692662.14	P.I.
1857	1699012.44	1692653.56	P.I.
1858	1698985.55	1691585.85	P.I.

MKEC ENGINEERING CONSULTANTS, INC.
411 N. WEBB ROAD
WICHITA, KS. 67206
316-684-9600

PAVING STREETS AND INCIDENTAL DRAINAGE

REEDS COVE FOURTH ADDITION

PHASE 2

BUBBLE MAP

SHEET TITLE

472-84384

PROJECT NUMBER

SRS — DESIGN BY

DM — DRAWN BY

GJA — CHECKED BY

ISSUED: August 2006

REVISED

SHEET NO. 9 of 10

H:\CIVIL\022121 Reeds 22nd Addition\MAP\Phase 2\PHASE2BUBMAP.DWG

PLOTTED: Tuesday, August 22, 2006 @ 09:23AM